





Preliminary Issue
Only

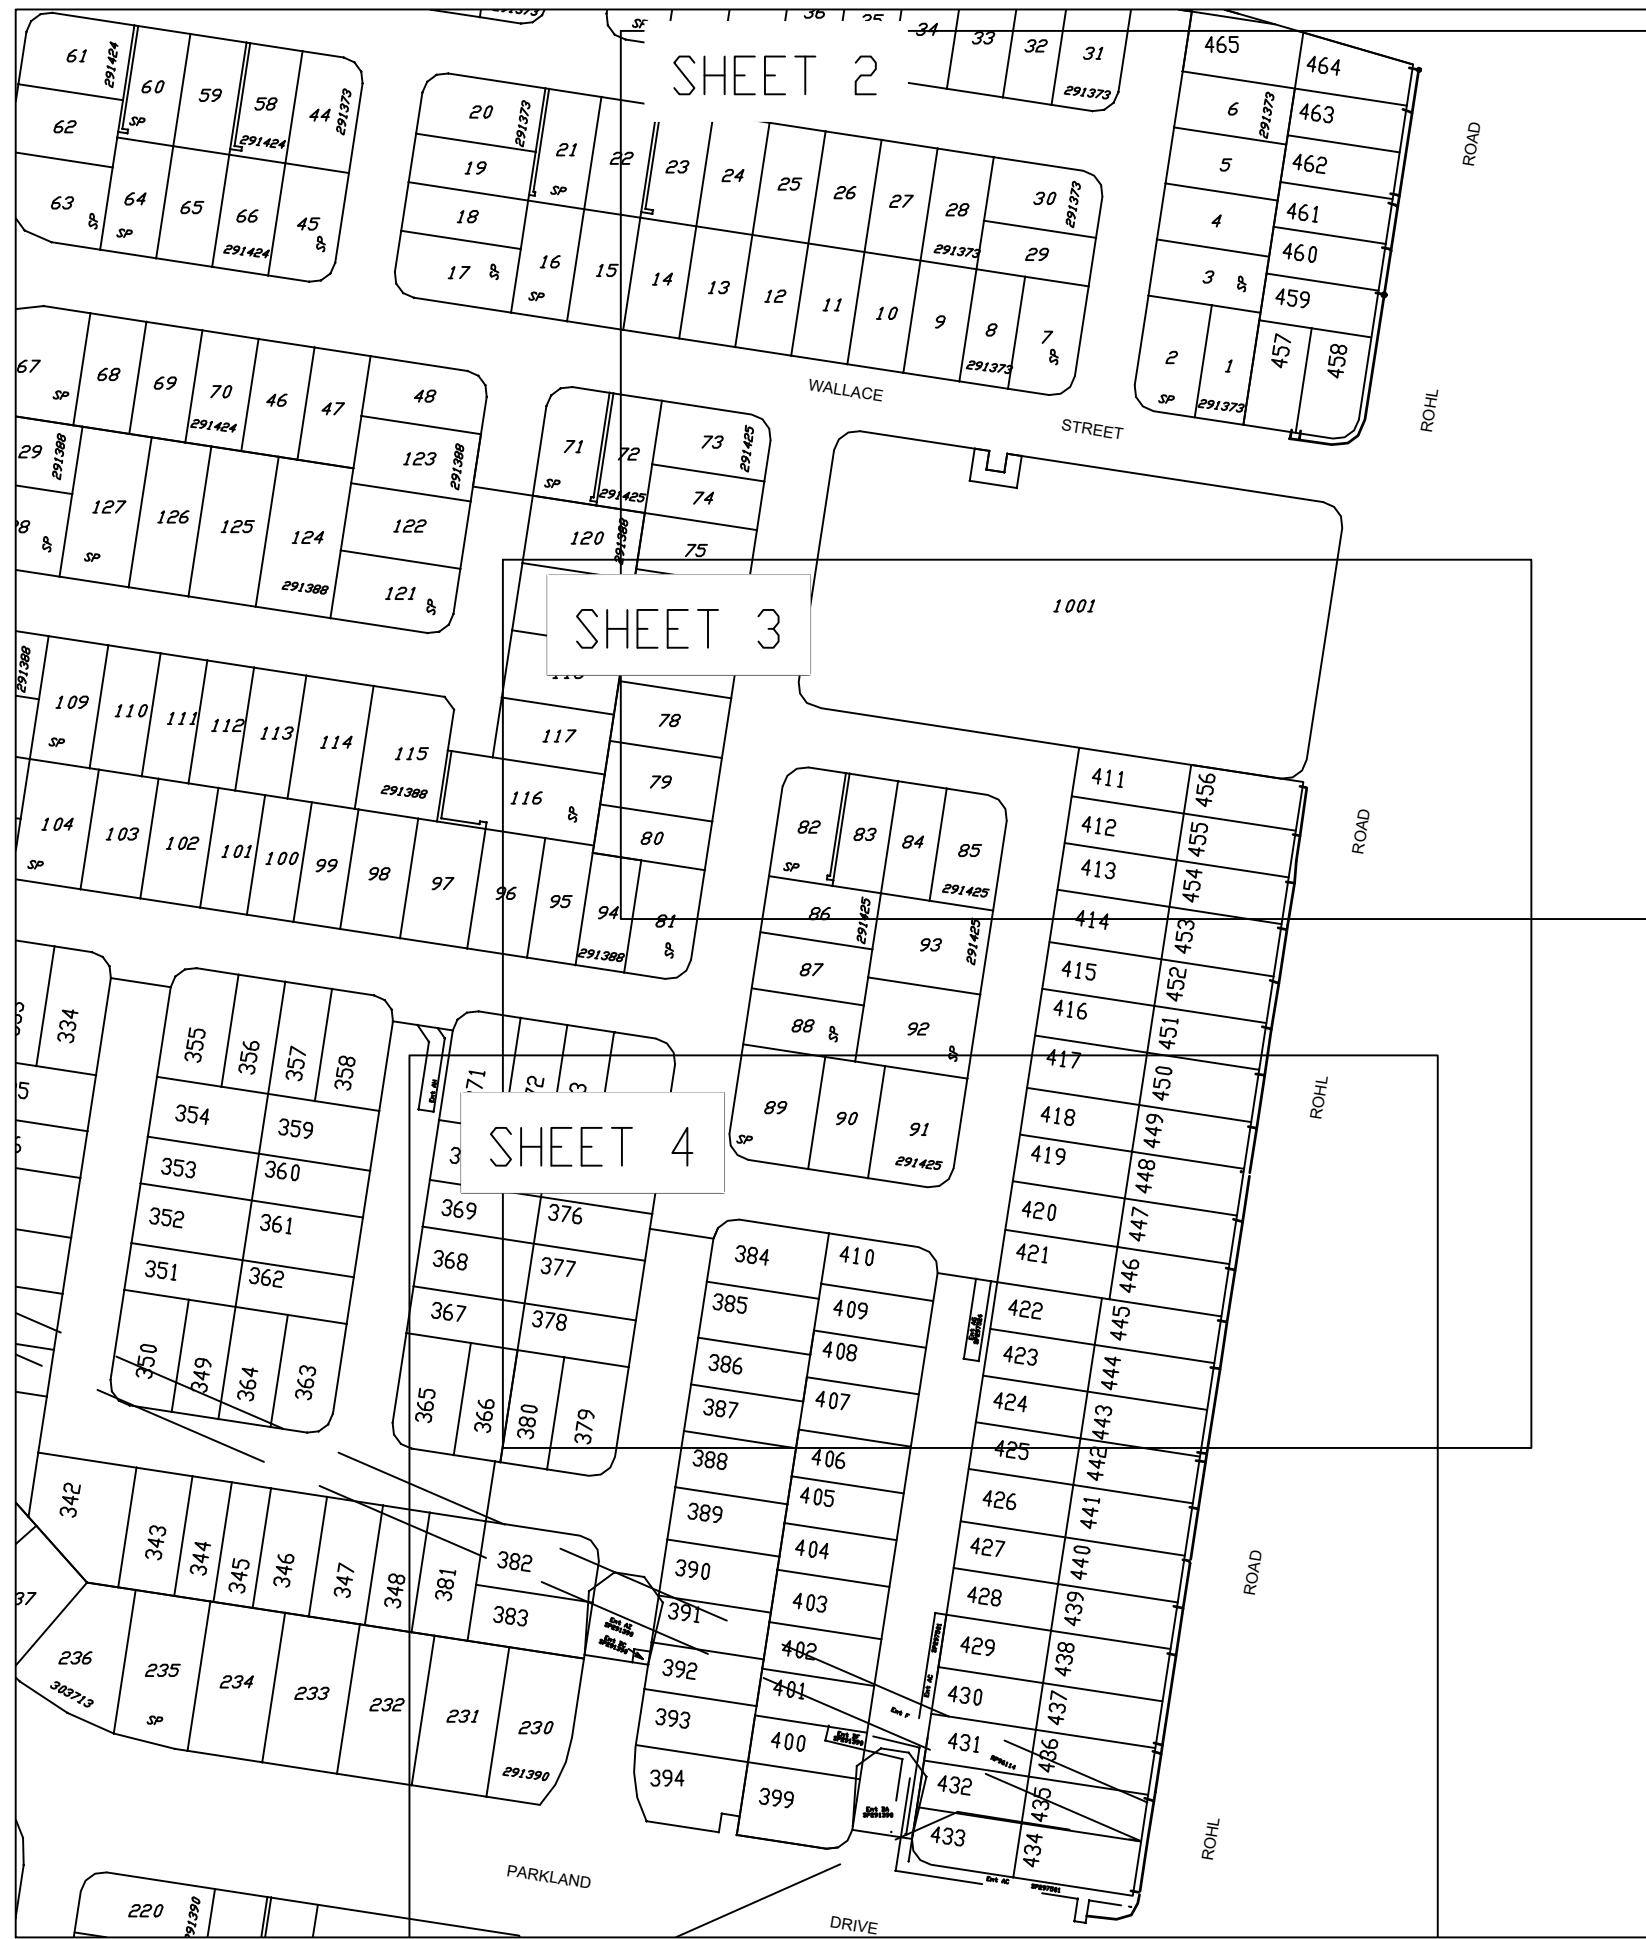

REGISTERED SURVEYOR'S CERTIFICATION
I, _____, hereby certify that the vertical and horizontal locations and dimensions shown on this plan are a true and correct record and were located by survey.
Registered Surveyor (sig.) Reg. Surveyor No. Date

ENGINEER'S CERTIFICATION
I, _____, hereby certify that:
1. The information contained in this drawing / document is in compliance with approved drawings and design.
2. The new water and sewerage works defined by this drawing have been designed and constructed in accordance with the SEQ Code.
3. This represents an accurate record of as-constructed works.
4. I accept responsibility for the information contained in this drawing / document.
RPEQ (signature) RPEQ No. Date:

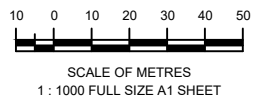

A1

REV NO	DATE	REVISION PURPOSE / DESCRIPTION	DRAWN	RPEQ	RPEQ No.	INITIALS	DATE
A	13/07/2021	PROGRESS PLOT	JMc				



BRISBANE WHITSUNDAYS
071 388 4700 071 645 8000
MACKAY CAIRNS
071 462 9700 071 402 8400
veris.com.au
ACN 616 736 727
Veris Australia Pty Ltd




STAGE 5B
WATERLEA WALLOON
SEWER RETICULATION
SEWER

DRAWING STATUS AS CONSTRUCTED	
SHEET 1 OF 4 SHEETS	
DRAWING NO. 401364-AS05B (A)	REV. A




**Preliminary Issue
Only**

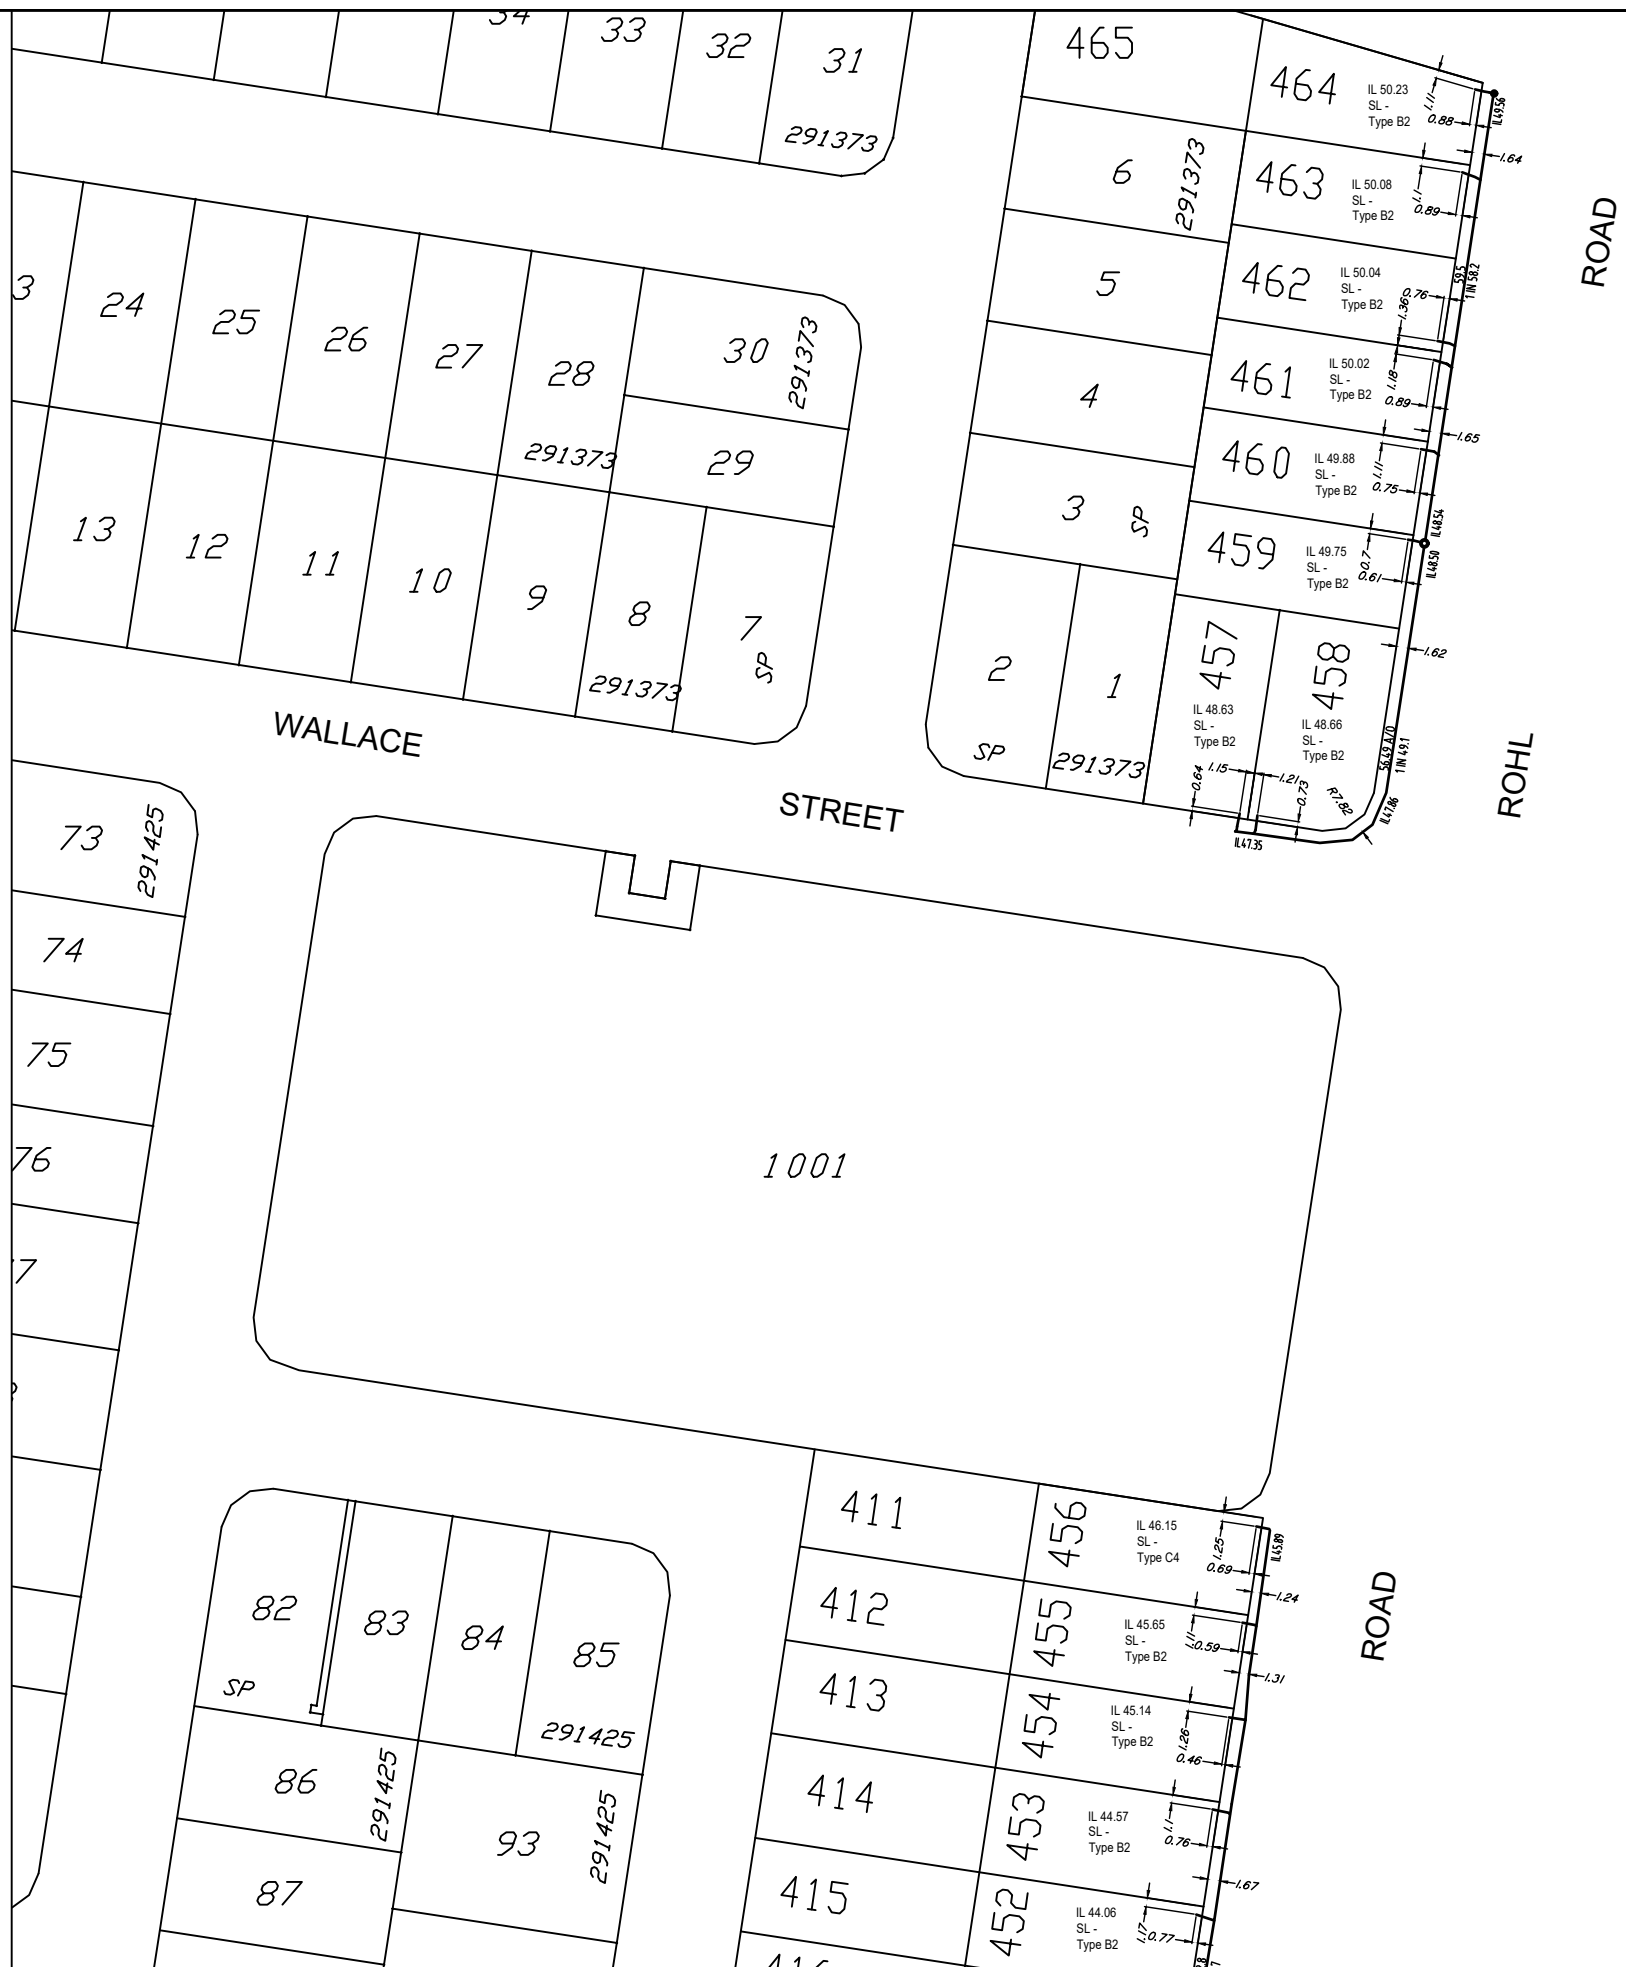

REGISTERED SURVEYOR'S CERTIFICATION
I, _____, hereby certify that the vertical and horizontal locations and dimensions shown on this plan are a true and correct record and were located by survey.
Registered Surveyor (sig.) Reg. Surveyor No. Date

ENGINEER'S CERTIFICATION
I, _____, hereby certify that:
1. The information contained in this drawing / document is in compliance with approved drawings and design.
2. The new water and sewerage works defined by this drawing have been designed and constructed in accordance with the SEQ Code.
3. This represents an accurate record of as-constructed works.
4. I accept responsibility for the information contained in this drawing / document.
RPEQ (signature) RPEQ No. Date:

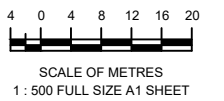

A1

REV NO	DATE	REVISION PURPOSE / DESCRIPTION	DRAWN	RPEQ	RPEQ No.	INITIALS	DATE
A	13/07/2021	PROGRESS PLOT	JMc				



BRISBANE 071 388 4100
MACKAY 071 462 9700
CAIRNS 071 402 8400
veris.com.au
ACN 616 736 727
Veris Australia Pty Ltd



**STAGE 5B
WATERLEA WALLOON
SEWER RETICULATION
SEWER**

DRAWING STATUS
AS CONSTRUCTED
SHEET 2 OF 4 SHEETS
DRAWING NO. 401364-AS05B (A) REV. A



Preliminary Issue Only




REGISTERED SURVEYOR'S CERTIFICATION
I, _____, hereby certify that the vertical and horizontal locations and dimensions shown on this plan are a true and correct record and were located by survey.

Registered Surveyor (sig.) Reg. Surveyor No. Date

ENGINEER'S CERTIFICATION
I, _____, hereby certify that:
1. The information contained in this drawing / document is in compliance with approved drawings and design.
2. The new water and sewerage works defined by this drawing have been designed and constructed in accordance with the SEQ Code.
3. This represents an accurate record of as-constructed works.
4. I accept responsibility for the information contained in this drawing / document.

RPEQ (signature) RPEQ No. Date

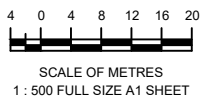

A1	REV NO	DATE	REVISION PURPOSE / DESCRIPTION	DRAWN	RPEQ	RPEQ No.	INITIALS	DATE
	A	13/07/2021	PROGRESS PLOT	JMc				
				DRAWN	JMc			14/06/2021
				CHECKED				
				APPROVED				



BRISBANE WHITSUNDAYS
(07) 3848 4700 (07) 5464 8000
MACKAY CAIRNS
(07) 4567 9700 (07) 4052 3400
veris.com.au
ACN 616 736 727
Veris Australia Pty Ltd



STAGE 5B
WATERLEA WALLOON
SEWER RETICULATION
SEWER

DRAWING STATUS
AS CONSTRUCTED
SHEET 3 OF 4 SHEETS
DRAWING NO. REV.
401364-AS05B (A) A



Preliminary Issue
Only



REGISTERED SURVEYOR'S CERTIFICATION

I, _____, hereby certify that the vertical and horizontal locations and dimensions shown on this plan are a true and correct record and were located by survey.

Registered Surveyor (sig.) Reg. Surveyor No. Date

ENGINEER'S CERTIFICATION

I, _____, hereby certify that:

- The information contained in this drawing / document is in compliance with approved drawings and design.
- The new water and sewerage works defined by this drawing have been designed and constructed in accordance with the SEQ Code.
- This represents an accurate record of as-constructed works.
- I accept responsibility for the information contained in this drawing / document.

RPEQ (signature) RPEQ No. Date:

A1

REV NO	DATE	REVISION PURPOSE / DESCRIPTION	DRAWN	RPEQ	RPEQ No.	INITIALS	DATE
A	13/07/2021	PROGRESS PLOT	JMc				



BRISBANE WHITSUNDAYS
 (07) 3848 4700 (07) 5444 8000
 MACKAY CAIRNS
 (07) 4567 9700 (07) 4052 8400

veris.com.au
 ACN 616 736 727
 Veris Australia Pty Ltd



STAGE 5B
 WATERLEA WALLOON
 SEWER RETICULATION
 SEWER

DRAWING STATUS
AS CONSTRUCTED

SHEET 4 OF 4 SHEETS

DRAWING NO. REV.
 401364-AS05B (A) A