




ADAC VS.01
LOCAL-MGA2020

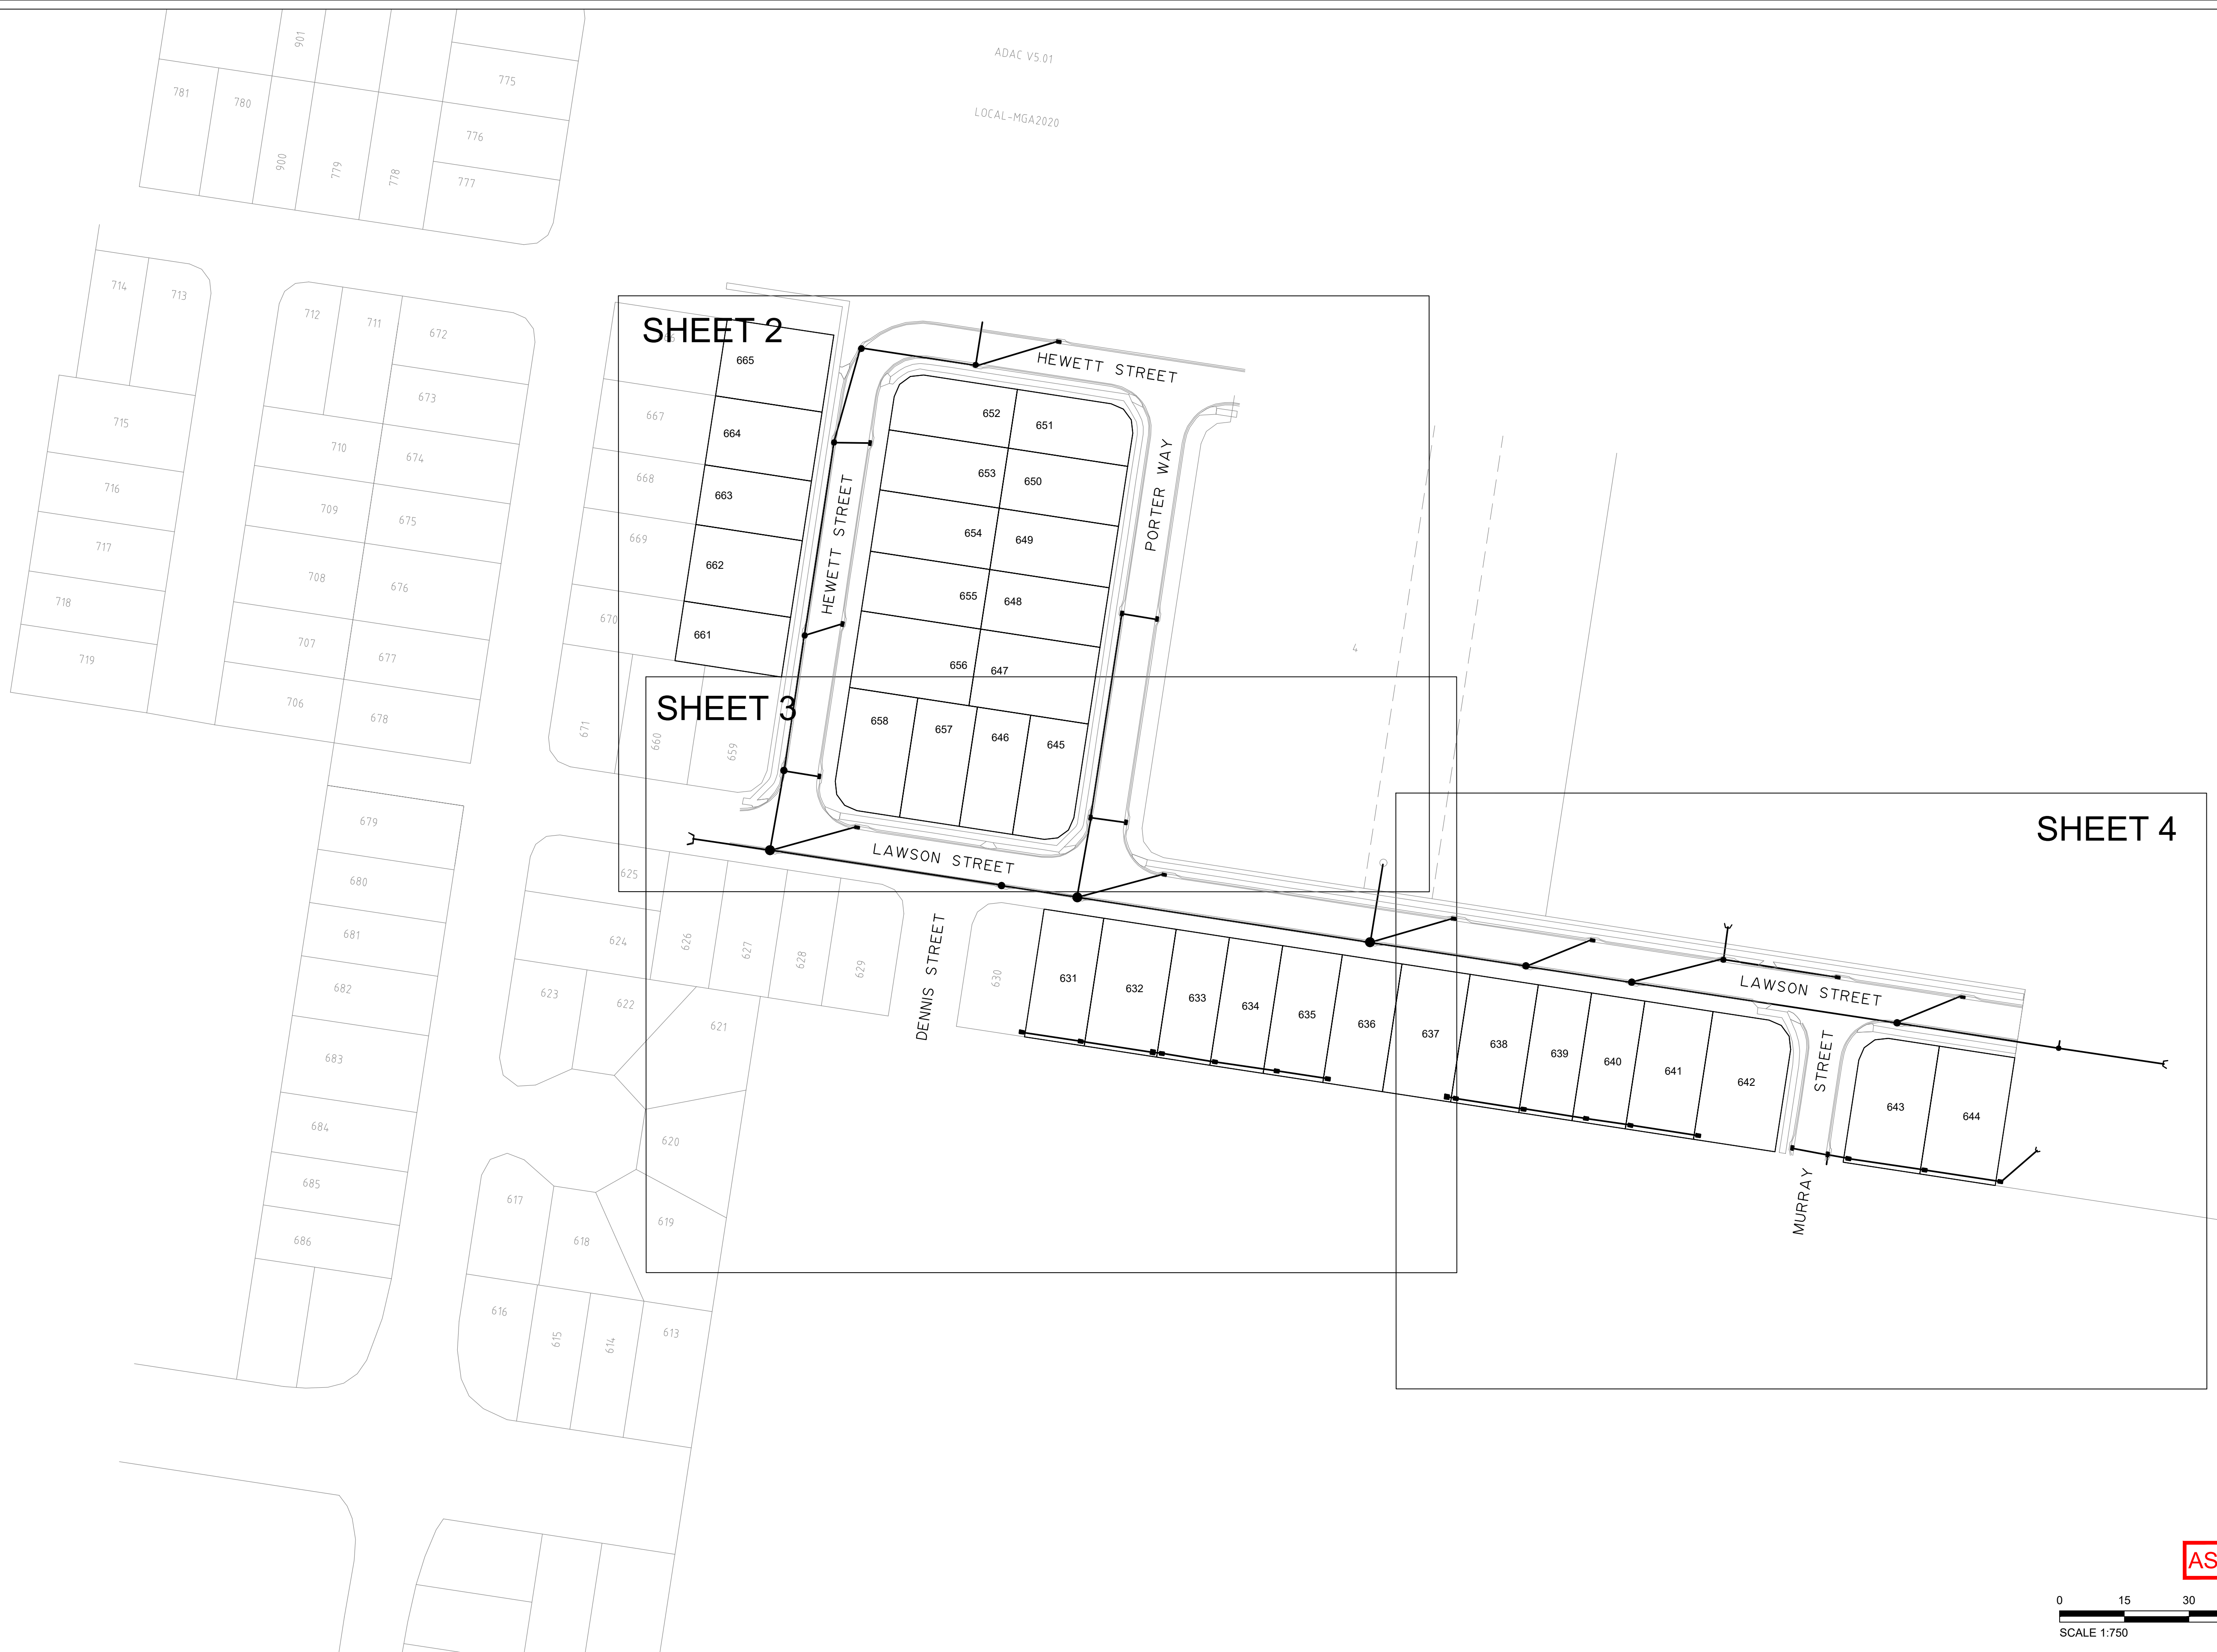

AS CONSTRUCTED

0 15 30 45 60 75m
SCALE 1:750 @A1

A1

INDEX	DATE	REVISIONS	DRAWN	CHECKED	PASSED
B	28/02/2023	PROGRESS PLOT	JMc		
A	13/12/2022	PROGRESS PLOT	JMc		

DRAWN	JMc	13/12/2022
CHECKED		
PASSED		
INITIALS		DATE



BRISBANE (07) 3686 4700 WHITSUNDAYS (07) 4945 8600
 MACKAY (07) 4667 9700 CAIRNS (07) 4232 9400
 veris.com.au
 ACN 615 735 727
 Veris Australia Pty Ltd




IPSWICH CITY COUNCIL

WATERLEA WALLOON STAGE 6B1
AS CONSTRUCTED
DRAINAGE

SCALE	1:750 @A1
SHEET	1 OF 4 SHEETS
DRAWING NO.	401905-6B1-ASW01
	B
	A



AS CONSTRUCTED

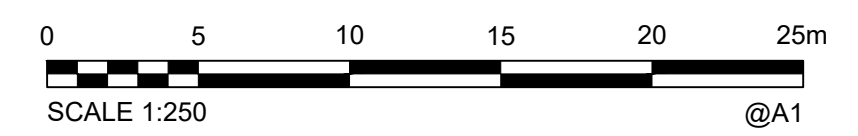

A1							
	B	28/02/2023	PROGRESS PLOT				JMc
	A	13/12/2022	PROGRESS PLOT				JMc
	INDEX	DATE	REVISIONS	DRAWN	CHECKED	PASSED	

DRAWN	JMc	13/12/2022	
CHECKED			
PASSED			
INITIALS		DATE	


BRISBANE (07) 3686 4700 WHITSUNDAYS (07) 4945 8600
 MACKAY (07) 4667 9700 CAIRNS (07) 4232 9400
 veris.com.au
 ACN 615 735 727
 Veris Australia Pty Ltd




IPSWICH CITY COUNCIL

WATERLEA WALLOON STAGE 6B1
 AS CONSTRUCTED
 DRAINAGE

SCALE	1:250 @A1
SHEET	3 OF 4 SHEETS
DRAWING NO.	401905-6B1-ASW01
	B A

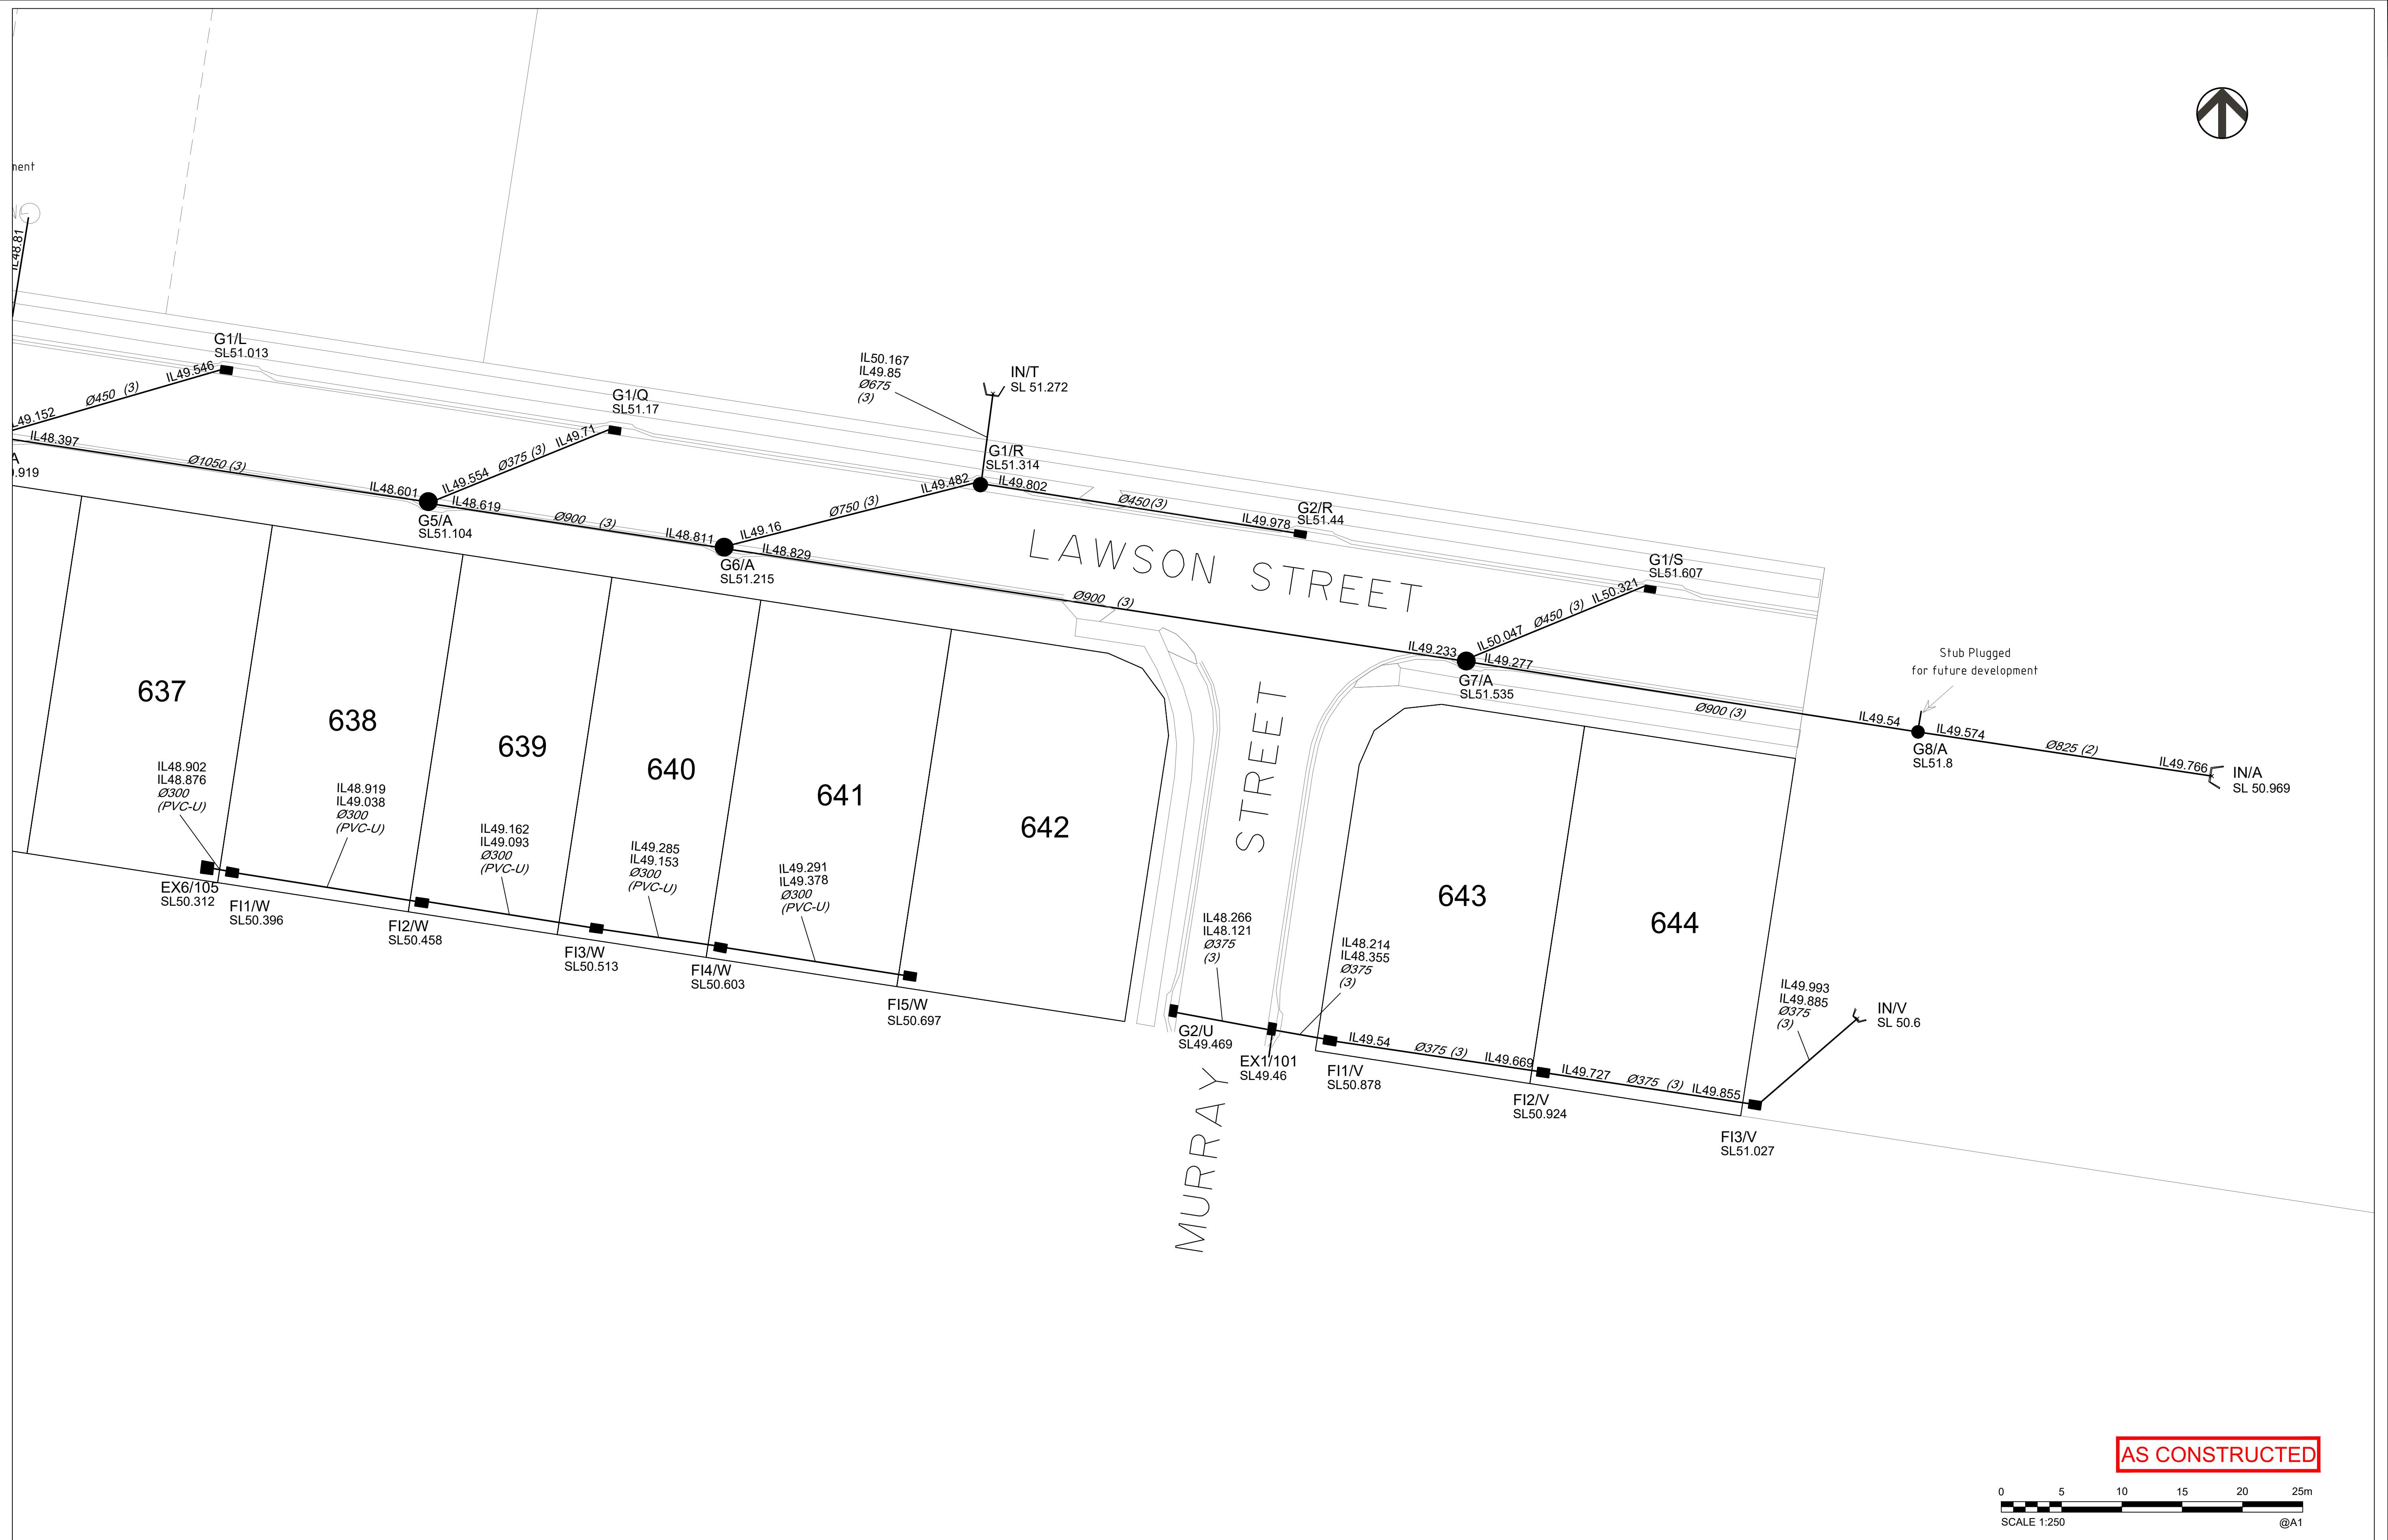

AS CONSTRUCTED

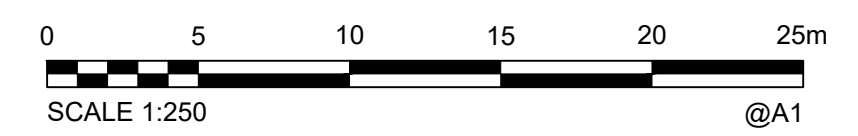

A1

INDEX	DATE	REVISIONS	DRAWN	CHECKED	PASSED
B	28/02/2023	PROGRESS PLOT	JM		
A	13/12/2022	PROGRESS PLOT	JM		

DRAWN	CHECKED	PASSED	INITIALS	DATE
JM				13/12/2022



BRISBANE (07) 3686 4700
 WHITSUNDAYS (07) 4945 8600
 MACKAY (07) 4667 9700
 CAIRNS (07) 4232 8400
 veris.com.au
 ACN 615 735 727
 Veris Australia Pty Ltd



IPSWICH CITY COUNCIL

WATERLEA WALLOON STAGE 6B1
 AS CONSTRUCTED
 DRAINAGE

SCALE	1:250 @A1
SHEET	4 OF 4 SHEETS
DRAWING NO.	401905-6B1-ASW01