

REGISTERED SURVEYOR'S CERTIFICATION

I, Veris Australia Pty Ltd, hereby certify that the vertical and horizontal locations and dimensions shown on this plan are a true and correct record and were located by survey.


Registered Surveyor (sig.) 6448 Reg. Surveyor No. Date

ENGINEER'S CERTIFICATION

I, _____, hereby certify that:

1. The information contained in this drawing / document is in compliance with approved drawings and design.
2. This represents an accurate record of as-constructed works.
3. I accept responsibility for the information contained in this drawing / document.

RPEQ (signature) RPEQ No. Date:

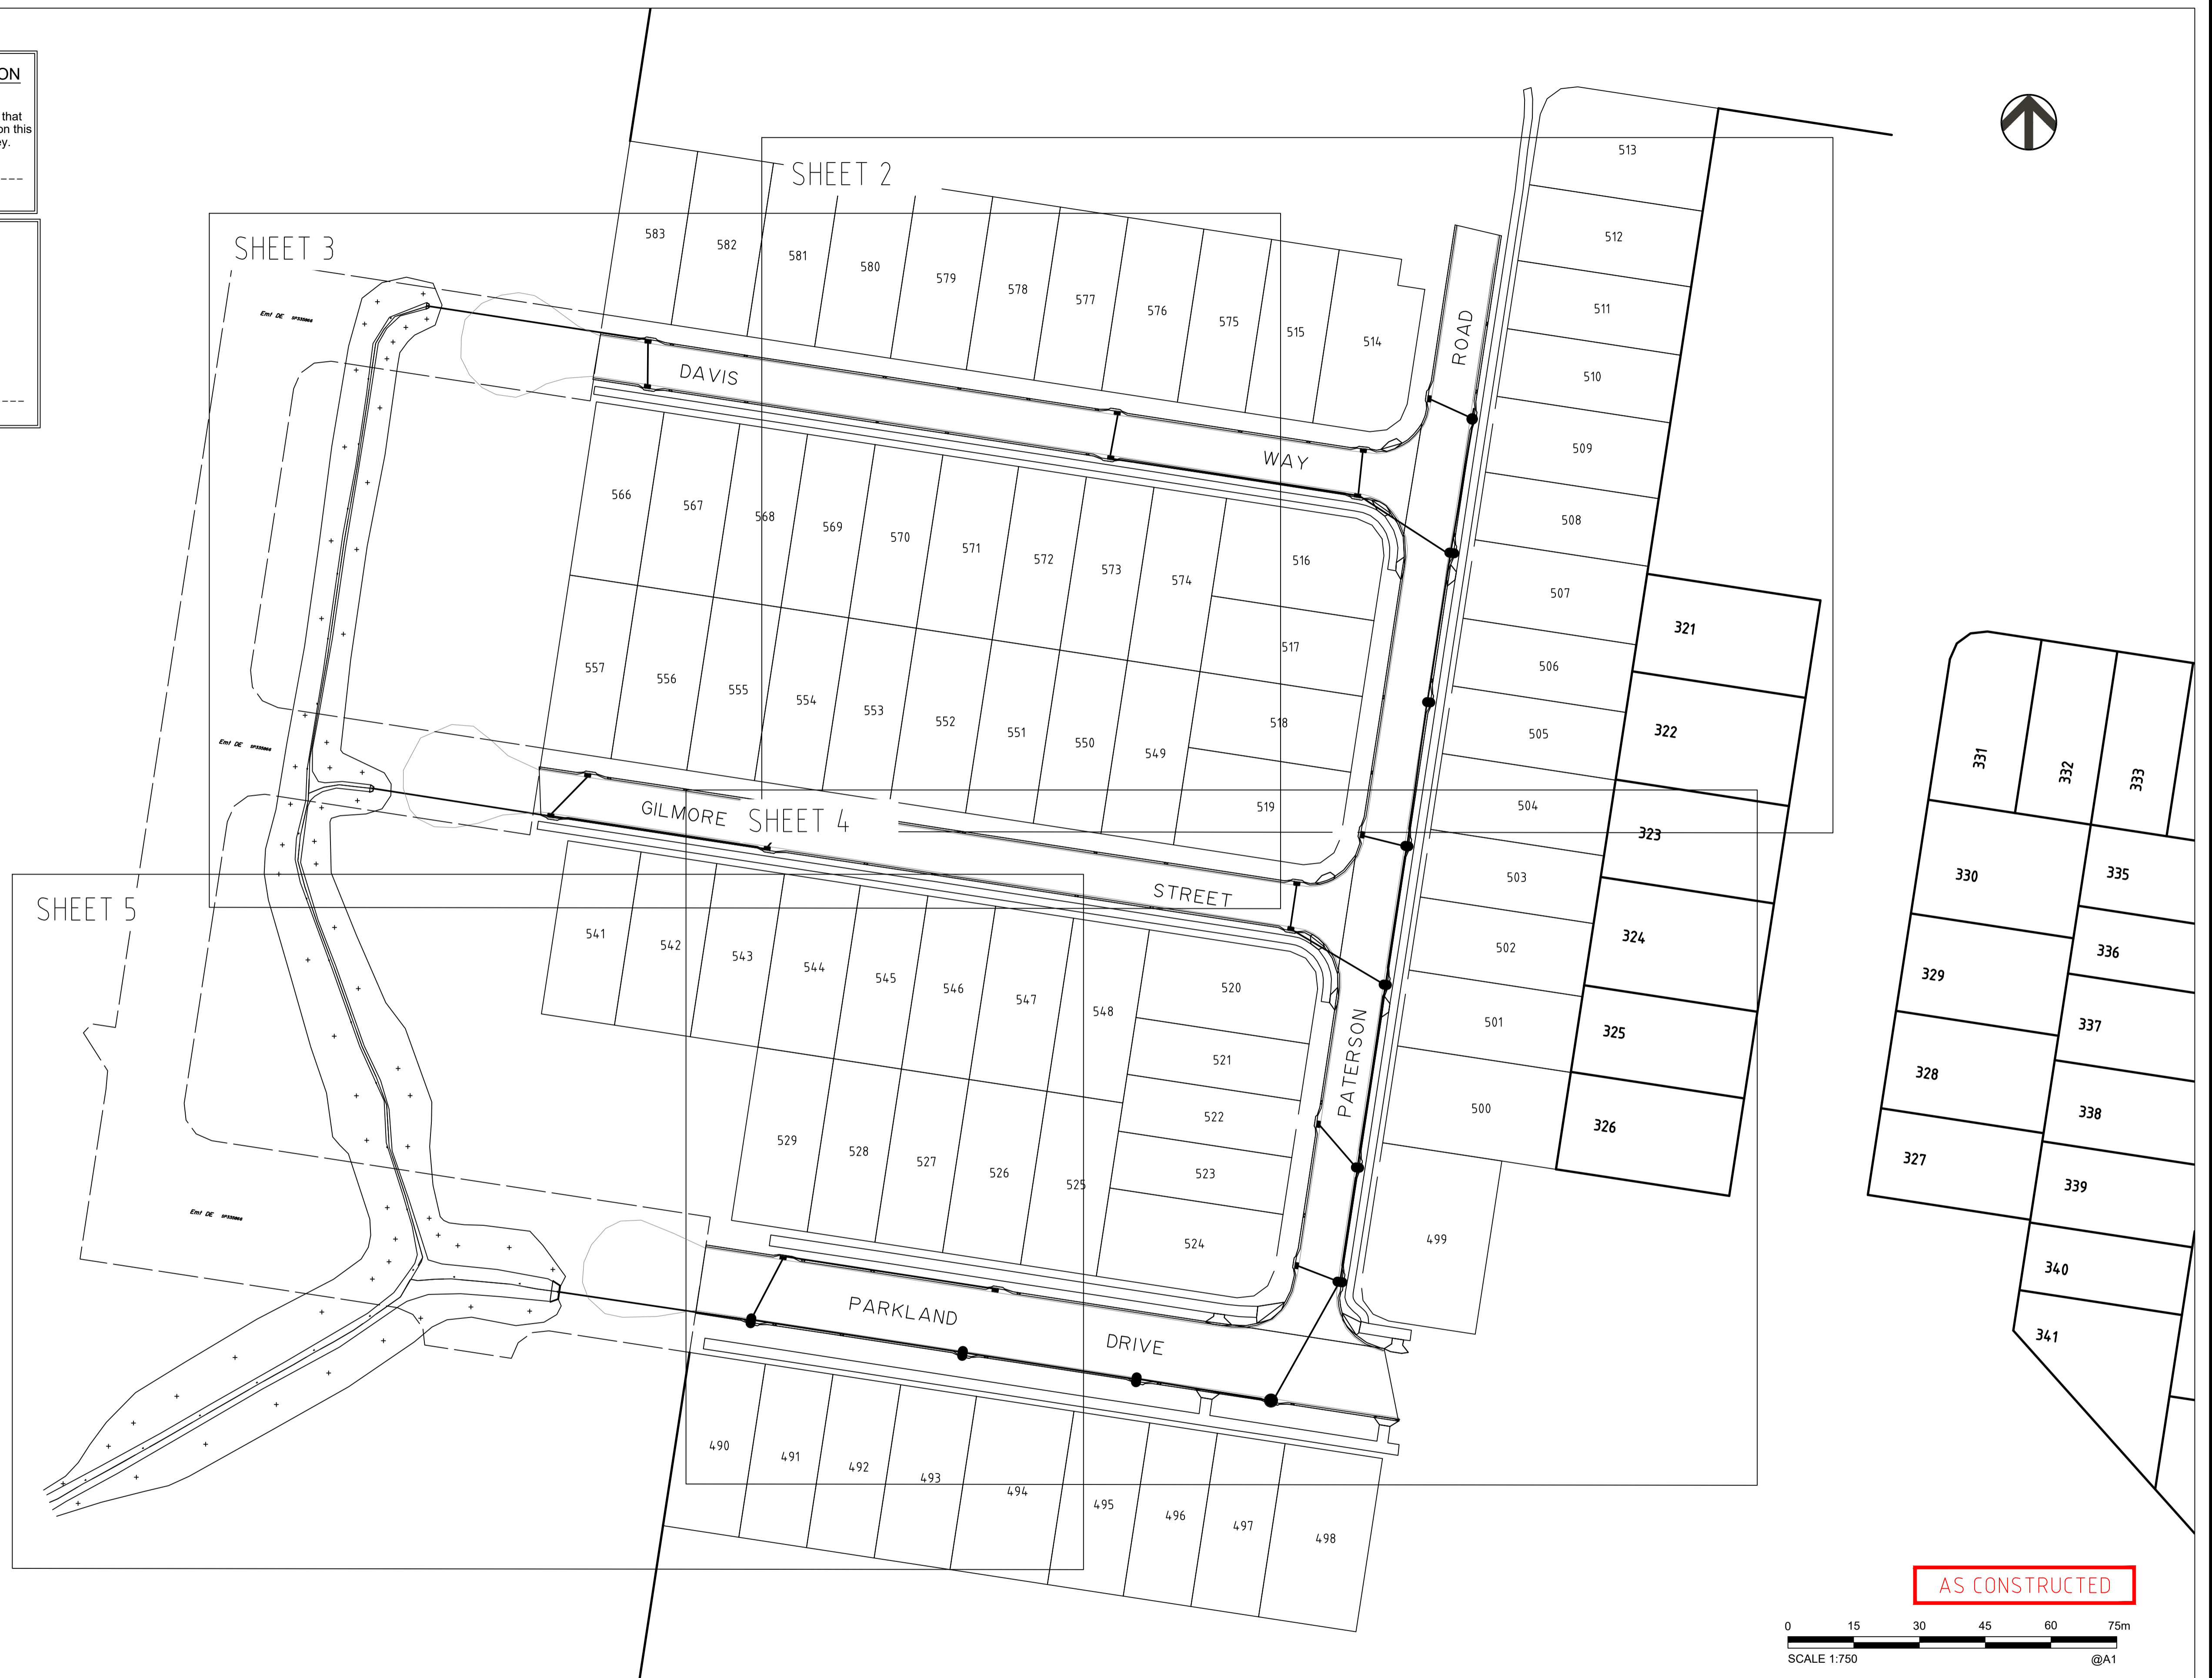

AS CONSTRUCTED

0 15 30 45 60 75m
SCALE 1:750 @A1

A1

INDEX	DATE	REVISIONS	DRAWN	CHECKED	PASSED
C	10/11/2023	PROGRESS PLOT	JMc		
B	20/10/2023	PROGRESS PLOT	JMc		
A	04/10/2023	PROGRESS PLOT	JMc		

DRAWN	CHECKED	PASSED	INITIALS	DATE
JMc				04/10/2023




BRISBANE (07) 3066 4700 WHITSUNDAYS (07) 4945 6600
MACKAY (07) 4937 9100 CAIRNS (07) 4522 9600
veris.com.au
ACN 615 735 727
Veris Australia Pty Ltd



IPSWICH CITY COUNCIL

WATERLEA WALLOON STAGES 6C1 & 6C2
AS CONSTRUCTED
DRAINAGE

SCALE	1:750 @A1
SHEET 1 OF 5 SHEETS	
DRAWING NO.	
401905-6C1-6C2-ASW01	

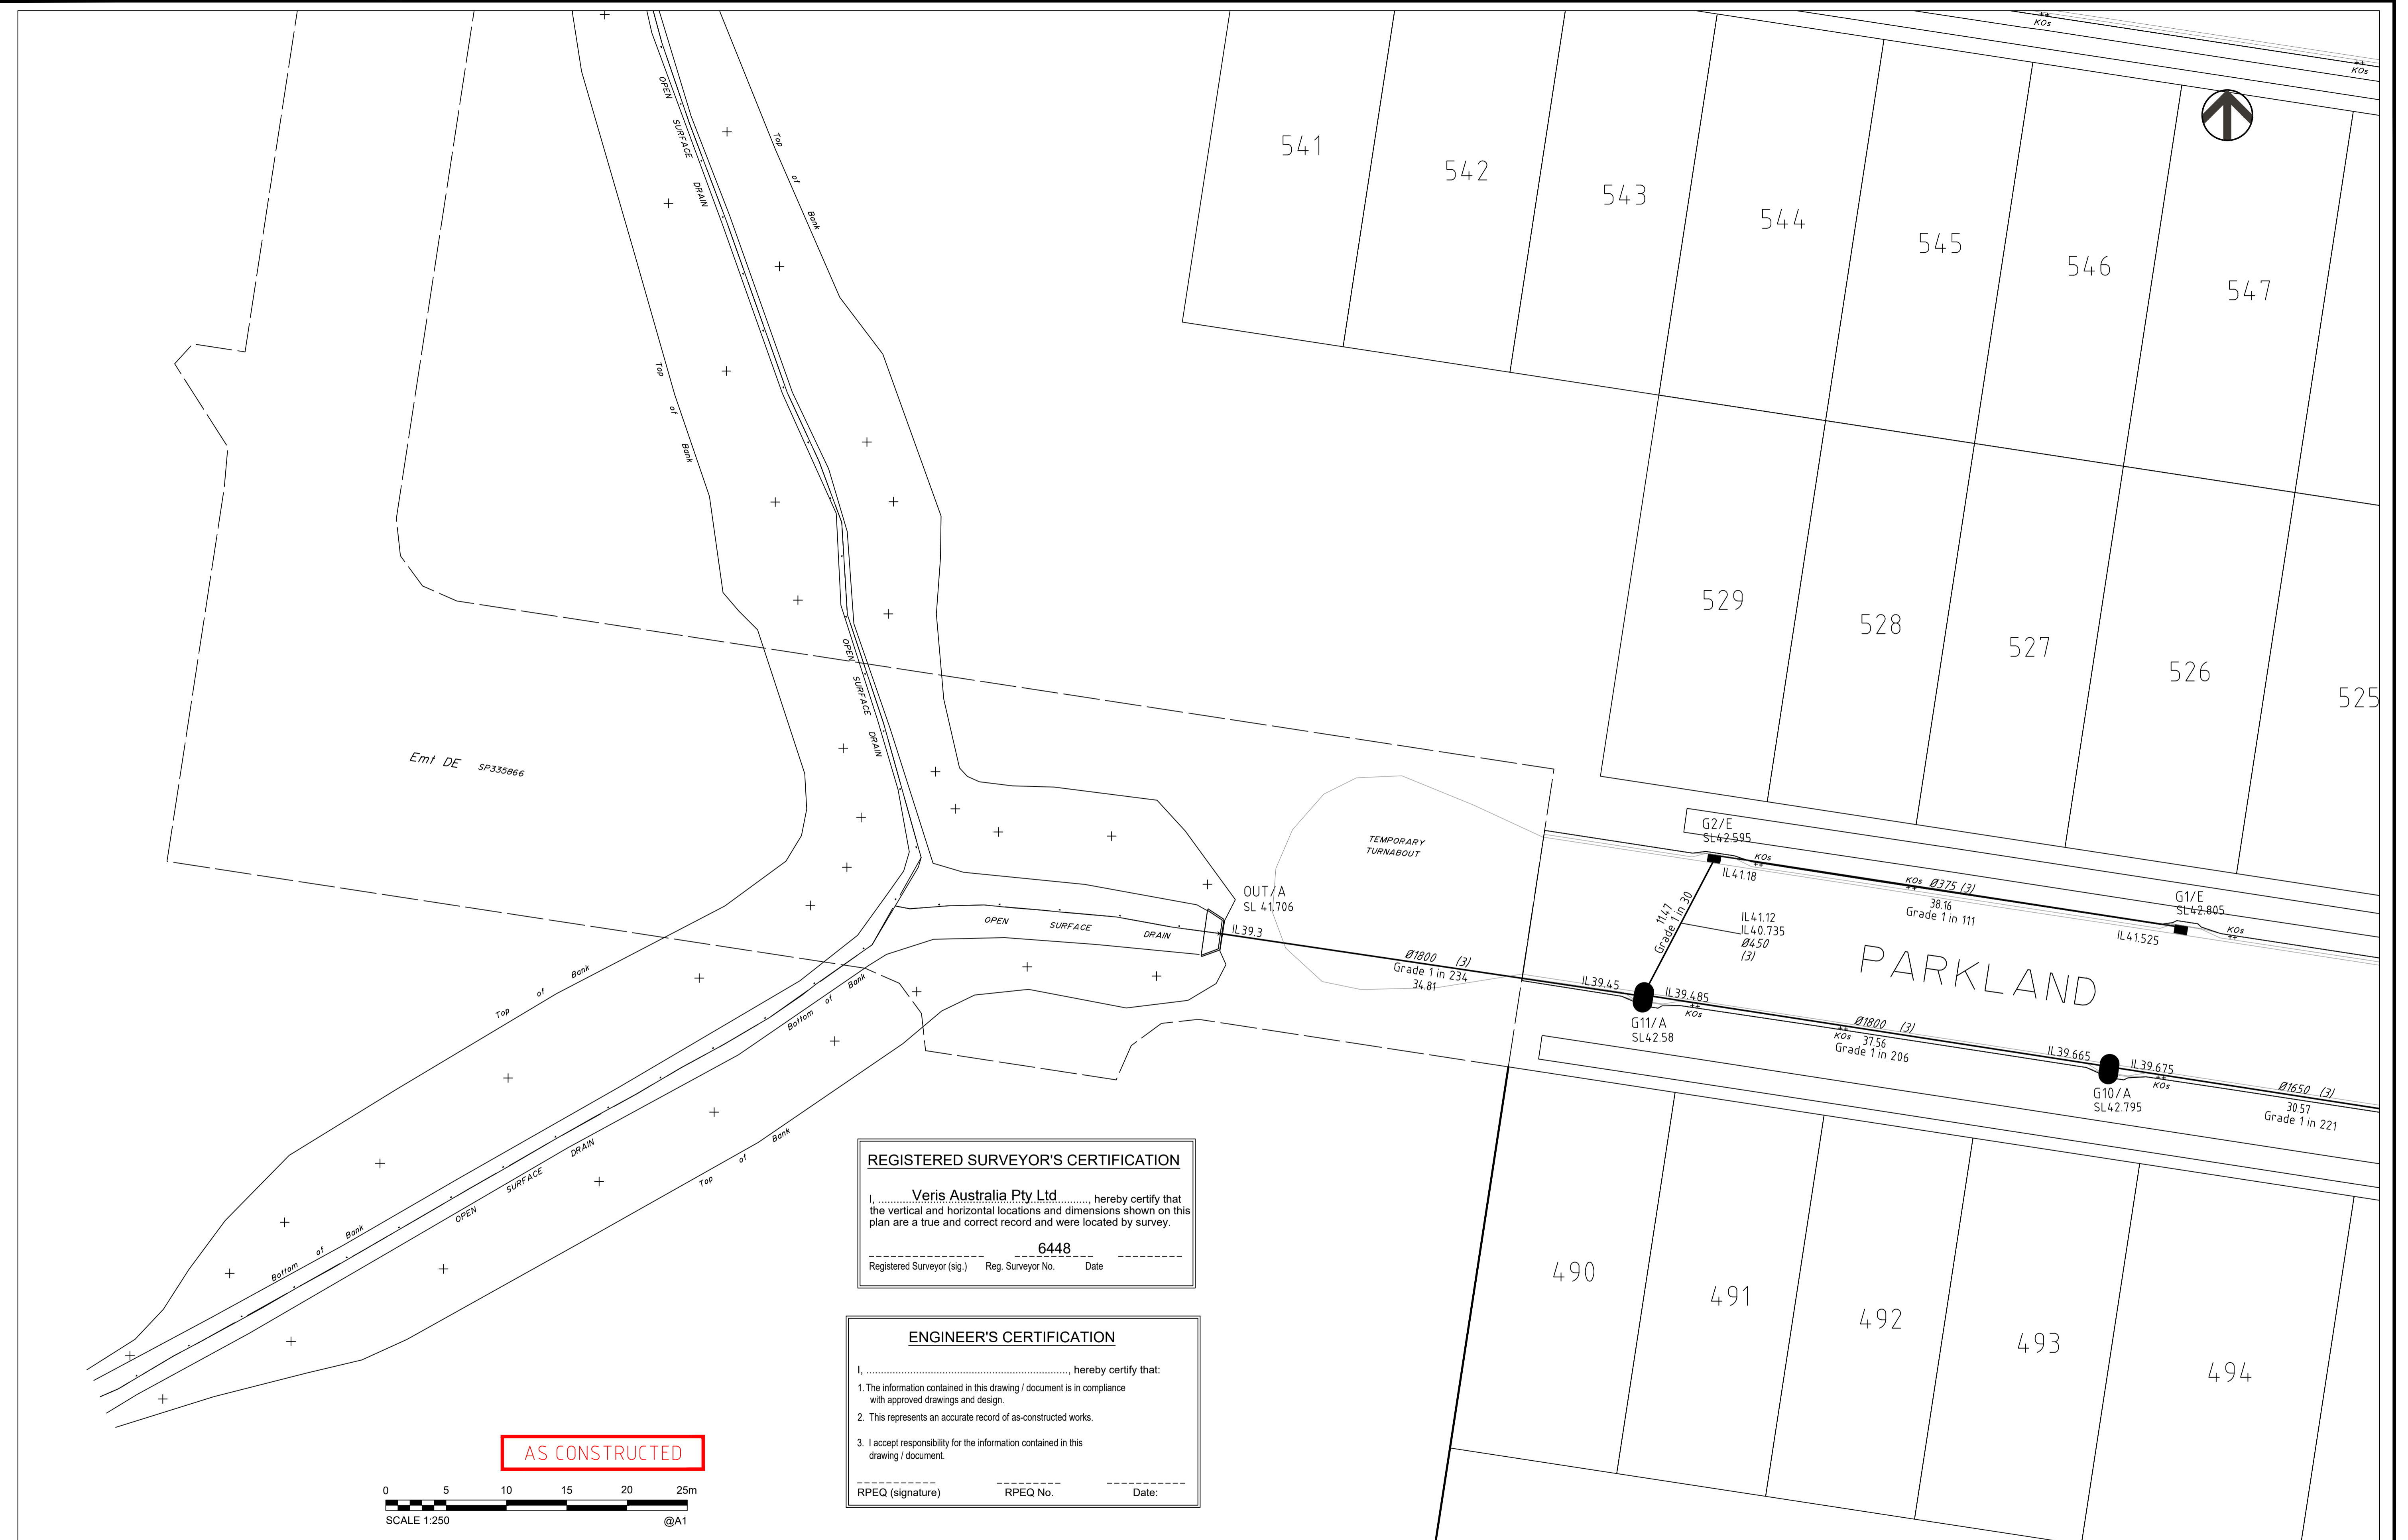

Emt DE SP335066

OUT/A
SL 4.1706

PARKLAND

REGISTERED SURVEYOR'S CERTIFICATION

I, Veris Australia Pty Ltd, hereby certify that the vertical and horizontal locations and dimensions shown on this plan are a true and correct record and were located by survey.

6448
Registered Surveyor (sig.) Reg. Surveyor No. Date


ENGINEER'S CERTIFICATION

I, _____, hereby certify that:

- The information contained in this drawing / document is in compliance with approved drawings and design.
- This represents an accurate record of as-constructed works.
- I accept responsibility for the information contained in this drawing / document.

RPEQ (signature) RPEQ No. Date:

AS CONSTRUCTED

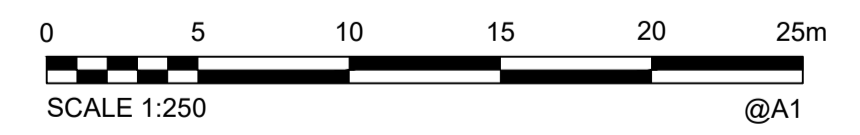

A1

INDEX	DATE	REVISIONS	DRAWN	CHECKED	PASSED
C	10/11/2023	PROGRESS PLOT	JMc		
B	20/10/2023	PROGRESS PLOT	JMc		
A	04/10/2023	PROGRESS PLOT	JMc		

DRAWN	DATE
JMc	04/10/2023
CHECKED	
PASSED	



BRISBANE (07) 3066 4700 WHITSUNDAYS (07) 4945 6600
MACKAY (07) 4937 3100 CAIRNS (07) 4522 2400
veris.com.au
ACN 615 735 727
Veris Australia Pty Ltd



IPSWICH CITY COUNCIL

WATERLEA WALLOON STAGES 6C1 & 6C2
AS CONSTRUCTED
DRAINAGE

SCALE	1:250 @A1
SHEET	5 OF 5 SHEETS
DRAWING NO.	
401905-6C1-6C2-ASW01	