



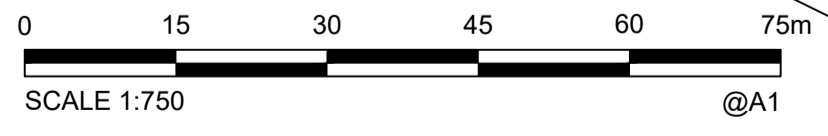

**REGISTERED SURVEYOR'S CERTIFICATION**  
 I, Veris Australia Pty Ltd, hereby certify that the vertical and horizontal locations and dimensions shown on this plan are a true and correct record and were located by survey.  
 Registered Surveyor (sig.) 6448 Reg. Surveyor No. Date

**ENGINEER'S CERTIFICATION**  
 I, \_\_\_\_\_, hereby certify that:  
 1. The information contained in this drawing / document is in compliance with approved drawings and design.  
 2. The new water and sewerage works defined by this drawing have been designed and constructed in accordance with the SEQ Code.  
 3. This represents an accurate record of as-constructed works.  
 4. I accept responsibility for the information contained in this drawing / document.  
 RPEQ (signature) RPEQ No. Date:

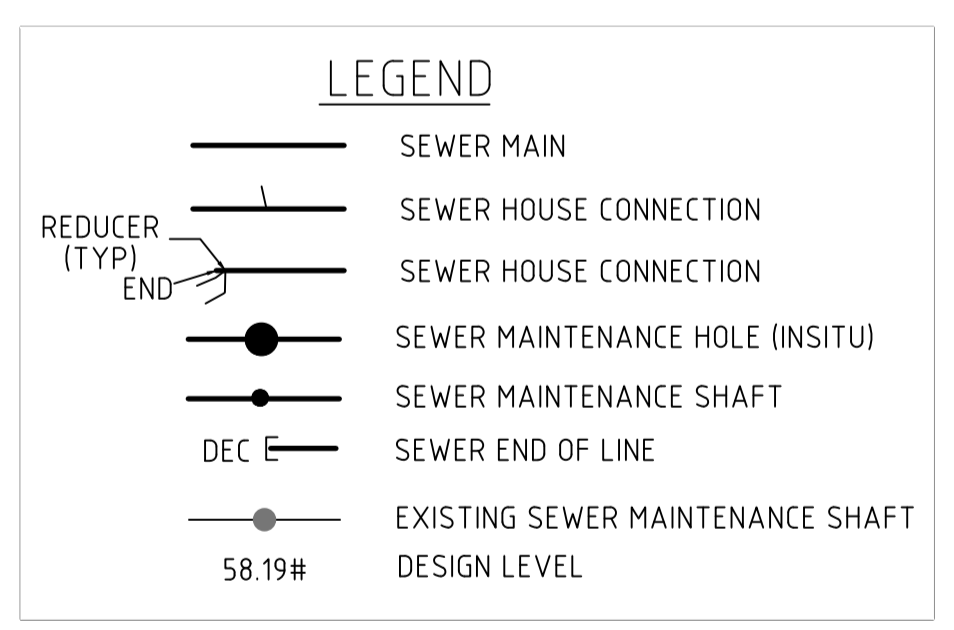

**A1**


| REV NO | DATE       | REVISION PURPOSE / DESCRIPTION | DRAWN | RPEQ | RPEQ No | INITIALS | DATE       |
|--------|------------|--------------------------------|-------|------|---------|----------|------------|
| C      | 06/11/2023 | PROGRESS PLOT AS CON SEWER     | JMc   |      |         |          | 29/08/2023 |
| B      | 19/09/2023 | PROGRESS PLOT AS CON SEWER     | JMc   |      |         |          |            |
| A      | 29/08/2023 | PROGRESS PLOT AS CON SEWER     | JMc   |      |         |          |            |

**veris**  
 BRISBANE (07) 3666 4700 WHITSUNDAYS (07) 4945 6600  
 MACKAY (07) 4957 9100 CAIRNS (07) 4052 9400  
 veris.com.au  
 ACN 615 735 727  
 Veris Australia Pty Ltd



**DAWN WALLOON**  
 Patterson Road Walloon  
**STAGE 6C1**  
 AS CONSTRUCTED SEWER

| DRAWING STATUS        |      |
|-----------------------|------|
| <b>AS CONSTRUCTED</b> |      |
| SHEET 1 OF 3 SHEETS   |      |
| DRAWING NO.           | REV. |
| 401905-6C1-AS01       | C    |

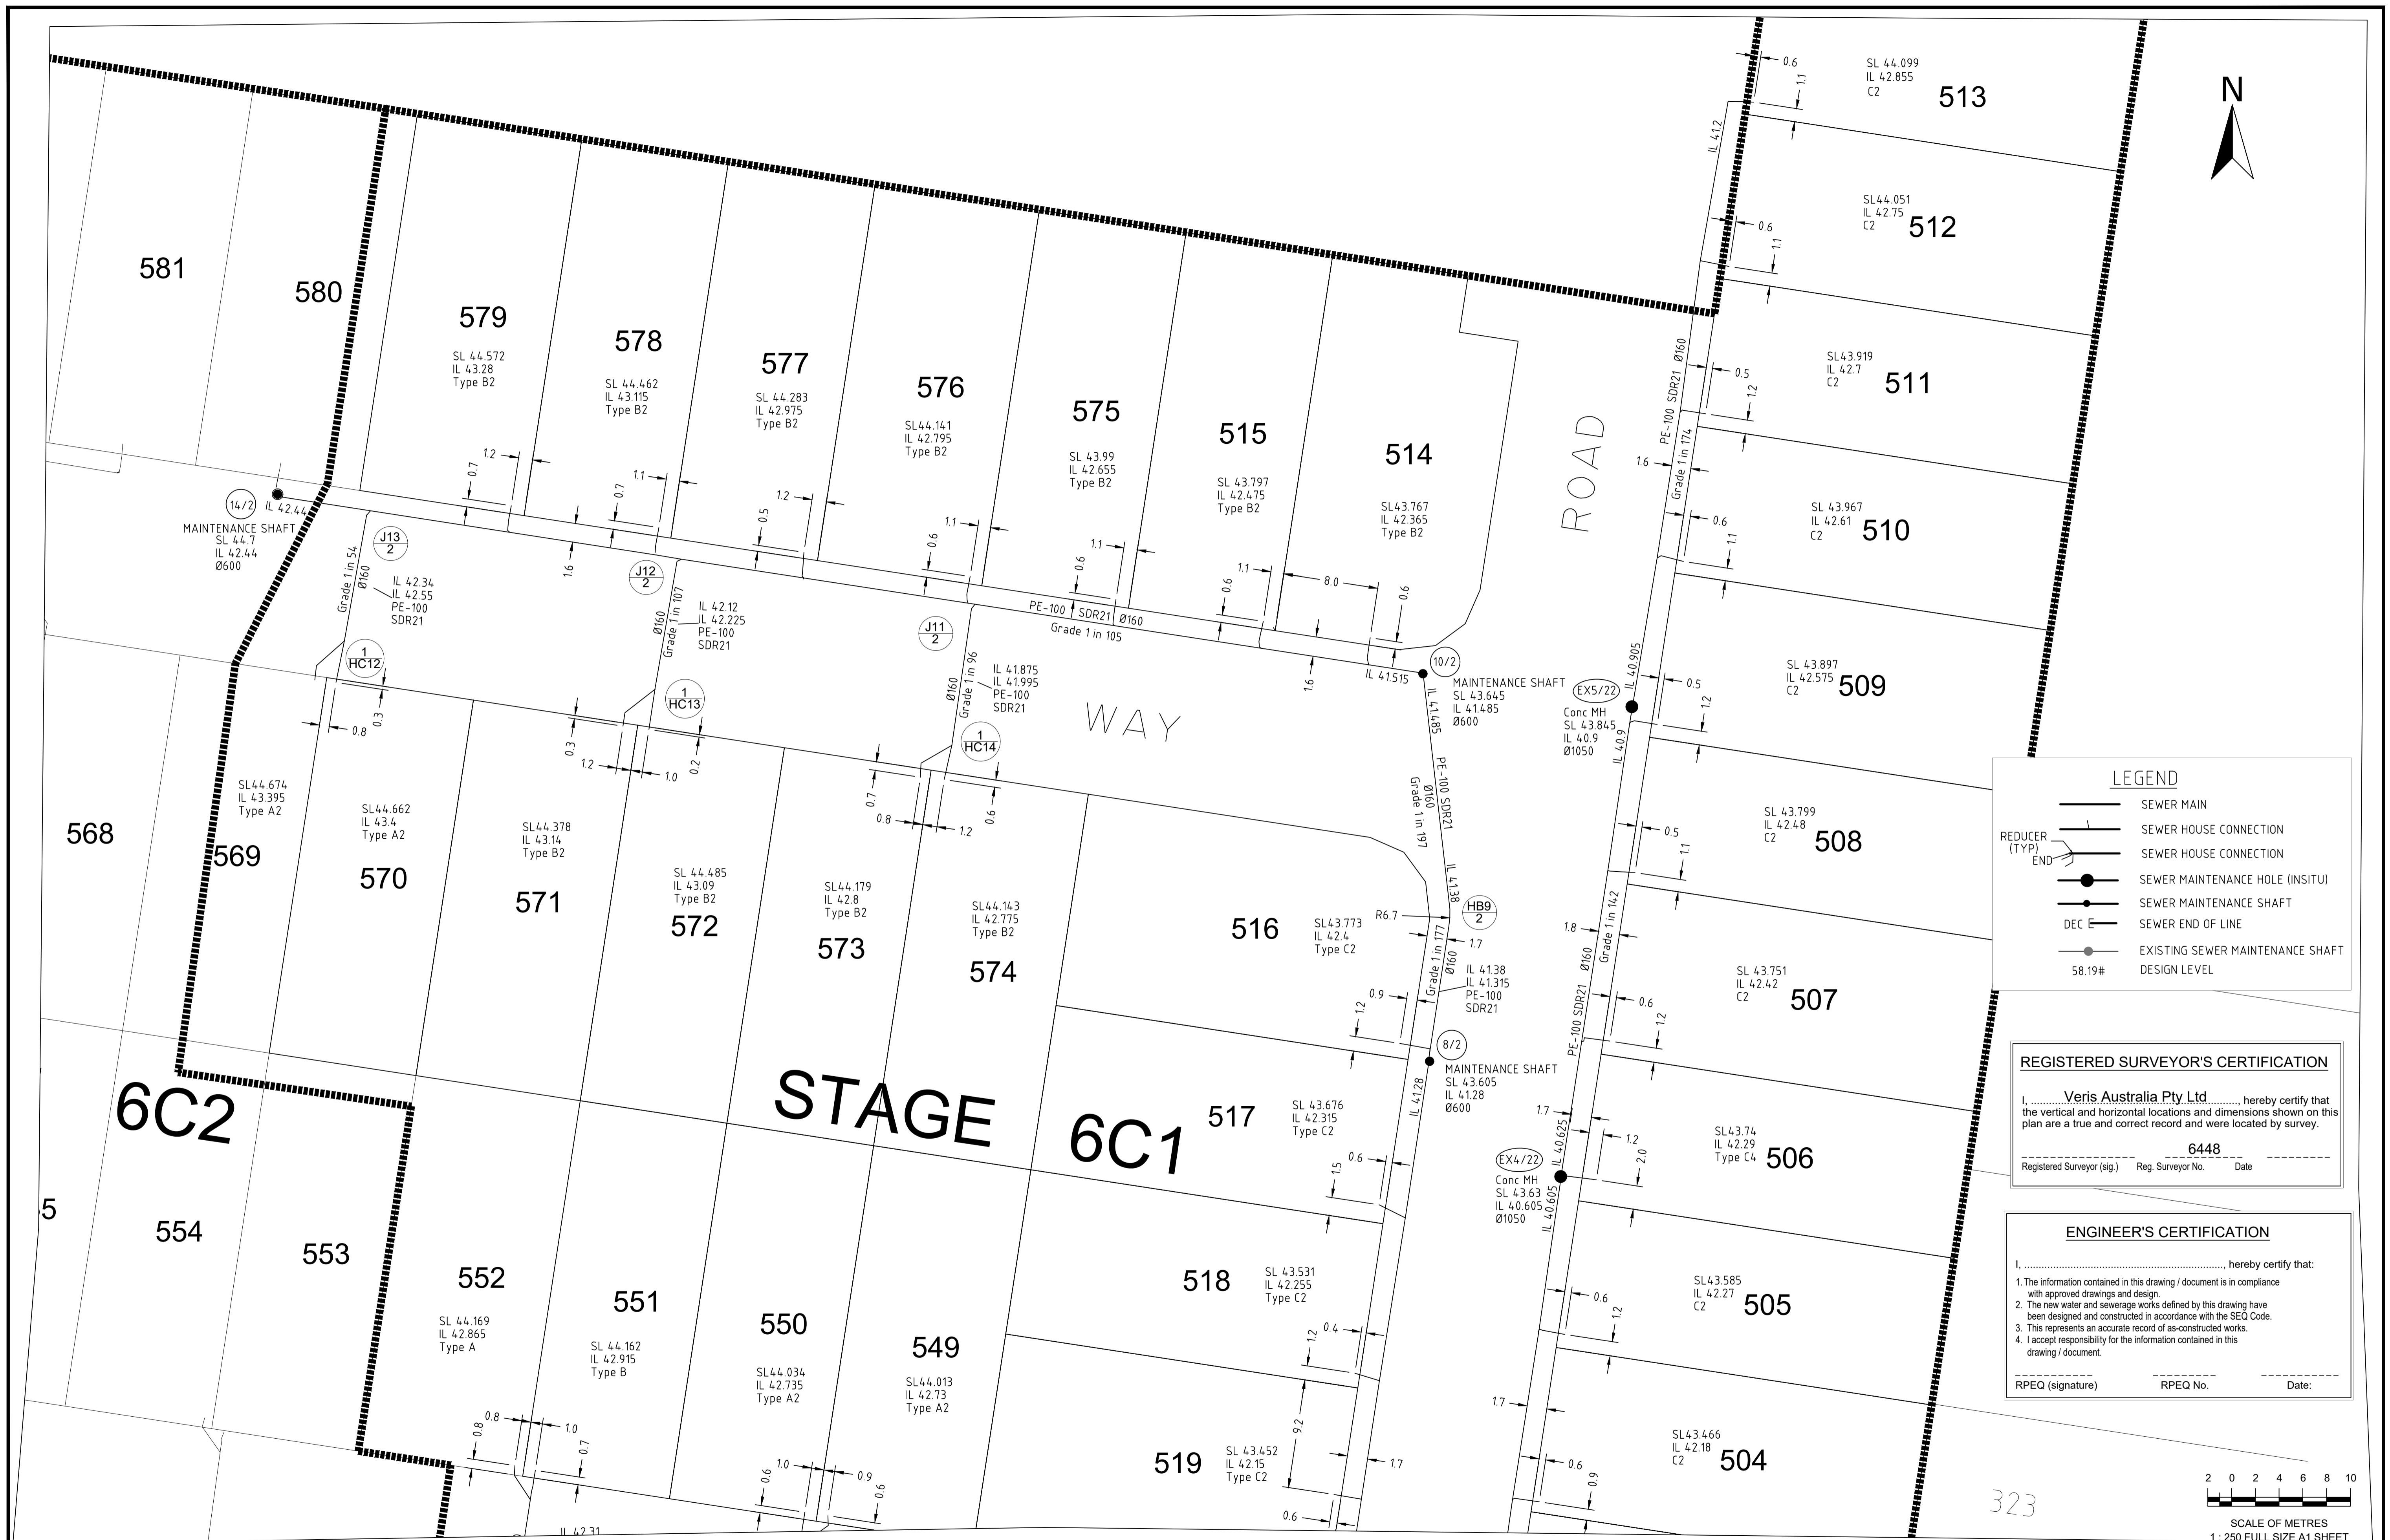

**LEGEND**

|  |                                  |
|--|----------------------------------|
|  | SEWER MAIN                       |
|  | SEWER HOUSE CONNECTION           |
|  | SEWER HOUSE CONNECTION           |
|  | SEWER MAINTENANCE HOLE (INSITU)  |
|  | SEWER MAINTENANCE SHAFT          |
|  | SEWER END OF LINE                |
|  | EXISTING SEWER MAINTENANCE SHAFT |
|  | 58.19#<br>DESIGN LEVEL           |

**REGISTERED SURVEYOR'S CERTIFICATION**

I, Veris Australia Pty Ltd, hereby certify that the vertical and horizontal locations and dimensions shown on this plan are a true and correct record and were located by survey.


6448  
Registered Surveyor (sig.)    Reg. Surveyor No.    Date

**ENGINEER'S CERTIFICATION**

I, \_\_\_\_\_, hereby certify that:

- The information contained in this drawing / document is in compliance with approved drawings and design.
- The new water and sewerage works defined by this drawing have been designed and constructed in accordance with the SEQ Code.
- This represents an accurate record of as-constructed works.
- I accept responsibility for the information contained in this drawing / document.

RPEQ (signature)    RPEQ No.    Date:

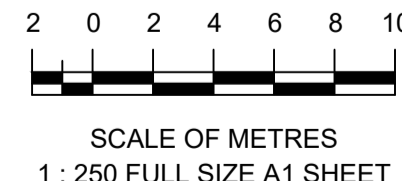

|           |        |            |                                |       |          |         |            |
|-----------|--------|------------|--------------------------------|-------|----------|---------|------------|
| <b>A1</b> | C      | 06/11/2023 | PROGRESS PLOT AS CON SEWER     | JMc   | DRAWN    | JMc     | 29/08/2023 |
|           | B      | 19/09/2023 | PROGRESS PLOT AS CON SEWER     | JMc   | CHECKED  |         |            |
|           | A      | 29/08/2023 | PROGRESS PLOT AS CON SEWER     | JMc   | APPROVED |         |            |
|           | REV NO | DATE       | REVISION PURPOSE / DESCRIPTION | DRAWN | RPEQ     | RPEQ No | INITIALS   |

BRISBANE (07) 3666 4700  
WHITSUNDAYS (07) 4945 6600  
MACKAY (07) 4957 9100  
CAIRNS (07) 4052 9400

**veris**

veris.com.au  
ACN 615 735 727  
Veris Australia Pty Ltd

**DAWN WALLOON**  
Patterson Road Walloon

**STAGE 6C1**  
AS CONSTRUCTED SEWER

|  |                  |
|--|------------------|
| <b>DRAWING STATUS</b><br><b>AS CONSTRUCTED</b> |                  |
| SHEET 2 OF 3 SHEETS                            |                  |
| DRAWING NO.<br><b>401905-6C1-AS01</b>          | REV.<br><b>C</b> |



**REGISTERED SURVEYOR'S CERTIFICATION**

I, Veris Australia Pty Ltd, hereby certify that the vertical and horizontal locations and dimensions shown on this plan are a true and correct record and were located by survey.



6448  
 Registered Surveyor (sig.) Reg. Surveyor No. Date

**ENGINEER'S CERTIFICATION**

I, \_\_\_\_\_, hereby certify that:

- The information contained in this drawing / document is in compliance with approved drawings and design.
- The new water and sewerage works defined by this drawing have been designed and constructed in accordance with the SEQ Code.
- This represents an accurate record of as-constructed works.
- I accept responsibility for the information contained in this drawing / document.

RPEQ (signature) RPEQ No. Date:

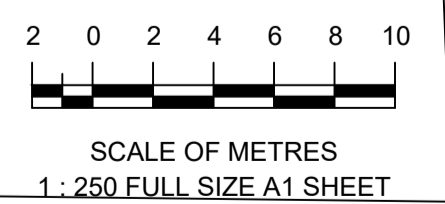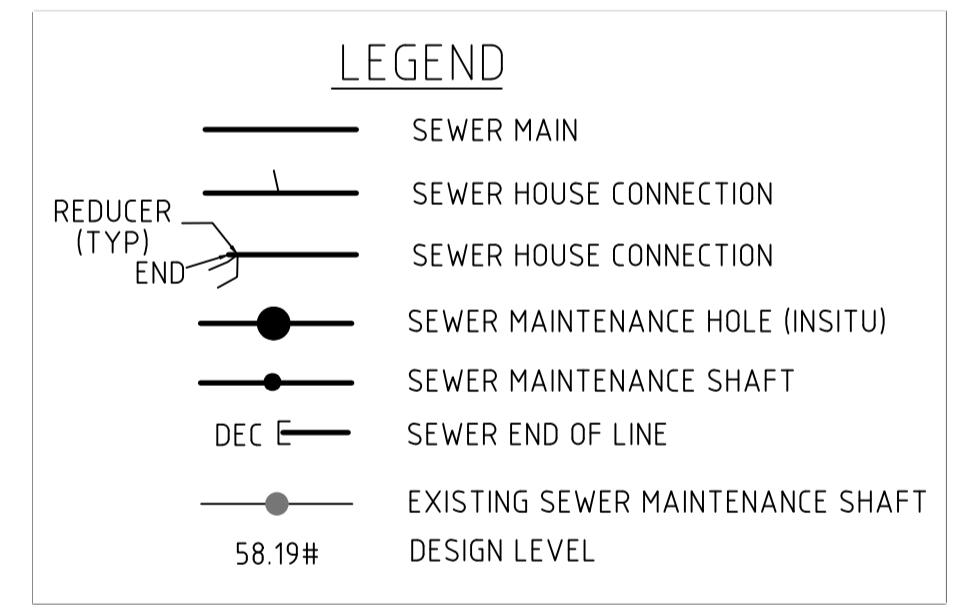

|           |        |            |                                |       |          |         |            |
|-----------|--------|------------|--------------------------------|-------|----------|---------|------------|
| <b>A1</b> | C      | 06/11/2023 | PROGRESS PLOT AS CON SEWER     | JMc   | DRAWN    | JMc     | 29/08/2023 |
|           | B      | 19/09/2023 | PROGRESS PLOT AS CON SEWER     | JMc   | CHECKED  |         |            |
|           | A      | 29/08/2023 | PROGRESS PLOT AS CON SEWER     | JMc   | APPROVED |         |            |
|           | REV NO | DATE       | REVISION PURPOSE / DESCRIPTION | DRAWN | RPEQ     | RPEQ No | INITIALS   |

BRISBANE (07) 3666 4700 WHITSUNDAYS (07) 4945 6600  
 MACKAY (07) 4957 9700 CAIRNS (07) 4052 9400

**veris** veris.com.au  
 ACN 615 735 727  
 Veris Australia Pty Ltd

**QUEENSLAND UrbanUtilities**

**DAWN WALLOON**  
 Patterson Road Walloon

**STAGE 6C1**  
 AS CONSTRUCTED SEWER

|   |                  |
|---|------------------|
| DRAWING STATUS<br><b>AS CONSTRUCTED</b> |                  |
| SHEET 3 OF 3 SHEETS                     |                  |
| DRAWING NO.<br><b>401905-6C1-AS01</b>   | REV.<br><b>C</b> |