

REGISTERED SURVEYOR'S CERTIFICATION

I, **Veris Australia Pty Ltd**, hereby certify that the vertical and horizontal locations and dimensions shown on this plan are a true and correct record and were located by survey.

Registered Surveyor (sig.) **6448** Reg. Surveyor No. Date


ENGINEER'S CERTIFICATION

I, hereby certify that:
 1. The information contained in this drawing / document is in compliance with approved drawings and design.
 2. The new water and sewerage works defined by this drawing have been designed and constructed in accordance with the SEQ Code.
 3. This represents an accurate record of as-constructed works.
 4. I accept responsibility for the information contained in this drawing / document.

RPEQ (signature) RPEQ No. Date:

LEGEND

- SEWER MAIN
- SEWER HOUSE CONNECTION
- SEWER HOUSE CONNECTION
- SEWER MAINTENANCE HOLE (INSITU)
- SEWER MAINTENANCE SHAFT
- SEWER END OF LINE
- EXISTING SEWER MAINTENANCE SHAFT
- 58.19# DESIGN LEVEL

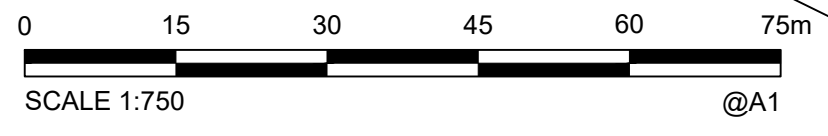

A1

REV NO	DATE	REVISION PURPOSE / DESCRIPTION	DRAWN	RPEQ	RPEQ No	INITIALS	DATE
C	07/11/2023	PROGRESS PLOT AS CON SEWER	JMc			DRAWN	28/08/2023
B	19/09/2023	PROGRESS PLOT AS CON SEWER	JMc			CHECKED	
A	28/08/2023	PROGRESS PLOT AS CON SEWER	JMc			APPROVED	

veris

BRISBANE (07) 3666 4700 WHITSUNDAYS (07) 4945 6600
 MACKAY (07) 4957 9700 CAIRNS (07) 4052 9400



veris.com.au
 ACN 615 735 727
 Veris Australia Pty Ltd



DAWN WALLOON
 Parkland Drive Walloon

STAGE 6C2
 AS CONSTRUCTED SEWER

DRAWING STATUS AS CONSTRUCTED	
SHEET 1 OF 4 SHEETS	
DRAWING NO. 401905-6C2-AS01	REV. C

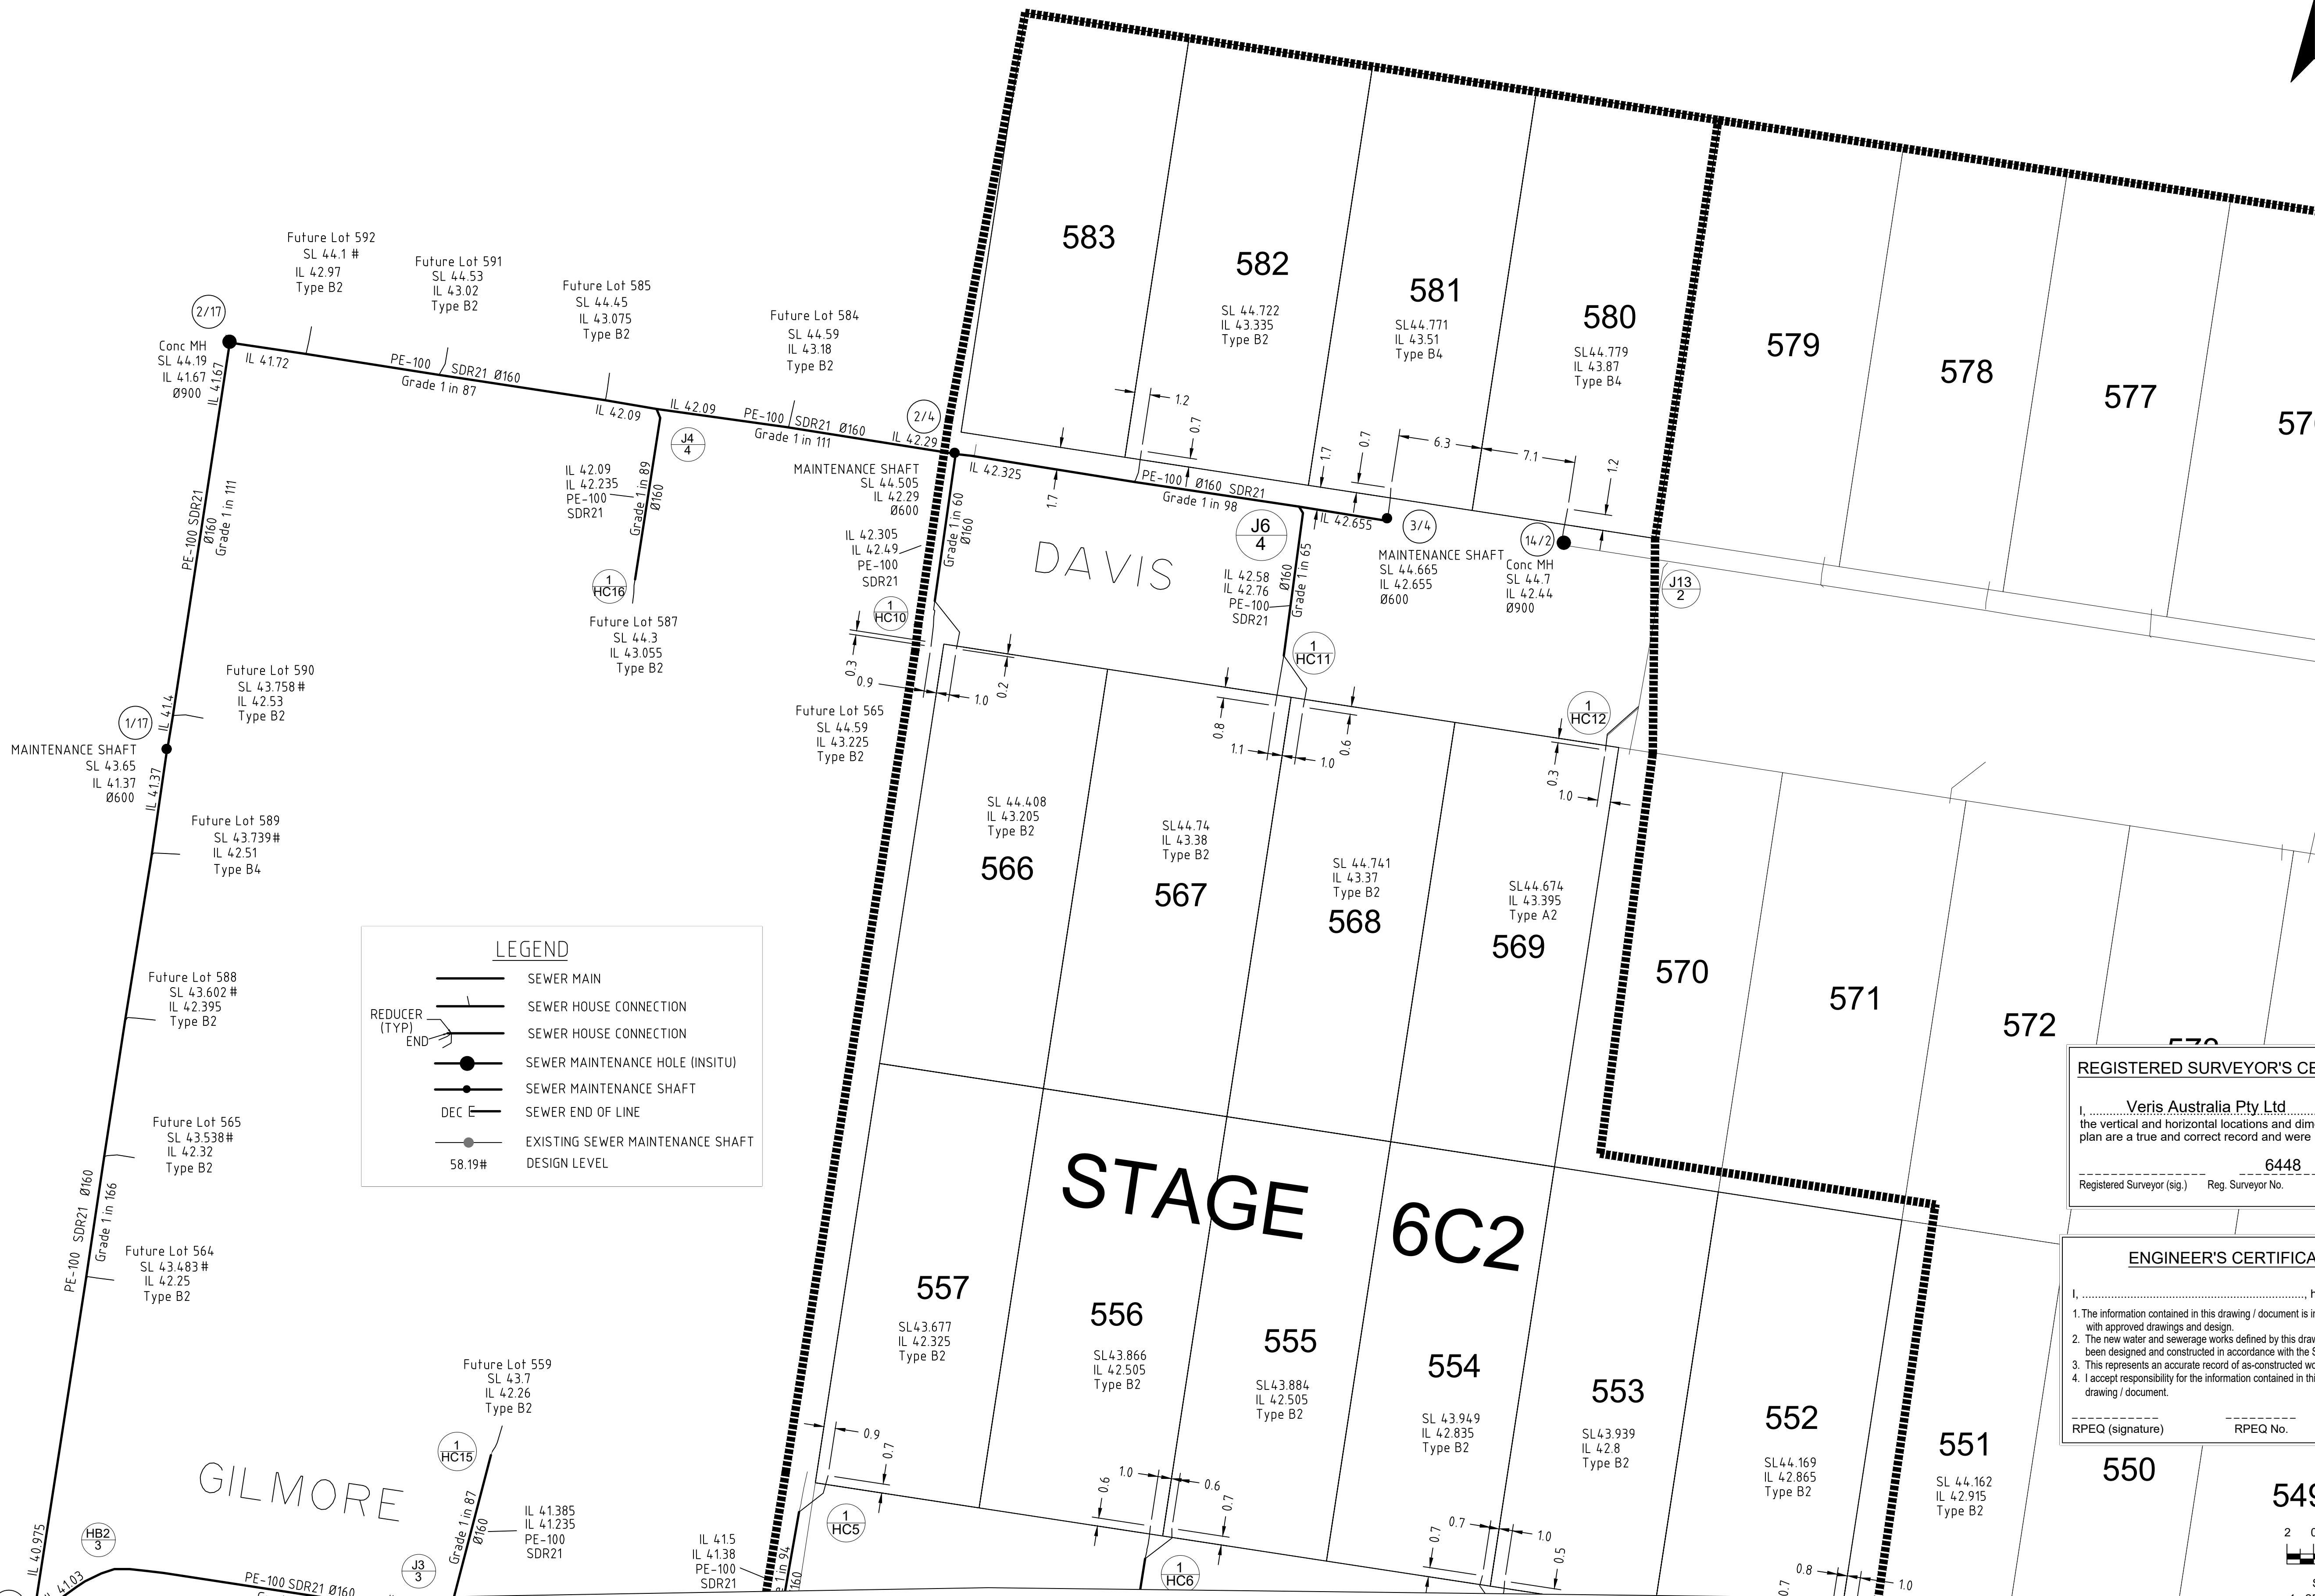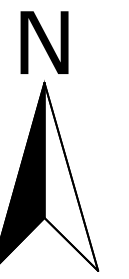

LEGEND

- SEWER MAIN
- SEWER HOUSE CONNECTION
- SEWER HOUSE CONNECTION
- SEWER MAINTENANCE HOLE (INSITU)
- SEWER MAINTENANCE SHAFT
- SEWER END OF LINE
- EXISTING SEWER MAINTENANCE SHAFT
- 58.19# DESIGN LEVEL

REDUCER (TYP) END

REGISTERED SURVEYOR'S CERTIFICATION

I, Veris Australia Pty Ltd, hereby certify that the vertical and horizontal locations and dimensions shown on this plan are a true and correct record and were located by survey.


6448
Registered Surveyor (sig.) Reg. Surveyor No. Date

ENGINEER'S CERTIFICATION

I, _____, hereby certify that:

- The information contained in this drawing / document is in compliance with approved drawings and design.
- The new water and sewerage works defined by this drawing have been designed and constructed in accordance with the SEQ Code.
- This represents an accurate record of as-constructed works.
- I accept responsibility for the information contained in this drawing / document.

RPEQ (signature) RPEQ No. Date:

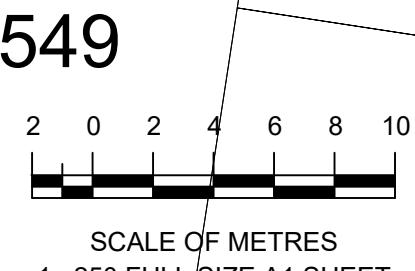

A1

REV NO	DATE	REVISION PURPOSE / DESCRIPTION	DRAWN	RPEQ	RPEQ No	INITIALS	DATE
C	07/11/2023	PROGRESS PLOT AS CON SEWER	JMc				28/08/2023
B	19/09/2023	PROGRESS PLOT AS CON SEWER	JMc				
A	28/08/2023	PROGRESS PLOT AS CON SEWER	JMc				

BRISBANE (07) 3666 4700
WHITSUNDAYS (07) 4945 6600

MACKAY (07) 4957 9100
CAIRNS (07) 4052 9400


veris.com.au
ACN 615 735 727
Veris Australia Pty Ltd



DAWN WALLOON
Parkland Drive Walloon

STAGE 6C2
AS CONSTRUCTED SEWER

DRAWING STATUS AS CONSTRUCTED	
SHEET 2 OF 4 SHEETS	
DRAWING NO. 401905-6C2-AS01	REV. C

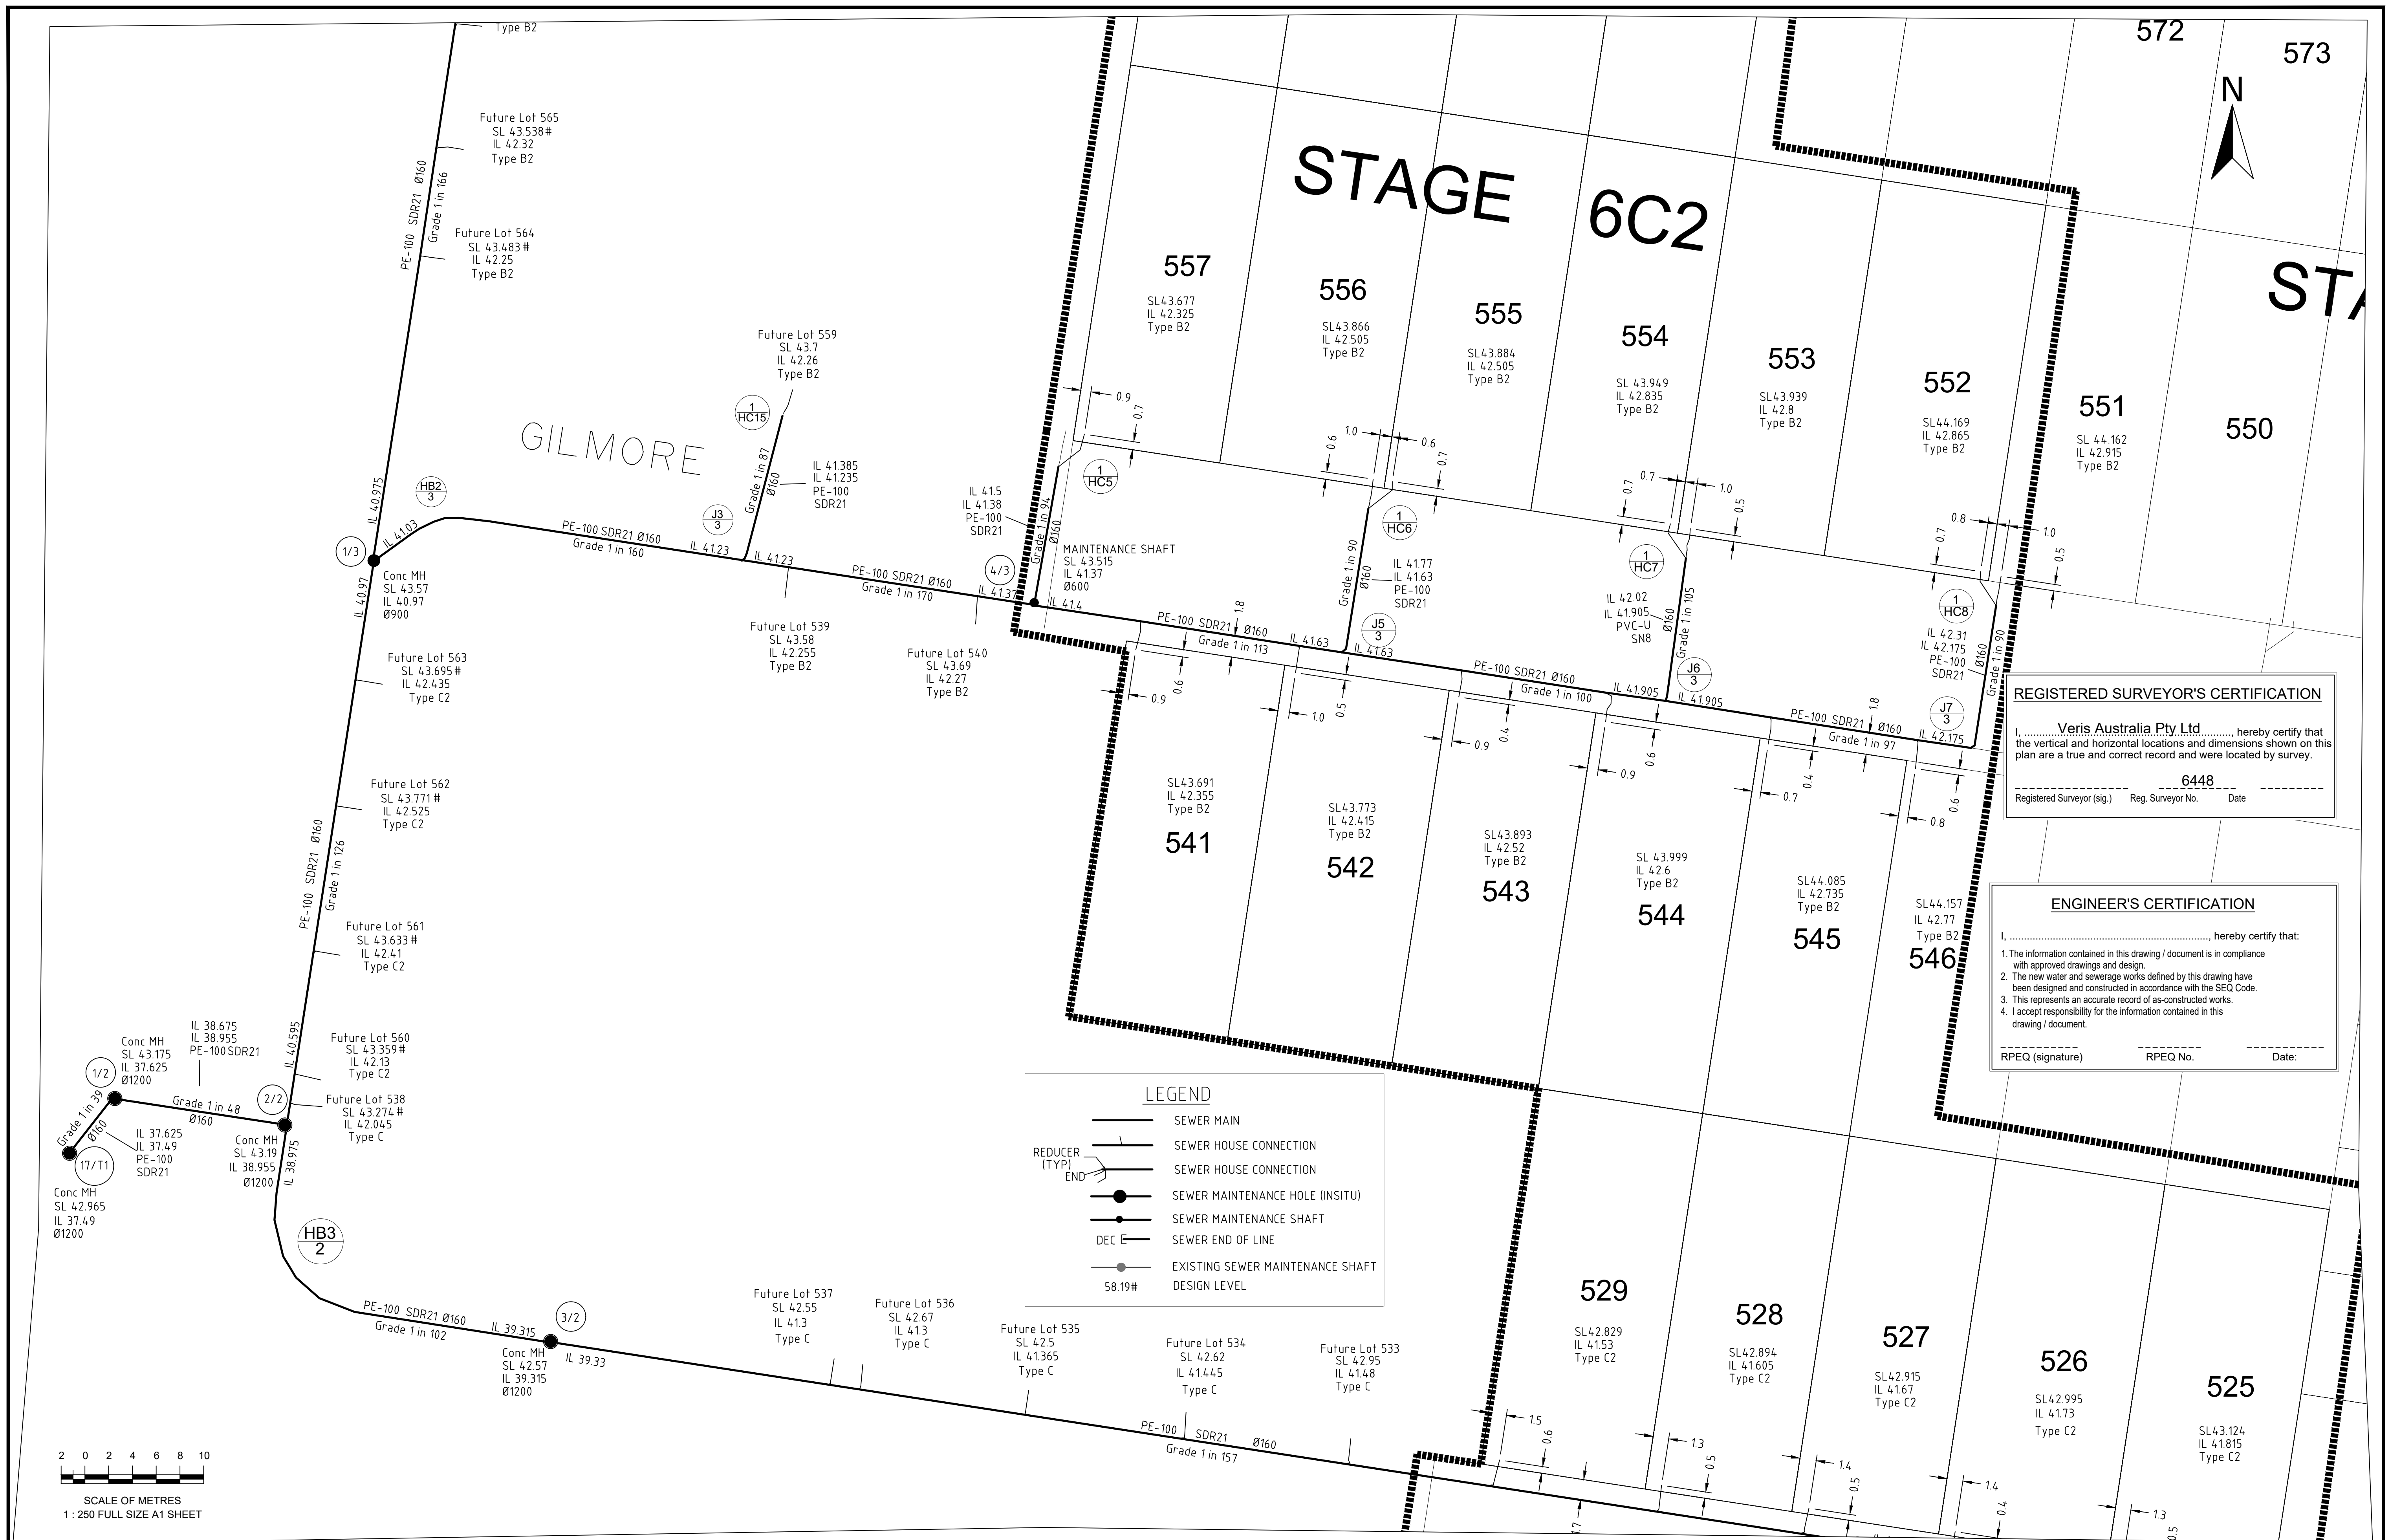

REGISTERED SURVEYOR'S CERTIFICATION

I, Veris Australia Pty Ltd, hereby certify that the vertical and horizontal locations and dimensions shown on this plan are a true and correct record and were located by survey.



6448
 Registered Surveyor (sig) Reg. Surveyor No. Date

ENGINEER'S CERTIFICATION

I, _____, hereby certify that:

- The information contained in this drawing / document is in compliance with approved drawings and design.
- The new water and sewerage works defined by this drawing have been designed and constructed in accordance with the SEQ Code.
- This represents an accurate record of as-constructed works.
- I accept responsibility for the information contained in this drawing / document.

RPEQ (signature) RPEQ No. Date:

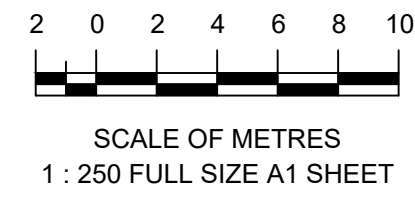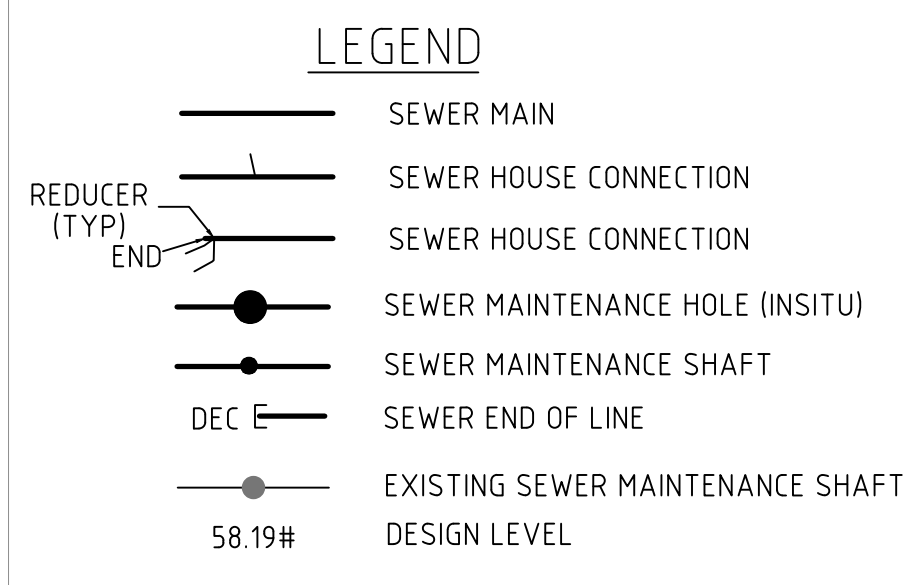


A1	C	07/11/2023	PROGRESS PLOT AS CON SEWER	JMc	DRAWN	JMc	28/08/2023
	B	19/09/2023	PROGRESS PLOT AS CON SEWER	JMc	CHECKED		
	A	28/08/2023	PROGRESS PLOT AS CON SEWER	JMc	APPROVED		
	REV NO	DATE	REVISION PURPOSE / DESCRIPTION	DRAWN	RPEQ	RPEQ No	INITIALS

BRISBANE (07) 3666 4700 WHITSUNDAYS (07) 4945 6600
 MACKAY (07) 4957 9700 CAIRNS (07) 4052 9400
 veris.com.au
 ACN 615 735 727
 Veris Australia Pty Ltd



DAWN WALLOON
 Parkland Drive Walloon
STAGE 6C2
 AS CONSTRUCTED SEWER

DRAWING STATUS AS CONSTRUCTED	
SHEET 3 OF 4 SHEETS	
DRAWING NO. 401905-6C2-AS01	REV. C

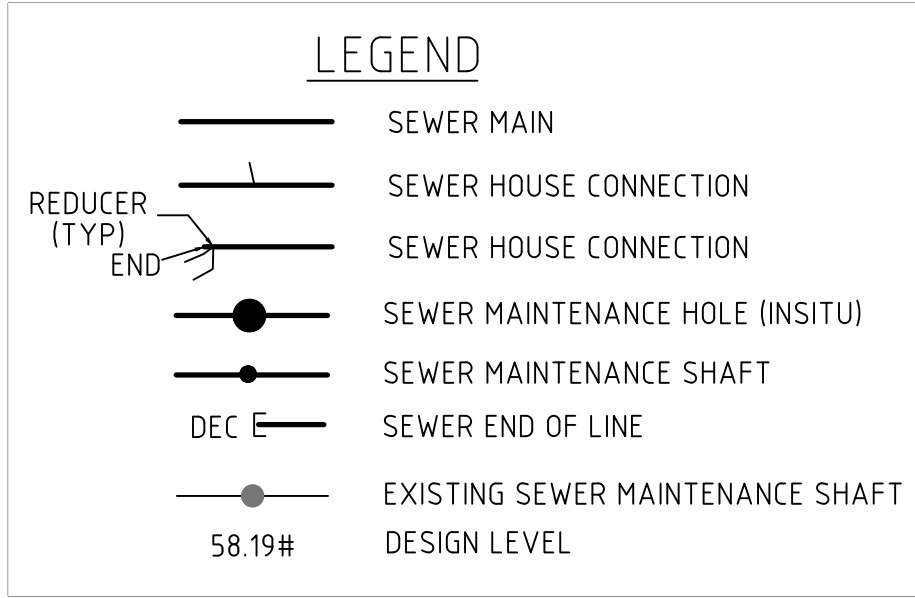

Future Lot 537
SL 42.55
IL 4.13
Type C

Future Lot 536
SL 42.67
IL 4.13
Type C

Future Lot 535
SL 42.5
IL 4.1365
Type C

Future Lot 534
SL 42.62
IL 4.1445
Type C

Future Lot 533
SL 42.95
IL 4.148
Type C

529
SL 42.829
IL 4.153
Type C2

528
SL 42.894
IL 4.1605
Type C2

527
SL 42.915
IL 4.167
Type C2

526
SL 42.995
IL 4.173
Type C2


525
SL 43.124
IL 4.1815
Type C2

521

522

523

524

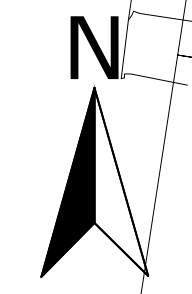

498

PARKLAND

DRIVE

490

491

492

493

494

495

496

497

498

REGISTERED SURVEYOR'S CERTIFICATION

I, Veris Australia Pty Ltd, hereby certify that the vertical and horizontal locations and dimensions shown on this plan are a true and correct record and were located by survey.

Registered Surveyor (sig.) 6448 Reg. Surveyor No. Date

ENGINEER'S CERTIFICATION

I, _____, hereby certify that:

- The information contained in this drawing / document is in compliance with approved drawings and design.
- The new water and sewerage works defined by this drawing have been designed and constructed in accordance with the SEQ Code.
- This represents an accurate record of as-constructed works.
- I accept responsibility for the information contained in this drawing / document.

RPEQ (signature) RPEQ No. Date:



SCALE OF METRES
1 : 250 FULL SIZE A1 SHEET

A1

REV NO	DATE	REVISION PURPOSE / DESCRIPTION	DRAWN	RPEQ	RPEQ No	INITIALS	DATE
C	07/11/2023	PROGRESS PLOT AS CON SEWER	JMc				28/08/2023
B	19/09/2023	PROGRESS PLOT AS CON SEWER	JMc				
A	28/08/2023	PROGRESS PLOT AS CON SEWER	JMc				

BRISBANE (07) 3666 4700
WHITSUNDAYS (07) 4945 6600
MACKAY (07) 4957 9700
CAIRNS (07) 4052 9400

veris.com.au
ACN 615 735 727
Veris Australia Pty Ltd



DAWN WALLOON
Parkland Drive Walloon

STAGE 6C2
AS CONSTRUCTED SEWER

DRAWING STATUS AS CONSTRUCTED	
SHEET 4 OF 4 SHEETS	
DRAWING NO. 401905-6C2-AS01	REV. C