

**REGISTERED SURVEYOR'S CERTIFICATION**

I, Veris Australia Pty Ltd, hereby certify that the vertical and horizontal locations and dimensions shown on this plan are a true and correct record and were located by survey.

Registered Surveyor (sig.) 6448 Reg. Surveyor No. 18/1/2024 Date

**ENGINEER'S CERTIFICATION**

I, \_\_\_\_\_, hereby certify that:

1. The information contained in this drawing / document is in compliance with approved drawings and design.
2. This represents an accurate record of as-constructed works.
3. I accept responsibility for the information contained in this drawing / document.

RPEQ (signature) \_\_\_\_\_ RPEQ No. \_\_\_\_\_ Date: \_\_\_\_\_



**LEGEND**

42.5	AS CONSTRUCTED CONTOURS (Interval 0.25m)
43	AS CONSTRUCTED CONTOURS (Interval 0.25m)
Top of Bank	CHANGE OF GRADE
Bottom of Bank	CHANGE OF GRADE
—	RETAINING WALL

**AS CONSTRUCTED**

0 20 40 60 80 100m  
SCALE 1:1000 @A1

**A1**

B	17/01/2024	FINAL	JMc			
A	27/09/2023	PROGRESS PLOT	JMc			
INDEX	DATE	REVISIONS	DRAWN	CHECKED	PASSED	

DRAWN	JMc	27/09/2023
CHECKED		
PASSED		
INITIALS		DATE




BRISBANE (07) 3066 4700  
WHITSUNDAYS (07) 4945 6600  
MACKAY (07) 4937 9100  
CAIRNS (07) 4522 9600  
veris.com.au  
ACN 615 735 727  
Veris Australia Pty Ltd



**IPSWICH CITY COUNCIL**

WATERLEA WALLOON STAGES 6B2 + 6B3  
AS CONSTRUCTED  
EARTHWORKS

SCALE	1:2000@A1
SHEET	1 OF 9 SHEETS
DRAWING NO.	401905-6B2-6B3-AEW01
	B
	A

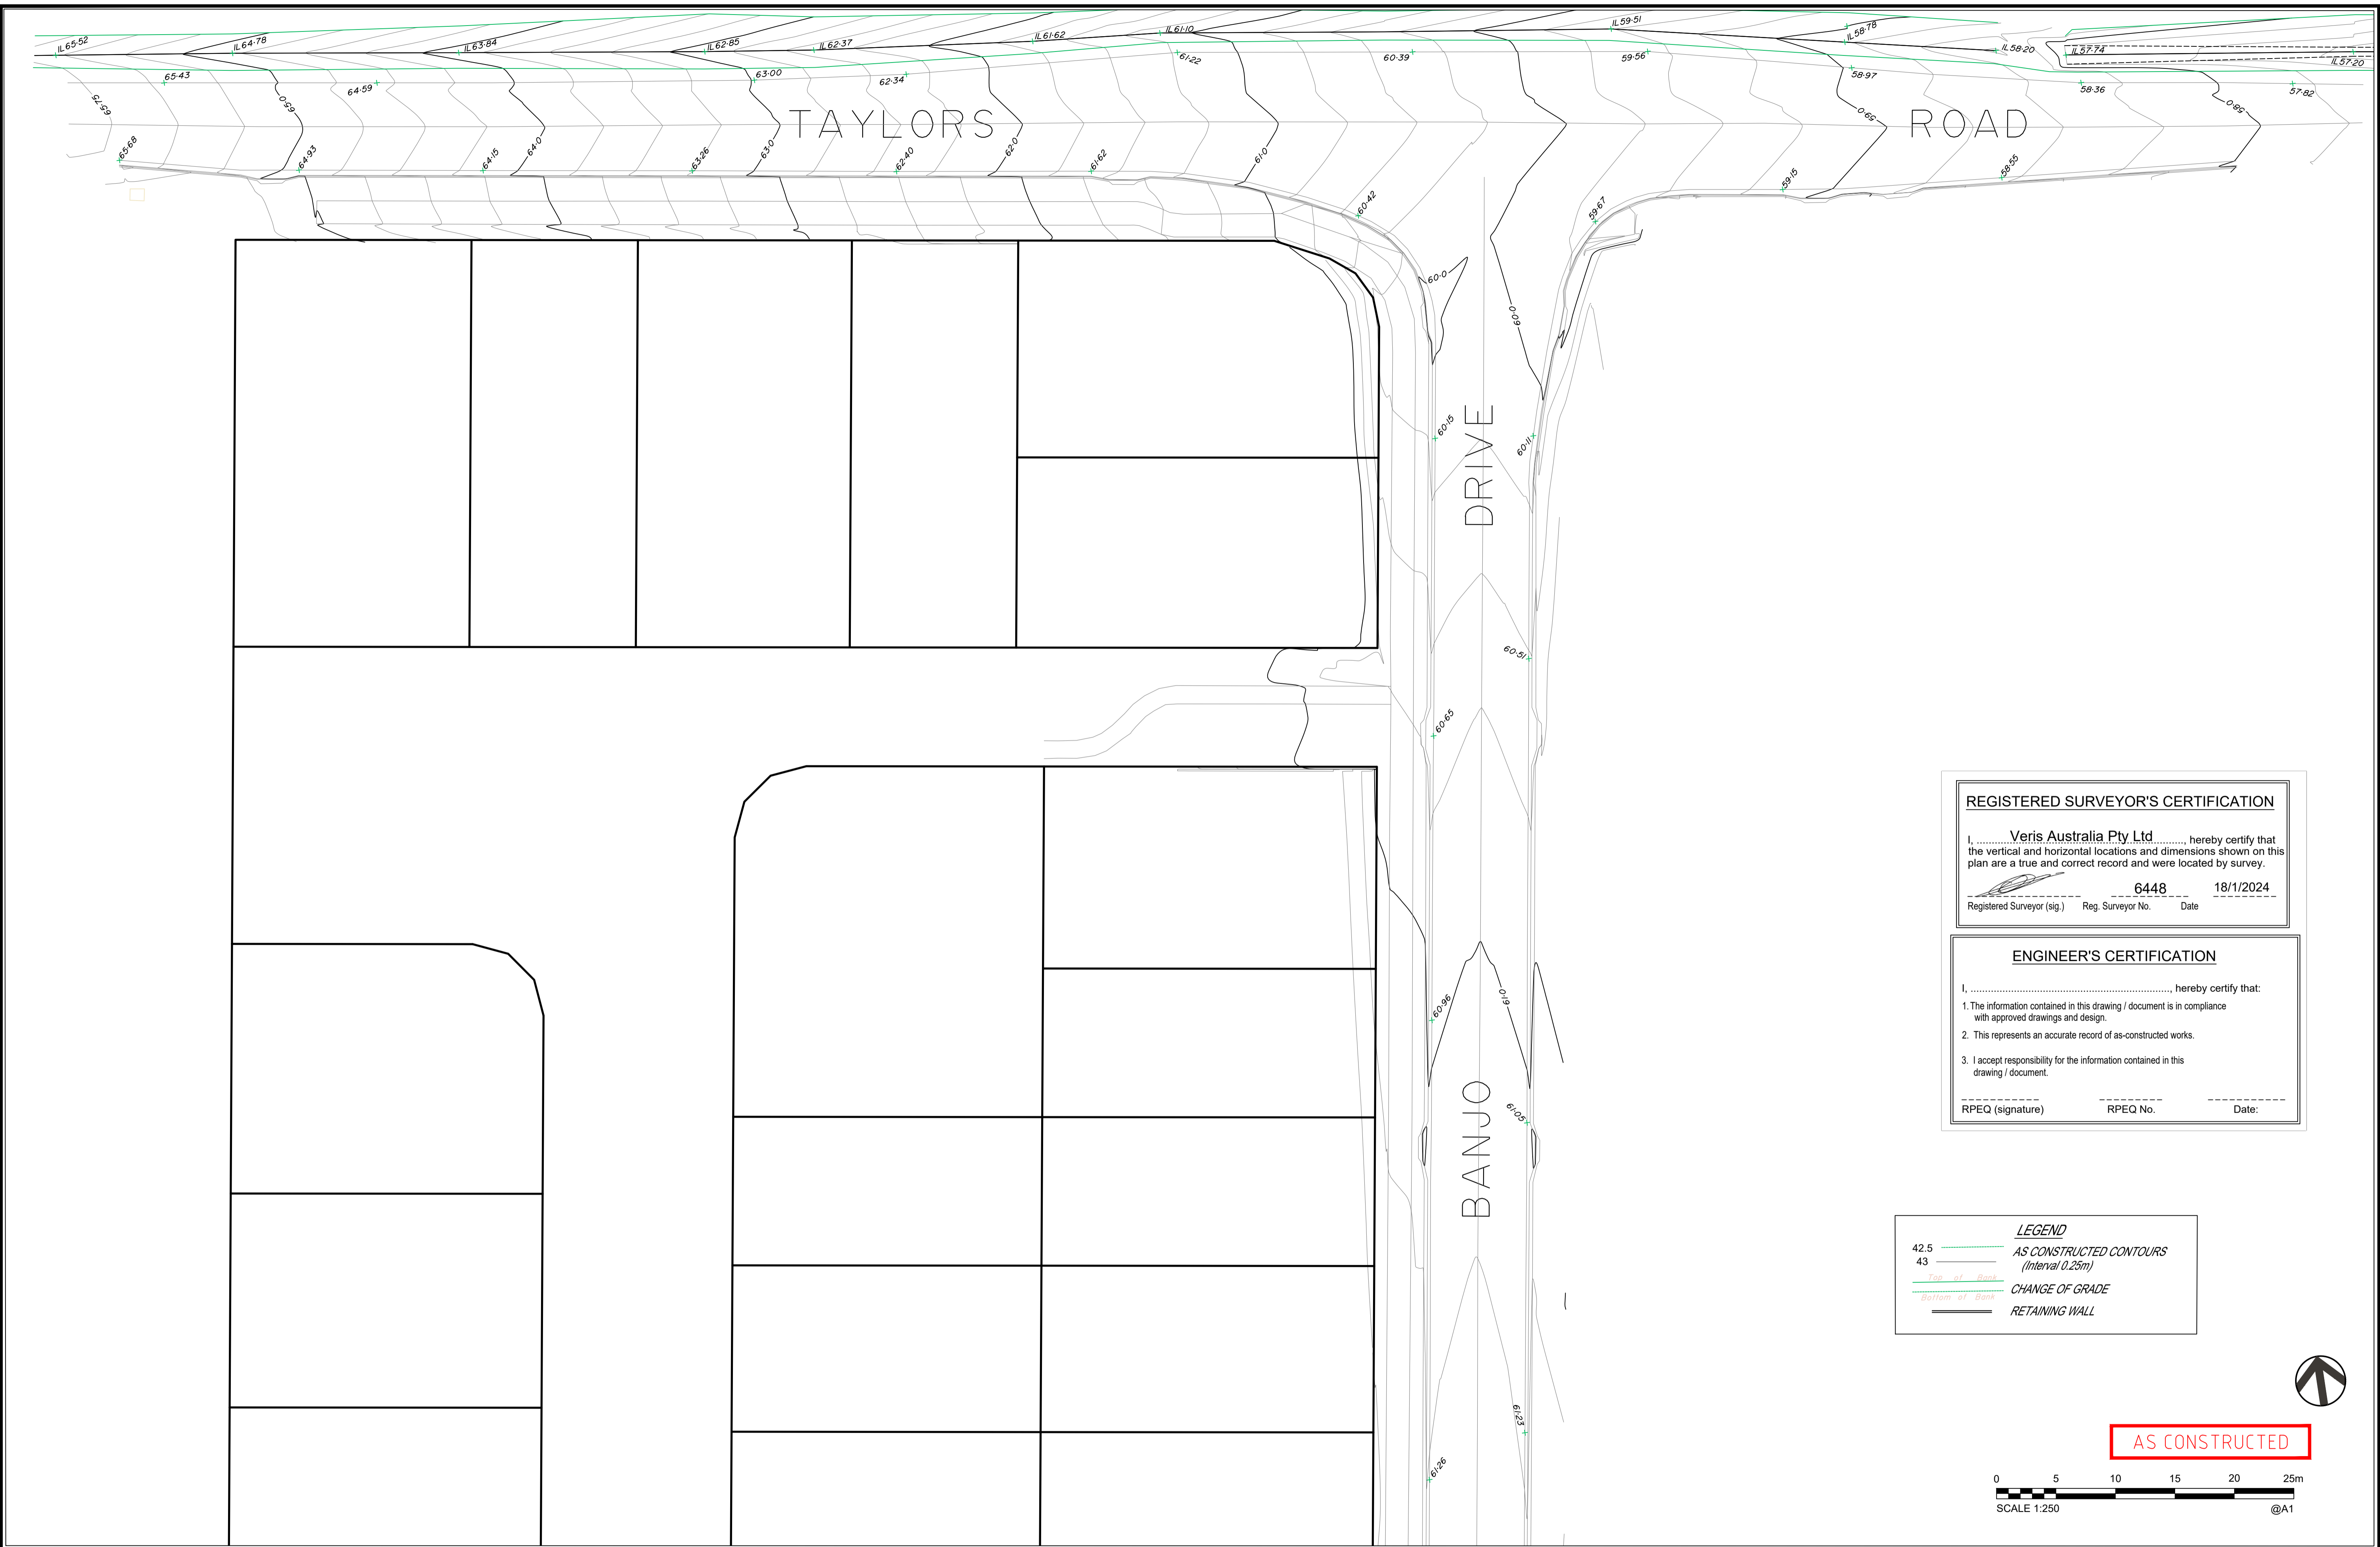

**REGISTERED SURVEYOR'S CERTIFICATION**

I, Veris Australia Pty Ltd, hereby certify that the vertical and horizontal locations and dimensions shown on this plan are a true and correct record and were located by survey.

Registered Surveyor (sig.) 6448 Reg. Surveyor No. Date 18/1/2024

**ENGINEER'S CERTIFICATION**


I, \_\_\_\_\_, hereby certify that:  
 1. The information contained in this drawing / document is in compliance with approved drawings and design.  
 2. This represents an accurate record of as-constructed works.  
 3. I accept responsibility for the information contained in this drawing / document.

RPEQ (signature) \_\_\_\_\_ RPEQ No. \_\_\_\_\_ Date: \_\_\_\_\_

**LEGEND**

42.5	AS CONSTRUCTED CONTOURS (Interval 0.25m)
43	CHANGE OF GRADE
Top of Bank	CHANGE OF GRADE
Bottom of Bank	CHANGE OF GRADE
—	RETAINING WALL

**AS CONSTRUCTED**

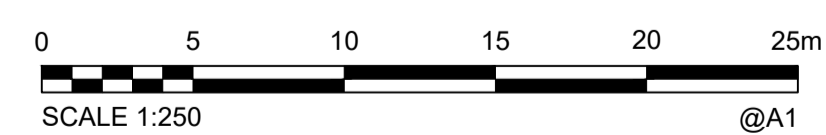

<b>A1</b>	B	17/01/2024	FINAL	JMc		
	A	27/09/2023	PROGRESS PLOT	JMc		
	INDEX	DATE	REVISIONS	DRAWN	CHECKED	PASSED


DRAWN	JMc	27/09/2023
CHECKED		
PASSED		
	INITIALS	DATE

**veris**  
 BRISBANE (07) 3966 4700 WHITSUNDAYS (07) 4945 6600  
 MACKAY (07) 4957 9100 CAIRNS (07) 4522 9400  
 veris.com.au  
 ACN 615 735 727  
 Veris Australia Pty Ltd



**IPSWICH CITY COUNCIL**  
 WATERLEA WALLOON STAGES 6B2 + 6B3  
 AS CONSTRUCTED  
 EARTHWORKS

SCALE	1:250 @A1
SHEET	2 OF 9 SHEETS
DRAWING NO.	
<b>401905-6B2-6B3-AEW01</b>	
	B
	A

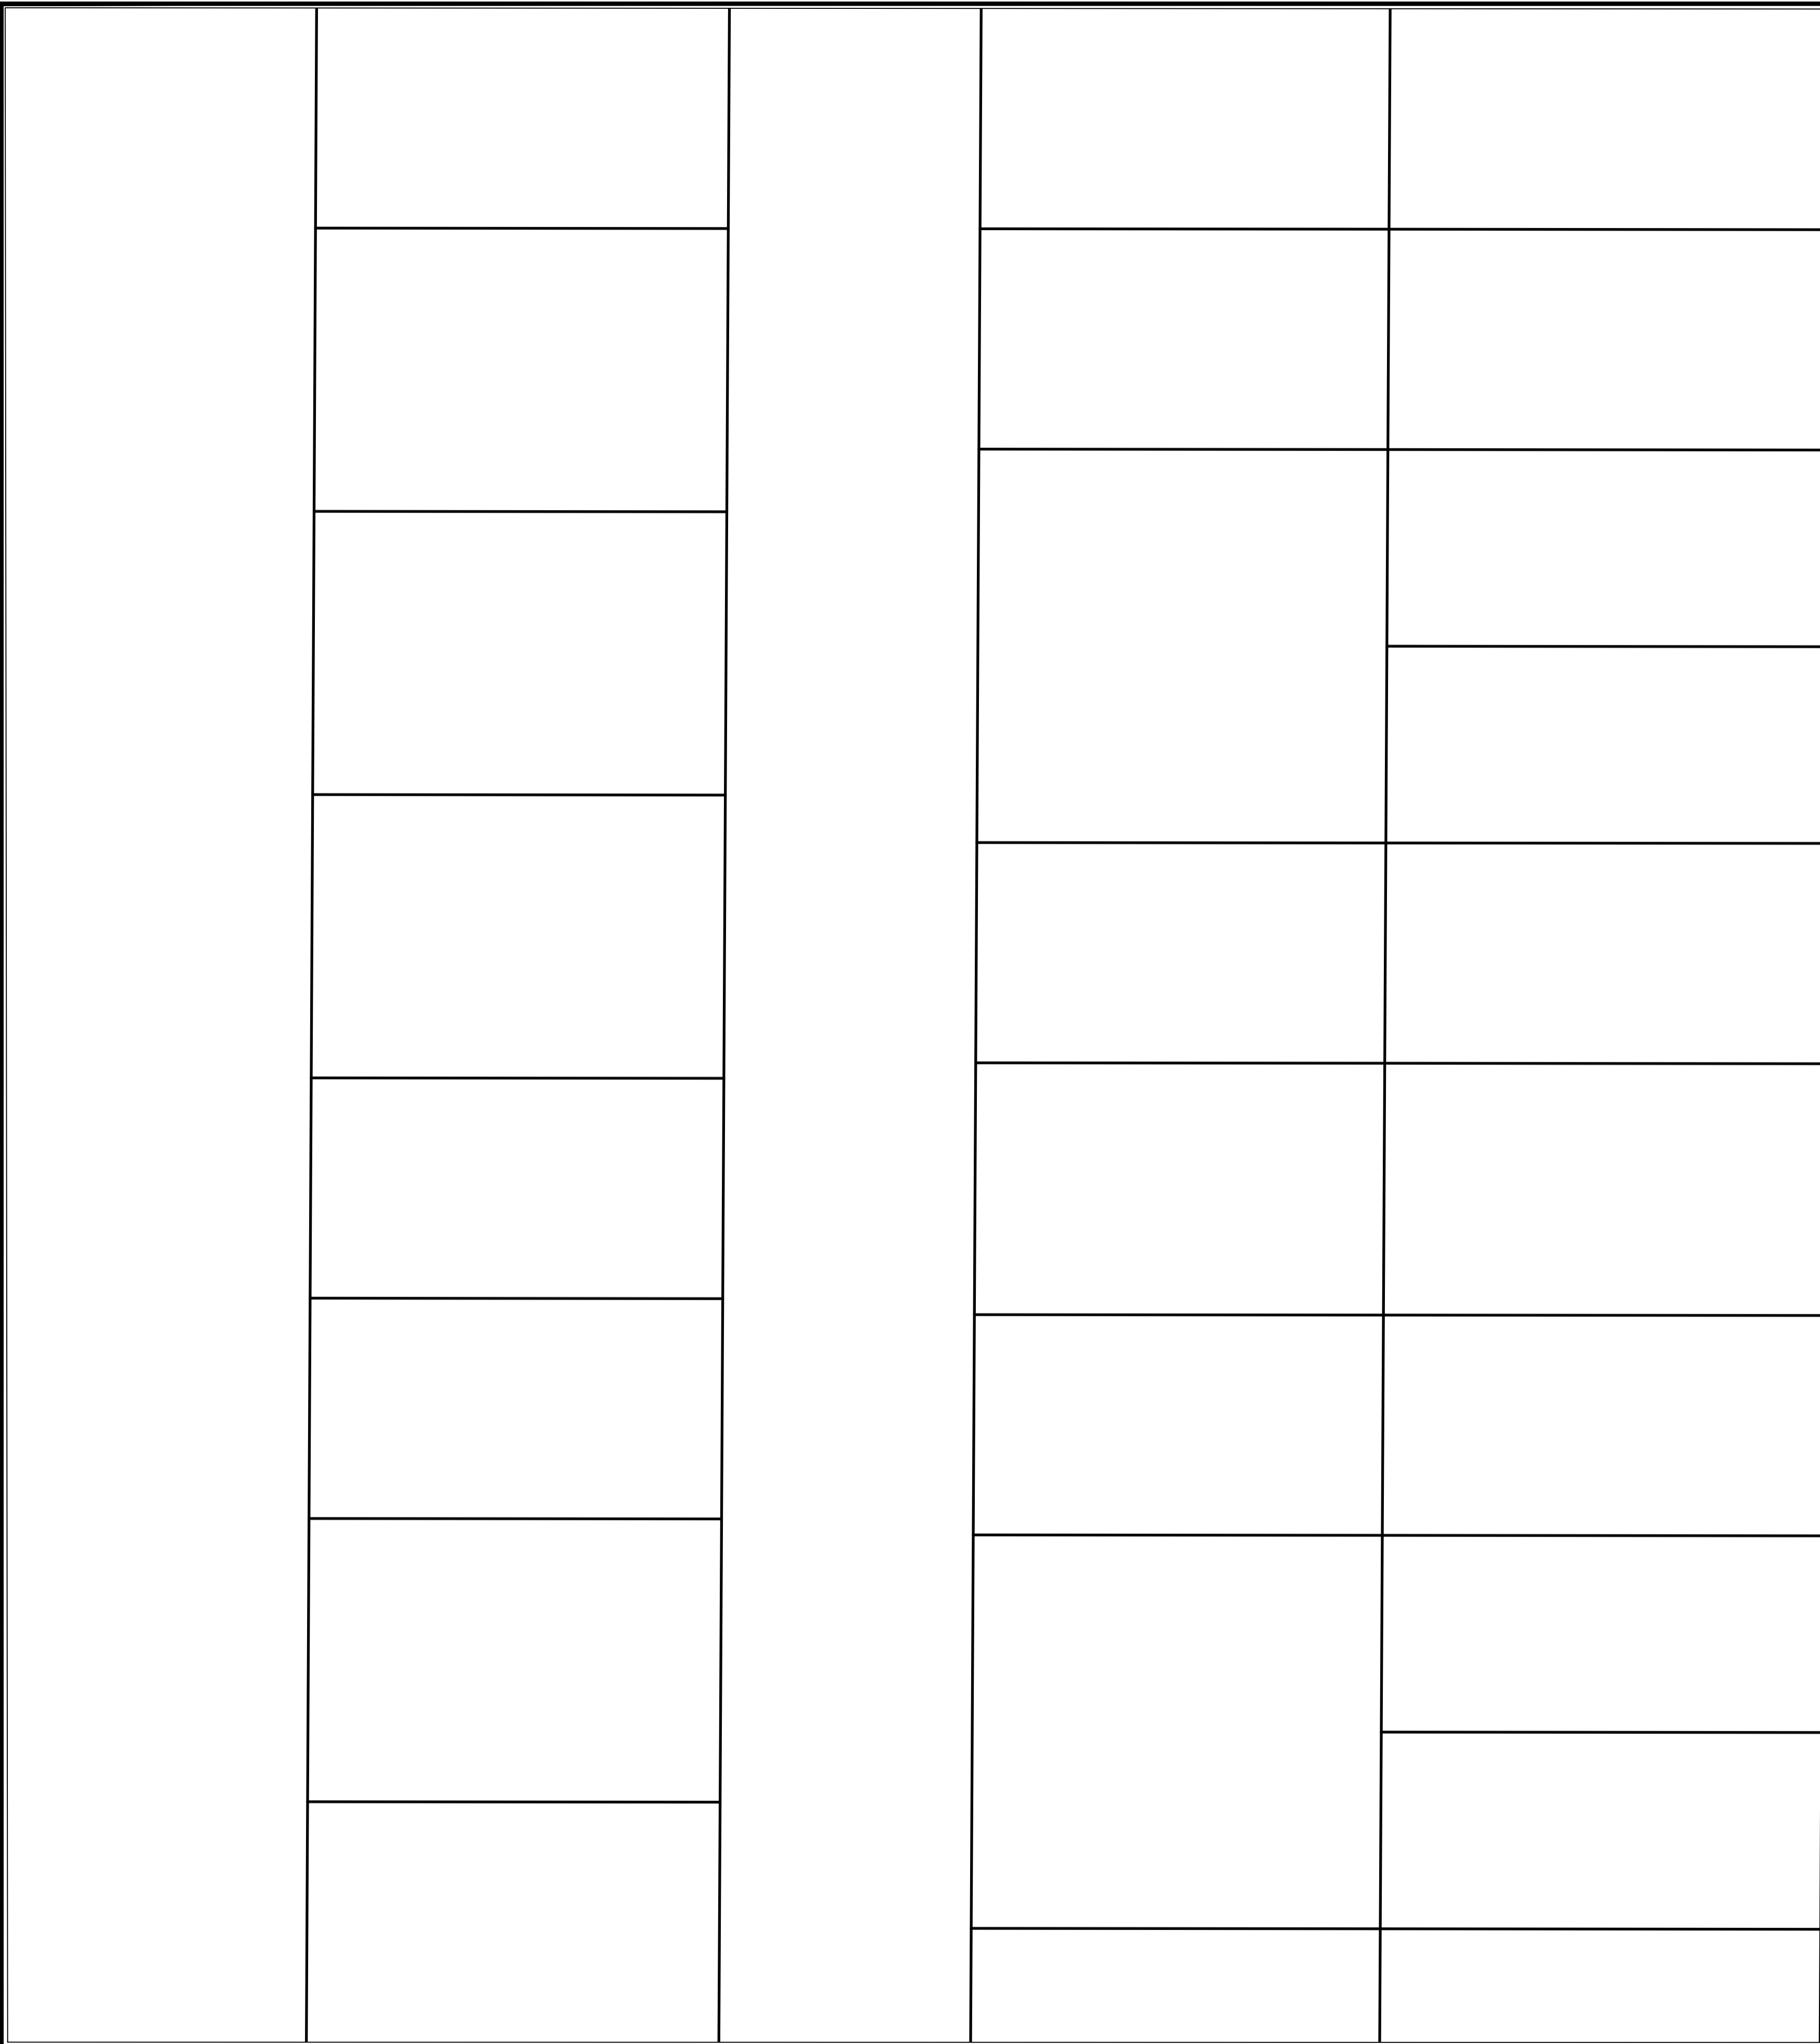

**REGISTERED SURVEYOR'S CERTIFICATION**

I, Veris Australia Pty Ltd, hereby certify that the vertical and horizontal locations and dimensions shown on this plan are a true and correct record and were located by survey.

Registered Surveyor (sig.) \_\_\_\_\_ 6448 \_\_\_\_\_ 18/1/2024  
 Reg. Surveyor No. Date

**ENGINEER'S CERTIFICATION**


I, \_\_\_\_\_ hereby certify that:  
 1. The information contained in this drawing / document is in compliance with approved drawings and design.  
 2. This represents an accurate record of as-constructed works.  
 3. I accept responsibility for the information contained in this drawing / document.

\_\_\_\_\_  
 RPEQ (signature) RPEQ No. Date:

**LEGEND**

- 42.5 AS CONSTRUCTED CONTOURS (Interval 0.25m)
- 43
- Top of Bank CHANGE OF GRADE
- Bottom of Bank
- RETAINING WALL

**AS CONSTRUCTED**

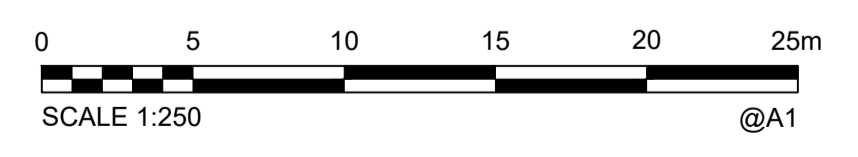

<b>A1</b>	B	17/01/2024	FINAL	JMc		
	A	27/09/2023	PROGRESS PLOT	JMc		
	INDEX	DATE	REVISIONS	DRAWN	CHECKED	PASSED

DRAWN	JMc	27/09/2023
CHECKED		
PASSED		
	INITIALS	DATE

BRISBANE (07) 3966 4700 WHITSUNDAYS (07) 4945 6600  
 MACKAY (07) 4957 3700 CAIRNS (07) 4522 3400  
 veris.com.au  
 ACN 615 735 727  
 Veris Australia Pty Ltd



**IPSWICH CITY COUNCIL**

WATERLEA WALLOON STAGES 6B2 + 6B3  
 AS CONSTRUCTED  
 EARTHWORKS

SCALE	1:250 @A1
SHEET	3 OF 9 SHEETS
DRAWING NO.	
401905-6B2-6B3-AEW01	
	B
	A

**REGISTERED SURVEYOR'S CERTIFICATION**

I, ..... Veris Australia Pty Ltd ..... hereby certify that the vertical and horizontal locations and dimensions shown on this plan are a true and correct record and were located by survey.

Registered Surveyor (sig.) \_\_\_\_\_ 6448 \_\_\_\_\_ 18/1/2024  
 Reg. Surveyor No. Date

**ENGINEER'S CERTIFICATION**

I, ..... hereby certify that:

1. The information contained in this drawing / document is in compliance with approved drawings and design.
2. This represents an accurate record of as-constructed works.
3. I accept responsibility for the information contained in this drawing / document.

RPEQ (signature) \_\_\_\_\_ RPEQ No. \_\_\_\_\_ Date: \_\_\_\_\_

**LEGEND**


42.5 AS CONSTRUCTED CONTOURS  
 (Interval 0.25m)

43 CHANGE OF GRADE


Top of Bank

Bottom of Bank

RETAINING WALL

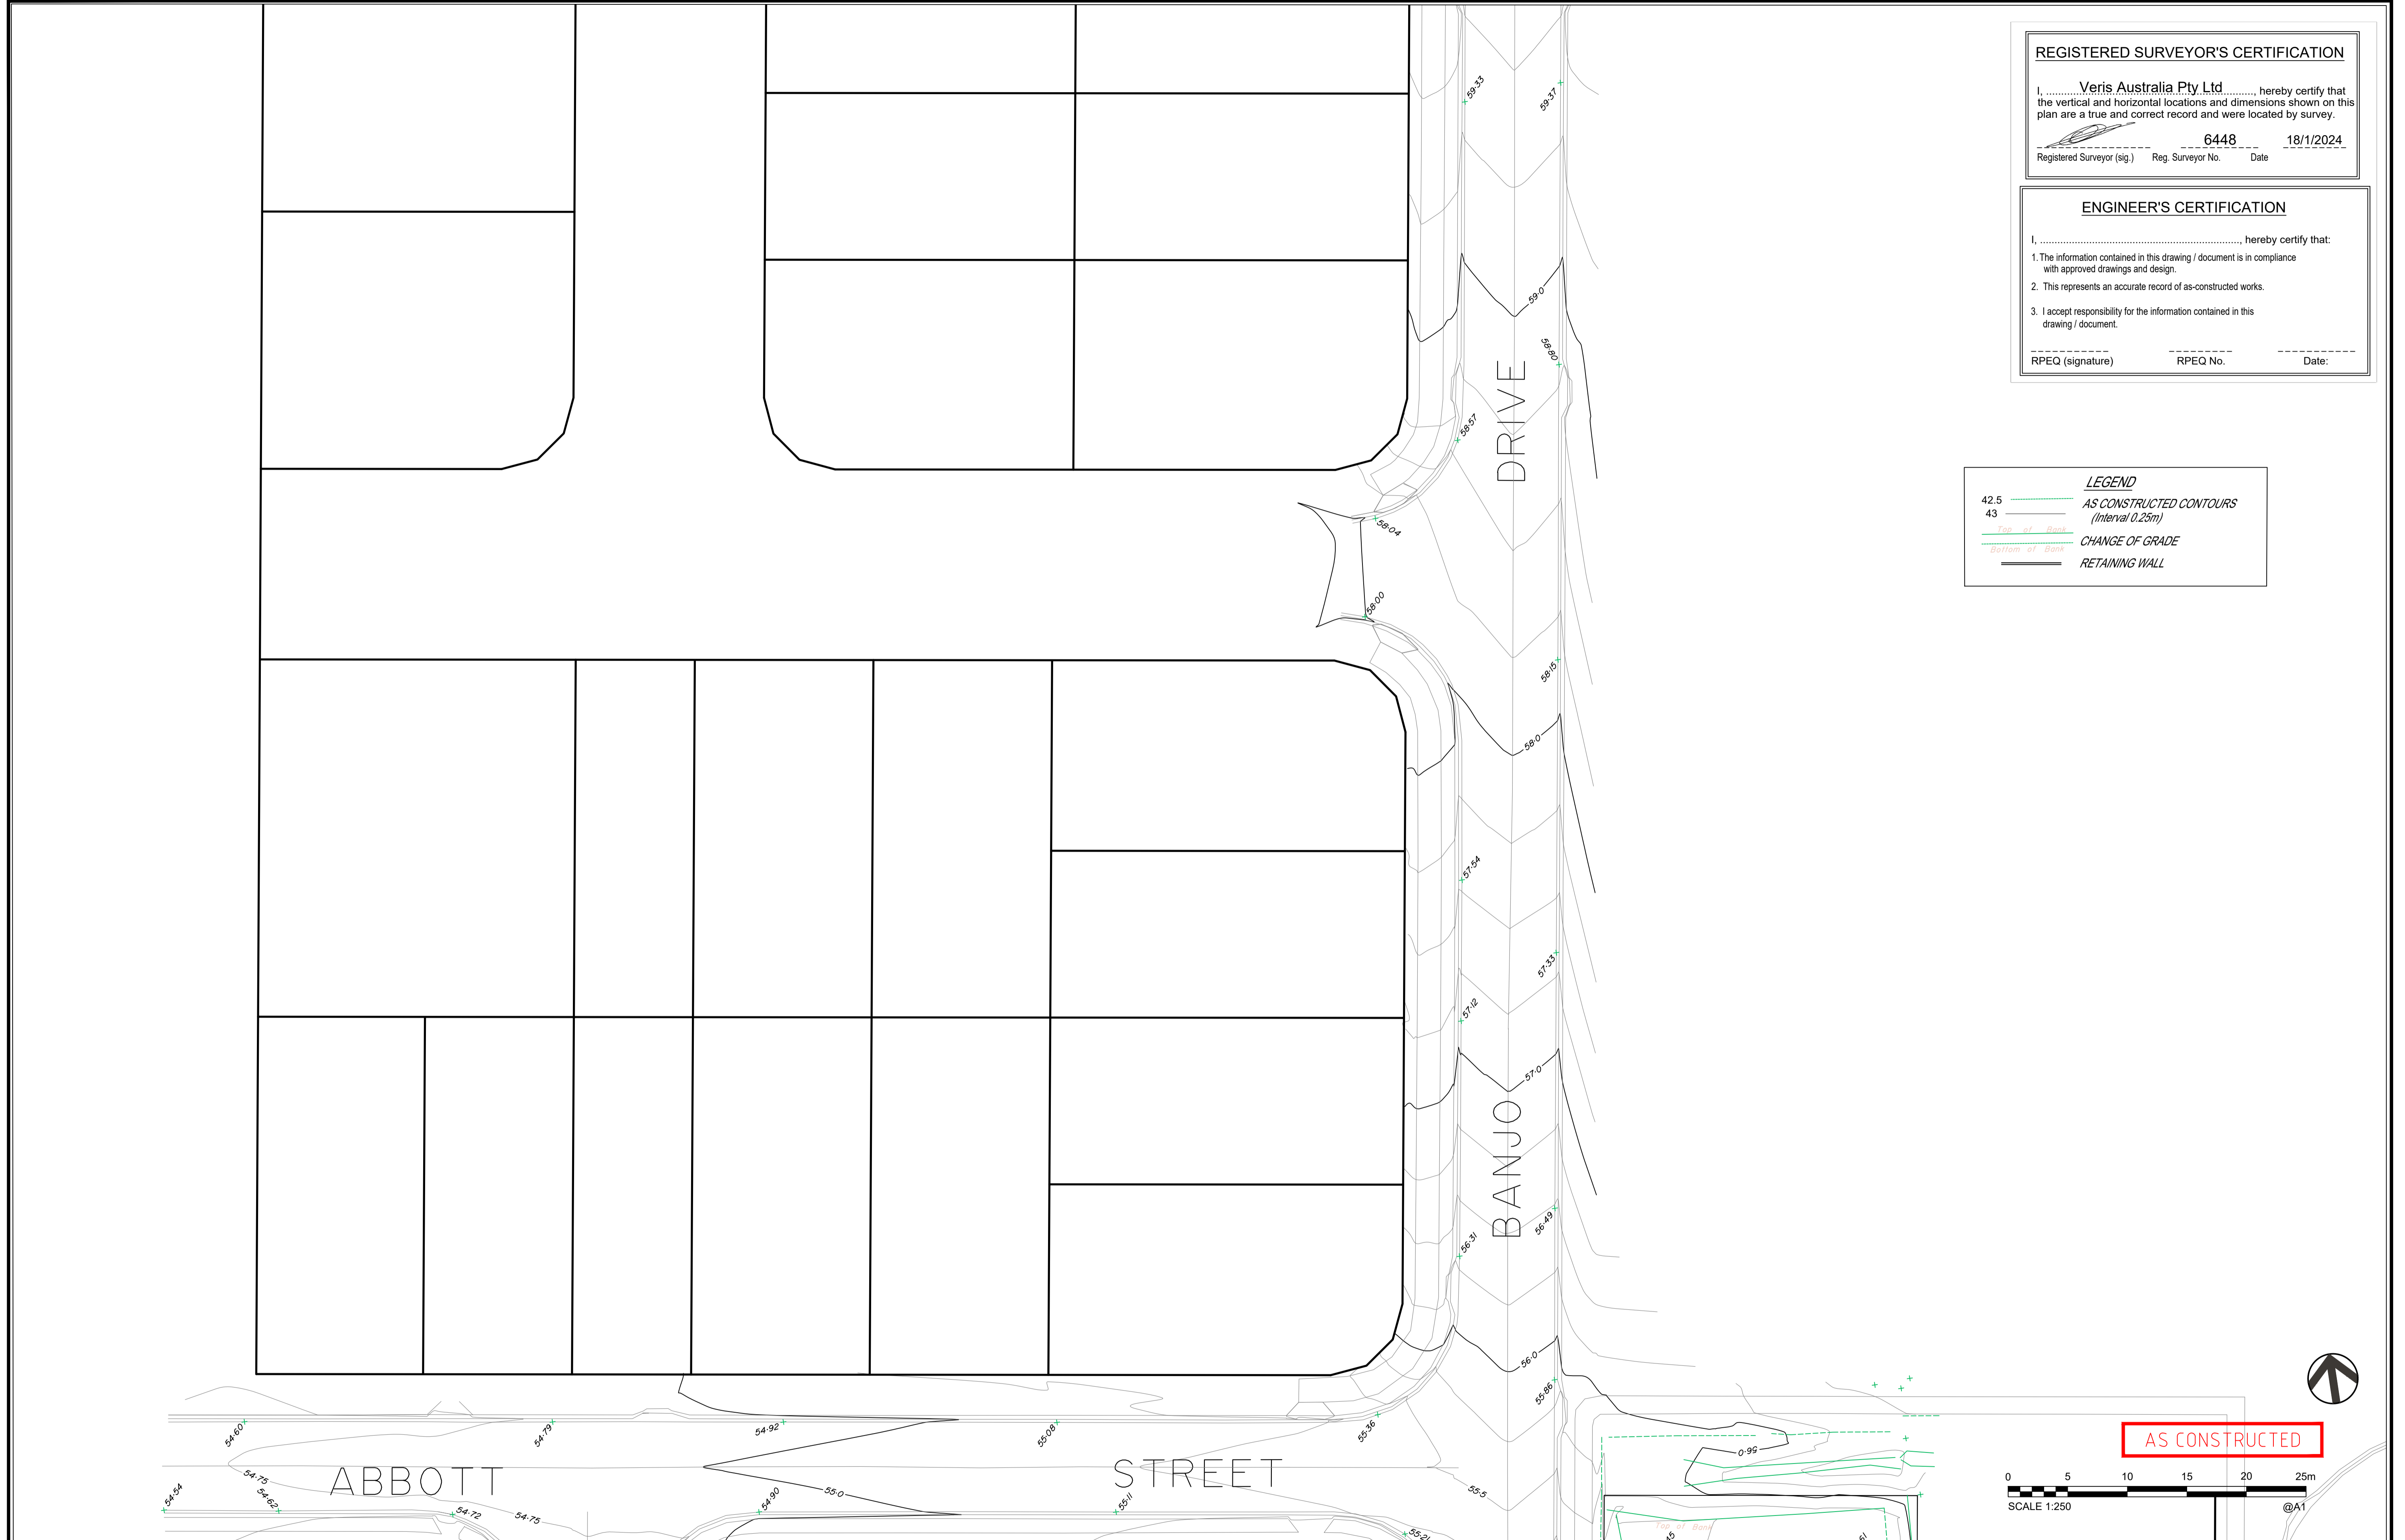

**AS CONSTRUCTED**

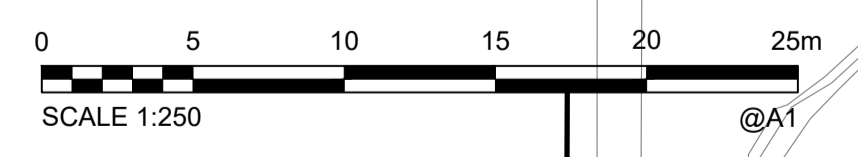


<b>A1</b>	B	17/01/2024	FINAL	JMc				
	A	27/09/2023	PROGRESS PLOT	JMc				
	INDEX	DATE	REVISIONS	DRAWN	CHECKED	PASSED	INITIALS	DATE

DRAWN	JMc	27/09/2023
CHECKED		
PASSED		

**veris**


BRISBANE (07) 3966 4700 WHITSUNDAYS (07) 4945 6600  
 MACKAY (07) 4957 3700 CAIRNS (07) 4522 3400  
 veris.com.au  
 ACN 615 735 727  
 Veris Australia Pty Ltd

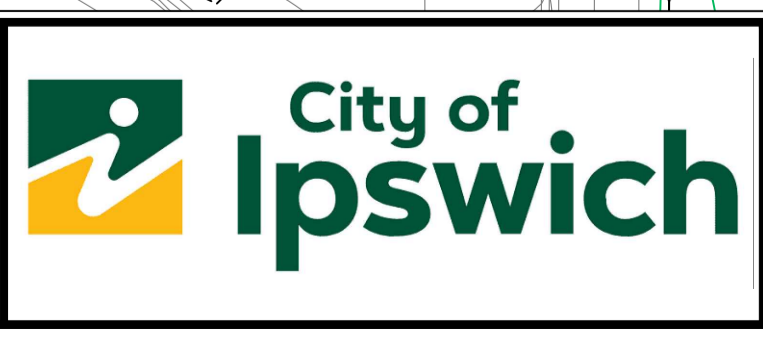

**IPSWICH CITY COUNCIL**

WATERLEA WALLOON STAGES 6B2 + 6B3  
 AS CONSTRUCTED  
 EARTHWORKS

SCALE	1:250 @A1
SHEET	4 OF 9 SHEETS
DRAWING NO.	401905-6B2-6B3-AEW01
	B
	A

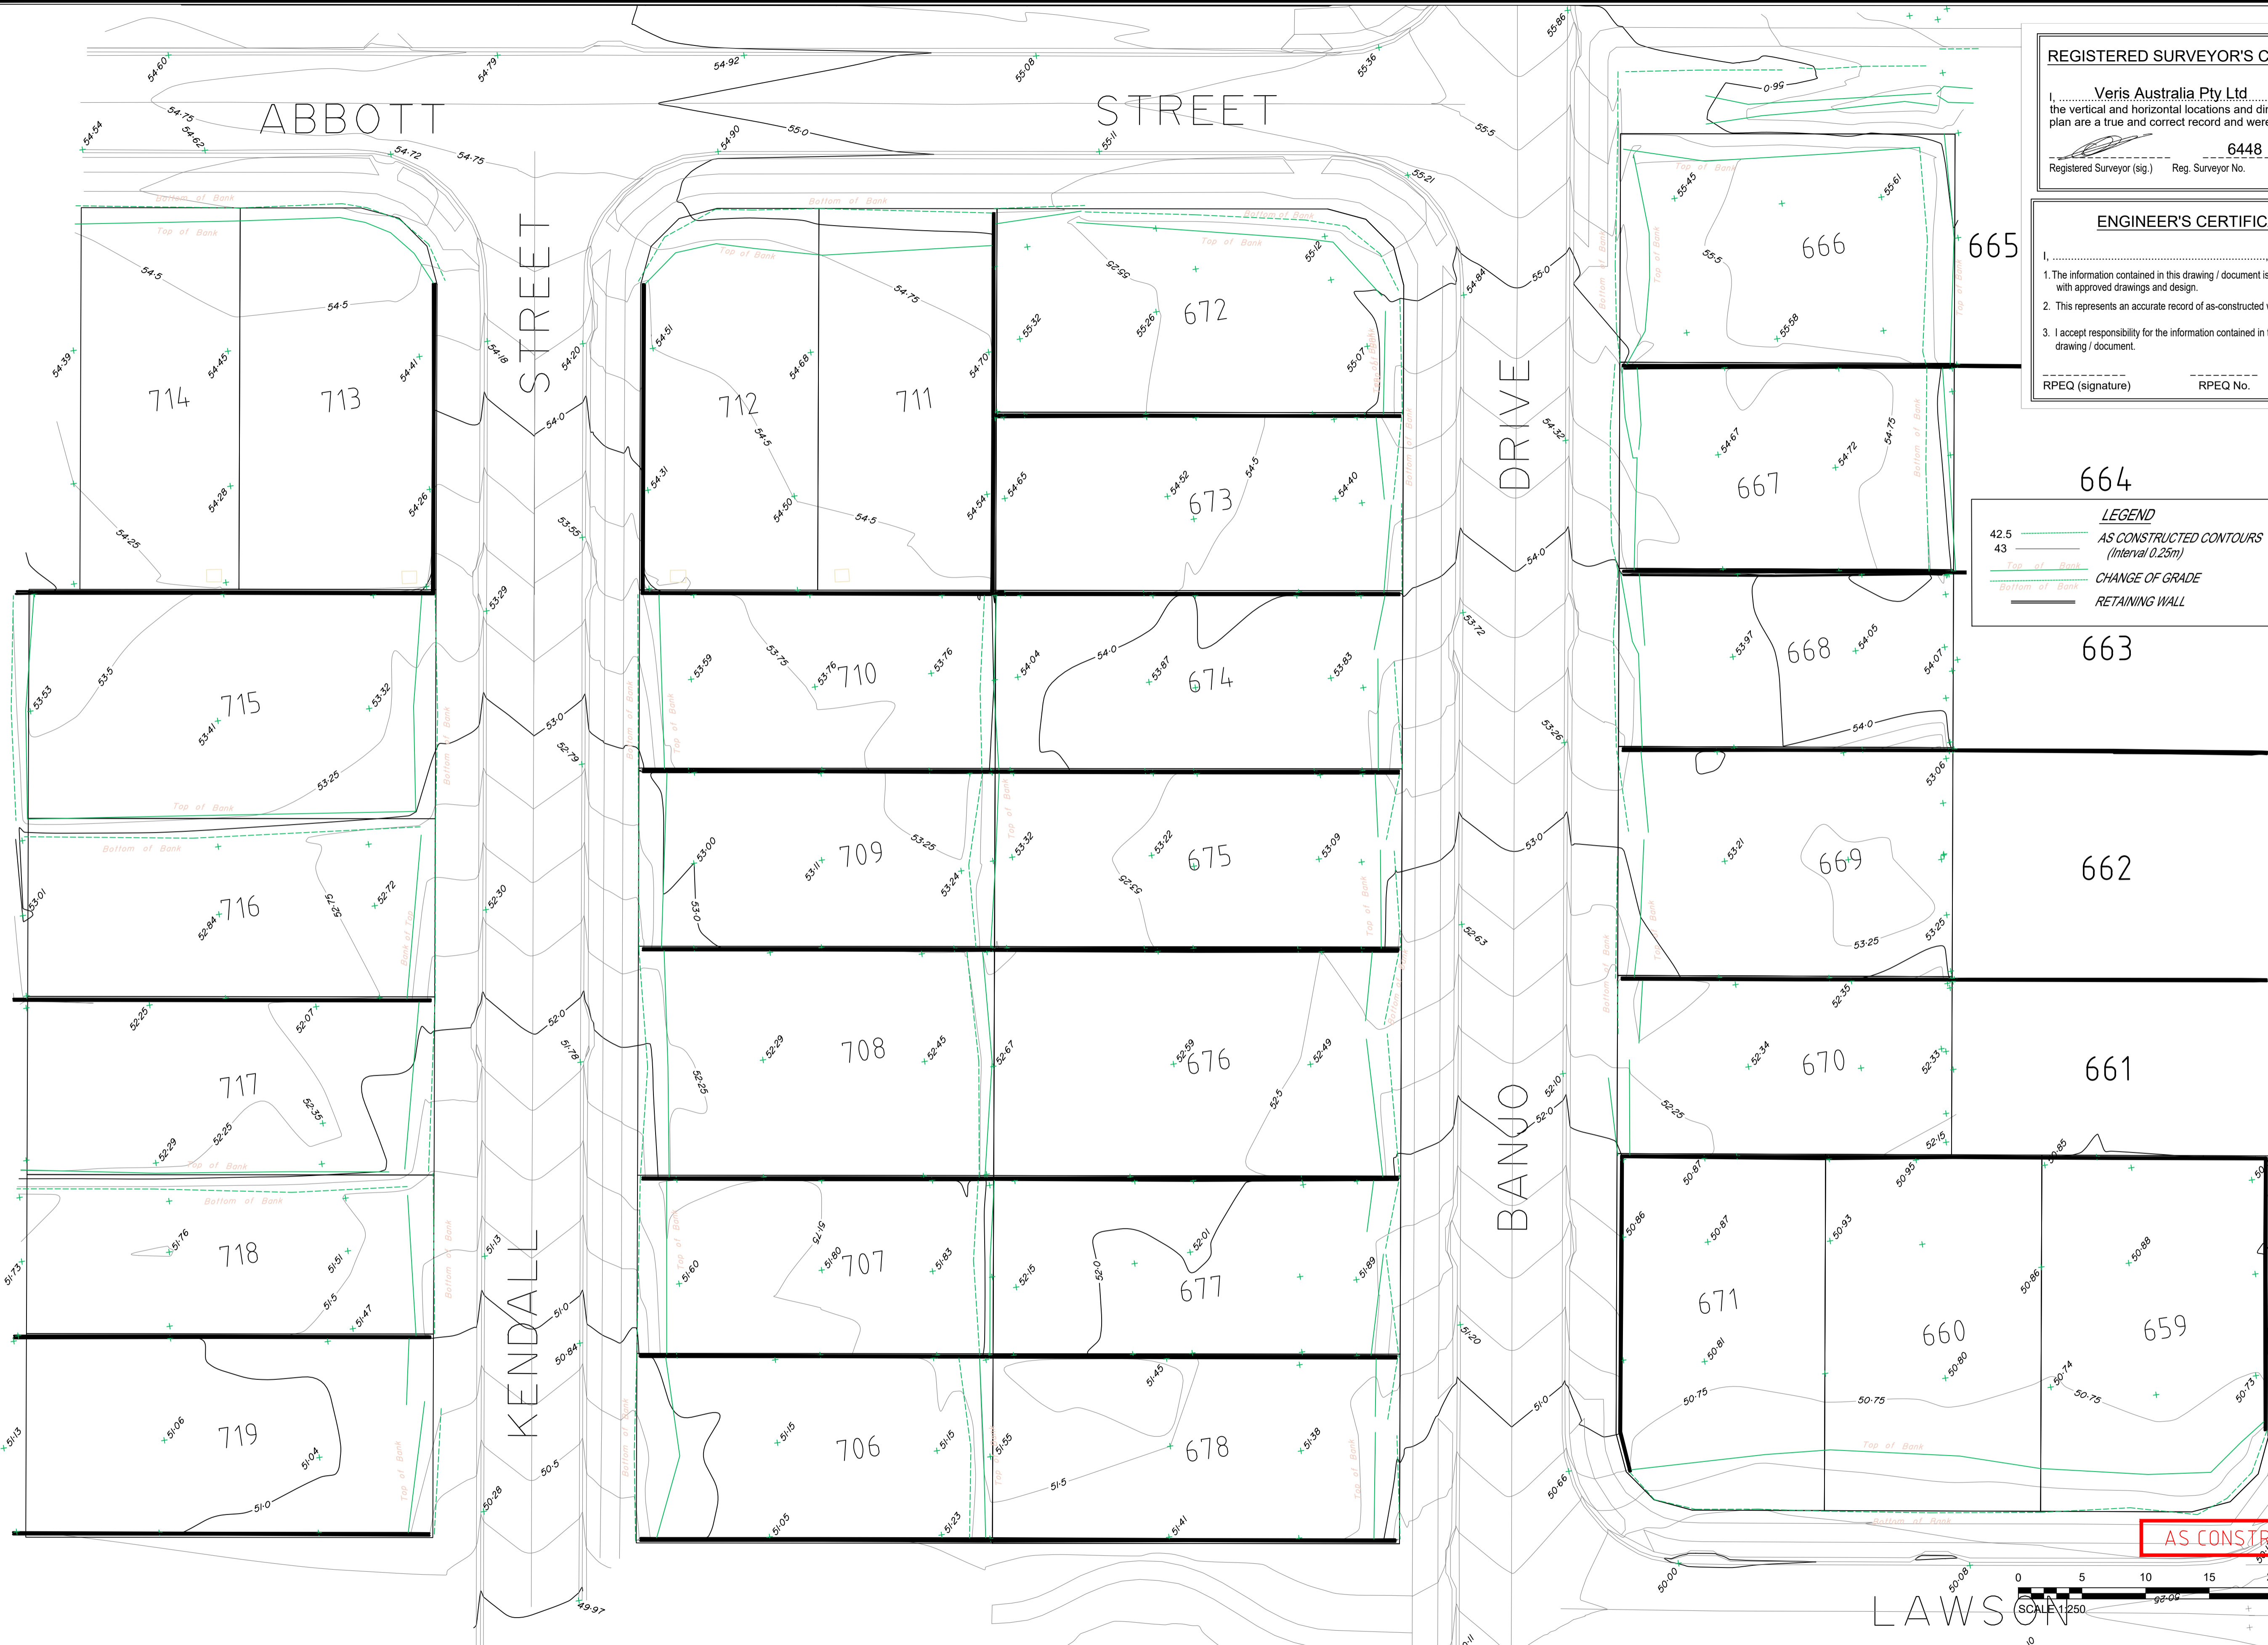


**REGISTERED SURVEYOR'S CERTIFICATION**  
 I, Veris Australia Pty Ltd, hereby certify that the vertical and horizontal locations and dimensions shown on this plan are a true and correct record and were located by survey.  
 Registered Surveyor (sig.) 6448 Reg. Surveyor No. 18/1/2024 Date

**ENGINEER'S CERTIFICATION**  
 I, hereby certify that:  
 1. The information contained in this drawing / document is in compliance with approved drawings and design.  
 2. This represents an accurate record of as-constructed works.  
 3. I accept responsibility for the information contained in this drawing / document.  
 RPEQ (signature) RPEQ No. Date:

**LEGEND**  
 42.5 AS CONSTRUCTED CONTOURS (Interval 0.25m)  
 43 CHANGE OF GRADE  
 Top of Bank  
 Bottom of Bank  
 RETAINING WALL

**AS CONSTRUCTED**

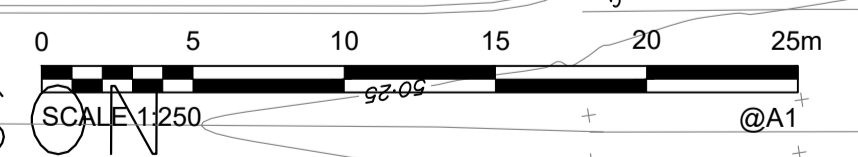

<b>A1</b>	B	17/01/2024	FINAL	JMc		
	A	27/09/2023	PROGRESS PLOT	JMc		
	INDEX	DATE	REVISIONS	DRAWN	CHECKED	PASSED


DRAWN	JMc	27/09/2023
CHECKED		
PASSED		
INITIALS		DATE

**veris**  
 BRISBANE (07) 3666 4700 WHITSUNDAYS (07) 4945 6600  
 MACKAY (07) 4957 7000 CAIRNS (07) 4522 9600  
 veris.com.au  
 ACN 615 735 727  
 Veris Australia Pty Ltd



**IPSWICH CITY COUNCIL**  
 WATERLEA WALLOON STAGES 6B2 + 6B3  
 AS CONSTRUCTED  
 EARTHWORKS

SCALE 1:250 @A1  
 SHEET 5 OF 9 SHEETS  
 DRAWING NO.  
 401905-6B2-6B3-AEW01

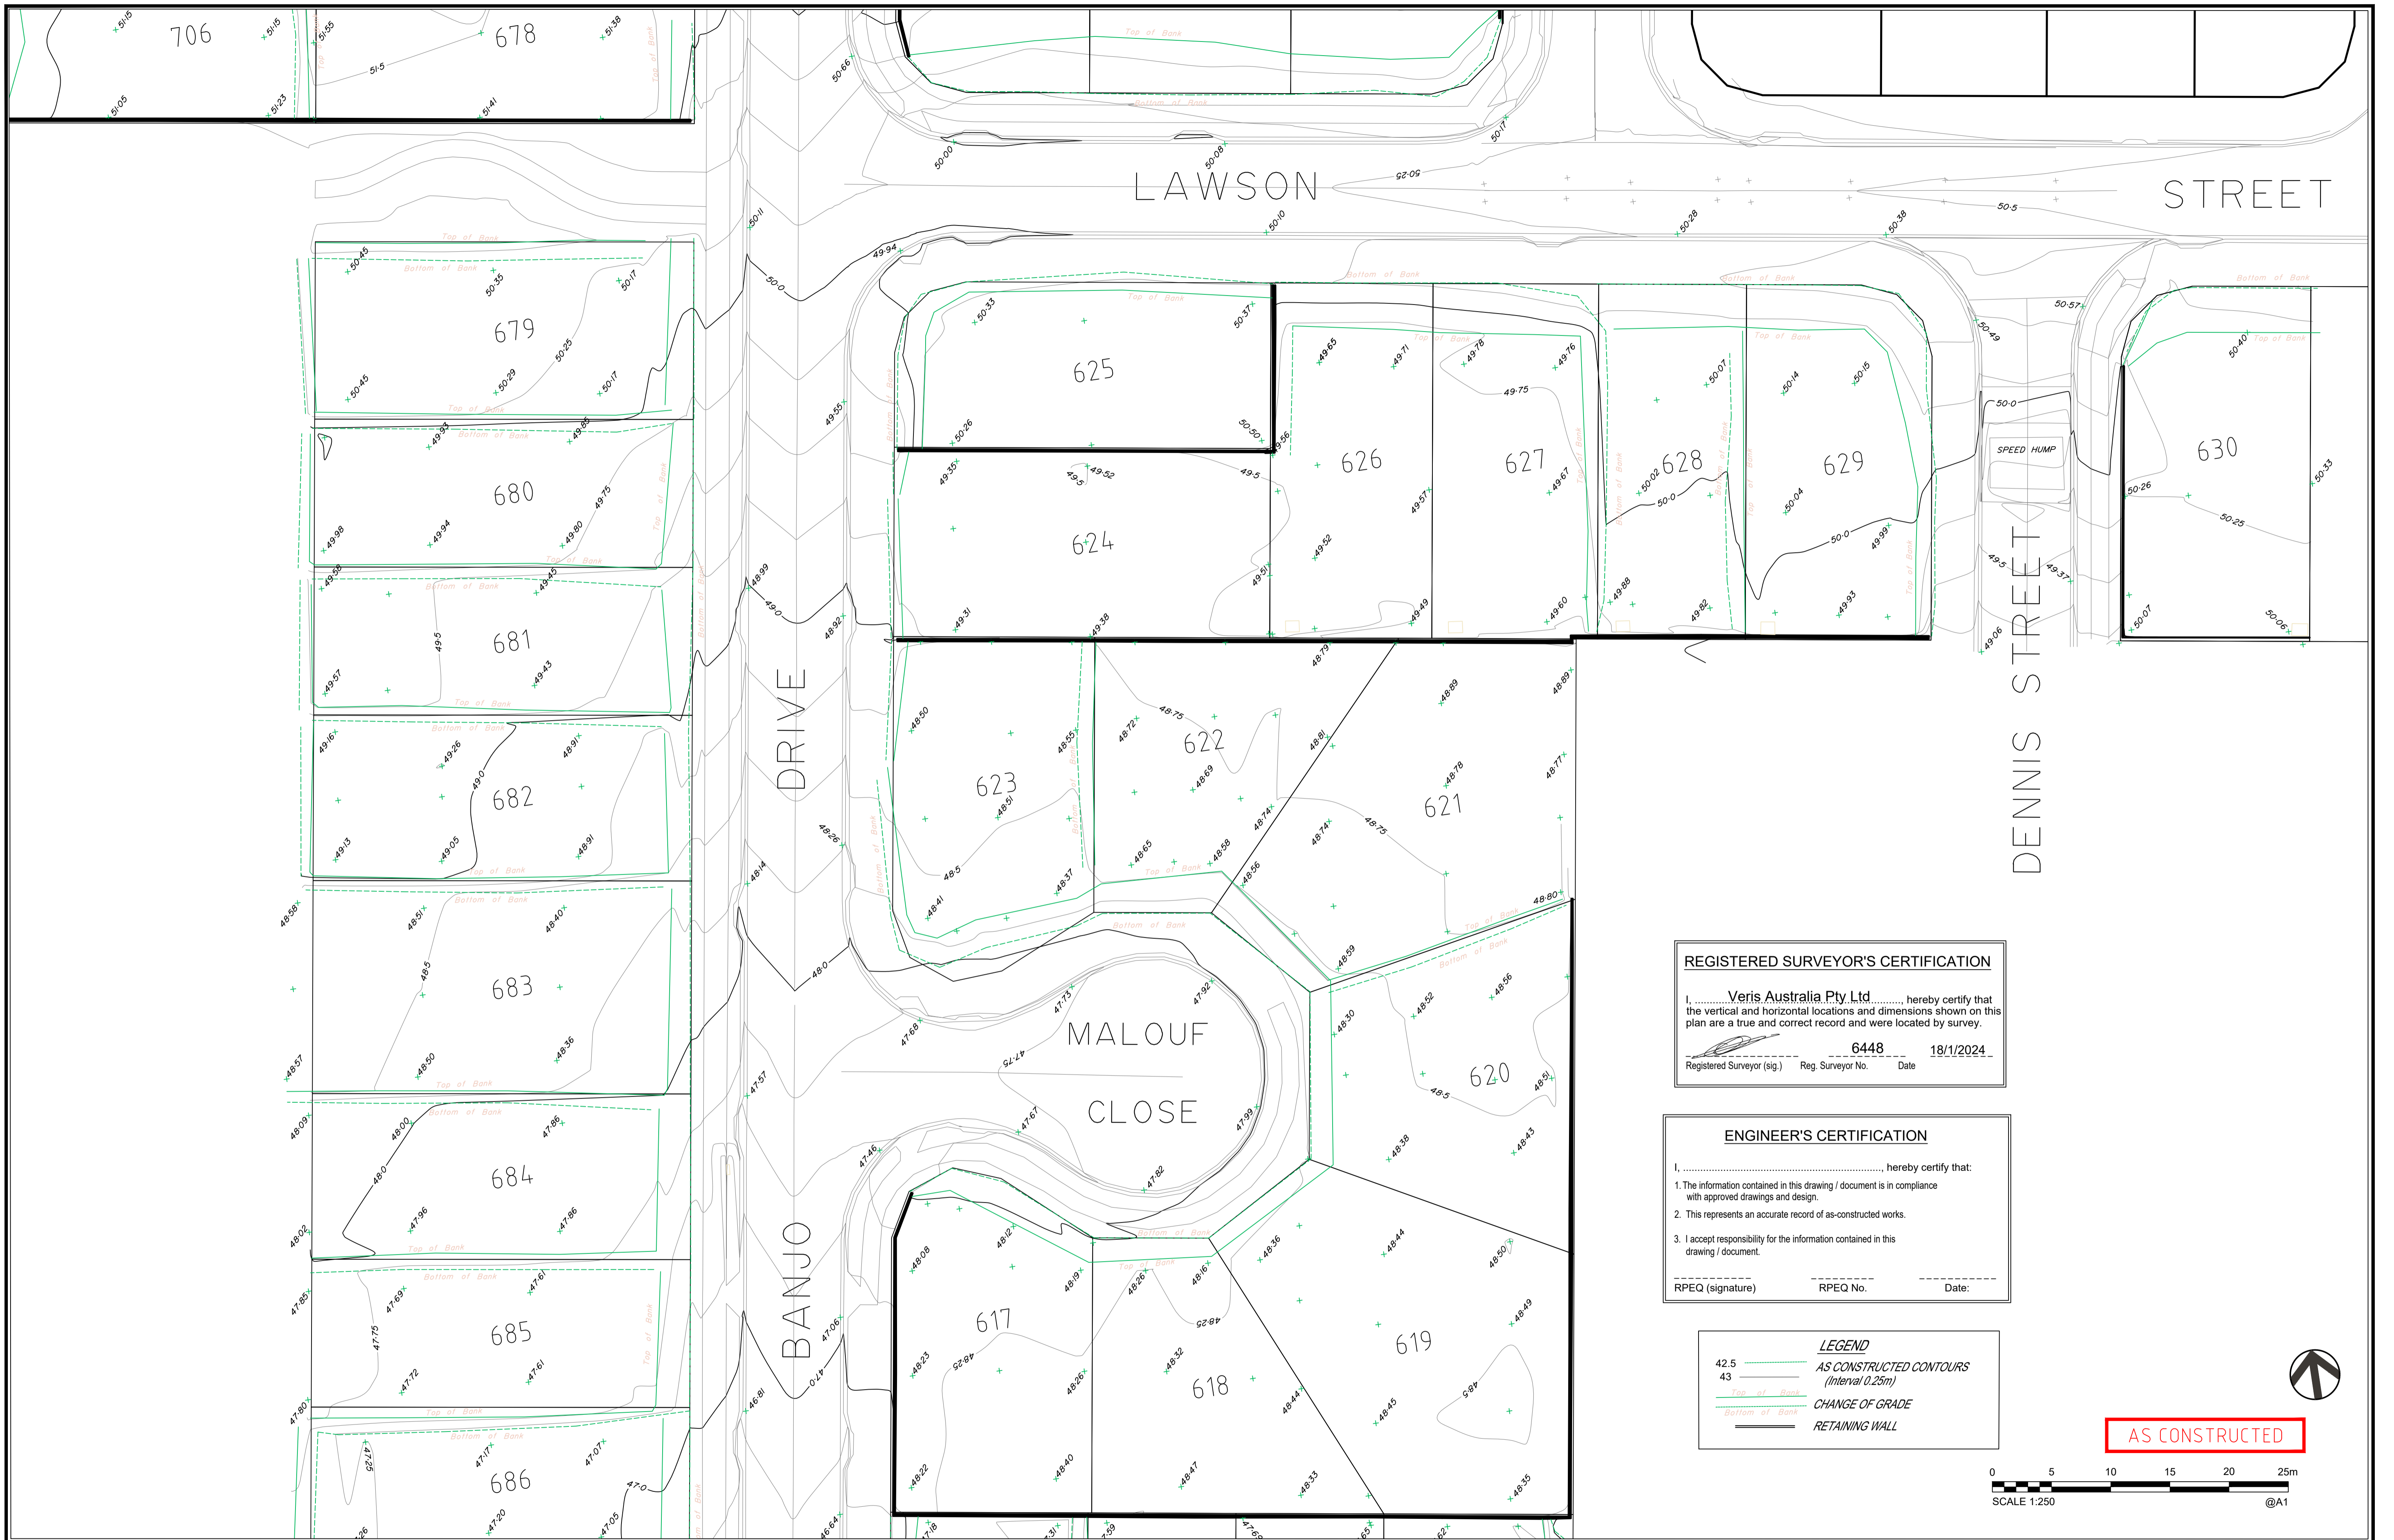

**REGISTERED SURVEYOR'S CERTIFICATION**

I, Veris Australia Pty Ltd, hereby certify that the vertical and horizontal locations and dimensions shown on this plan are a true and correct record and were located by survey.

Registered Surveyor (sig.) 6448 Reg. Surveyor No. 18/1/2024 Date

**ENGINEER'S CERTIFICATION**

I, \_\_\_\_\_, hereby certify that:

- The information contained in this drawing / document is in compliance with approved drawings and design.
- This represents an accurate record of as-constructed works.
- I accept responsibility for the information contained in this drawing / document.


RPEQ (signature) \_\_\_\_\_ RPEQ No. \_\_\_\_\_ Date: \_\_\_\_\_

**LEGEND**

42.5 AS CONSTRUCTED CONTOURS (Interval 0.25m)

43 CHANGE OF GRADE

RETAINING WALL

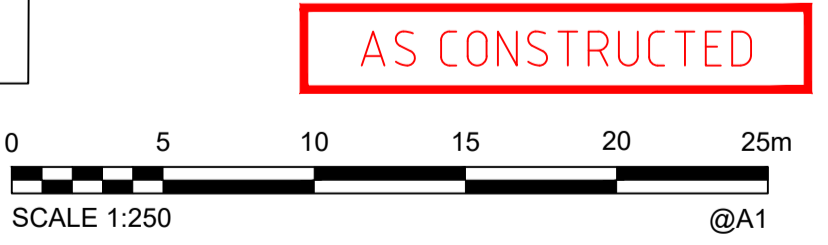

**AS CONSTRUCTED**

<b>A1</b>	B	17/01/2024	FINAL	JMc			
	A	27/09/2023	PROGRESS PLOT	JMc			
	INDEX	DATE	REVISIONS	DRAWN	CHECKED	PASSED	

DRAWN	JMc	27/09/2023
CHECKED		
PASSED		
INITIALS		DATE




BRISBANE (07) 3066 4700  
WHITSUNDAYS (07) 4945 6600  
MACKAY (07) 4957 9700  
CAIRNS (07) 4522 9600  
veris.com.au  
ACN 615 735 727  
Veris Australia Pty Ltd



**IPSWICH CITY COUNCIL**

WATERLEA WALLOON STAGES 6B2 + 6B3  
AS CONSTRUCTED  
EARTHWORKS

SCALE	1:250 @A1
SHEET	6 OF 9 SHEETS
DRAWING NO.	
401905-6B2-6B3-AEW01	
	B
	A

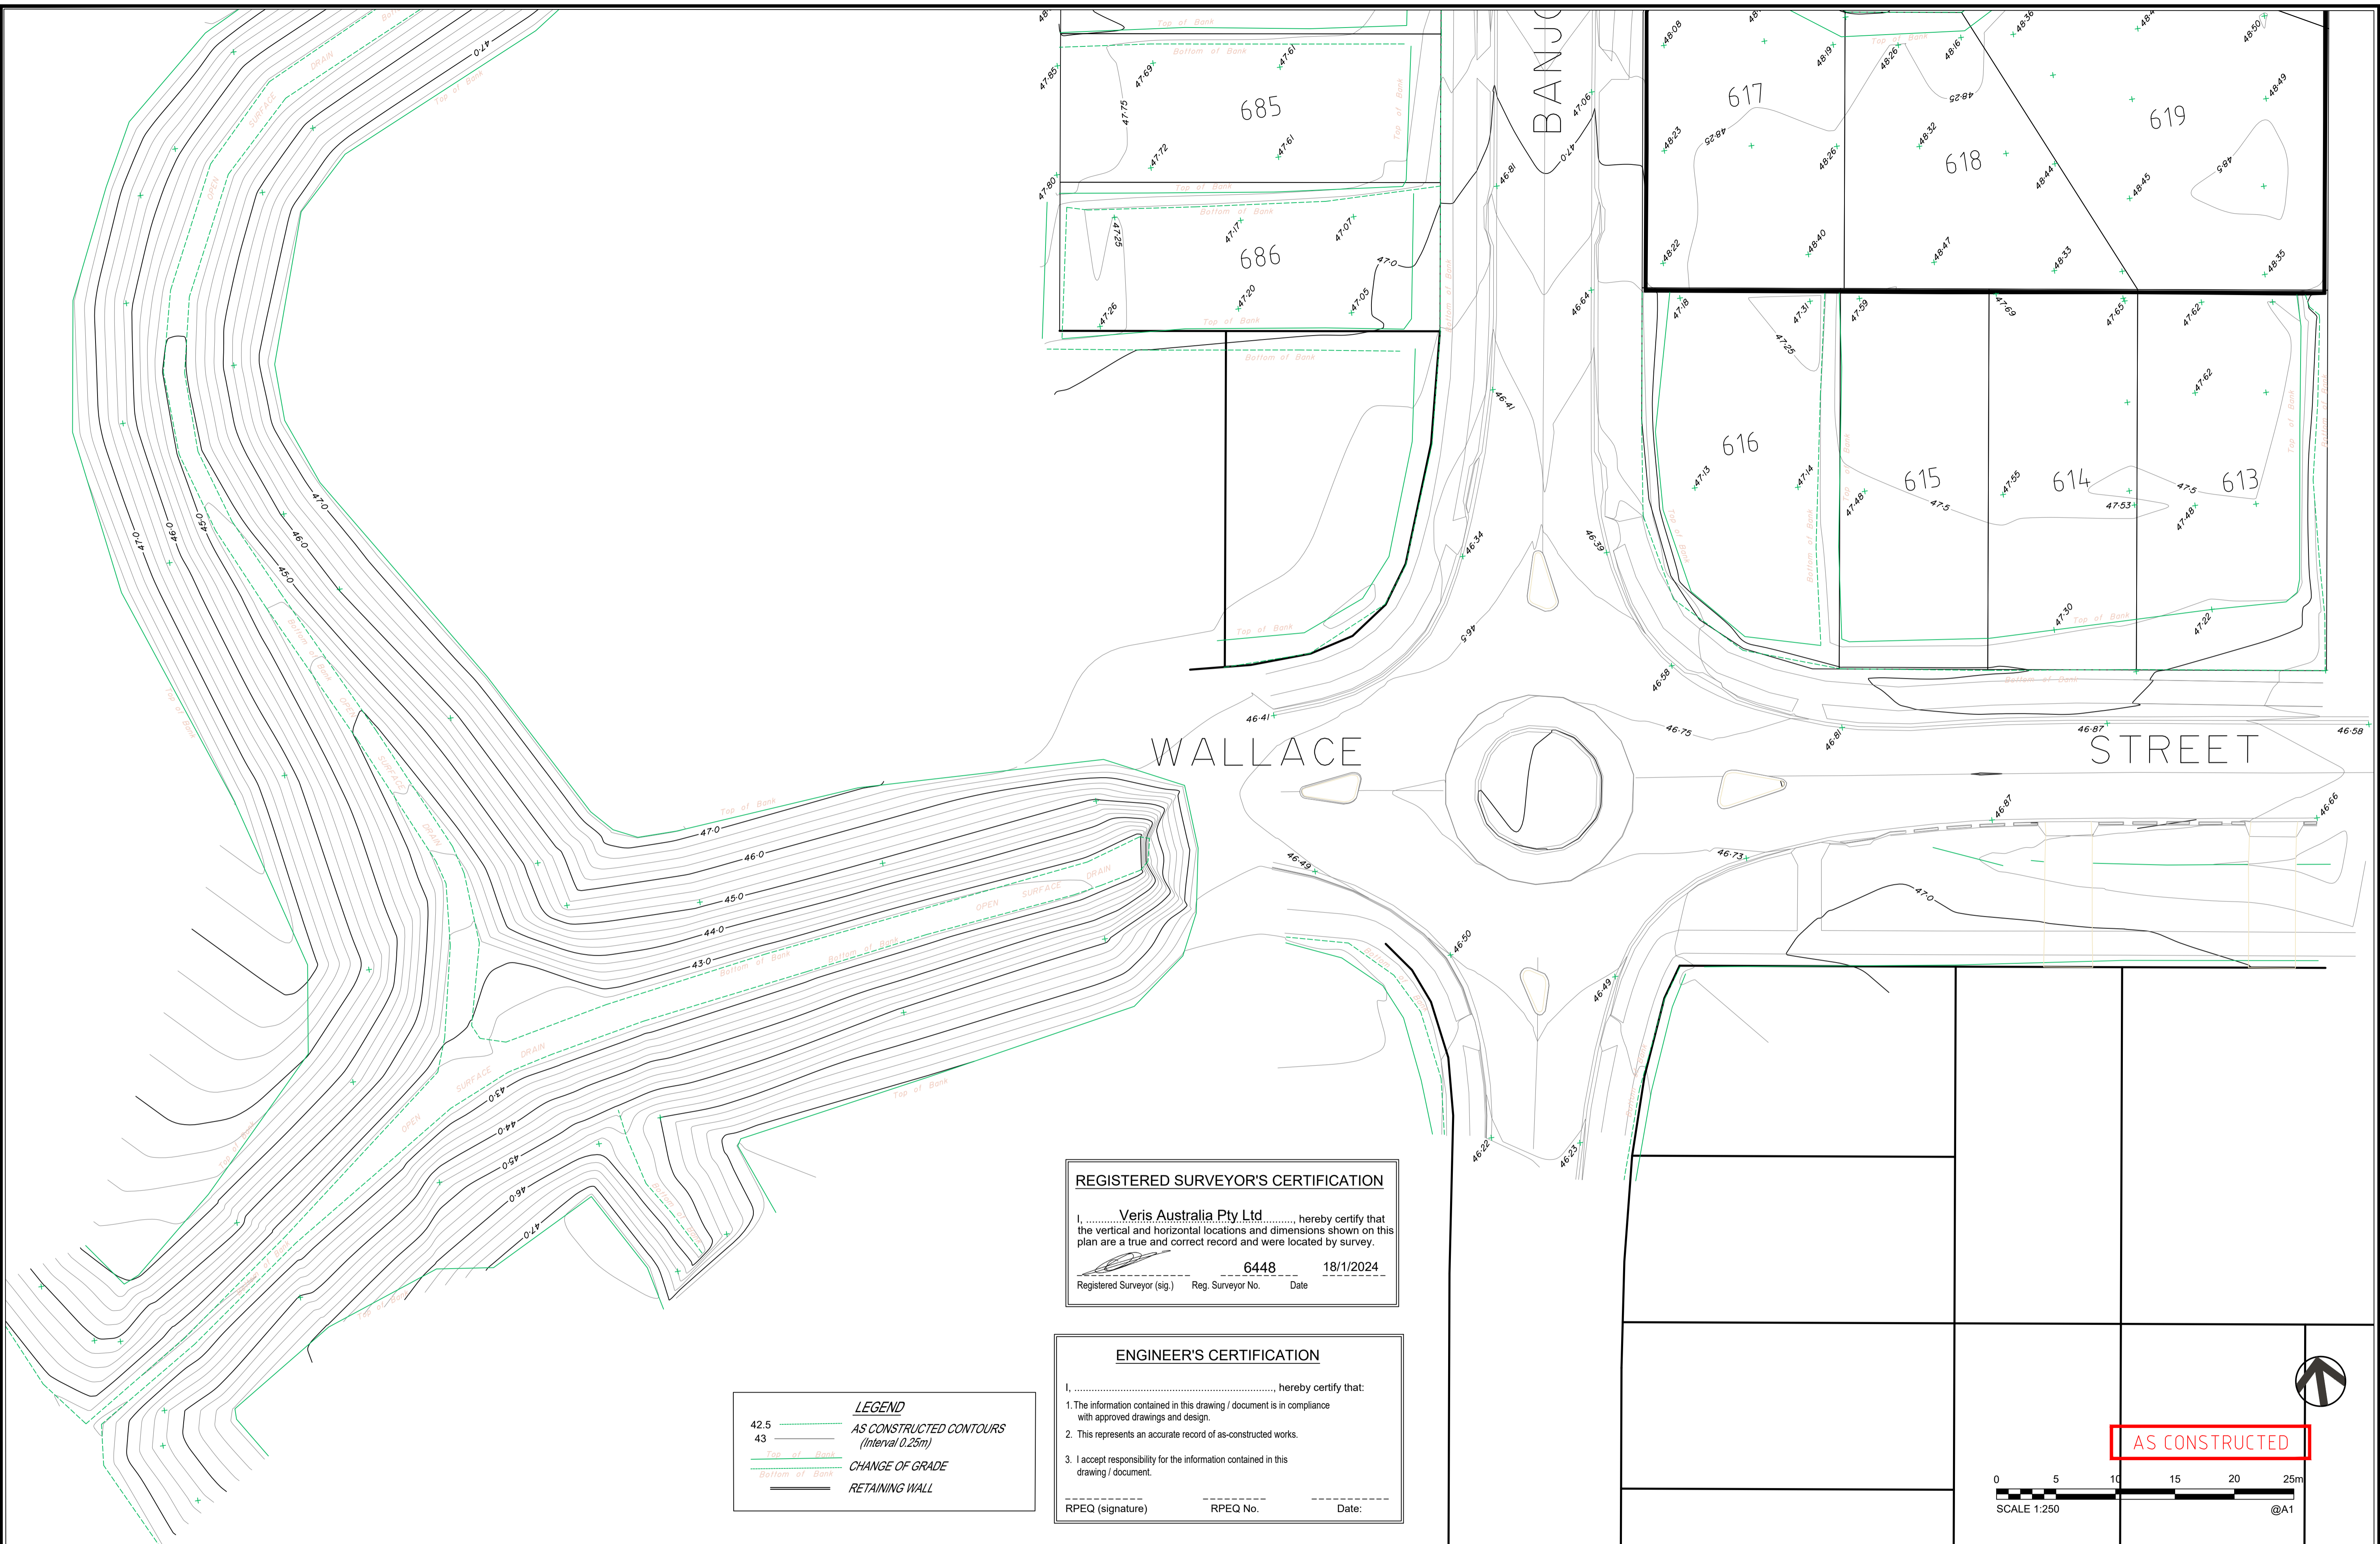

**REGISTERED SURVEYOR'S CERTIFICATION**

I, Veris Australia Pty Ltd, hereby certify that the vertical and horizontal locations and dimensions shown on this plan are a true and correct record and were located by survey.

6448      18/1/2024  
 Registered Surveyor (sig.)    Reg. Surveyor No.    Date

**ENGINEER'S CERTIFICATION**

I, \_\_\_\_\_, hereby certify that:

- The information contained in this drawing / document is in compliance with approved drawings and design.
- This represents an accurate record of as-constructed works.
- I accept responsibility for the information contained in this drawing / document.


RPEQ (signature)      RPEQ No.      Date:

**LEGEND**

42.5 ——— AS CONSTRUCTED CONTOURS  
 43 (Interval 0.25m)

——— CHANGE OF GRADE  
 ——— RETAINING WALL

**AS CONSTRUCTED**

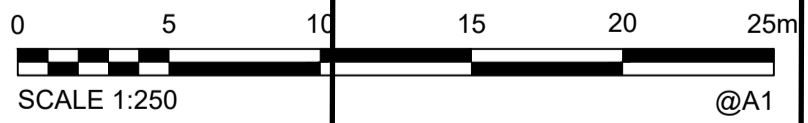

<b>A1</b>	B	17/01/2024	FINAL	JMc			
	A	27/09/2023	PROGRESS PLOT	JMc			
	INDEX	DATE	REVISIONS	DRAWN	CHECKED	PASSED	

DRAWN	JMc	27/09/2023
CHECKED		
PASSED		
INITIALS		DATE




BRISBANE (07) 3666 4700  
 WHITSUNDAYS (07) 4945 6600  
 MACKAY (07) 4937 9700  
 CAIRNS (07) 4522 9600  
 veris.com.au  
 ACN 615 735 727  
 Veris Australia Pty Ltd



**IPSWICH CITY COUNCIL**

WATERLEA WALLOON STAGES 6B2 + 6B3  
 AS CONSTRUCTED  
 EARTHWORKS

SCALE	1:250 @A1
SHEET	7 OF 9 SHEETS
DRAWING NO.	
401905-6B2-6B3-AEW01	
	B
	A

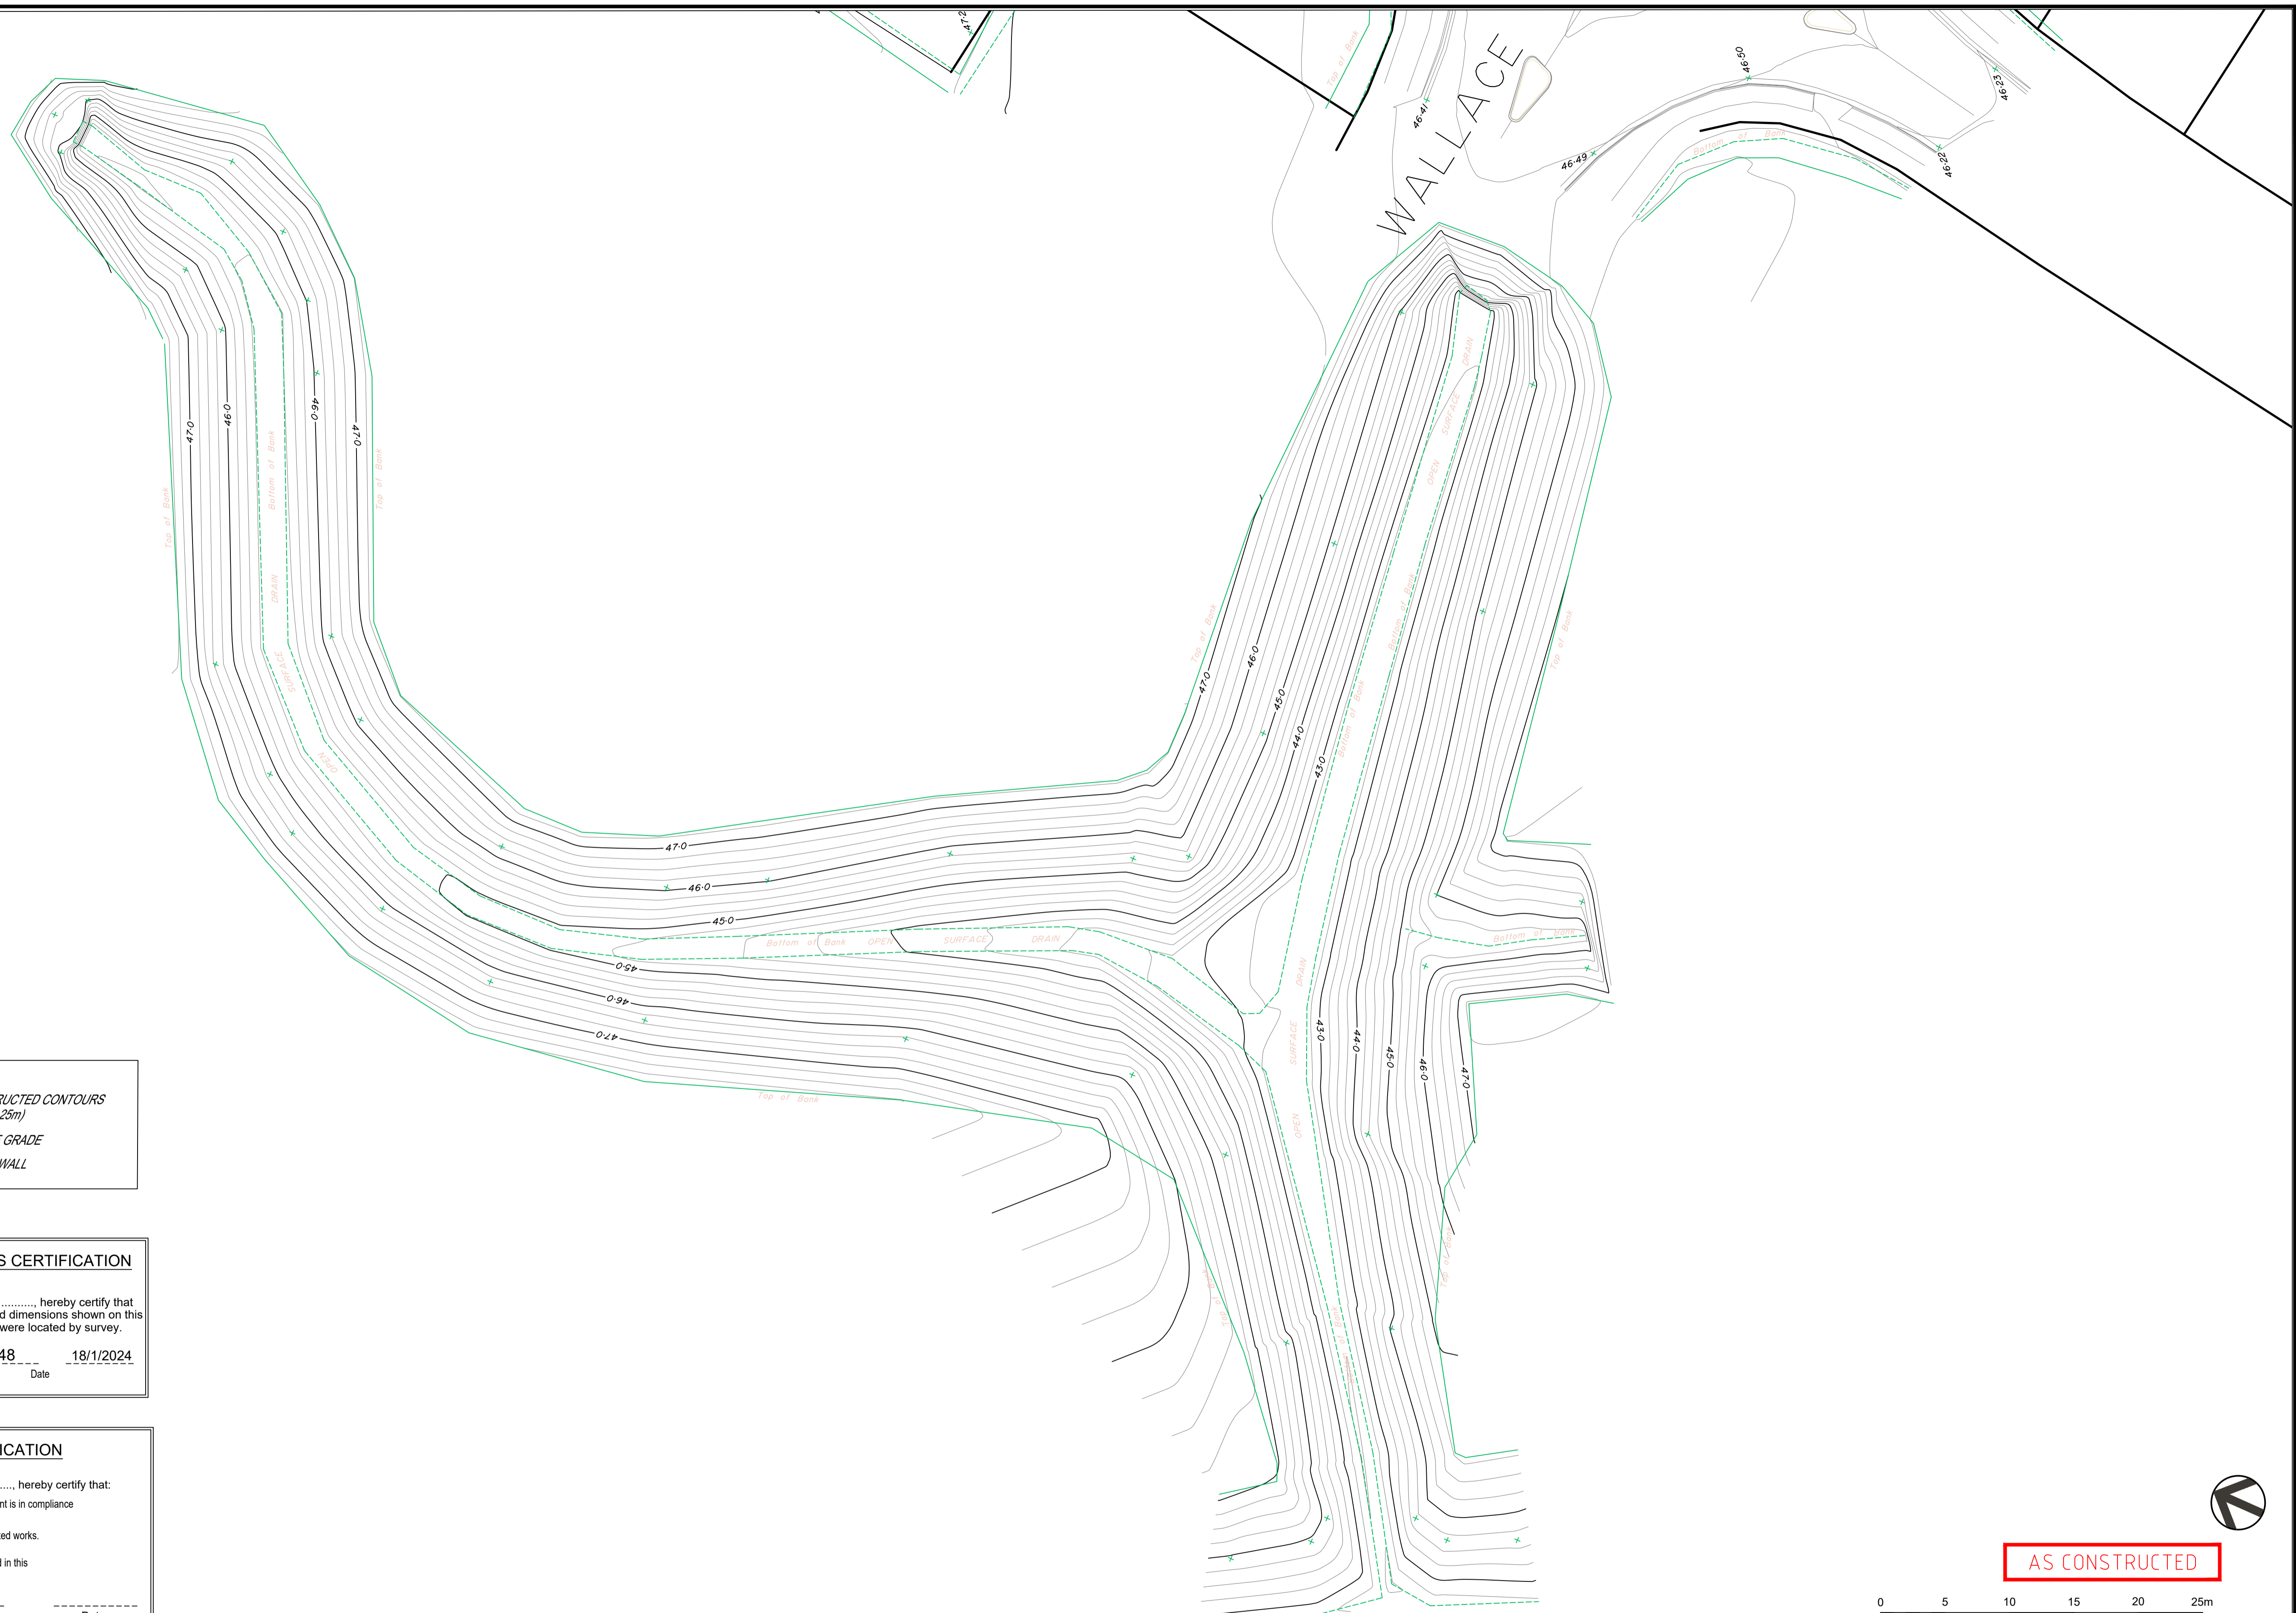


**LEGEND**

42.5	AS CONSTRUCTED CONTOURS
43	(Interval 0.25m)
Top of Bank	CHANGE OF GRADE
Bottom of Bank	RETAINING WALL

**REGISTERED SURVEYOR'S CERTIFICATION**

I, Veris Australia Pty Ltd, hereby certify that the vertical and horizontal locations and dimensions shown on this plan are a true and correct record and were located by survey.

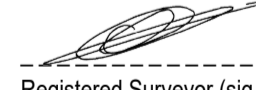

 6448 18/1/2024  
 Registered Surveyor (sig.) Reg. Surveyor No. Date

**ENGINEER'S CERTIFICATION**

I, \_\_\_\_\_, hereby certify that:

- The information contained in this drawing / document is in compliance with approved drawings and design.
- This represents an accurate record of as-constructed works.
- I accept responsibility for the information contained in this drawing / document.

\_\_\_\_\_ Date: \_\_\_\_\_  
 RPEQ (signature) RPEQ No.

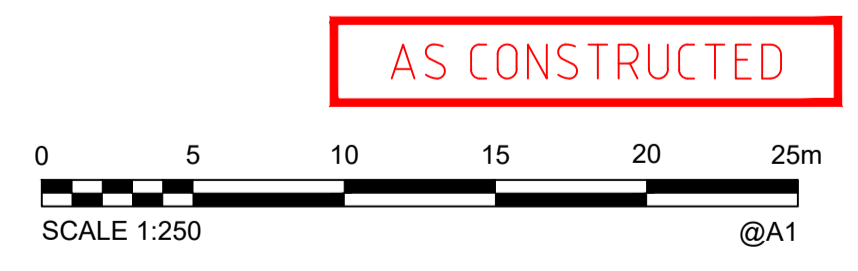

**A1**

INDEX	DATE	REVISIONS	DRAWN	CHECKED	PASSED
B	17/01/2024	FINAL	JMc		
A	27/09/2023	PROGRESS PLOT	JMc		

DRAWN	INITIALS	DATE
JMc		27/09/2023
CHECKED		
PASSED		



BRISBANE (07) 3066 4700 WHITSUNDAYS (07) 4945 6600  
 MACKAY (07) 4957 9100 CAIRNS (07) 4522 9400  
 veris.com.au  
 ACN 615 735 727  
 Veris Australia Pty Ltd



**IPSWICH CITY COUNCIL**

WATERLEA WALLOON STAGES 6B2 + 6B3  
 AS CONSTRUCTED  
 EARTHWORKS

SCALE	1:250 @A1
SHEET	8 OF 9 SHEETS
DRAWING NO.	401905-6B2-6B3-AEW01
	B
	A



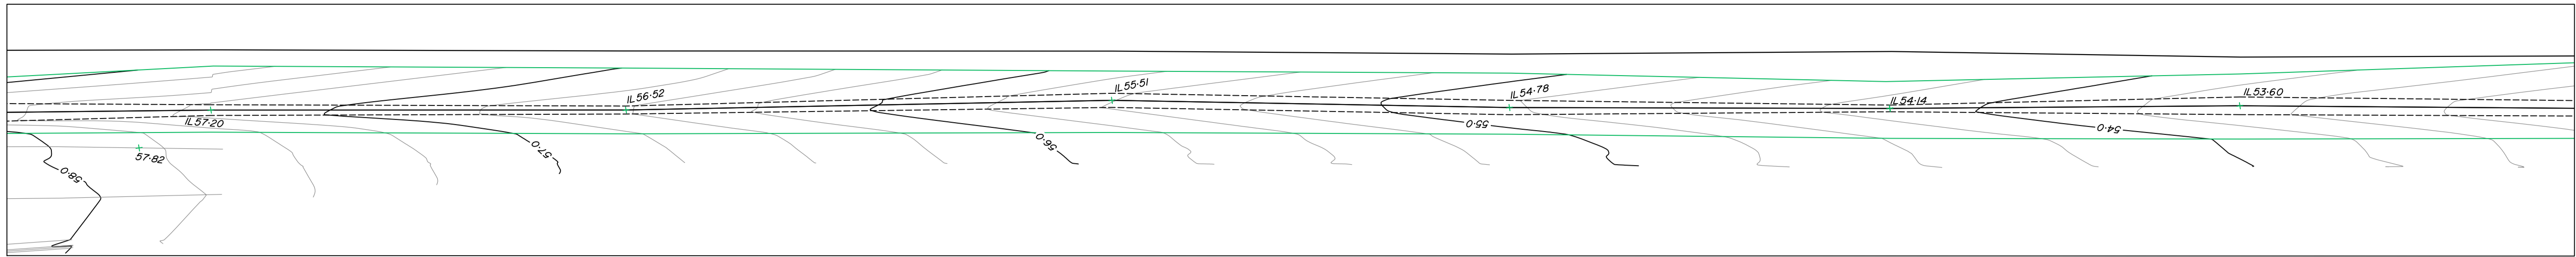


DIAGRAM A  
Scale 1:250

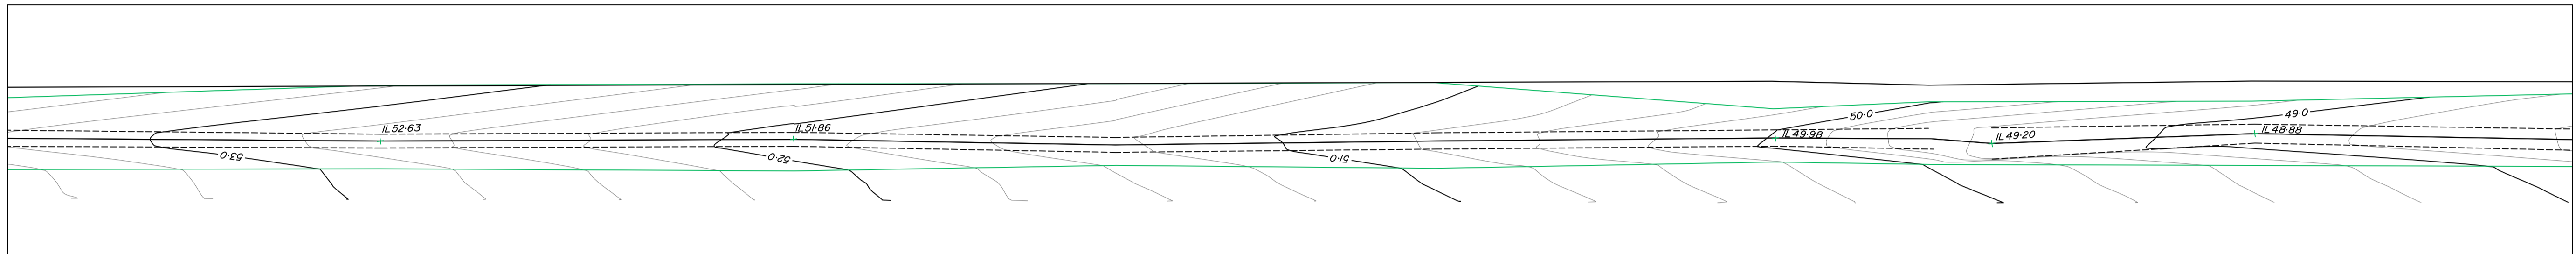


DIAGRAM B  
Scale 1:250

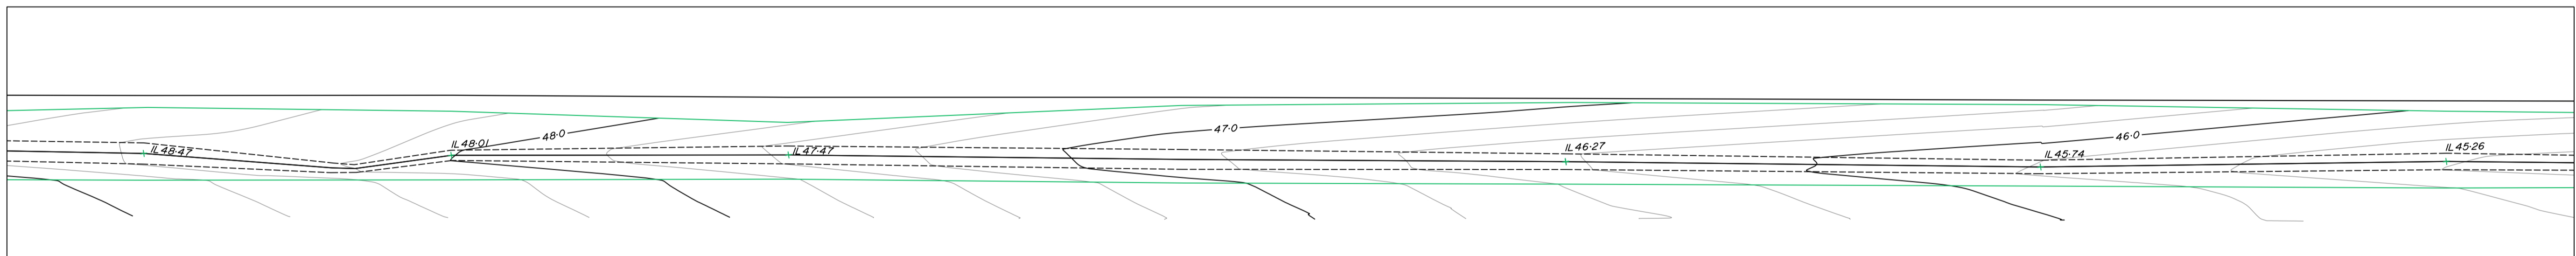


DIAGRAM C  
Scale 1:250

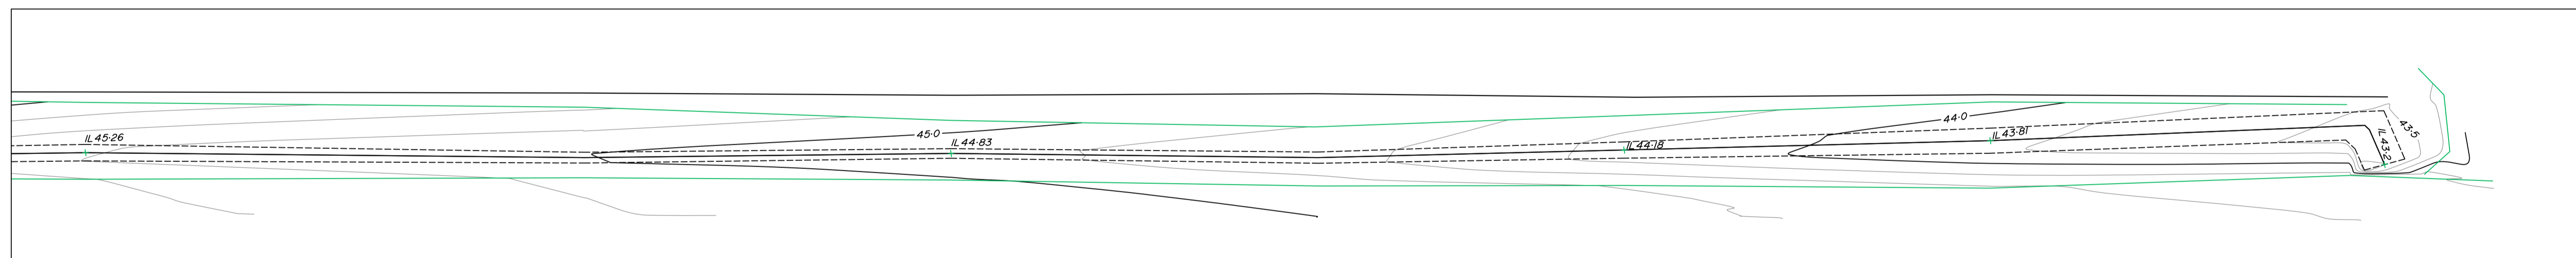



DIAGRAM D  
Scale 1:250

**REGISTERED SURVEYOR'S CERTIFICATION**  
I, **Veris Australia Pty Ltd**, hereby certify that the vertical and horizontal locations and dimensions shown on this plan are a true and correct record and were located by survey.  
Registered Surveyor (sig.) **6448** Date **18/1/2024**  
Reg. Surveyor No.

**ENGINEER'S CERTIFICATION**  
I, \_\_\_\_\_, hereby certify that:  
1. The information contained in this drawing / document is in compliance with approved drawings and design.  
2. This represents an accurate record of as-constructed works.  
3. I accept responsibility for the information contained in this drawing / document.  
RPEQ (signature) RPEQ No. Date:

**LEGEND**  
42.5 AS CONSTRUCTED CONTOURS (Interval 0.25m)  
43 CHANGE OF GRADE  
 Top of Bank  
 Bottom of Bank  
 RETAINING WALL

**AS CONSTRUCTED**

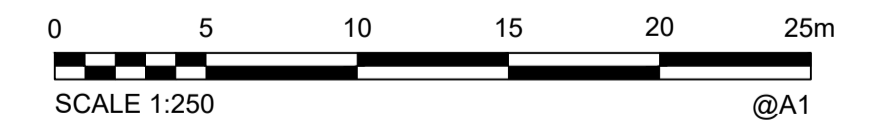

**A1**

B	17/01/2024	FINAL	JMc			
A	27/09/2023	PROGRESS PLOT	JMc			
INDEX	DATE	REVISIONS	DRAWN	CHECKED	PASSED	

DRAWN	JMc	27/09/2023
CHECKED		
PASSED		
INITIALS		DATE



BRISBANE (07) 3966 4700 WHITSUNDAYS (07) 4945 6600  
MACKAY (07) 4937 9100 CAIRNS (07) 4522 9400  
veris.com.au  
ACN 615 735 727  
Veris Australia Pty Ltd



**IPSWICH CITY COUNCIL**

WATERLEA WALLOON STAGES 6B2 + 6B3  
AS CONSTRUCTED  
EARTHWORKS

SCALE	1:250 @A1
SHEET	9 OF 9 SHEETS
DRAWING NO.	401905-6B2-6B3-AEW01
	B
	A