







**LEGEND**

- NEW HYDRANT
- NEW SLUICE VALVE
- NEW TEE
- NEW END CAP
- NEW TAPER
- NEW WATER SERVICE CONDUIT (Ø100 PVC-O PN16)
- NEW WATER SERVICE (Ø25 PE PN16)
- NEW WATER METER
- NEW WATER HOUSE CONNECTION (TAPPING BAND)
- NEW WATER MAIN (Ø180 PE-100 PN16)
- WATER MARKER

- ① Ø180 STOP VALVE
- ⑧ Ø180 90° BEND
- ② Ø180 FIRE HYDRANT
- ⑨ Ø180 x Ø315 Tee
- ③ Ø180 x Ø180 TEE
- ⑩ Ø315 Stop Valve
- ④ Ø180 DEAD END CAP
- ⑪ Ø315 Fire Hydrant
- ⑤ Ø180 11.25° BEND
- ⑫ Ø315 DEAD END CAP
- ⑥ Ø180 22.5° BEND
- ⑬ Ø315 11.25° BEND
- ⑦ Ø180 45° BEND

STAGE 6B3

STAGE 6B2

STAGE 6B1

**REGISTERED SURVEYOR'S CERTIFICATION**

I, Veris Australia Pty Ltd, hereby certify that the vertical and horizontal locations and dimensions shown on this plan are a true and correct record and were located by survey.

6448 10/1/2024  
Registered Surveyor (sig.) Reg. Surveyor No. Date


**ENGINEER'S CERTIFICATION**

I, \_\_\_\_\_, hereby certify that:

1. The information contained in this drawing / document is in compliance with approved drawings and design.
2. The new water and sewerage works defined by this drawing have been designed and constructed in accordance with the SEQ Code.
3. This represents an accurate record of as-constructed works.
4. I accept responsibility for the information contained in this drawing / document.

RPEQ (signature) RPEQ No. Date:

STAGE 6B3

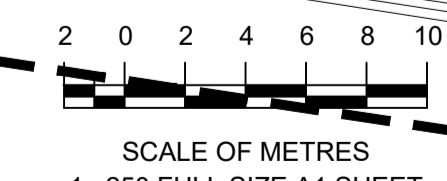

A1	E	19/12/2023	FINAL	JMc					
	D	26/09/2023	PROGRESS PLOT	JMc					
	C	06/09/2023	REMOVE SHEET 3 REV B	JMc			DRAWN	JMc	10/08/2023
	B	25/08/2023	FINAL	JMc			CHECKED		
	A	10/08/2023	PROGRESS PLOT AS CON WATER	JMc			APPROVED		
REV NO	DATE	REVISION PURPOSE / DESCRIPTION	DRAWN	RPEQ	RPEQ No	INITIALS	DATE		

**veris**

BRISBANE (07) 3666 4700  
MACKAY (07) 4957 9700  
WHITSUNDAYS (07) 4945 6600  
CAIRNS (07) 4052 9400  
veris.com.au  
ACN 615 735 727  
Veris Australia Pty Ltd

QUEENSLAND  
**UrbanUtilities**

**DAWN WALLOON**  
Banjo Drive Walloon

**STAGE 6B2**  
AS CONSTRUCTED WATER

<b>DRAWING STATUS</b>	
<b>AS CONSTRUCTED</b>	
SHEET 4 OF 4 SHEETS	
DRAWING NO. <b>401905-6B2-AW01</b>	REV. <b>E</b>