



REGISTERED SURVEYOR'S CERTIFICATION

I, **Veris Australia Pty Ltd**, hereby certify that the vertical and horizontal locations and dimensions shown on this plan are a true and correct record and were located by survey.

Registered Surveyor (sig.) **6448** Reg. Surveyor No. **10/1/2024** Date

ENGINEER'S CERTIFICATION

I, _____, hereby certify that:

- The information contained in this drawing / document is in compliance with approved drawings and design.
- The new water and sewerage works defined by this drawing have been designed and constructed in accordance with the SEQ Code.
- This represents an accurate record of as-constructed works.
- I accept responsibility for the information contained in this drawing / document.

RPEQ (signature) _____ RPEQ No. _____ Date: _____

LEGEND

- NEW HYDRANT
- NEW SLUICE VALVE
- NEW TEE
- NEW END CAP
- NEW TAPER
- NEW WATER SERVICE CONDUIT (Ø100 PVC-O PN16)
- NEW WATER SERVICE (Ø25 PE PN16)
- NEW WATER METER
- NEW WATER HOUSE CONNECTION (TAPPING BAND)
- NEW WATER MAIN (Ø180 PE-100 PN16)
- WATER MARKER

- ① Ø180 STOP VALVE
- ② Ø180 FIRE HYDRANT
- ③ Ø180 x Ø180 TEE
- ④ Ø180 DEAD END CAP
- ⑤ Ø180 11.25° BEND
- ⑥ Ø180 22.5° BEND
- ⑦ Ø180 45° BEND
- ⑧ Ø180 90° BEND
- ⑨ Ø180 x Ø315 Tee
- ⑩ Ø315 Stop Valve
- ⑪ Ø315 Fire Hydrant
- ⑫ Ø315 DEAD END CAP
- ⑬ Ø315 11.25° BEND



A1

REV NO	DATE	REVISION PURPOSE / DESCRIPTION	DRAWN	RPEQ	RPEQ No	INITIALS	DATE
E	20/12/2023	ADD SOME ADMENDMENTS	JMc				
D	28/09/2023	FINAL	JMc				
C	06/08/2023	REMOVE SOME EXTRA ITEMS IN ABBOTT ST	JMc			DRAWN	JMc 10/08/2023
B	25/08/2023	PROGRESS	JMc			CHECKED	
A	10/08/2023	PROGRESS PLOT AS CON WATER	JMc			APPROVED	

veris

BRISBANE (07) 3666 4700
MACKAY (07) 4957 9100
WHITSUNDAYS (07) 4945 6600
CAIRNS (07) 4052 9400

veris.com.au
ACN 615 735 727
Veris Australia Pty Ltd



DAWN WALLOON
Banjo Drive Walloon

STAGE 6B3
AS CONSTRUCTED WATER

DRAWING STATUS AS CONSTRUCTED	
SHEET 1 OF 4 SHEETS	
DRAWING NO. 401905-6B3-AW01	REV. E

REGISTERED SURVEYOR'S CERTIFICATION

I, Veris Australia Pty Ltd, hereby certify that the vertical and horizontal locations and dimensions shown on this plan are a true and correct record and were located by survey.

Registered Surveyor (sig.) 6448 Reg. Surveyor No. Date 10/1/2024

ENGINEER'S CERTIFICATION

I, _____, hereby certify that:



- The information contained in this drawing / document is in compliance with approved drawings and design.
- The new water and sewerage works defined by this drawing have been designed and constructed in accordance with the SEQ Code.
- This represents an accurate record of as-constructed works.
- I accept responsibility for the information contained in this drawing / document.

RPEQ (signature) _____ RPEQ No. _____ Date: _____

LEGEND

- NEW HYDRANT
- NEW SLUICE VALVE
- NEW TEE
- NEW END CAP
- NEW TAPER
- NEW WATER SERVICE CONDUIT (Ø100 PVC-O PN16)
- NEW WATER SERVICE (Ø25 PE PN16)
- NEW WATER METER
- NEW WATER HOUSE CONNECTION (TAPPING BAND)
- NEW WATER MAIN (Ø180 PE-100 PN16)
- WATER MARKER

- ① Ø180 STOP VALVE
- ② Ø180 FIRE HYDRANT
- ③ Ø180 x Ø180 TEE
- ④ Ø180 DEAD END CAP
- ⑤ Ø180 11.25° BEND
- ⑥ Ø180 22.5° BEND
- ⑦ Ø180 45° BEND
- ⑧ Ø180 90° BEND
- ⑨ Ø180 x Ø315 Tee
- ⑩ Ø315 Stop Valve
- ⑪ Ø315 Fire Hydrant
- ⑫ Ø315 DEAD END CAP
- ⑬ Ø315 11.25° BEND

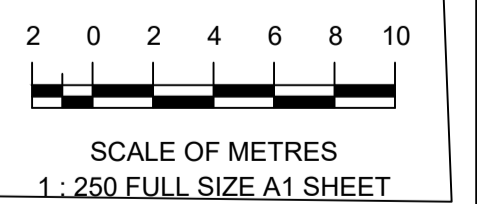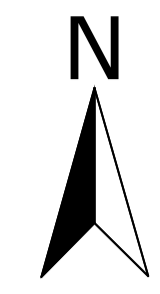

A1	E	20/12/2023	ADD SOME ADMENDMENTS	JMc					
	D	28/09/2023	FINAL	JMc					
	C	06/09/2023	REMOVE SOME EXTRA ITEMS IN ABBOTT ST	JMc			DRAWN	JMc	10/08/2023
	B	25/08/2023	PROGRESS	JMc			CHECKED		
	A	10/08/2023	PROGRESS PLOT AS CON WATER	JMc			APPROVED		
REV NO	DATE	REVISION PURPOSE / DESCRIPTION		DRAWN	RPEQ	RPEQ No	INITIALS	DATE	

BRISBANE (07) 3666 4700
WHITSUNDAYS (07) 4945 6600
MACKAY (07) 4957 9700
CAIRNS (07) 4052 9400
veris.com.au
ACN 615 735 727
Veris Australia Pty Ltd



DAWN WALLOON
Banjo Drive Walloon

STAGE 6B3
AS CONSTRUCTED WATER

DRAWING STATUS AS CONSTRUCTED	
SHEET 2 OF 4 SHEETS	
DRAWING NO. 401905-6B3-AW01	REV. E



REGISTERED SURVEYOR'S CERTIFICATION

I, Veris Australia Pty Ltd, hereby certify that the vertical and horizontal locations and dimensions shown on this plan are a true and correct record and were located by survey.

Registered Surveyor (sig.) 6448 Reg. Surveyor No. 10/1/2024 Date

ENGINEER'S CERTIFICATION

I, _____, hereby certify that:

- The information contained in this drawing / document is in compliance with approved drawings and design.
- The new water and sewerage works defined by this drawing have been designed and constructed in accordance with the SEQ Code.
- This represents an accurate record of as-constructed works.
- I accept responsibility for the information contained in this drawing / document.

RPEQ (signature) _____ RPEQ No. _____ Date: _____

LEGEND

	NEW HYDRANT
	NEW SLUICE VALVE
	NEW TEE
	NEW END CAP
	NEW TAPER
	NEW WATER SERVICE CONDUIT (Ø100 PVC-O PN16)
	NEW WATER SERVICE (Ø25 PE PN16)
	NEW WATER METER
	NEW WATER HOUSE CONNECTION (TAPPING BAND)
	NEW WATER MAIN (Ø180 PE-100 PN16)
	WATER MARKER

① Ø180 STOP VALVE	⑧ Ø180 90° BEND
② Ø180 FIRE HYDRANT	⑨ Ø180 x Ø315 Tee
③ Ø180 x Ø180 TEE	⑩ Ø315 Stop Valve
④ Ø180 DEAD END CAP	⑪ Ø315 Fire Hydrant
⑤ Ø180 11.25° BEND	⑫ Ø315 DEAD END CAP
⑥ Ø180 22.5° BEND	⑬ Ø315 11.25° BEND
⑦ Ø180 45° BEND	

STAGE 6B3

A1

REV NO	DATE	REVISION PURPOSE / DESCRIPTION	DRAWN	RPEQ	RPEQ No	INITIALS	DATE
E	20/12/2023	ADD SOME ADMENDMENTS	JMc				
D	28/09/2023	FINAL	JMc				
C	06/09/2023	REMOVE SOME EXTRA ITEMS IN ABBOTT ST	JMc				10/08/2023
B	25/08/2023	PROGRESS	JMc				
A	10/08/2023	PROGRESS PLOT AS CON WATER	JMc				

veris

BRISBANE (07) 3666 4700
MACKAY (07) 4957 9700
veris.com.au
ACN 615 735 727
Veris Australia Pty Ltd


WHITSUNDAYS
(07) 4945 6600
CAIRNS
(07) 4052 9400

QUEENSLAND
UrbanUtilities

DAWN WALLOON
Banjo Drive Walloon

STAGE 6B3
AS CONSTRUCTED WATER

DRAWING STATUS AS CONSTRUCTED	
SHEET 3 OF 4 SHEETS	
DRAWING NO. 401905-6B3-AW01	REV. E

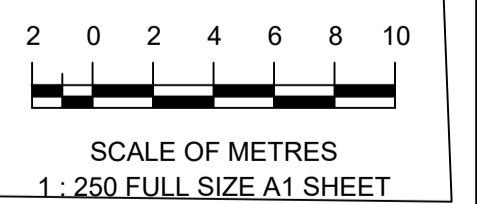

POL OF



LEGEND

- NEW HYDRANT
- NEW SLUICE VALVE
- NEW TEE
- NEW END CAP
- NEW TAPER
- NEW WATER SERVICE CONDUIT (Ø100 PVC-O PN16)
- NEW WATER SERVICE (Ø25 PE PN16)
- NEW WATER METER
- NEW WATER HOUSE CONNECTION (TAPPING BAND)
- NEW WATER MAIN (Ø180 PE-100 PN16)
- WATER MARKER

- ① Ø180 STOP VALVE
- ② Ø180 FIRE HYDRANT
- ③ Ø180 x Ø180 TEE
- ④ Ø180 DEAD END CAP
- ⑤ Ø180 11.25° BEND
- ⑥ Ø180 22.5° BEND
- ⑦ Ø180 45° BEND
- ⑧ Ø180 90° BEND
- ⑨ Ø180 x Ø315 Tee
- ⑩ Ø315 Stop Valve
- ⑪ Ø315 Fire Hydrant
- ⑫ Ø315 DEAD END CAP
- ⑬ Ø315 11.25° BEND

REGISTERED SURVEYOR'S CERTIFICATION

I, Veris Australia Pty Ltd, hereby certify that the vertical and horizontal locations and dimensions shown on this plan are a true and correct record and were located by survey.


Registered Surveyor (sig.) [Signature] Reg. Surveyor No. 6448 Date 10/1/2024

ENGINEER'S CERTIFICATION

I, _____, hereby certify that:

- The information contained in this drawing / document is in compliance with approved drawings and design.
- The new water and sewerage works defined by this drawing have been designed and constructed in accordance with the SEQ Code.
- This represents an accurate record of as-constructed works.
- I accept responsibility for the information contained in this drawing / document.

RPEQ (signature) _____ RPEQ No. _____ Date: _____

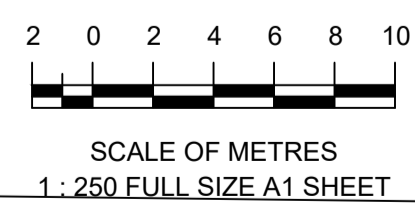

A1	E	20/12/2023	ADD SOME ADMENDMENTS	JMc					
	D	28/09/2023	FINAL	JMc					
	C	06/09/2023	REMOVE SOME EXTRA ITEMS IN ABBOTT ST	JMc			DRAWN	JMc	10/08/2023
	B	25/08/2023	PROGRESS	JMc			CHECKED		
	A	10/08/2023	PROGRESS PLOT AS CON WATER	JMc			APPROVED		
REV NO	DATE	REVISION PURPOSE / DESCRIPTION	DRAWN	RPEQ	RPEQ No	INITIALS	DATE		

BRISBANE (07) 3666 4700 WHITSUNDAYS (07) 4945 6600
 MACKAY (07) 4957 9700 CAIRNS (07) 4052 9400
 veris.com.au
 ACN 615 735 727
 Veris Australia Pty Ltd



DAWN WALLOON
 Banjo Drive Walloon
STAGE 6B3
 AS CONSTRUCTED WATER

DRAWING STATUS AS CONSTRUCTED	
SHEET 4 OF 4 SHEETS	
DRAWING NO. 401905-6B3-AW01	REV. E