

REGISTERED SURVEYOR'S CERTIFICATION

I, Veris Australia Pty Ltd, hereby certify that the vertical and horizontal locations and dimensions shown on this plan are a true and correct record and were located by survey.

[Signature] 6448 17/11/2023
 Delegate Cadastral Surveyor (sig.) Reg. Surveyor No. Date

ENGINEER'S CERTIFICATION


I, _____, hereby certify that:

- The information contained in this drawing / document is in compliance with approved drawings and design.
- This represents an accurate record of as-constructed works.
- I accept responsibility for the information contained in this drawing / document.


 RPEQ (signature) RPEQ No. Date:

LEGEND

- 42.5 AS CONSTRUCTED CONTOURS (Interval 0.25m)
- 43 CHANGE OF GRADE
- Top of Bank
- Bottom of Bank
- RETAINING WALL

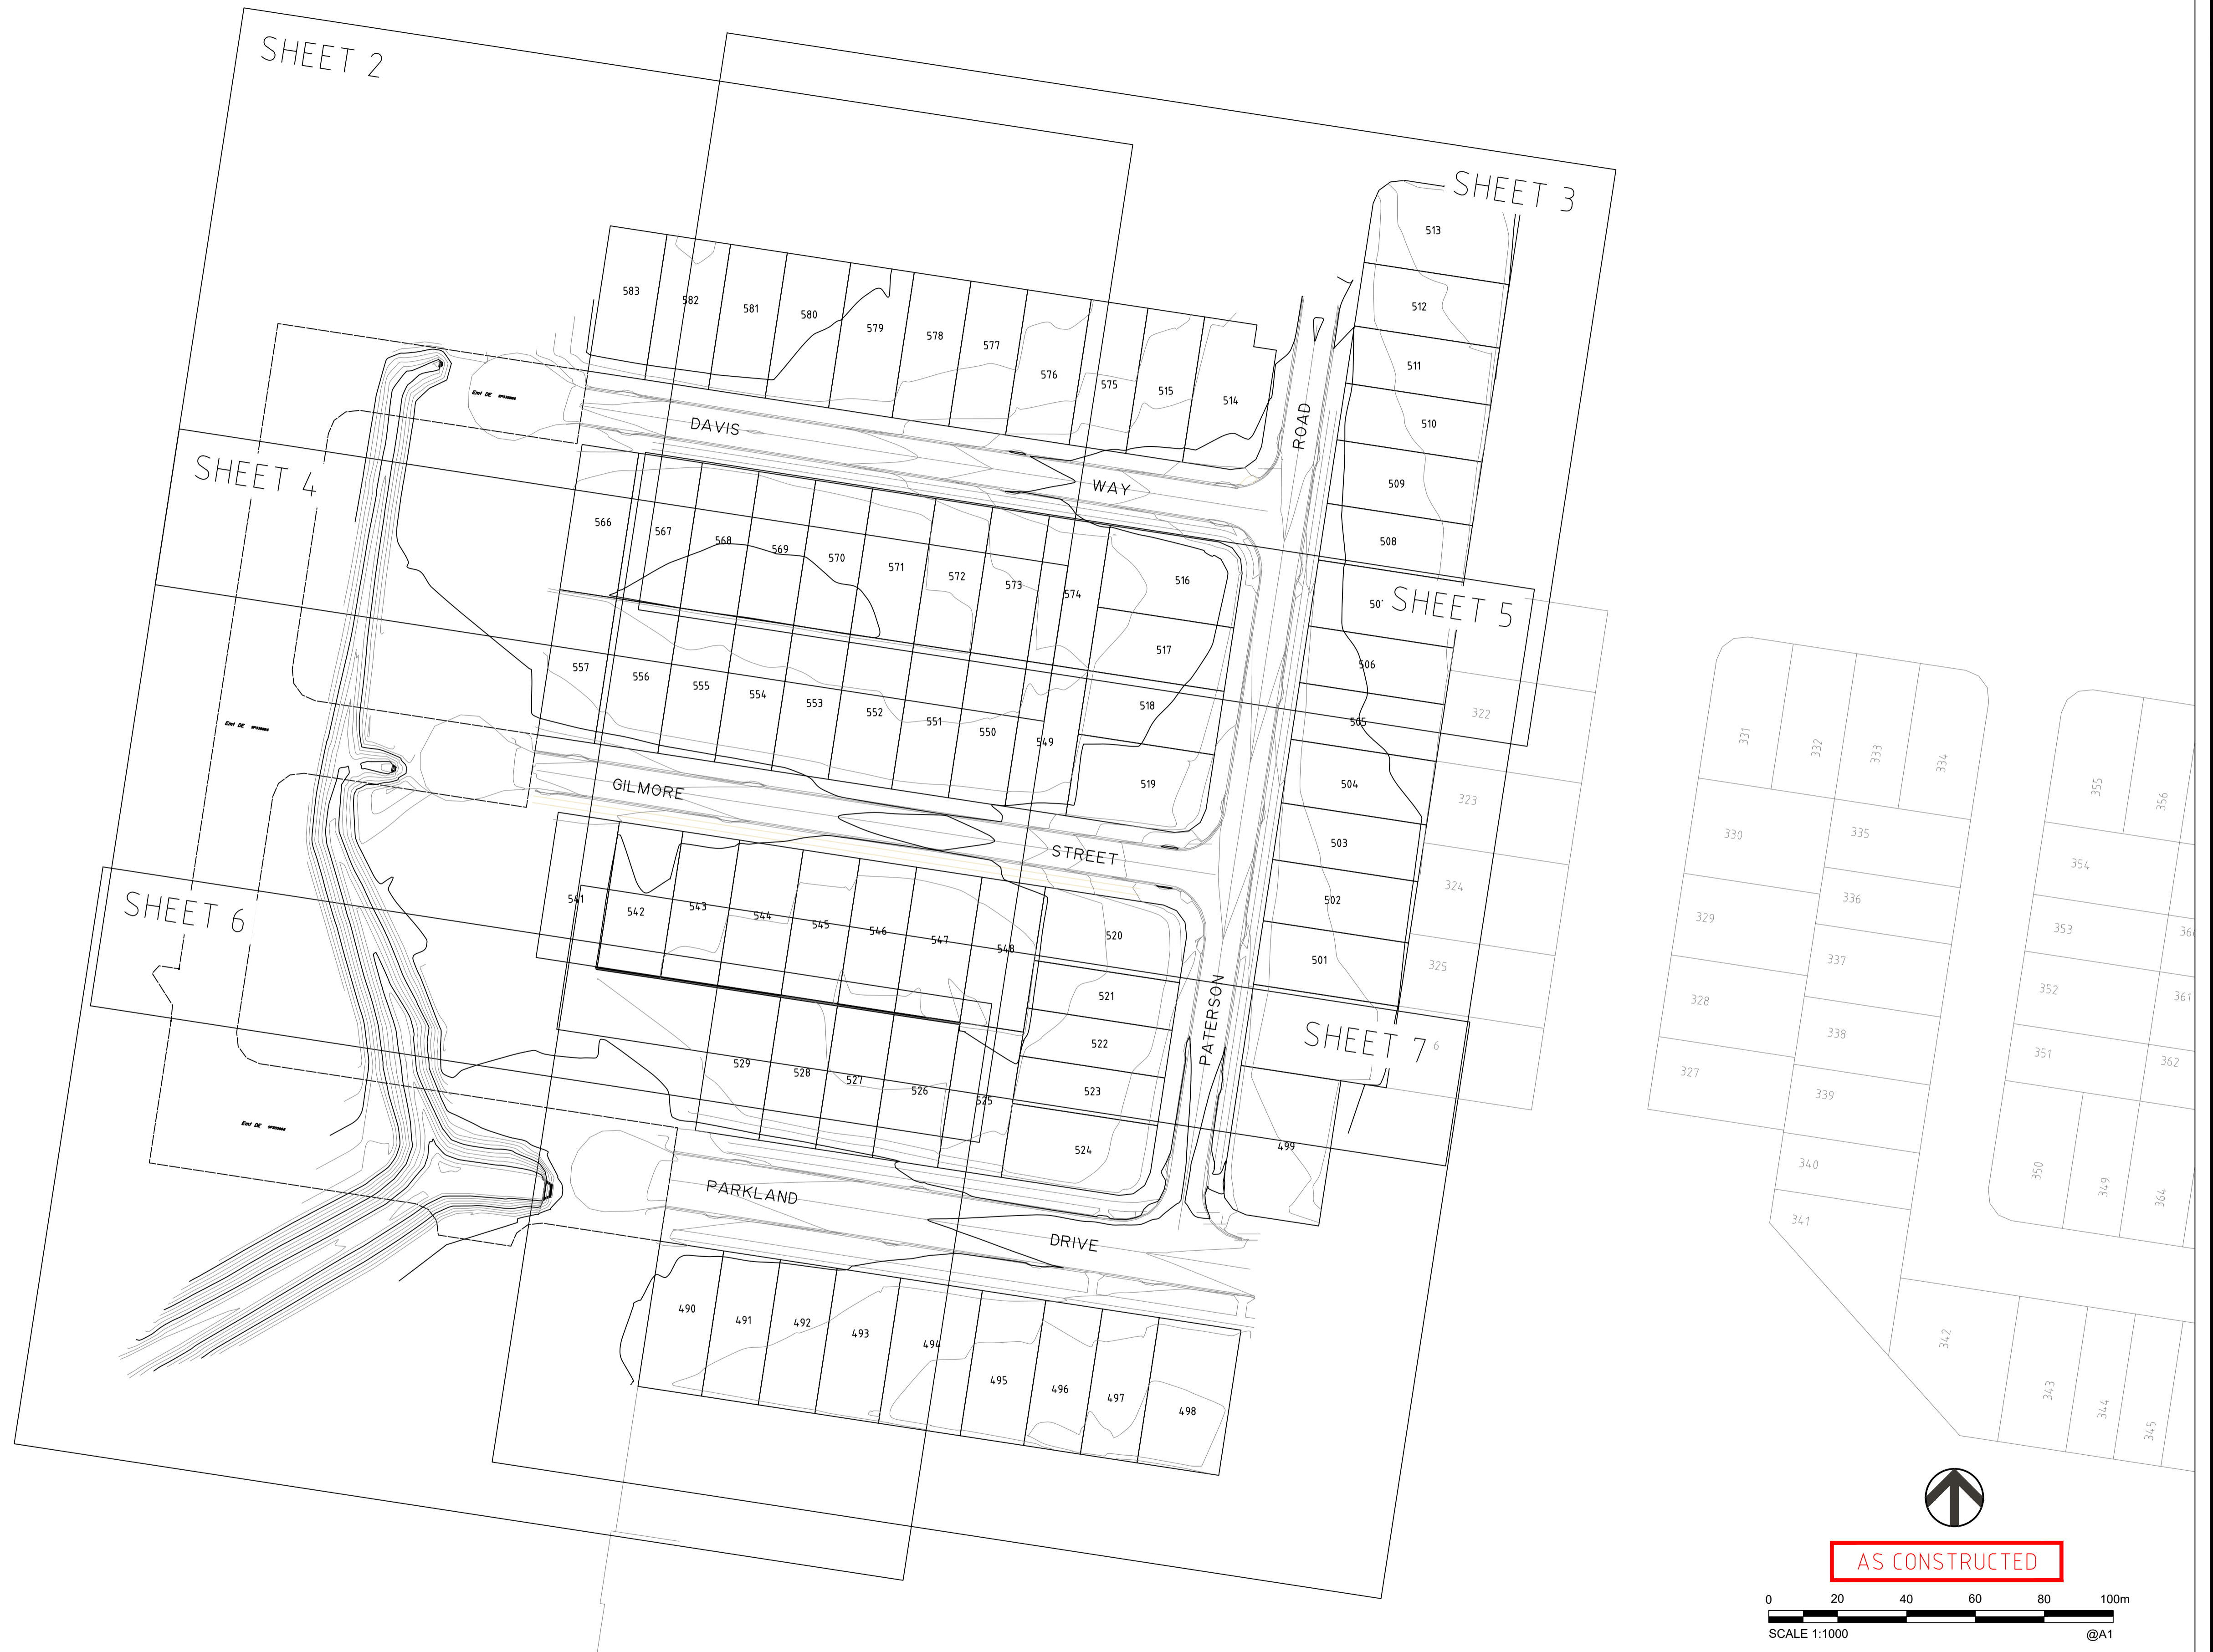

AS CONSTRUCTED

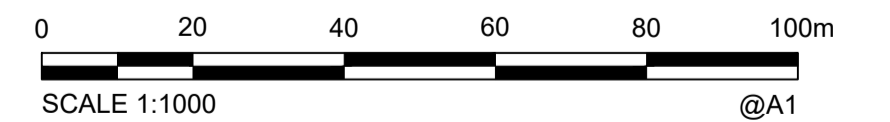

A1

INDEX	DATE	REVISIONS	DRAWN	CHECKED	PASSED
A	29/09/2023	PROGRESS PLOT	JMc		

DRAWN	JMc	29/09/2023
CHECKED		
PASSED		
INITIALS	DATE	

veris

BRISBANE (07) 3656 4700 WHITSUNDAYS (07) 4345 9900
 MACKAY (07) 4957 9700 CAIRNS (07) 4002 9400
 veris.com.au
 ACN 615 735 727
 Veris Australia Pty Ltd



IPSWICH CITY COUNCIL

WATERLEA WALLOON STAGES 6C1 + 6C2
 AS CONSTRUCTED
 EARTHWORKS

SCALE 1:500@A1
 SHEET 1 OF 3 SHEETS
 DRAWING NO.
401905-6C1-6C2-AEW01



REGISTERED SURVEYOR'S CERTIFICATION

I, Veris Australia Pty Ltd, hereby certify that the vertical and horizontal locations and dimensions shown on this plan are a true and correct record and were located by survey.

Michael Day, 6448, 17/11/2023. Delegate Cadastral Surveyor (sig.), Reg. Surveyor No., Date.

ENGINEER'S CERTIFICATION

I, hereby certify that:



- 1. The information contained in this drawing / document is in compliance with approved drawings and design.
2. This represents an accurate record of as-constructed works.
3. I accept responsibility for the information contained in this drawing / document.

RPEQ (signature), RPEQ No., Date.

LEGEND

- 42.5 AS CONSTRUCTED CONTOURS (Interval 0.25m)
43 Top of Bank
CHANGE OF GRADE
Bottom of Bank
RETAINING WALL

AS CONSTRUCTED

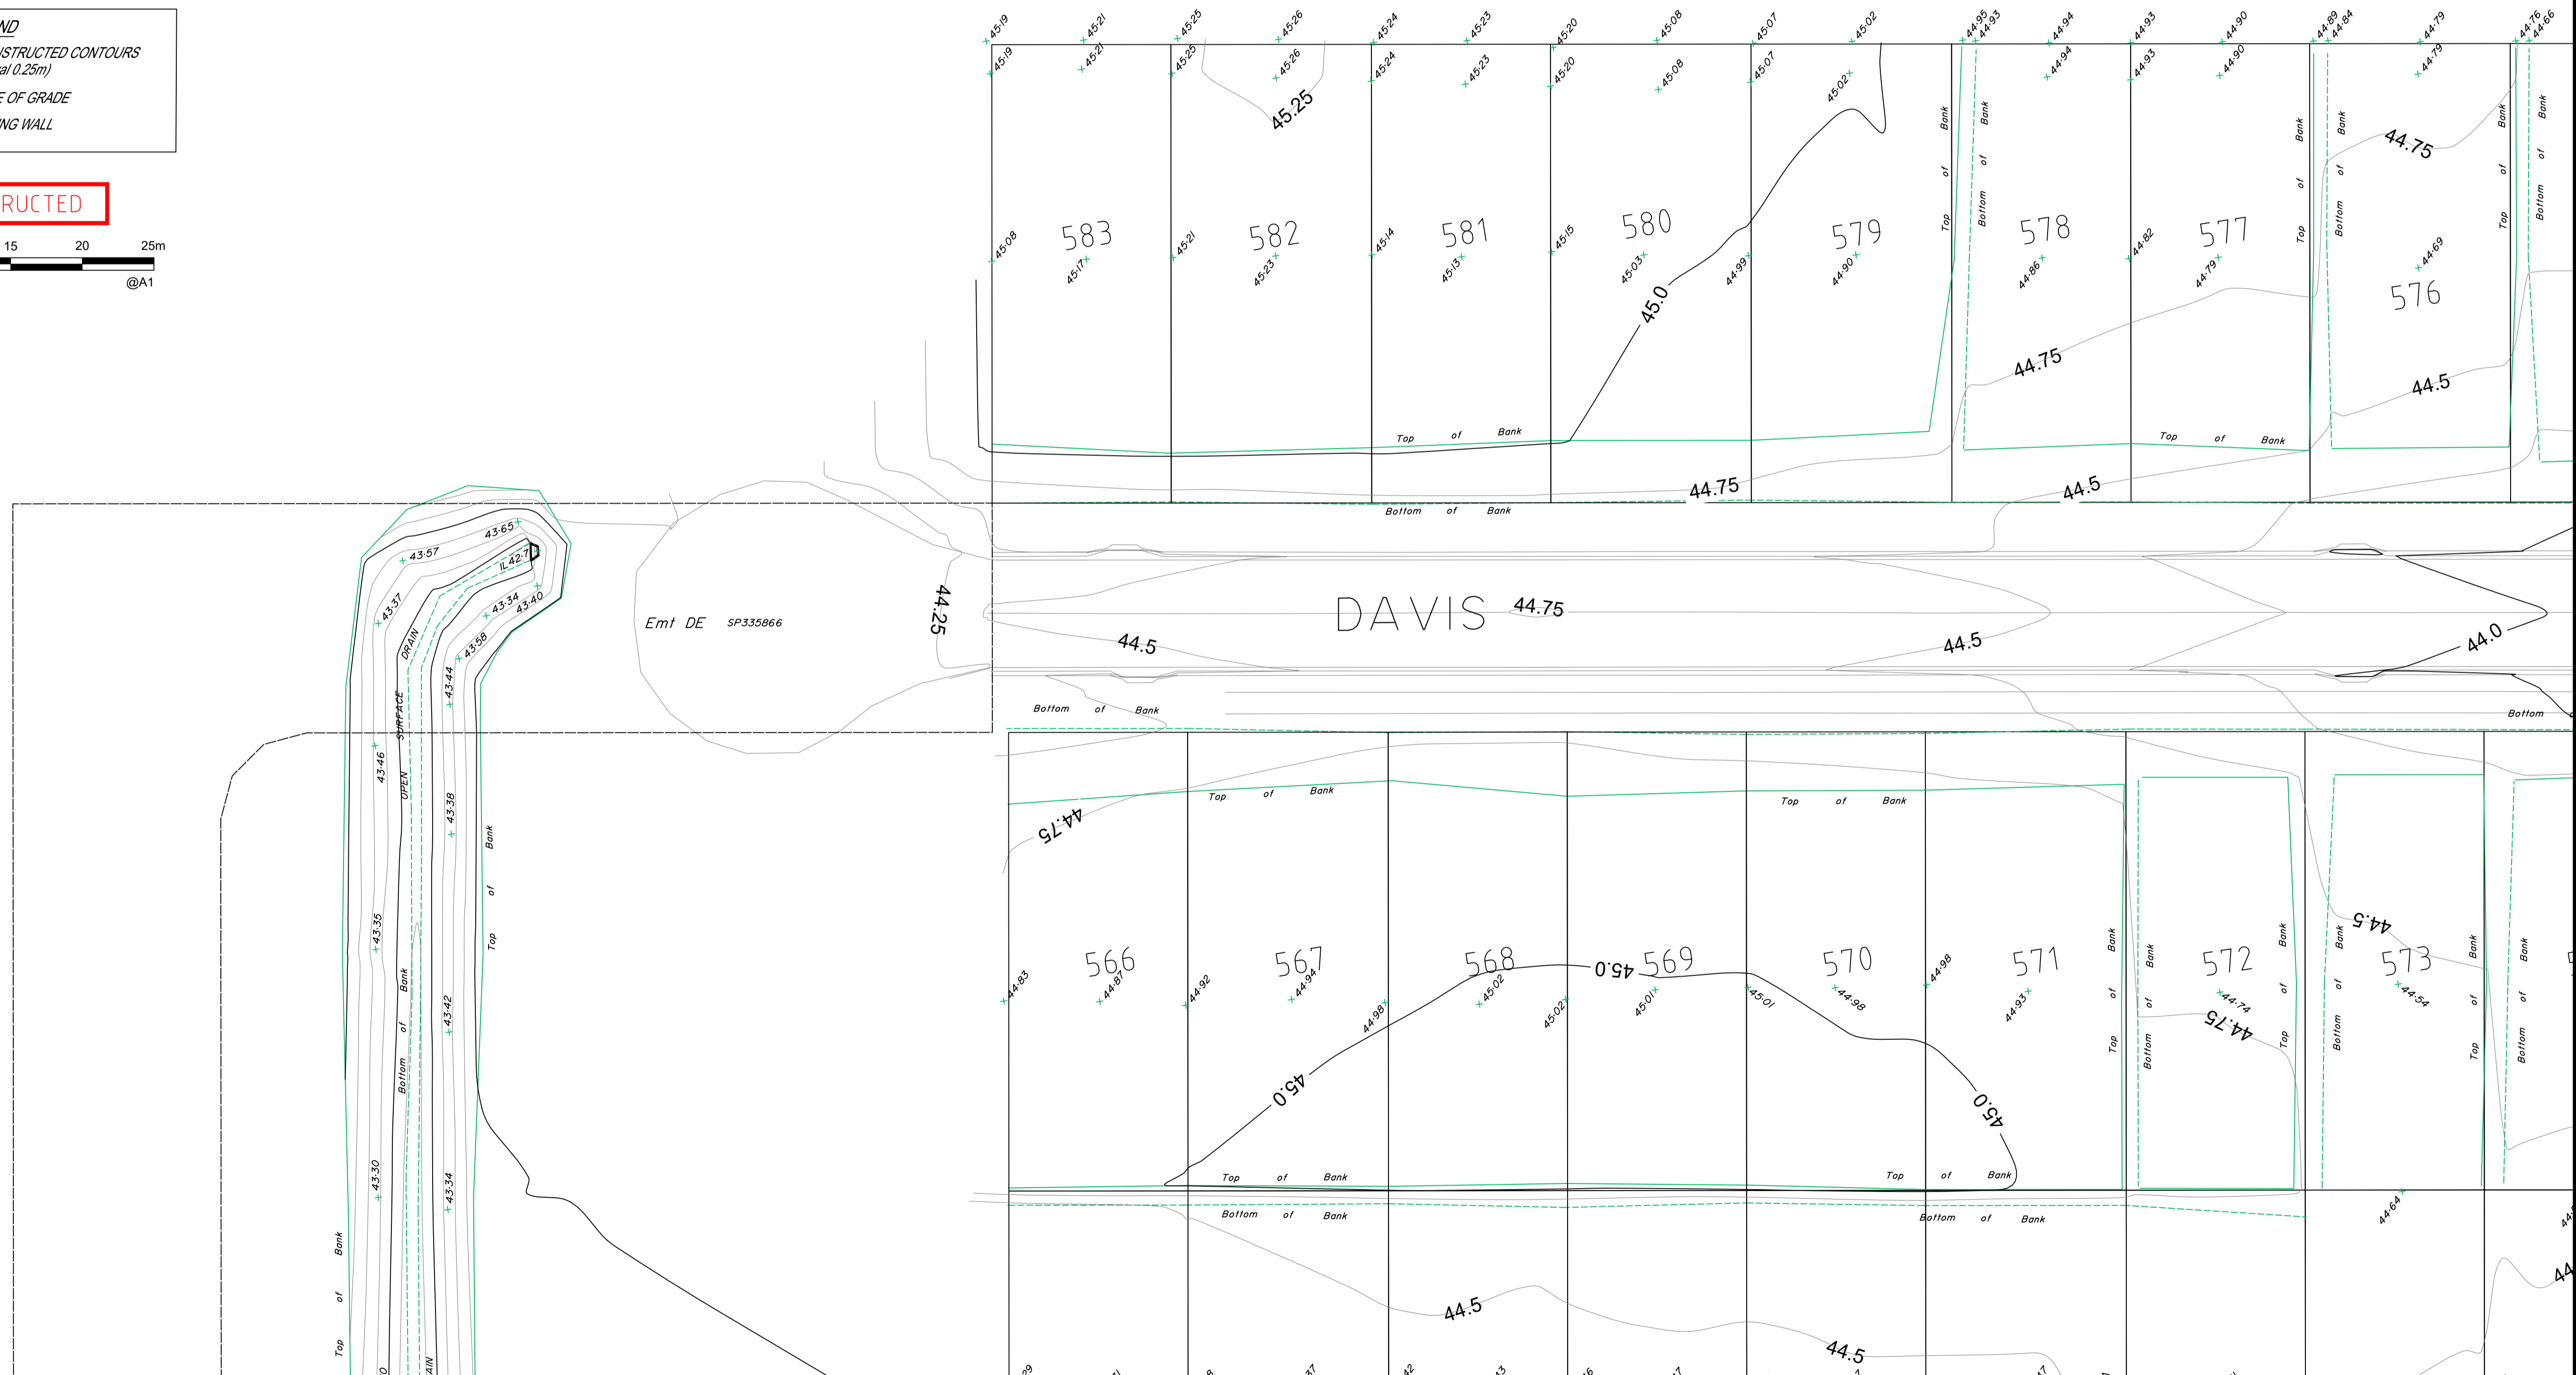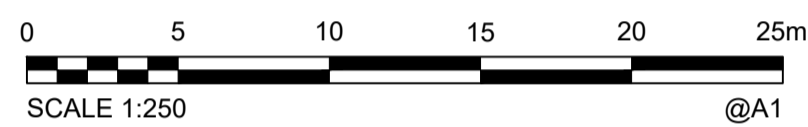


A1

Table with columns: INDEX, DATE, REVISIONS, DRAWN, CHECKED, PASSED. Row 1: A, 29/09/2023, PROGRESS PLOT, JMc.

Table with columns: DRAWN, CHECKED, PASSED, INITIALS, DATE. Row 1: JMc, 29/09/2023.

Logos for veris, BRISBANE WHITSUNDAYS, MACKAY CAIRNS, and veris.com.au.

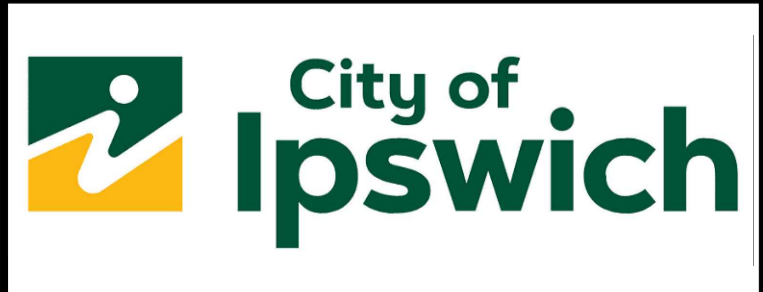

IPSWICH CITY COUNCIL
WATERLEA WALLOON STAGES 6C1 + 6C2
AS CONSTRUCTED
EARTHWORKS

Table with columns: SCALE, SHEET 2 OF 7 SHEETS, DRAWING NO., 401905-6B2-6B3-AEW01.

REGISTERED SURVEYOR'S CERTIFICATION

I, **Veris Australia Pty Ltd**, hereby certify that the vertical and horizontal locations and dimensions shown on this plan are a true and correct record and were located by survey.

[Signature] **6448** 17/11/2023
 Delegate Cadastral Surveyor (sig.) Reg. Surveyor No. Date

ENGINEER'S CERTIFICATION

I, _____, hereby certify that:

- The information contained in this drawing / document is in compliance with approved drawings and design.
- This represents an accurate record of as-constructed works.
- I accept responsibility for the information contained in this drawing / document.


 RPEQ (signature) RPEQ No. Date:

LEGEND

- 42.5 AS CONSTRUCTED CONTOURS (Interval 0.25m)
- 43 Top of Bank
- Bottom of Bank CHANGE OF GRADE
- RETAINING WALL

Em1 DE SP335866

AS CONSTRUCTED

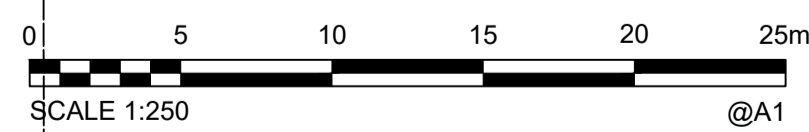

A1

DRAWN	JMc	29/09/2023
CHECKED		
PASSED		
INITIALS	DATE	



BRISBANE (07) 3656 4700 WHITSUNDAYS (07) 4345 0600
 MACKAY (07) 4957 9700 CAIRNS (07) 4052 9400
 veris.com.au
 ACN 615 735 727
 Veris Australia Pty Ltd



IPSWICH CITY COUNCIL

WATERLEA WALLOON STAGES 6C1 + 6C2
 AS CONSTRUCTED
 EARTHWORKS

SCALE	1:250@A1
SHEET	4 OF 7 SHEETS
DRAWING NO.	
	401905-6B2-6B3-AEW01

INDEX	DATE	REVISIONS	DRAWN	CHECKED	PASSED
A	29/09/2023	PROGRESS PLOT	JMc		



REGISTERED SURVEYOR'S CERTIFICATION

I, **Veris Australia Pty Ltd**, hereby certify that the vertical and horizontal locations and dimensions shown on this plan are a true and correct record and were located by survey.

Michael Capp 6448 17/11/2023
 Delegate Cadastral Surveyor (sig.) Reg. Surveyor No. Date

ENGINEER'S CERTIFICATION

I, _____, hereby certify that:


- The information contained in this drawing / document is in compliance with approved drawings and design.
- This represents an accurate record of as-constructed works.
- I accept responsibility for the information contained in this drawing / document.

RPEQ (signature) RPEQ No. Date:

LEGEND

42.5 AS CONSTRUCTED CONTOURS (Interval 0.25m)
 43
 Top of Bank CHANGE OF GRADE
 Bottom of Bank RETAINING WALL

AS CONSTRUCTED

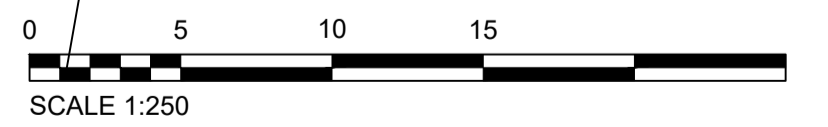

A1									
A	29/09/2023	PROGRESS PLOT							
INDEX	DATE	REVISIONS	DRAWN	CHECKED	PASSED	INITIALS	DATE		

DRAWN	JM	29/09/2023
CHECKED		
PASSED		




BRISBANE 071 3555 4700 WHITSUNDAYS 071 4845 0600
 MACKAY 071 4927 9700 CAIRNS 071 4252 9400
 veris.com.au
 ACN 615 735 727
 Veris Australia Pty Ltd



IPSWICH CITY COUNCIL

WATERLEA WALLOON STAGES 6C1 + 6C2
 AS CONSTRUCTED
 EARTHWORKS

SCALE	1:250@A1
SHEET	5 OF 7 SHEETS
DRAWING NO.	
	401905-6B2-6B3-AEW01

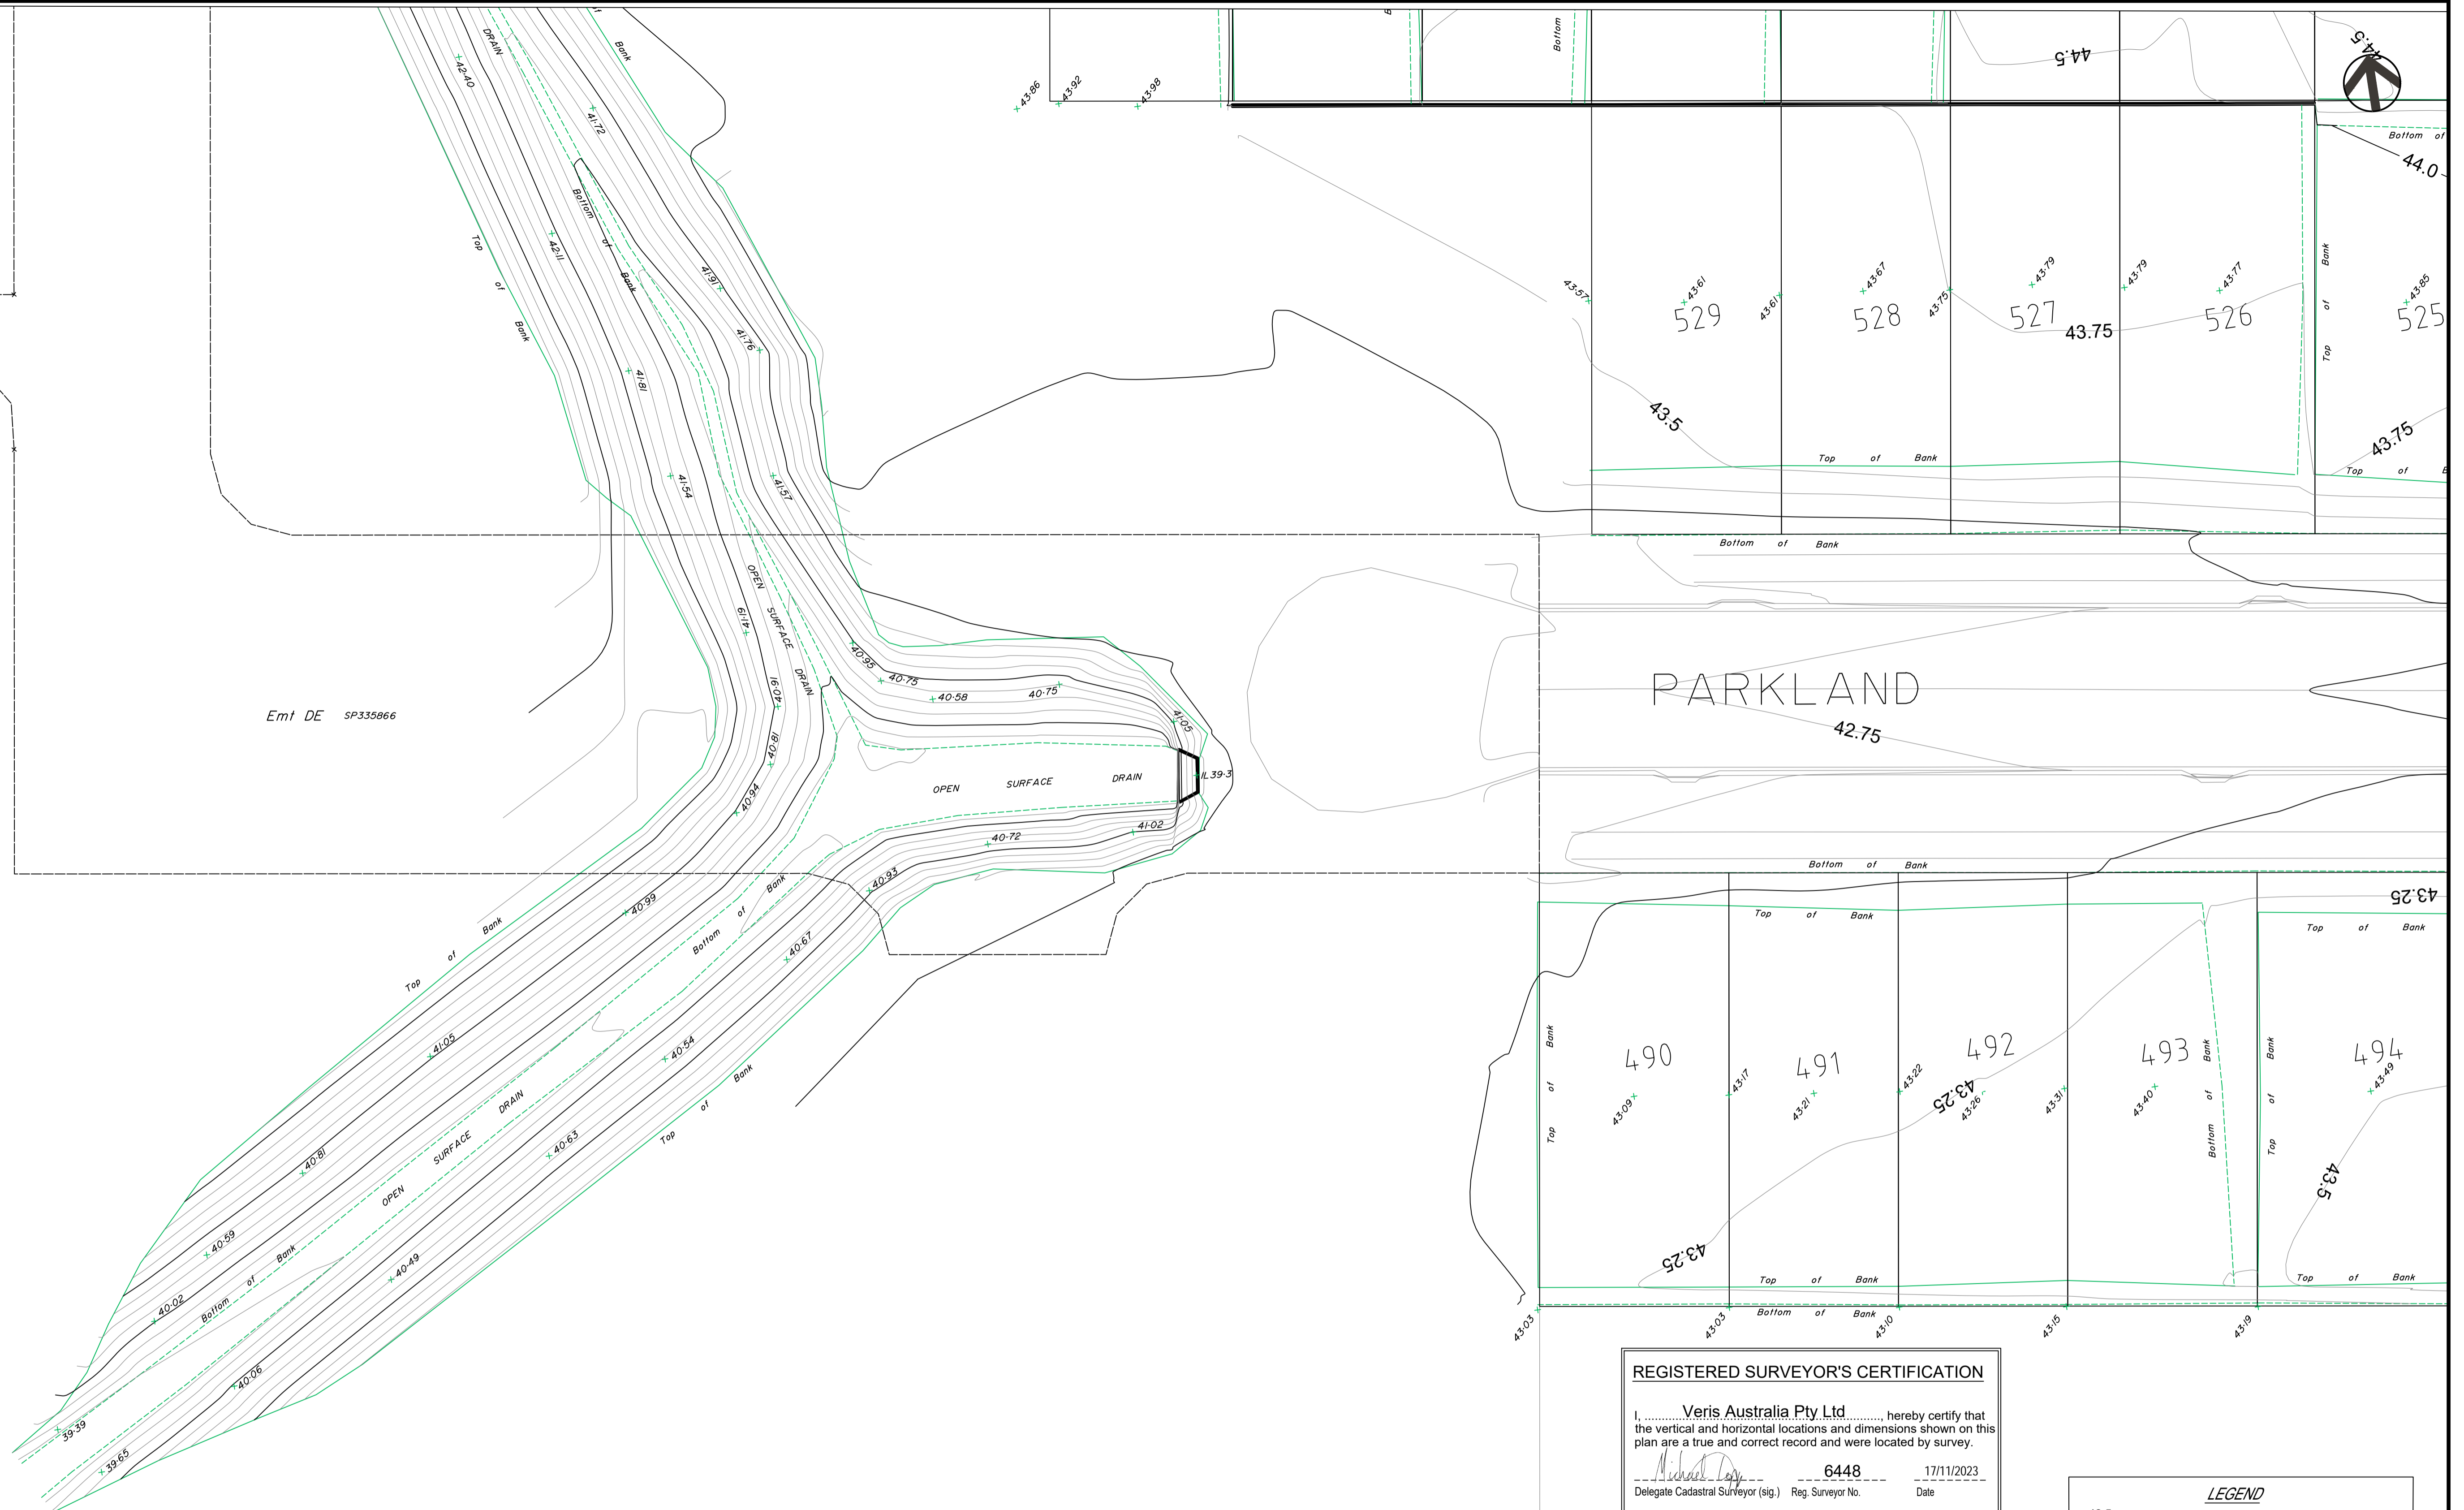


Eml DE SP335866

PARKLAND

REGISTERED SURVEYOR'S CERTIFICATION
 I, Veris Australia Pty Ltd, hereby certify that the vertical and horizontal locations and dimensions shown on this plan are a true and correct record and were located by survey.
 Delegate Cadastral Surveyor (sig.) Reg. Surveyor No. 6448 Date 17/11/2023

ENGINEER'S CERTIFICATION
 I, _____, hereby certify that:
 1. The information contained in this drawing / document is in compliance with approved drawings and design.
 2. This represents an accurate record of as-constructed works.
 3. I accept responsibility for the information contained in this drawing / document.
 RPEQ (signature) RPEQ No. Date:


LEGEND
 42.5 AS CONSTRUCTED CONTOURS (Interval 0.25m)
 Top of Bank
 Bottom of Bank
 CHANGE OF GRADE
 RETAINING WALL

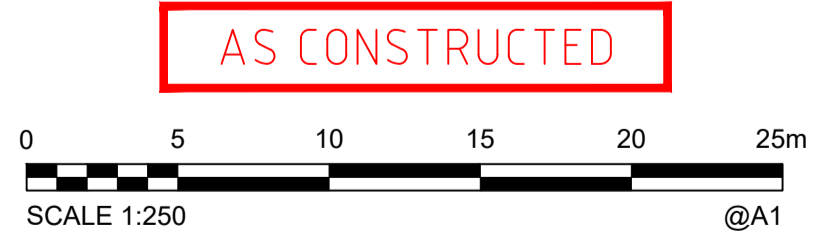

A1									
	A	29/09/2023	PROGRESS PLOT						
INDEX	DATE	REVISIONS		DRAWN	CHECKED	PASSED	INITIALS	DATE	

DRAWN	JMc	29/09/2023
CHECKED		
PASSED		

BRISBANE (07) 3066 4700 WHITSUNDAYS (07) 4343 6600
 MACKAY (07) 4957 8700 CAIRNS (07) 4052 8400
 veris.com.au
 ACN 615 735 727
 Veris Australia Pty Ltd

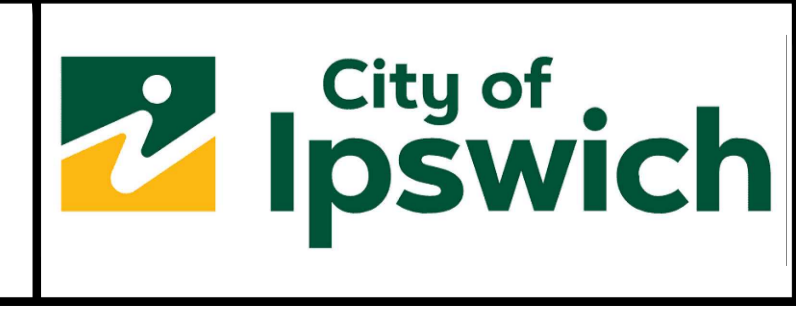

IPSWICH CITY COUNCIL
 WATERLEA WALLOON STAGES 6C1 + 6C2
 AS CONSTRUCTED
 EARTHWORKS

SCALE	1:250@A1
SHEET	6 OF 7 SHEETS
DRAWING NO.	
	401905-6B2-6B3-AEW01

