

ENGINEER'S CERTIFICATION


I, _____, hereby certify that:

- The information contained in this drawing / document is in compliance with approved drawings and design.
- This represents an accurate record of as-constructed works.
- I accept responsibility for the information contained in this drawing / document.

RPEQ (signature) _____ RPEQ No. _____ Date: _____

Registered Surveyor's Certification.

We, VERIS AUSTRALIA P/L, hereby certify that the horizontal and vertical locations, and dimensions shown on this plan are a true and correct record of the As Constructed information.

Signed:  Cadastral Surveyor & Delegate Reg. No. 6448

Dated: 5 June 2024



LEGEND

42.5 AS CONSTRUCTED CONTOURS (Interval 0.25m)


43

Top of Bank

Bottom of Bank

CHANGE OF GRADE

RETAINING WALL

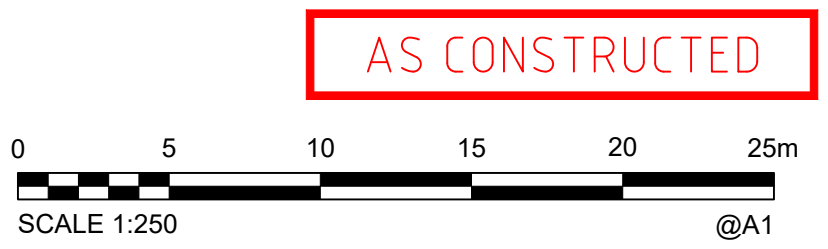

AS CONSTRUCTED

A1	C	05/06/2024	INCLUDE SWALE DRAIN IN STAGE 2 AREA	JMc		
	B	17/04/2024	UPDATE SURVEYORS CERTIFICATE BOX	JMc		
	A	14/03/2024	PROGRESS PLOT	JMc		
	INDEX	DATE	REVISIONS	DRAWN	CHECKED	PASSED

DRAWN	JMc	06/02/2024
CHECKED		
PASSED		
INITIALS		DATE

veris


BRISBANE (07) 3860 4700 WHITSUNDAYS (07) 4945 0500
 MACKAY (07) 4697 9700 CAIRNS (07) 4332 3600
 veris.com.au
 ACN 615 735 727
 Veris Australia Pty Ltd



IPSWICH CITY COUNCIL

WATERLEA WALLOON STAGES 1 GIBBS DAWN WALLOON
 AS CONSTRUCTED
 EARTHWORKS

SCALE	1:250 @A1
SHEET	2 OF 4 SHEETS
DRAWING NO.	
401905-611-AFS01 C	

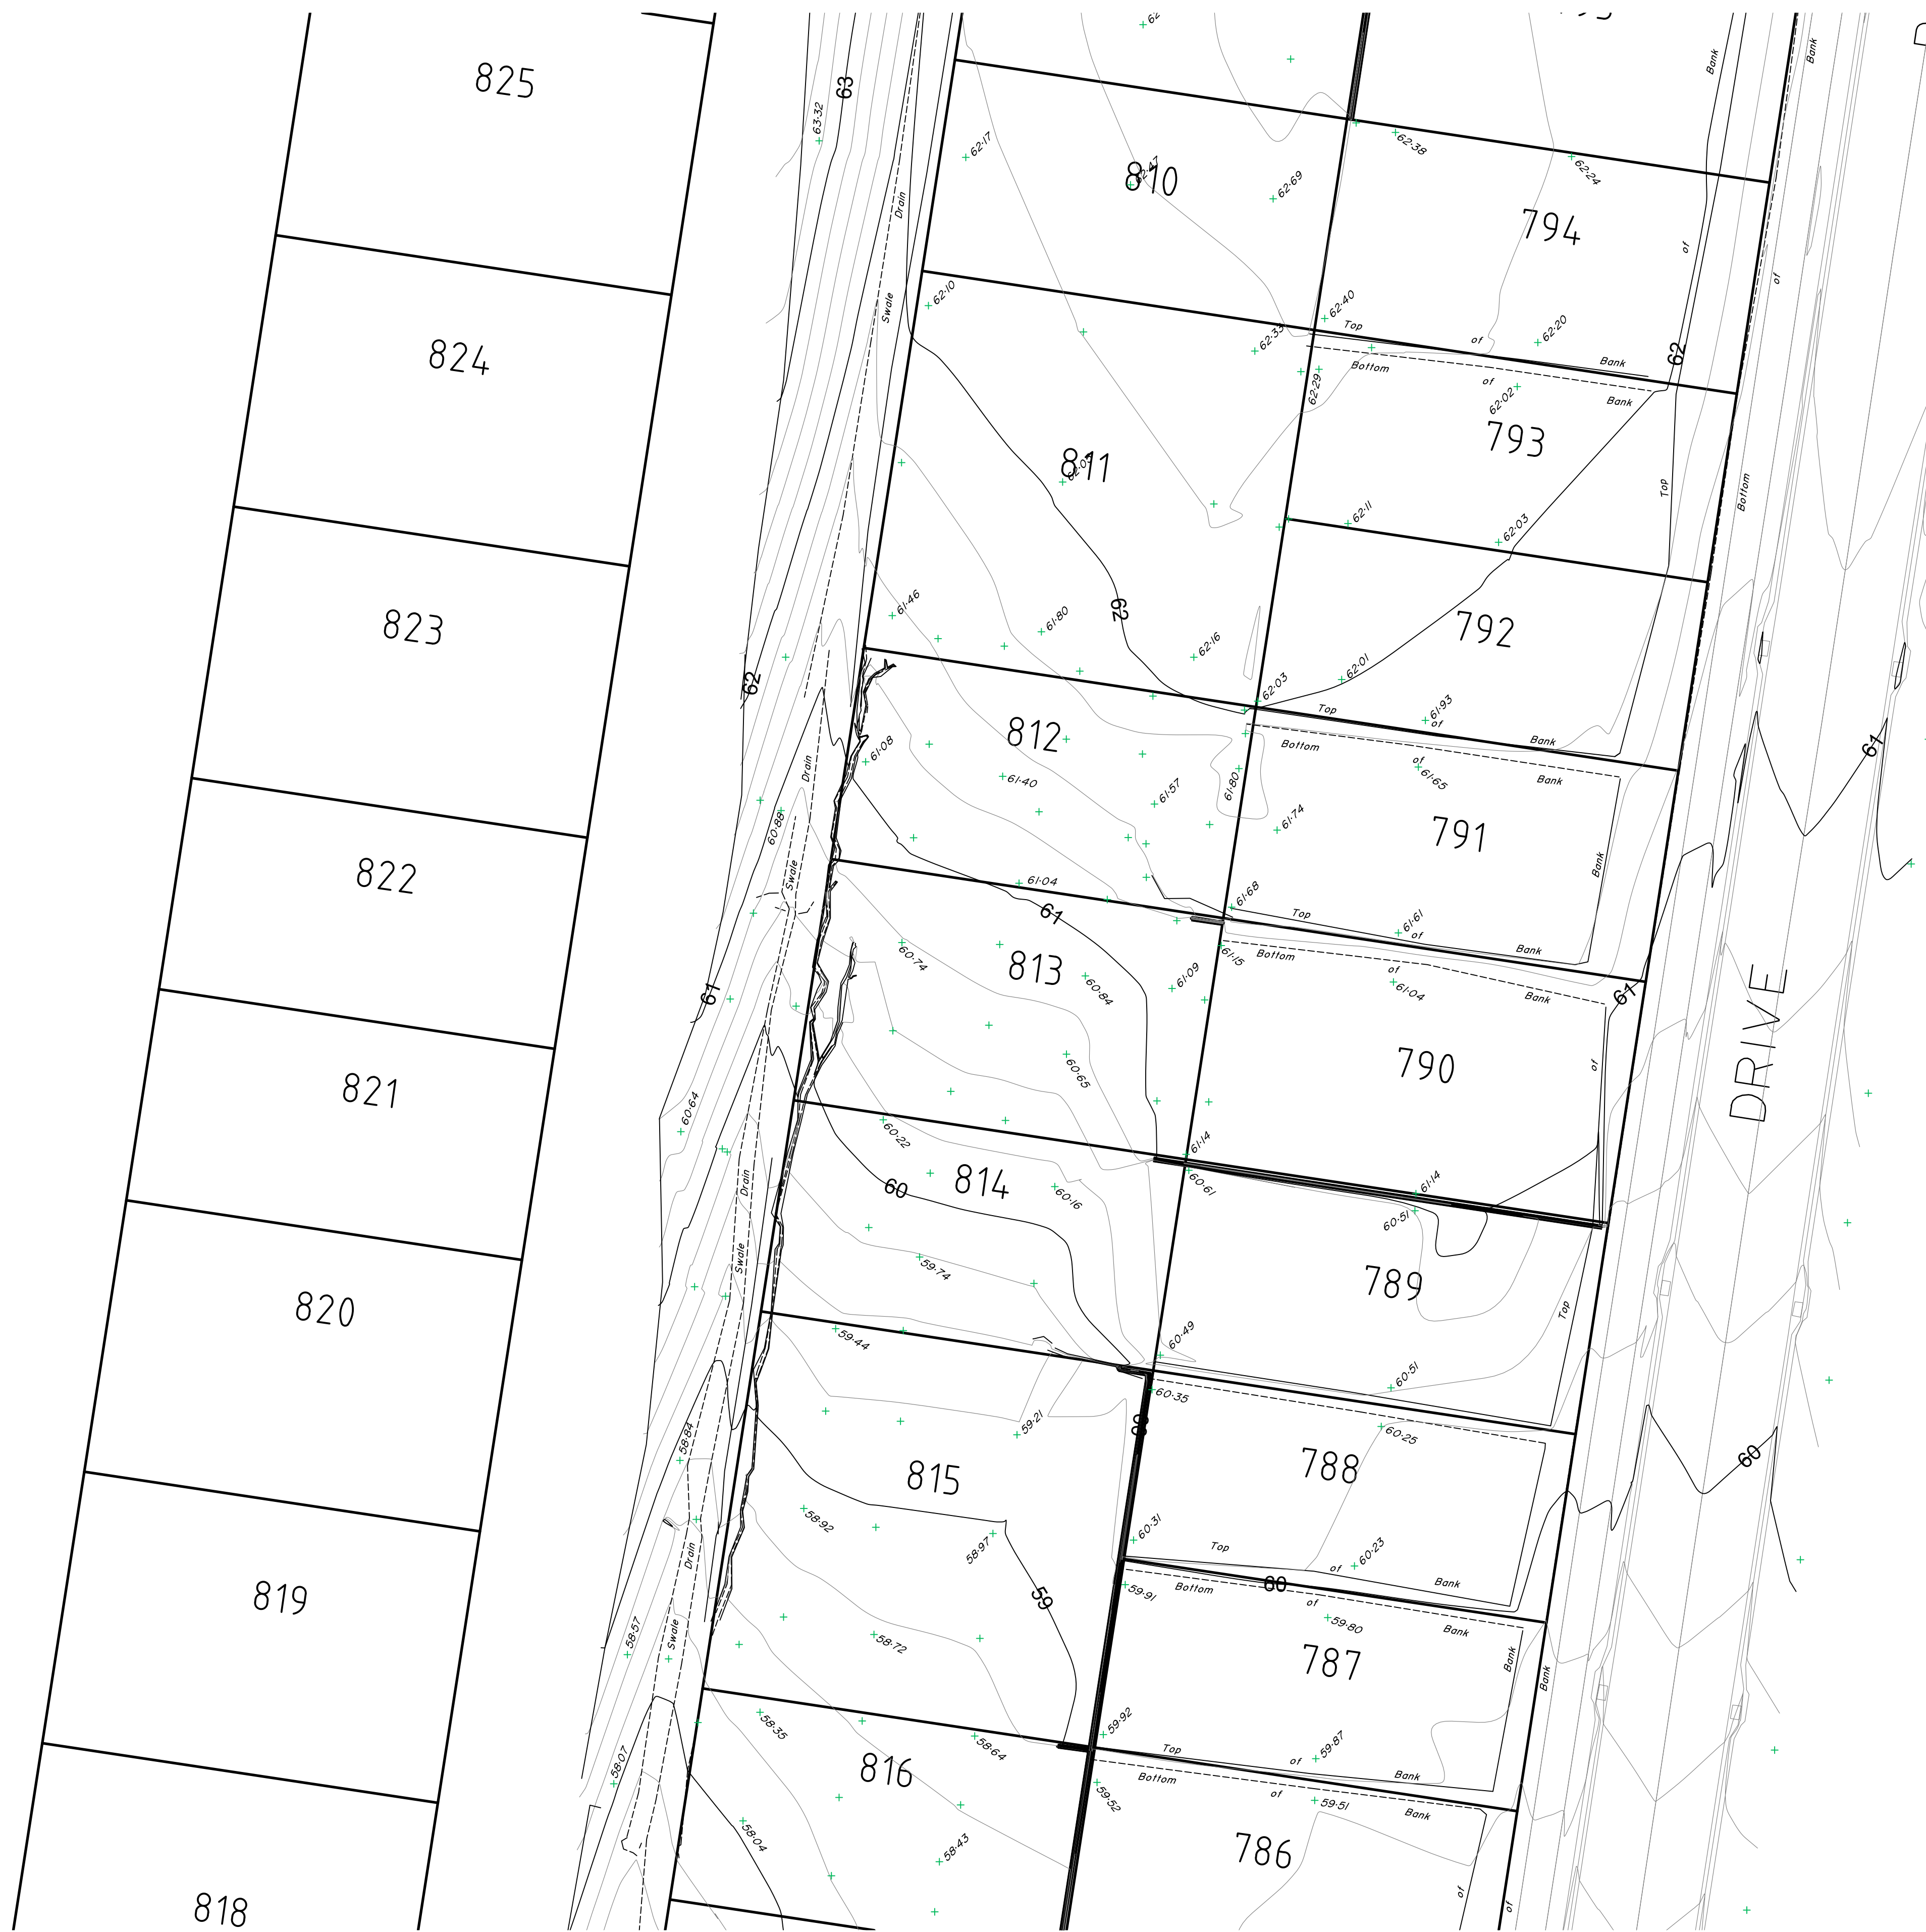

ENGINEER'S CERTIFICATION

I,, hereby certify that:

- The information contained in this drawing / document is in compliance with approved drawings and design.
- This represents an accurate record of as-constructed works.
- I accept responsibility for the information contained in this drawing / document.

RPEQ (signature) RPEQ No. Date:

Registered Surveyor's Certification.

We, VERIS AUSTRALIA P/L hereby certify that the horizontal and vertical locations, and dimensions shown on this plan are a true and correct record of the As Constructed information.

Signed: *[Signature]* Cadastral Surveyor Reg. No. 6448
& Delegate

Dated: 5 June 2024


LEGEND

42.5 AS CONSTRUCTED CONTOURS (Interval 0.25m)

43 Top of Bank

Bottom of Bank CHANGE OF GRADE

RETAINING WALL

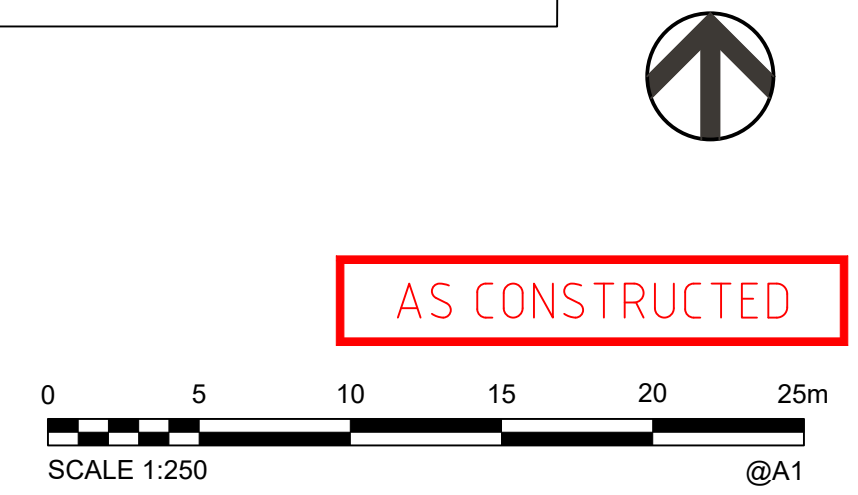

AS CONSTRUCTED

A1	C	05/06/2024	INCLUDE SWALE DRAIN IN STAGE 2 AREA	JMc		
	B	17/04/2024	UPDATE SURVEYORS CERTIFICATE BOX	JMc		
	A	14/03/2024	PROGRESS PLOT	JMc		
	INDEX	DATE	REVISIONS	DRAWN	CHECKED	PASSED

DRAWN	JMc	06/02/2024
CHECKED		
PASSED		
INITIALS		DATE

veris

BRISBANE (07) 3860 4700
WHITSUNDAYS (07) 4945 0500
MACKAY (07) 4687 9700
CAIRNS (07) 4232 9400
veris.com.au
ACN 615 735 727
Veris Australia Pty Ltd



IPSWICH CITY COUNCIL

WATERLEA WALLOON STAGES 1 GIBBS DAWN WALLOON
AS CONSTRUCTED
EARTHWORKS

SCALE	1:250 @A1
SHEET	3 OF 4 SHEETS
DRAWING NO.	
401905-611-AFS01 C	



ENGINEER'S CERTIFICATION

I, hereby certify that:

- The information contained in this drawing / document is in compliance with approved drawings and design.
- This represents an accurate record of as-constructed works.
- I accept responsibility for the information contained in this drawing / document.

RPEQ (signature) _____ RPEQ No. _____ Date: _____

Registered Surveyor's Certification.

We, **VERIS AUSTRALIA P/L** hereby certify that the horizontal and vertical locations, and dimensions shown on this plan are a true and correct record of the As Constructed information.

[Signature] Cadastral Surveyor & Delegate Reg. No. 6448

Signed.....

Dated **5 June 2024**

LEGEND


42.5 AS CONSTRUCTED CONTOURS (Interval 0.25m)

43 CHANGE OF GRADE


Top of Bank

Bottom of Bank

RETAINING WALL

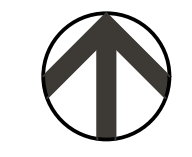

AS CONSTRUCTED

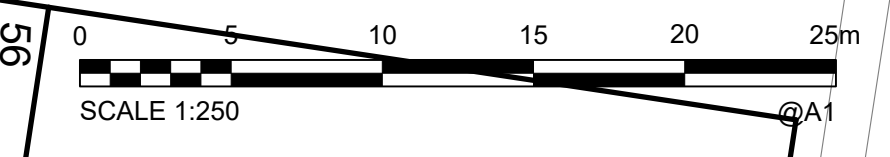

A1	C	05/06/2024	INCLUDE SWALE DRAIN IN STAGE 2 AREA	JMc		
	B	17/04/2024	UPDATE SURVEYORS CERTIFICATE BOX	JMc		
	A	14/03/2024	PROGRESS PLOT	JMc		
	INDEX	DATE	REVISIONS	DRAWN	CHECKED	PASSED

DRAWN	JMc	06/02/2024
CHECKED		
PASSED		
INITIALS		DATE

veris

BRISBANE (07) 3800 4700 WHITSUNDAYS (07) 4945 0600
 MACKAY (07) 4697 9700 CAIRNS (07) 4332 3400
 veris.com.au
 ACN 615 735 727
 Veris Australia Pty Ltd



IPSWICH CITY COUNCIL

WATERLEA WALLOON STAGES 1 GIBBS DAWN WALLOON
 AS CONSTRUCTED
 EARTHWORKS

SCALE	1:250 @A1
SHEET	4 OF 4 SHEETS
DRAWING NO.	
	C
	B
	A
	401905-611-AFS01 C