



ENGINEER'S CERTIFICATION


I, hereby certify that:



1. The information contained in this drawing / document is in compliance with approved drawings and design.
2. This represents an accurate record of as-constructed works.
3. I accept responsibility for the information contained in this drawing / document.

RPEQ (signature) RPEQ No. Date: -----

Registered Surveyor's Certification.

We, VERIS AUSTRALIA P/L hereby certify that the horizontal and vertical locations, and dimensions shown on this plan are a true and correct record of the As Constructed information.

Signed:  Cadastral Surveyor & Delegate Reg. No. 6448.....
Dated: 5 June 2024

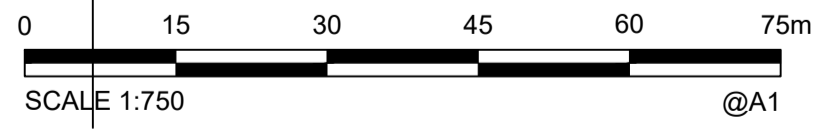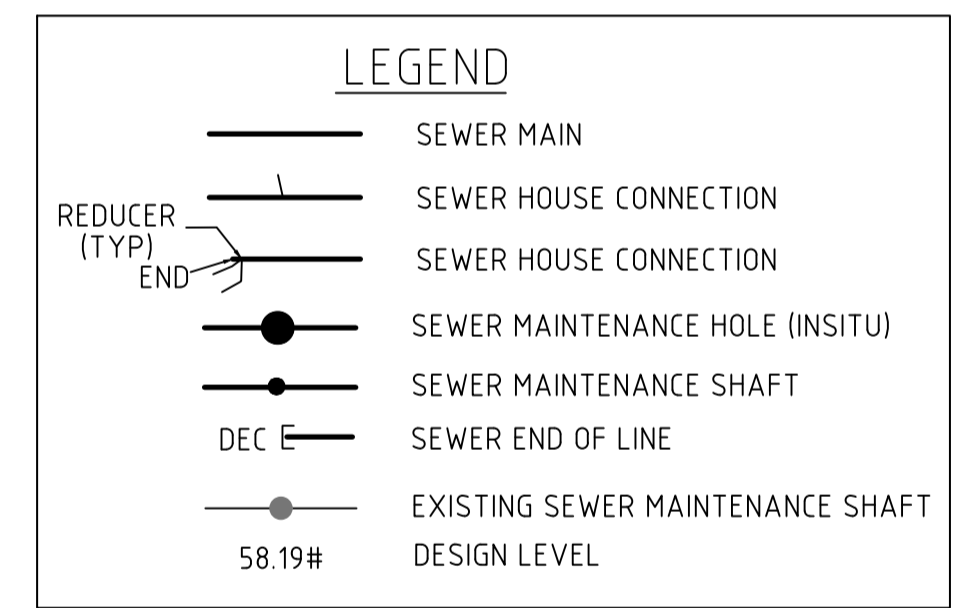

A1

REV NO	DATE	REVISION PURPOSE / DESCRIPTION	DRAWN	RPEQ	RPEQ No	INITIALS	DATE
B	17/04/2024	CORRECT SEWER MH DIA 1/1 2/1, 3/1, 4/1 & 1/2 TO 900mm	JMc				
A	05/02/2024	PROGRESS PLOT AS CON SEWER	JMc				

BRISBANE (07) 3666 4700	WHITSUNDAYS (07) 4945 6600
MACKAY (07) 4957 9100	CAIRNS (07) 4052 9400
veris.com.au	
ACN 615 735 727 Veris Australia Pty Ltd	



DAWN WALLOON
Banjo Drive Walloon

GIBBS STAGE 1
AS CONSTRUCTED SEWER

DRAWING STATUS AS CONSTRUCTED	
SHEET 1 OF 5 SHEETS	
DRAWING NO. 401905-611-AS01	REV. B



ENGINEER'S CERTIFICATION

I,, hereby certify that:



- The information contained in this drawing / document is in compliance with approved drawings and design.
- This represents an accurate record of as-constructed works.
- I accept responsibility for the information contained in this drawing / document.

RPEQ (signature) RPEQ No. Date:

Registered Surveyor's Certification.

We, VERIS AUSTRALIA P/L hereby certify that the horizontal and vertical locations, and dimensions shown on this plan are a true and correct record of the As Constructed information.

Signed:  Cadastral Surveyor & Delegate Reg. No. 6448
 Dated: 5 June 2024

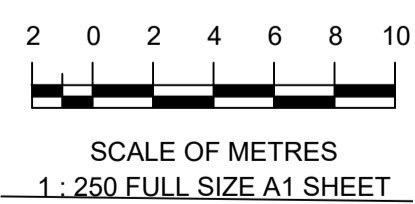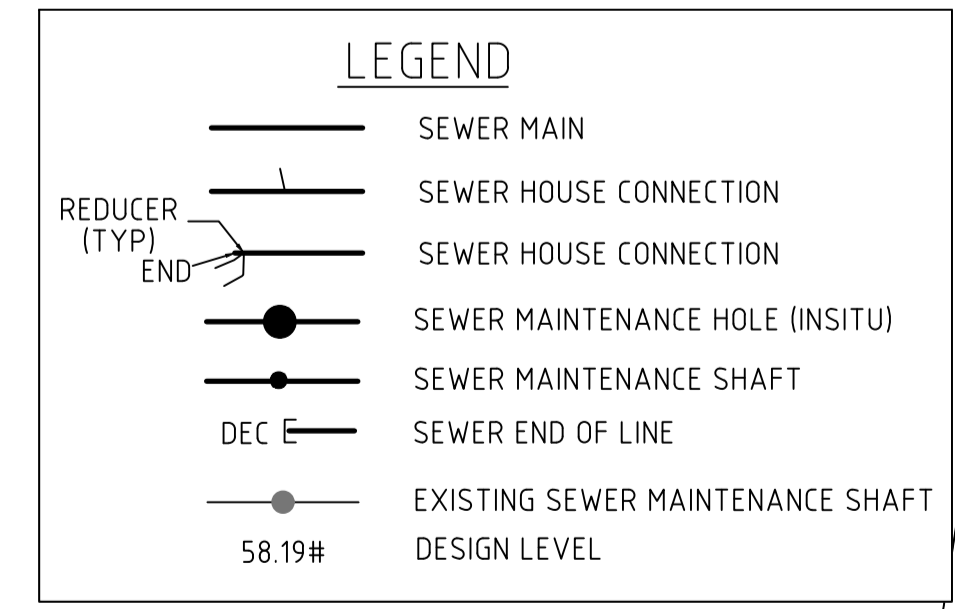

A1	B	17/04/2024	CORRECT SEWER MH DIA 1/1 2/1, 3/1, 4/1 & 1/2 TO 900mm	JMc																			
	A	05/02/2024	PROGRESS PLOT AS CON SEWER	JMc																			
	REV NO	DATE	REVISION PURPOSE / DESCRIPTION	DRAWN	RPEQ	RPEQ No																	

veris

BRISBANE (07) 3666 4700
 WHITSUNDAYS (07) 4945 6600
 MACKAY (07) 4957 9700
 CAIRNS (07) 4052 9400


veris.com.au
 ACN 615 735 727
 Veris Australia Pty Ltd



DAWN WALLOON
 Banjo Drive Walloon

GIBBS STAGE 1
 AS CONSTRUCTED SEWER

DRAWING STATUS AS CONSTRUCTED	
SHEET 2 OF 5 SHEETS	
DRAWING NO. 401905-611-AS01	REV. B

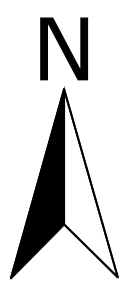

ENGINEER'S CERTIFICATION

I, _____, hereby certify that:

- The information contained in this drawing / document is in compliance with approved drawings and design.
- This represents an accurate record of as-constructed works.
- I accept responsibility for the information contained in this drawing / document.

_____ RPEQ (signature) _____ RPEQ No. _____ Date:

Registered Surveyor's Certification.


We, VERIS AUSTRALIA P/L, hereby certify that the horizontal and vertical locations, and dimensions shown on this plan are a true and correct record of the As Constructed information.

Signed: Cadastral Surveyor & Delegate
 Reg. No. 6448

Dated 5 June 2024

LEGEND

	SEWER MAIN
	SEWER HOUSE CONNECTION
	SEWER HOUSE CONNECTION
	SEWER MAINTENANCE HOLE (INSITU)
	SEWER MAINTENANCE SHAFT
	SEWER END OF LINE
	EXISTING SEWER MAINTENANCE SHAFT
	DESIGN LEVEL

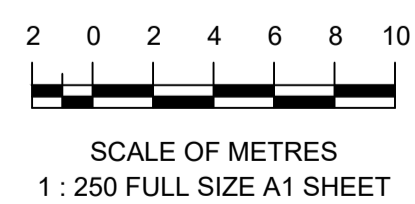

A1	B	17/04/2024	CORRECT SEWER MH DIA 1/1 2/1, 3/1, 4/1 & 1/2 TO 900mm	JMc	DRAWN	JMc	05/02/2024
	A	05/02/2024	PROGRESS PLOT AS CON SEWER	JMc	CHECKED		
	REV NO	DATE	REVISION PURPOSE / DESCRIPTION	DRAWN	RPEQ	RPEQ No	INITIALS DATE

veris

BRISBANE (07) 3666 4700
 MACKAY (07) 4957 9100
 WHITSUNDAYS (07) 4945 6600
 CAIRNS (07) 4052 9400

veris.com.au
 ACN 615 735 727
 Veris Australia Pty Ltd



DAWN WALLOON
Banjo Drive Walloon

GIBBS STAGE 1
AS CONSTRUCTED SEWER

DRAWING STATUS
AS CONSTRUCTED

SHEET 3 OF 5 SHEETS

DRAWING NO. 401905-611-AS01 REV. B

ENGINEER'S CERTIFICATION

- I, _____, hereby certify that:
- The information contained in this drawing / document is in compliance with approved drawings and design.
 - This represents an accurate record of as-constructed works.
 - I accept responsibility for the information contained in this drawing / document.

RPEQ (signature) RPEQ No. Date:

Registered Surveyor's Certification.

We, **VERIS AUSTRALIA P/L**, hereby certify that the horizontal and vertical locations, and dimensions shown on this plan are a true and correct record of the As Constructed information.


[Signature]

Signed: _____ Cadastral Surveyor & Delegate Reg. No. 6448
 Dated: 5 June 2024



LEGEND

- SEWER MAIN
- SEWER HOUSE CONNECTION
- SEWER HOUSE CONNECTION
- SEWER MAINTENANCE HOLE (INSITU)
- SEWER MAINTENANCE SHAFT
- SEWER END OF LINE
- EXISTING SEWER MAINTENANCE SHAFT
- DESIGN LEVEL

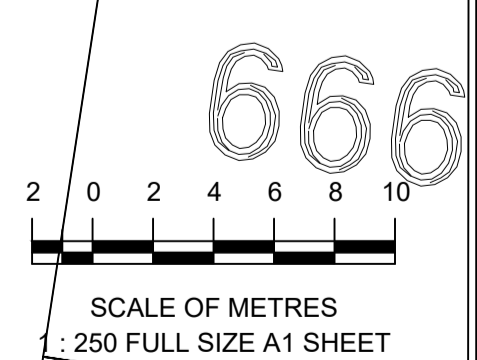

A1	REV NO	DATE	REVISION PURPOSE / DESCRIPTION	DRAWN	RPEQ	RPEQ No	INITIALS	DATE
	B	17/04/2024	CORRECT SEWER MH DIA 1/1 2/1, 3/1, 4/1 & 1/2 TO 900mm	JMc				05/02/2024
	A	05/02/2024	PROGRESS PLOT AS CON SEWER	JMc				

BRISBANE (07) 3666 4700 WHITSUNDAYS (07) 4945 6600
 MACKAY (07) 4957 9700 CAIRNS (07) 4052 9400
veris veris.com.au
 ACN 615 735 727 Veris Australia Pty Ltd

QUEENSLAND UrbanUtilities

DAWN WALLOON
 Banjo Drive Walloon
GIBBS STAGE 1
 AS CONSTRUCTED SEWER

DRAWING STATUS AS CONSTRUCTED	
SHEET 4 OF 5 SHEETS	
DRAWING NO. 401905-611-AS01	REV. B

ENGINEER'S CERTIFICATION


I,, hereby certify that:
 1. The information contained in this drawing / document is in compliance with approved drawings and design.
 2. This represents an accurate record of as-constructed works.
 3. I accept responsibility for the information contained in this drawing / document.

RPEQ (signature) RPEQ No. Date:

Registered Surveyor's Certification.


We, **VERIS AUSTRALIA P/L**, hereby certify that the horizontal and vertical locations, and dimensions shown on this plan are a true and correct record of the As Constructed information.

Signed:  Cadastral Surveyor & Delegate Reg. No. 6448
 Dated: 5 June 2024

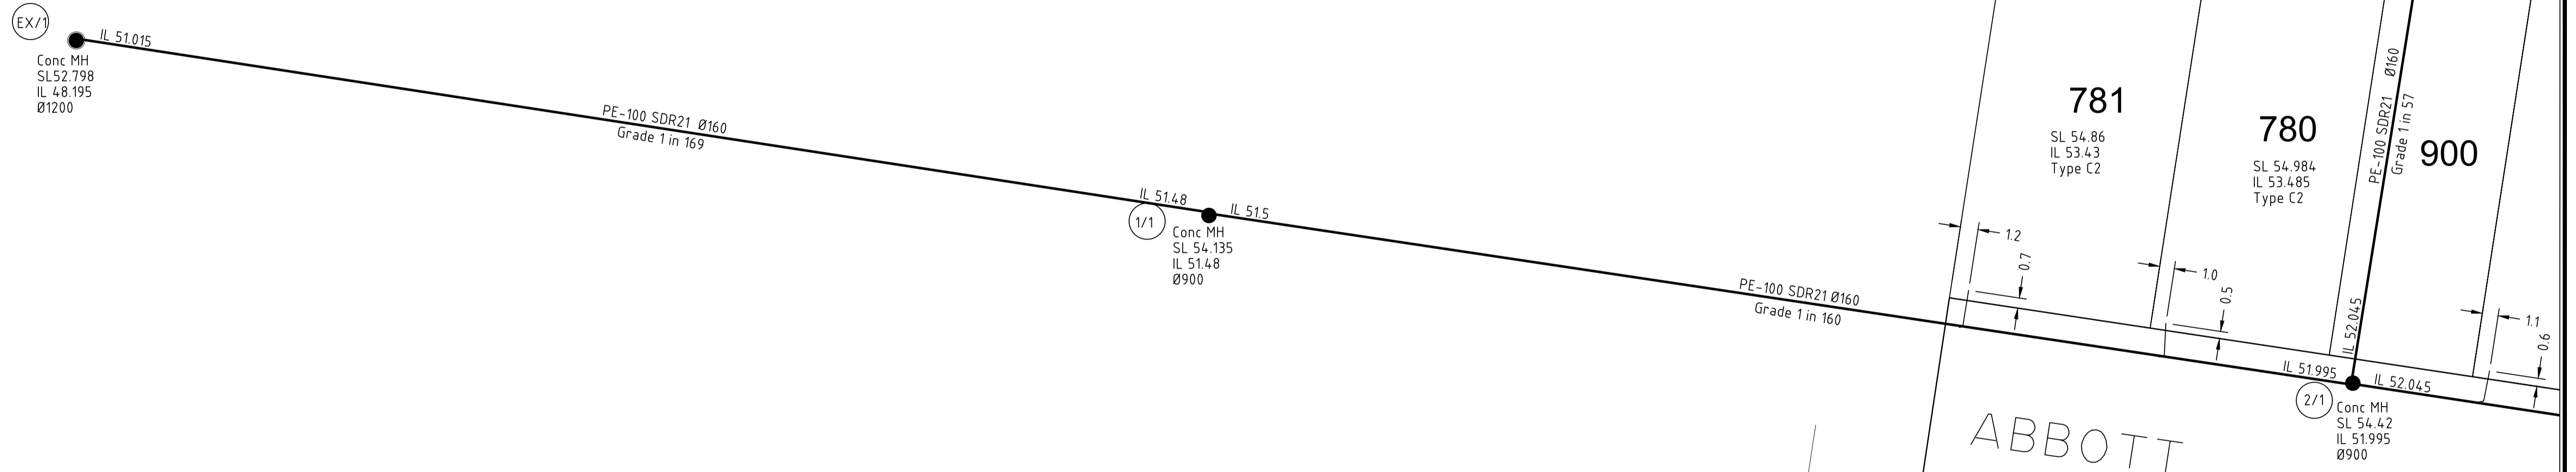

LEGEND

	SEWER MAIN
	SEWER HOUSE CONNECTION
	SEWER HOUSE CONNECTION
	SEWER MAINTENANCE HOLE (INSITU)
	SEWER MAINTENANCE SHAFT
	SEWER END OF LINE
	EXISTING SEWER MAINTENANCE SHAFT
58.19#	DESIGN LEVEL

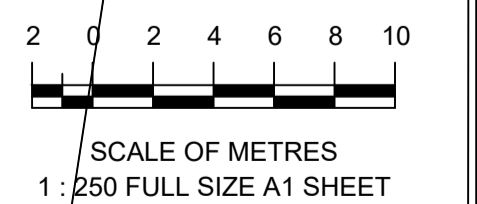

A1	REV NO	DATE	REVISION PURPOSE / DESCRIPTION	DRAWN	RPEQ	RPEQ No	INITIALS	DATE
	B	17/04/2024	CORRECT SEWER MH DIA 1/1 2/1, 3/1, 4/1 & 1/2 TO 900mm	JMc				
	A	05/02/2024	PROGRESS PLOT AS CON SEWER	JMc				

veris

BRISBANE (07) 3666 4700 WHITSUNDAYS (07) 4945 6600
 MACKAY (07) 4957 9100 CAIRNS (07) 4052 9400

veris.com.au
 ACN 615 735 727
 Veris Australia Pty Ltd



DAWN WALLOON
 Banjo Drive Walloon

GIBBS STAGE 1
 AS CONSTRUCTED SEWER

DRAWING STATUS	
AS CONSTRUCTED	
SHEET 5 OF 5 SHEETS	
DRAWING NO.	REV.
401905-611-AS01	B