


REGISTERED SURVEYOR'S CERTIFICATION

I, Veris Australia Pty Ltd, hereby certify that the vertical and horizontal locations and dimensions shown on this plan are a true and correct record and were located by survey.



 6448 5 June 2024
 Registered Surveyor (sig.) Reg. Surveyor No. Date

ENGINEER'S CERTIFICATION

I, _____, hereby certify that:

- The information contained in this drawing / document is in compliance with approved drawings and design.
- This represents an accurate record of as-constructed works.
- I accept responsibility for the information contained in this drawing / document.

 RPEQ (signature) RPEQ No. Date:

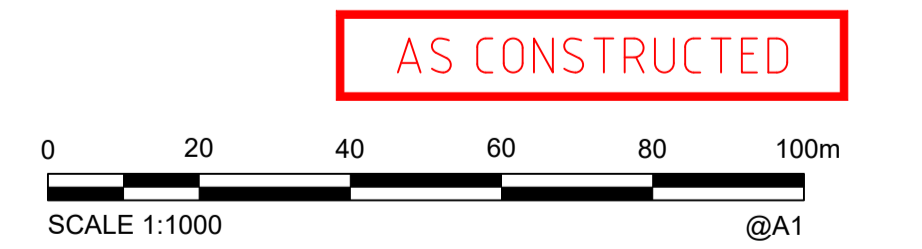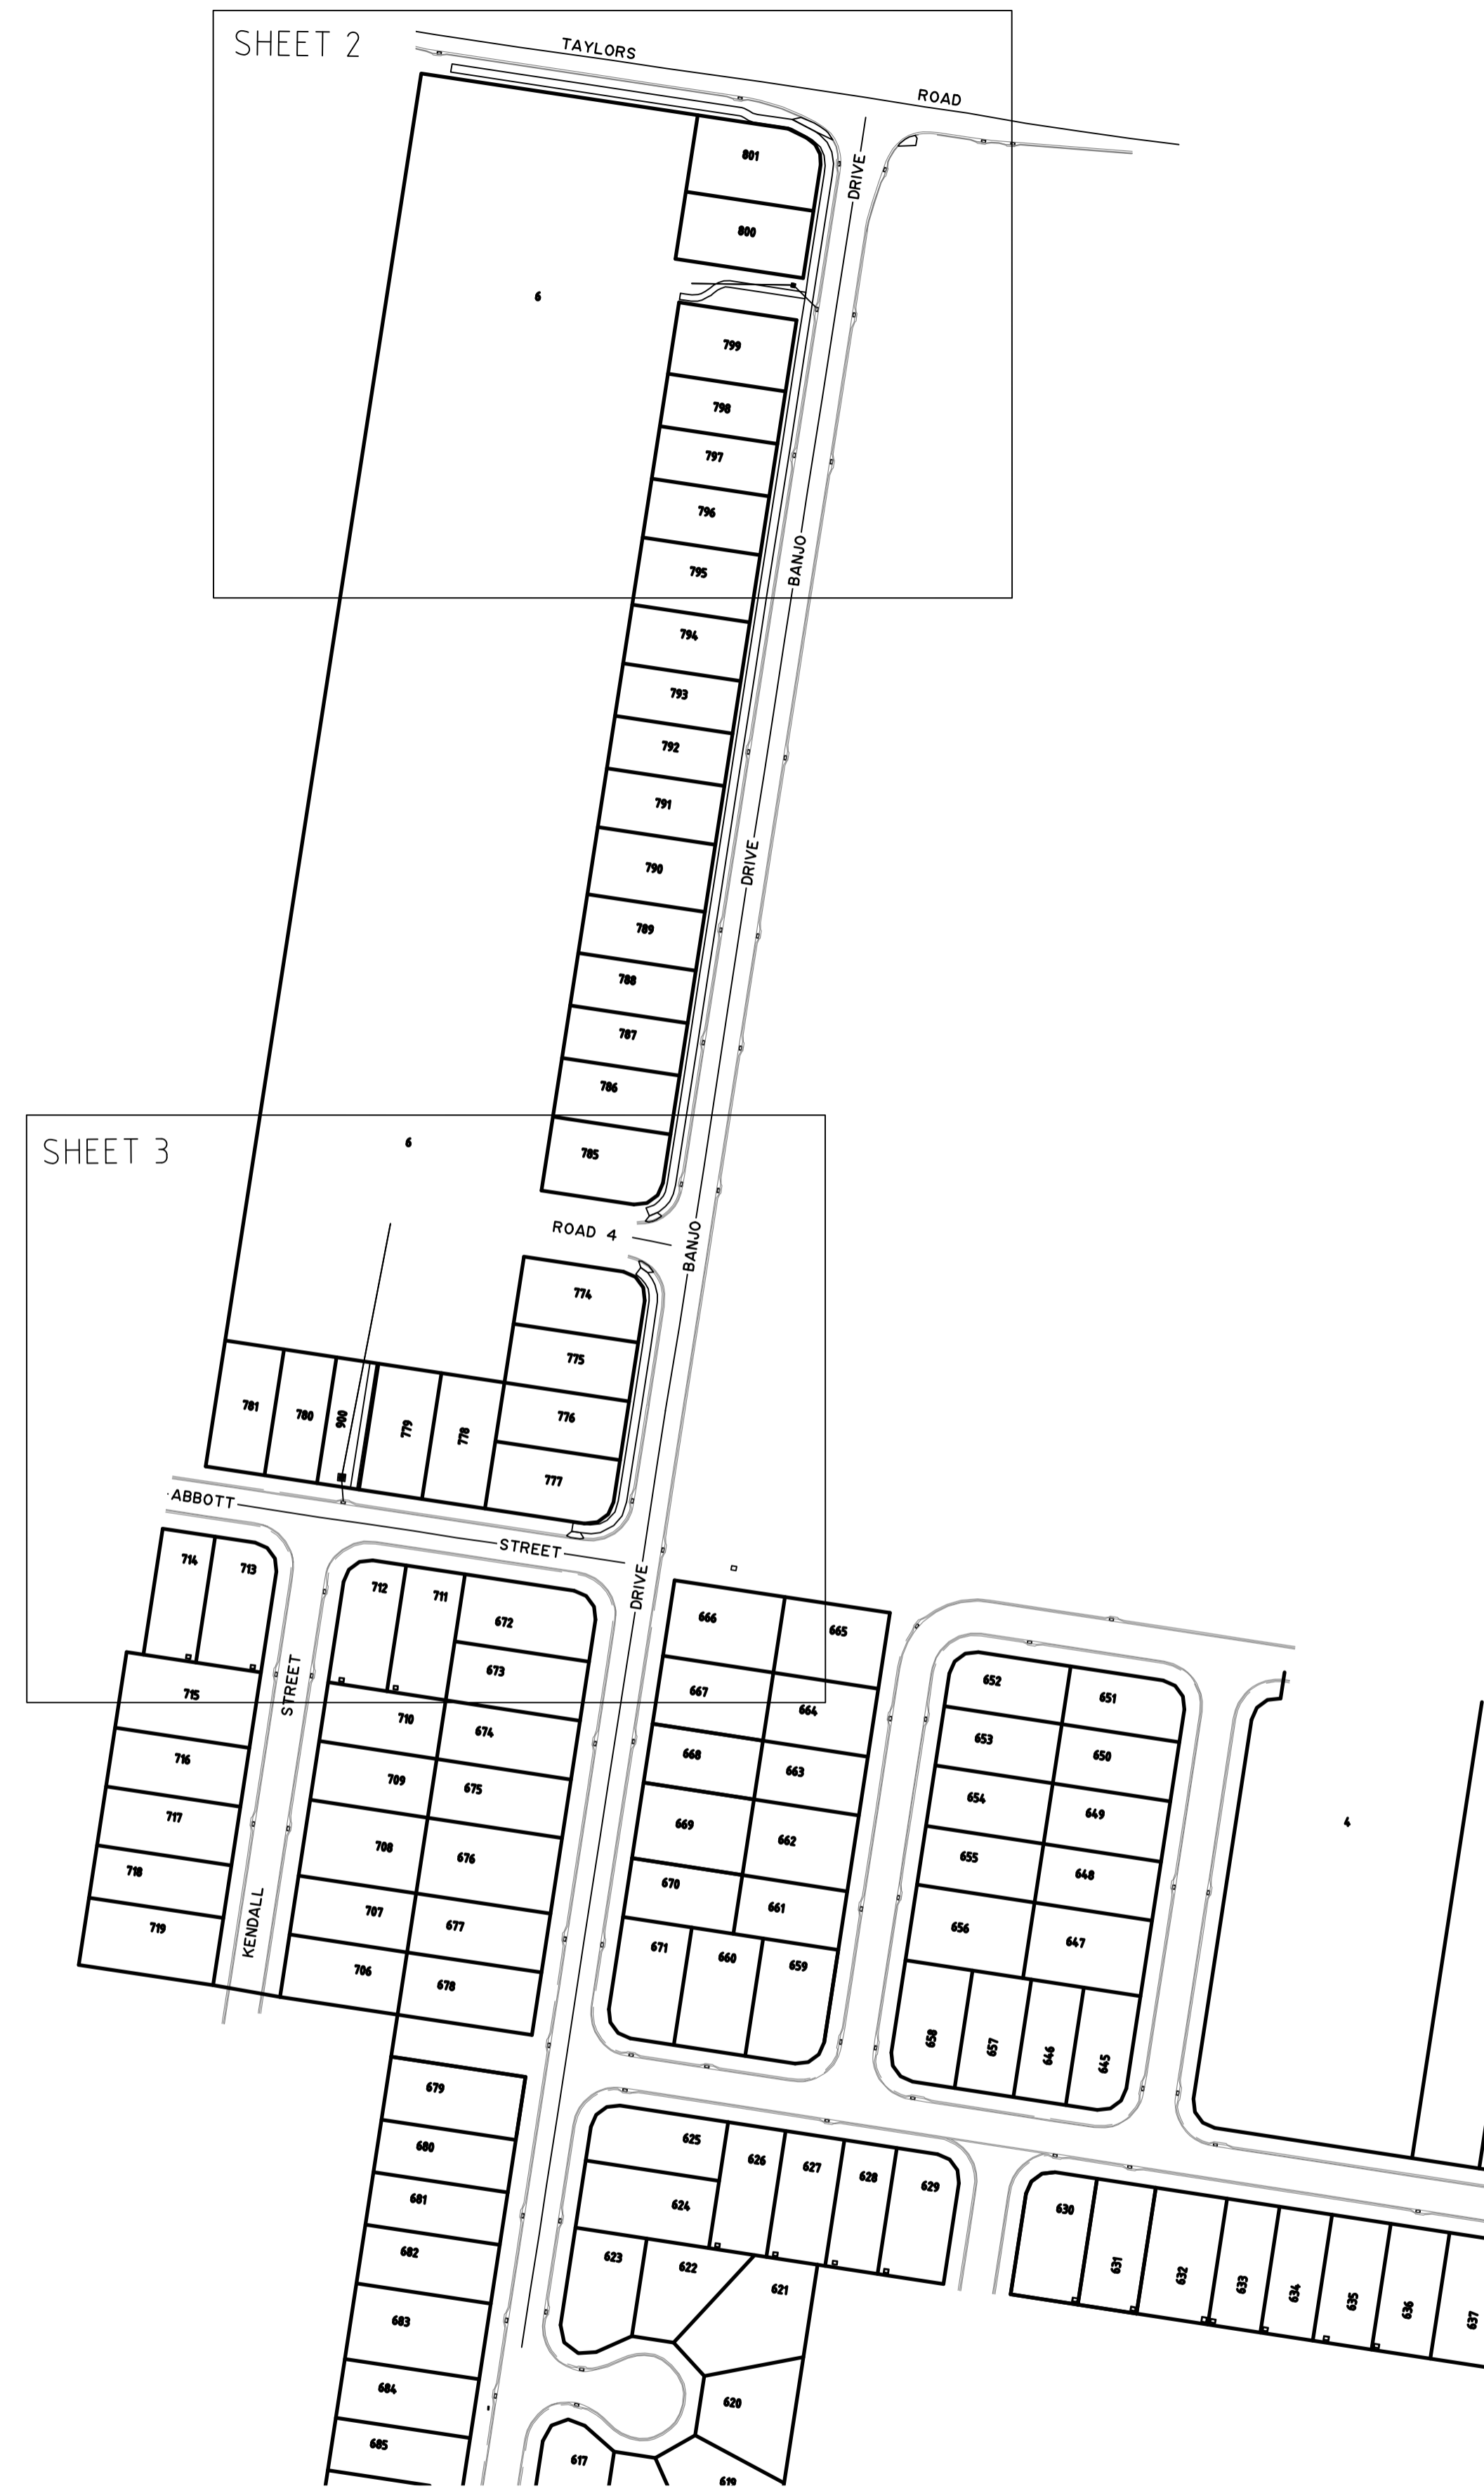

AS CONSTRUCTED

A1

INDEX	DATE	REVISIONS	DRAWN	CHECKED	PASSED
C	21/05/2024	CORRECT INVERTS PIPE 2/A-1/A	JMc		
B	25/03/2024	INCLUDE PIPE LENGTHS AND GRADES, CORRECT IL 2/B	JMc		
A	21/03/2024	PROGRESS PLOT	JMc		

DRAWN	JMc	21/03/2024
CHECKED		
PASSED		
INITIALS		DATE



BRISBANE (07) 3860 4700 WHITSUNDAYS (07) 4945 0500
 MACKAY (07) 4697 9700 CAIRNS (07) 4232 3400
 veris.com.au
 ACN 615 735 727
 Veris Australia Pty Ltd





IPSWICH CITY COUNCIL

WATERLEA WALLOON STAGES 1 GIBBS DAWN WALLOON
 AS CONSTRUCTED
 STORMWATER

SCALE	1:1250@A1
SHEET	1 OF 3 SHEETS
DRAWING NO.	401905-611-AFS01-C
	C
	B
	A

REGISTERED SURVEYOR'S CERTIFICATION
 I, Veris Australia Pty Ltd, hereby certify that the vertical and horizontal locations and dimensions shown on this plan are a true and correct record and were located by survey.
 Registered Surveyor (sig.) [Signature] 6448 5 June 2024
 Reg. Surveyor No. Date

ENGINEER'S CERTIFICATION
 I, _____, hereby certify that:
 1. The information contained in this drawing / document is in compliance with approved drawings and design.
 2. This represents an accurate record of as-constructed works.
 3. I accept responsibility for the information contained in this drawing / document.
 RPEQ (signature) _____ RPEQ No. _____ Date: _____

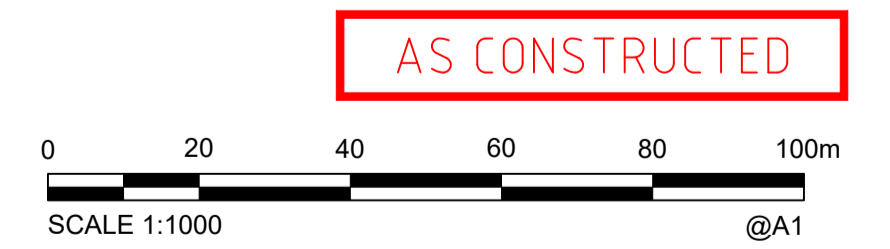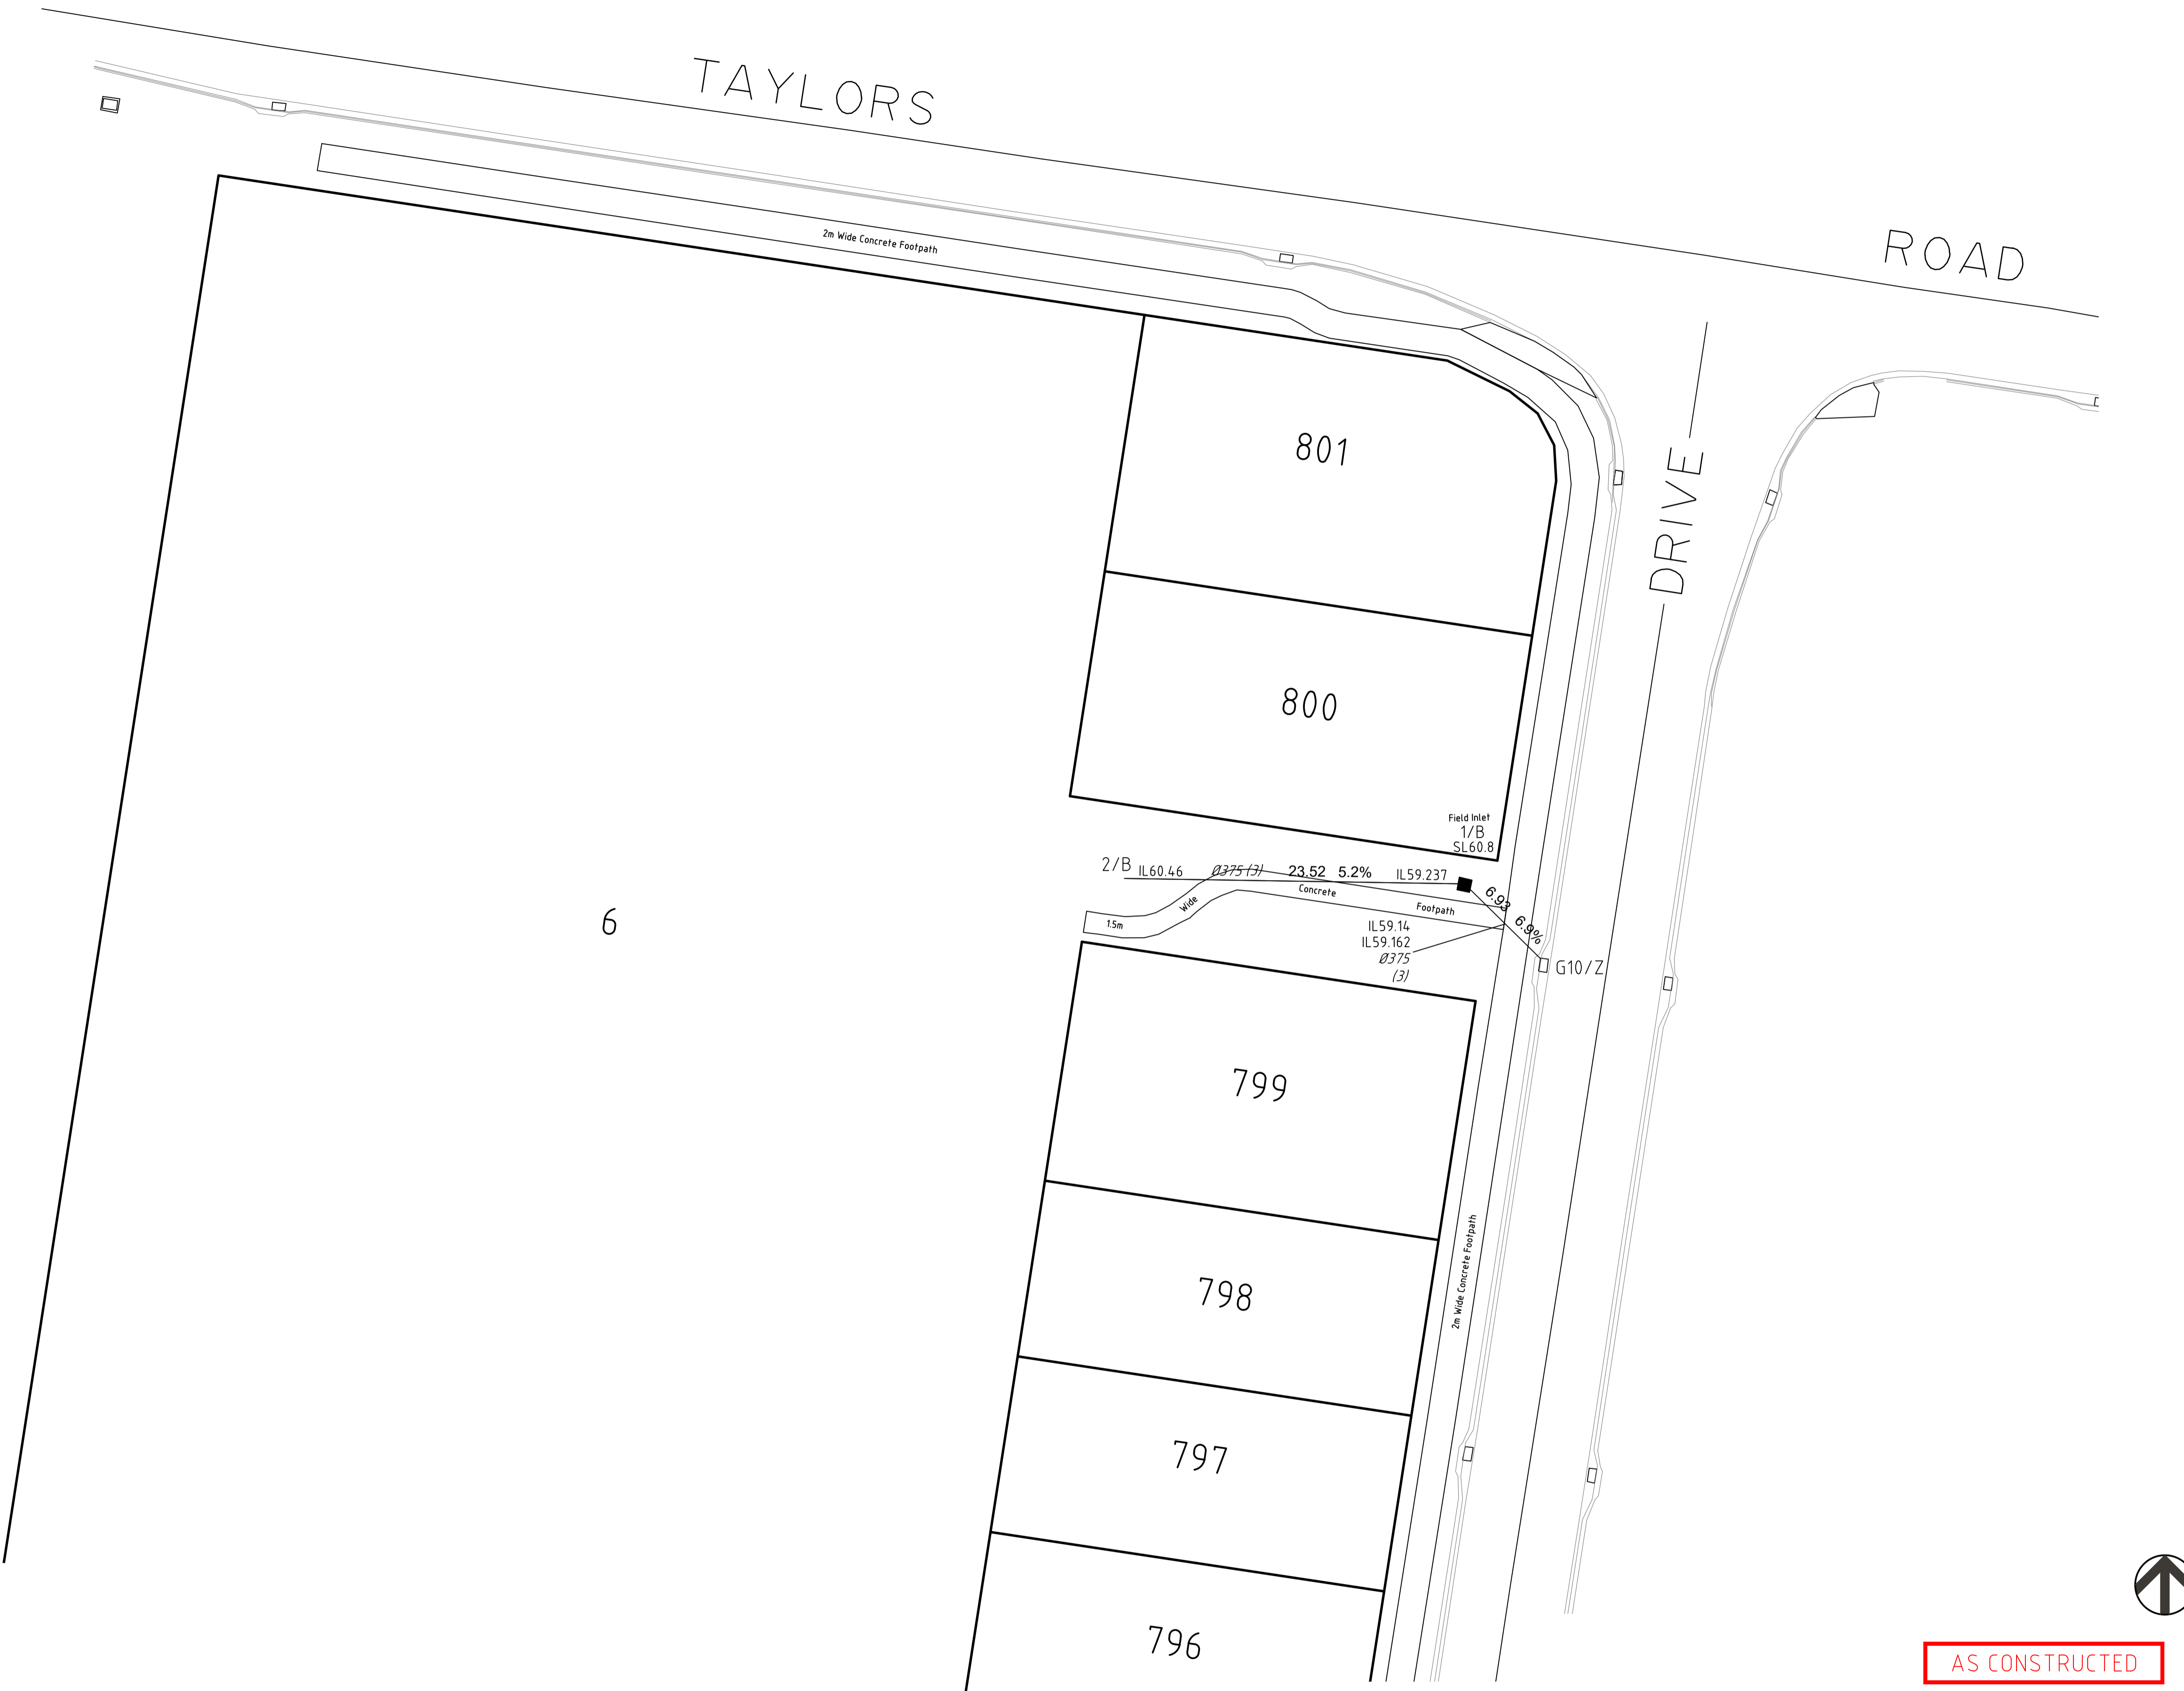

A1	C	21/05/2024	CORRECT INVERTS PIPE 2/A-1/A	JMc		
	B	25/03/2024	INCLUDE PIPE LENGTHS AND GRADES, CORRECT IL 2/B	JMc		
	A	21/03/2024	PROGRESS PLOT	JMc		
	INDEX	DATE	REVISIONS	DRAWN	CHECKED	PASSED

DRAWN	JMc	21/03/2024
CHECKED		
PASSED		
INITIALS		DATE

veris
 BRISBANE (07) 3860 4700 WHITSUNDAYS (07) 4945 0500
 MACKAY (07) 4497 9700 CAIRNS (07) 4232 3400
 veris.com.au
 ACN 615 735 727
 Veris Australia Pty Ltd



IPSWICH CITY COUNCIL
 WATERLEA WALLOON STAGES 1 GIBBS DAWN WALLOON
 AS CONSTRUCTED
 STORMWATER

SCALE	1:1250@A1
SHEET	2 OF 3 SHEETS
DRAWING NO.	401905-611-AFS01-C
	C
	B
	A



REGISTERED SURVEYOR'S CERTIFICATION
 I, Veris Australia Pty Ltd, hereby certify that the vertical and horizontal locations and dimensions shown on this plan are a true and correct record and were located by survey.
[Signature] 6448 5 June 2024
 Registered Surveyor (sig.) Reg. Surveyor No. Date

ENGINEER'S CERTIFICATION
 I, _____, hereby certify that:
 1. The information contained in this drawing / document is in compliance with approved drawings and design.
 2. This represents an accurate record of as-constructed works.
 3. I accept responsibility for the information contained in this drawing / document.

 RPEQ (signature) RPEQ No. Date:



AS CONSTRUCTED

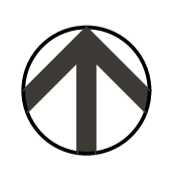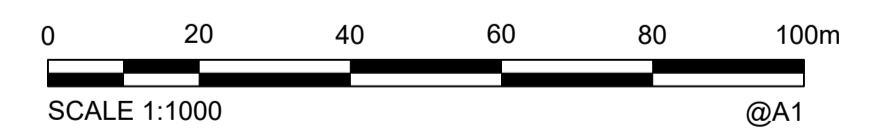

A1	C	21/05/2024	CORRECT INVERTS PIPE 2/A-1/A	JMc		
	B	25/03/2024	INCLUDE PIPE LENGTHS AND GRADES, CORRECT IL 2/B	JMc		
	A	21/03/2024	PROGRESS PLOT	JMc		
	INDEX	DATE	REVISIONS	DRAWN	CHECKED	PASSED

DRAWN	JMc	21/03/2024
CHECKED		
PASSED		
INITIALS		DATE

veris
 BRISBANE (07) 3860 4700 WHITSUNDAYS (07) 4945 0500
 MACKAY (07) 4697 9700 CAIRNS (07) 4232 3400
 veris.com.au
 ACN 615 735 727
 Veris Australia Pty Ltd



IPSWICH CITY COUNCIL		SCALE 1:1250@A1
WATERLEA WALLOON STAGES 1 GIBBS DAWN WALLOON AS CONSTRUCTED STORMWATER		SHEET 3 OF 3 SHEETS
		DRAWING NO.
		401905-611-AFS01-C
		C
		B
		A