



REGISTERED SURVEYOR'S CERTIFICATION

I, Veris Australia Pty Ltd, hereby certify that the vertical and horizontal locations and dimensions shown on this plan are a true and correct record and were located by survey.

[Signature] 6448 21/08/2024
 Registered Surveyor (sig.) Reg. Surveyor No. Date

ENGINEER'S CERTIFICATION

I, _____, hereby certify that:

- The information contained in this drawing / document is in compliance with approved drawings and design.
- This represents an accurate record of as-constructed works.
- I accept responsibility for the information contained in this drawing / document.

 RPEQ (signature) RPEQ No. Date:


A1

INDEX	DATE	REVISIONS	DRAWN	CHECKED	PASSED
B	29/07/2024	FINAL	JMc		
A	17/07/2024	PROGRESS PLOT	JMc		

INITIALS	DATE
DRAWN JMc	13/02/2024
CHECKED	
PASSED	

veris


BRISBANE (07) 3800 4700 WHITSUNDAYS (07) 4945 0500
 MACKAY (07) 4887 9700 CAIRNS (07) 4332 3400
 veris.com.au
 ACN 615 735 727
 Veris Australia Pty Ltd

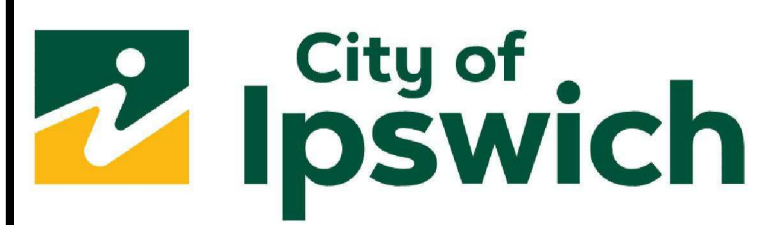

IPSWICH CITY COUNCIL

WATERLEA WALLOON STAGE 6F
 AS CONSTRUCTED
 EARTHWORKS


SCALE 1:750 @A1
 SHEET 1 OF 3 SHEETS
 DRAWING NO.
 401905-6F-AEW01

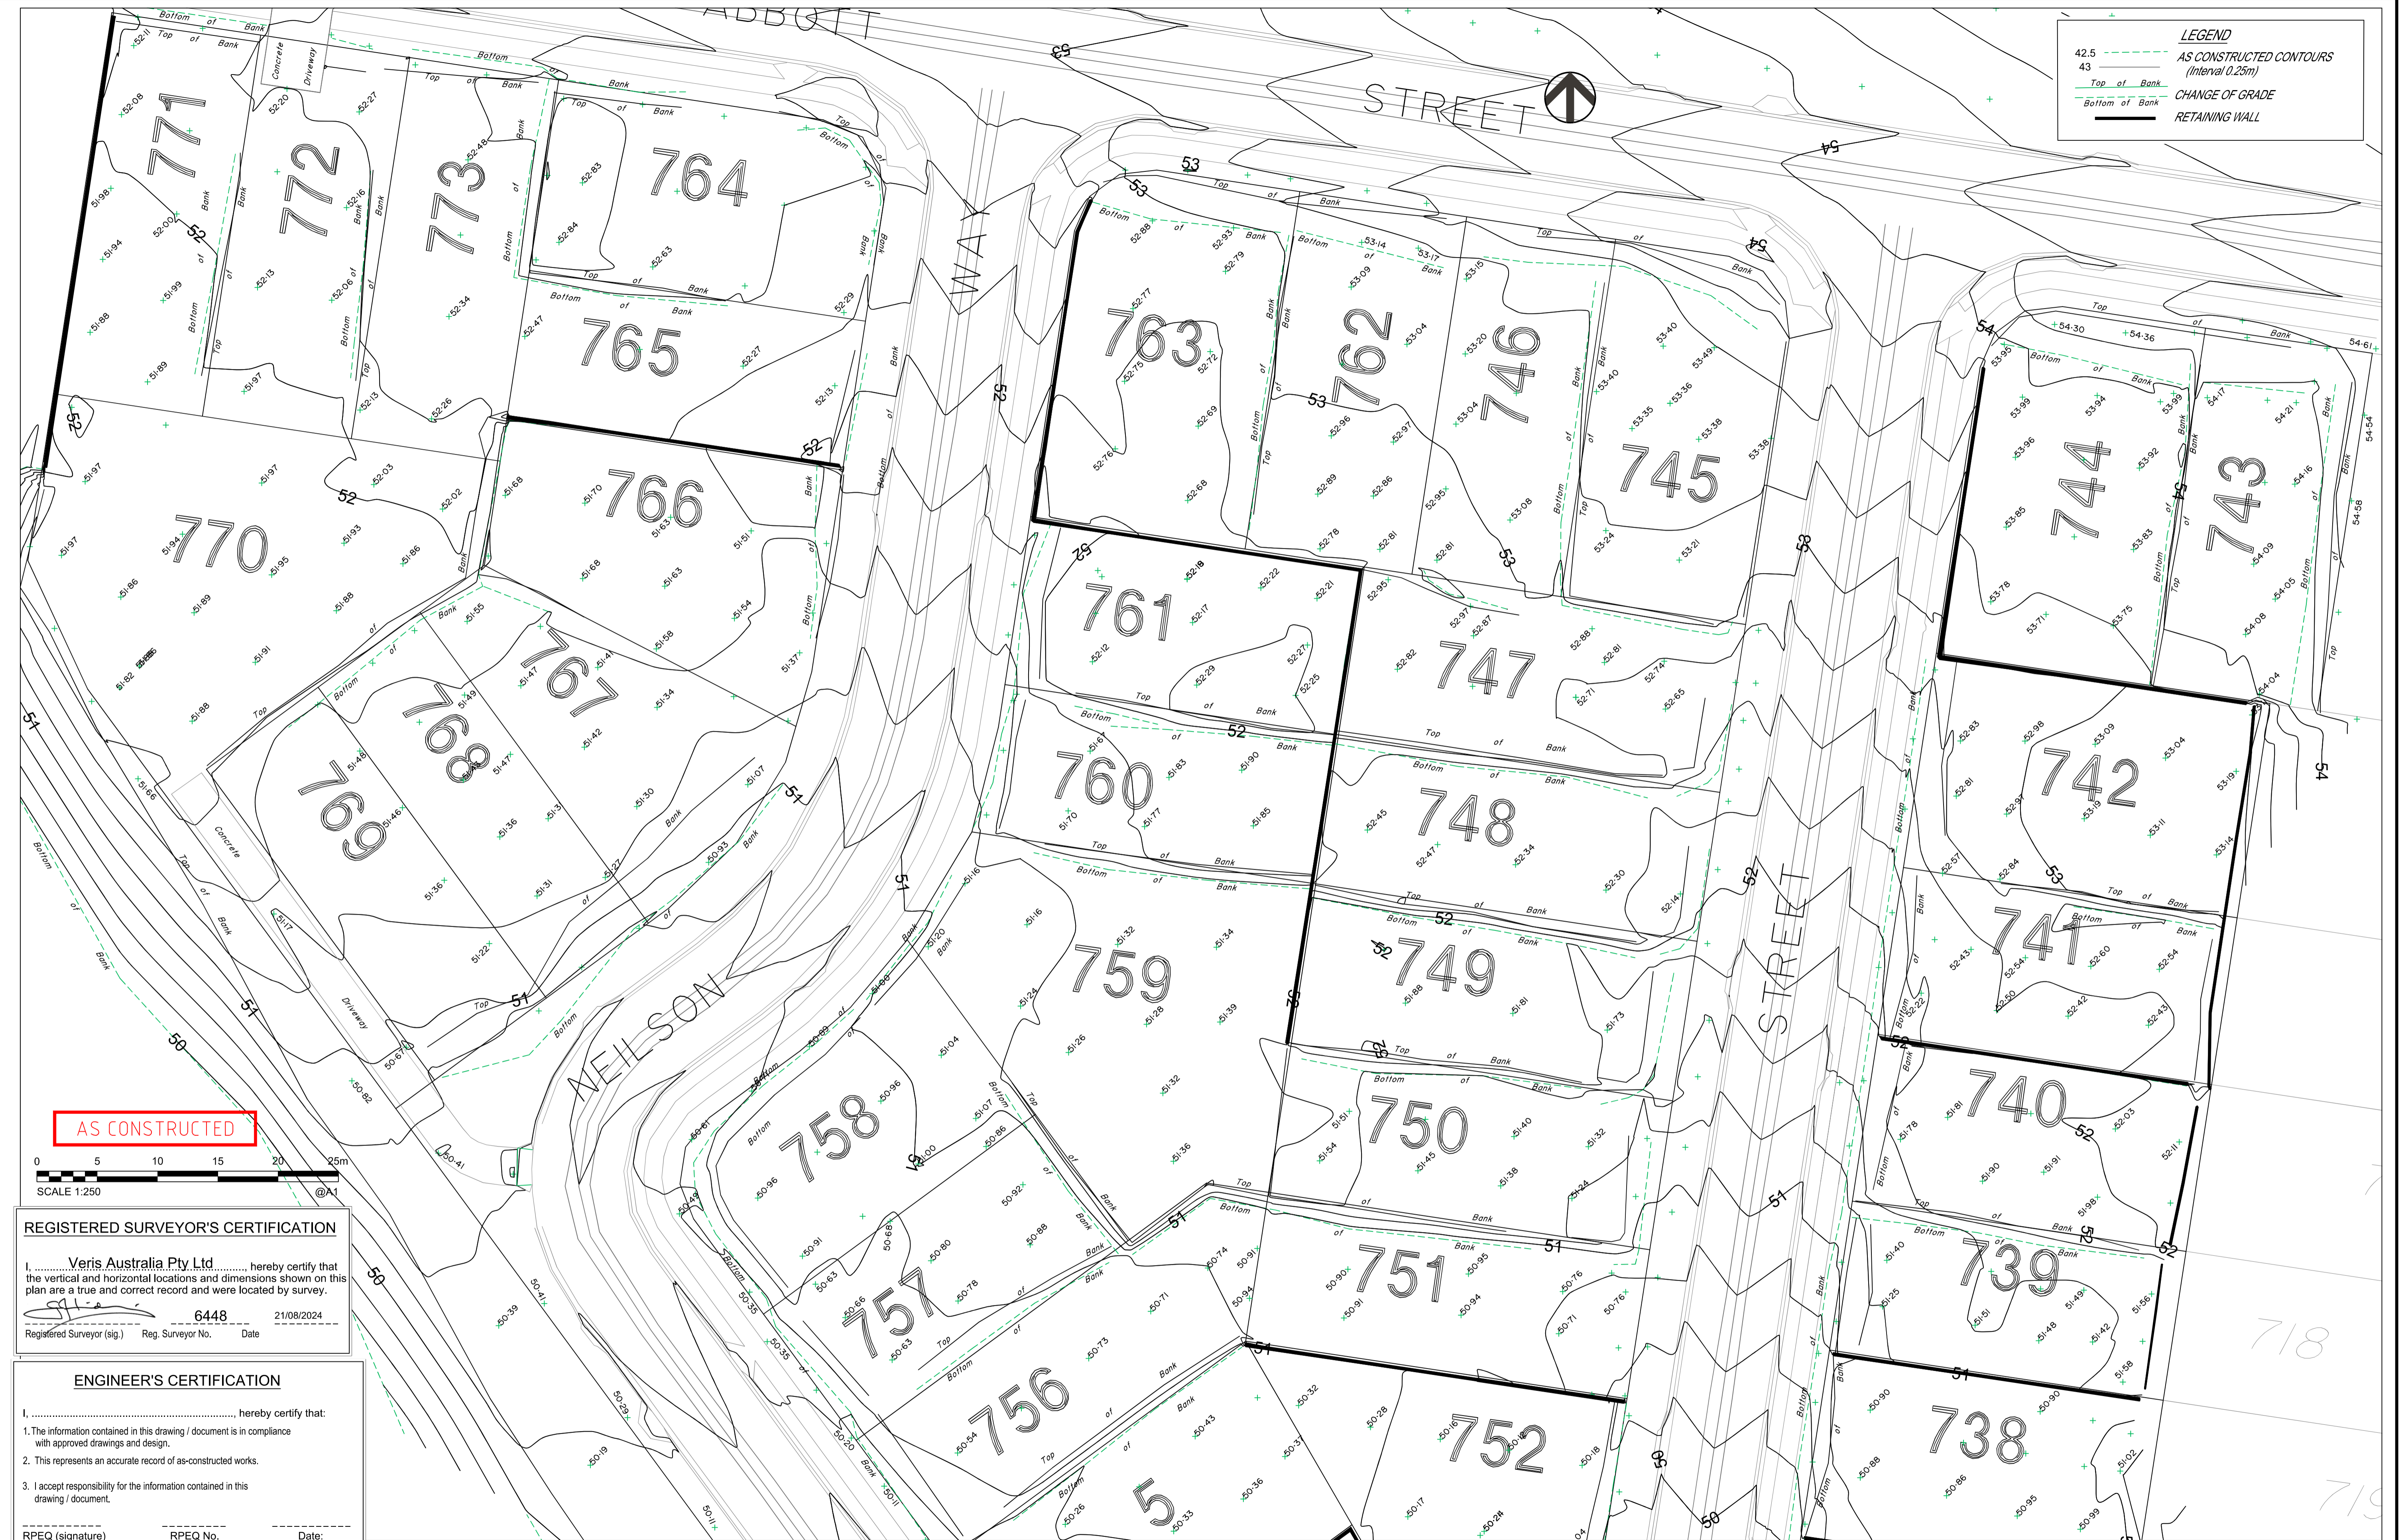

LEGEND

- 42.5 --- AS CONSTRUCTED CONTOURS (Interval 0.25m)
- 43 --- Top of Bank
- CHANGE OF GRADE
- RETAINING WALL

AS CONSTRUCTED

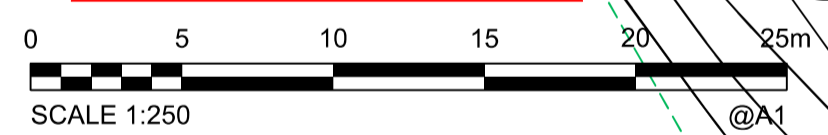

REGISTERED SURVEYOR'S CERTIFICATION

I, **Veris Australia Pty Ltd**, hereby certify that the vertical and horizontal locations and dimensions shown on this plan are a true and correct record and were located by survey.

Registered Surveyor (sig.) **6448** Reg. Surveyor No. Date **21/08/2024**

ENGINEER'S CERTIFICATION

I, _____, hereby certify that:

- The information contained in this drawing / document is in compliance with approved drawings and design.
- This represents an accurate record of as-constructed works.
- I accept responsibility for the information contained in this drawing / document.

RPEQ (signature) _____ RPEQ No. _____ Date: _____


A1

INDEX	DATE	REVISIONS	DRAWN	CHECKED	PASSED
B	29/07/2024	FINAL	JMc		
A	17/07/2024	PROGRESS PLOT	JMc		

DRAWN	CHECKED	PASSED	INITIALS	DATE
JMc				13/02/2024

veris

BRISBANE (07) 3660 4700
 WHITSUNDAYS (07) 4945 6600
 MACKAY (07) 5487 9700
 CAIRNS (07) 4332 9400
 veris.com.au
 ACN 615 735 727
 Veris Australia Pty Ltd

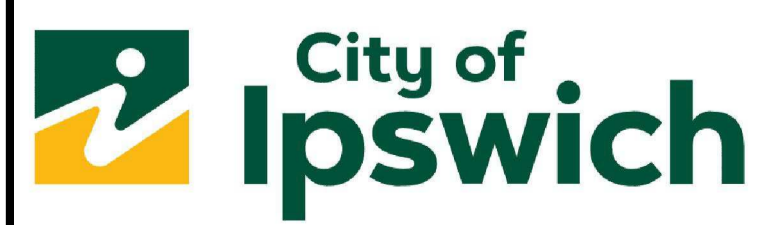


IPSWICH CITY COUNCIL

WATERLEA WALLOON STAGE 6F
 AS CONSTRUCTED
 EARTHWORKS

SCALE 1:250 @A1

SHEET 2 OF 3 SHEETS

DRAWING NO. **401905-6F-AEW01**

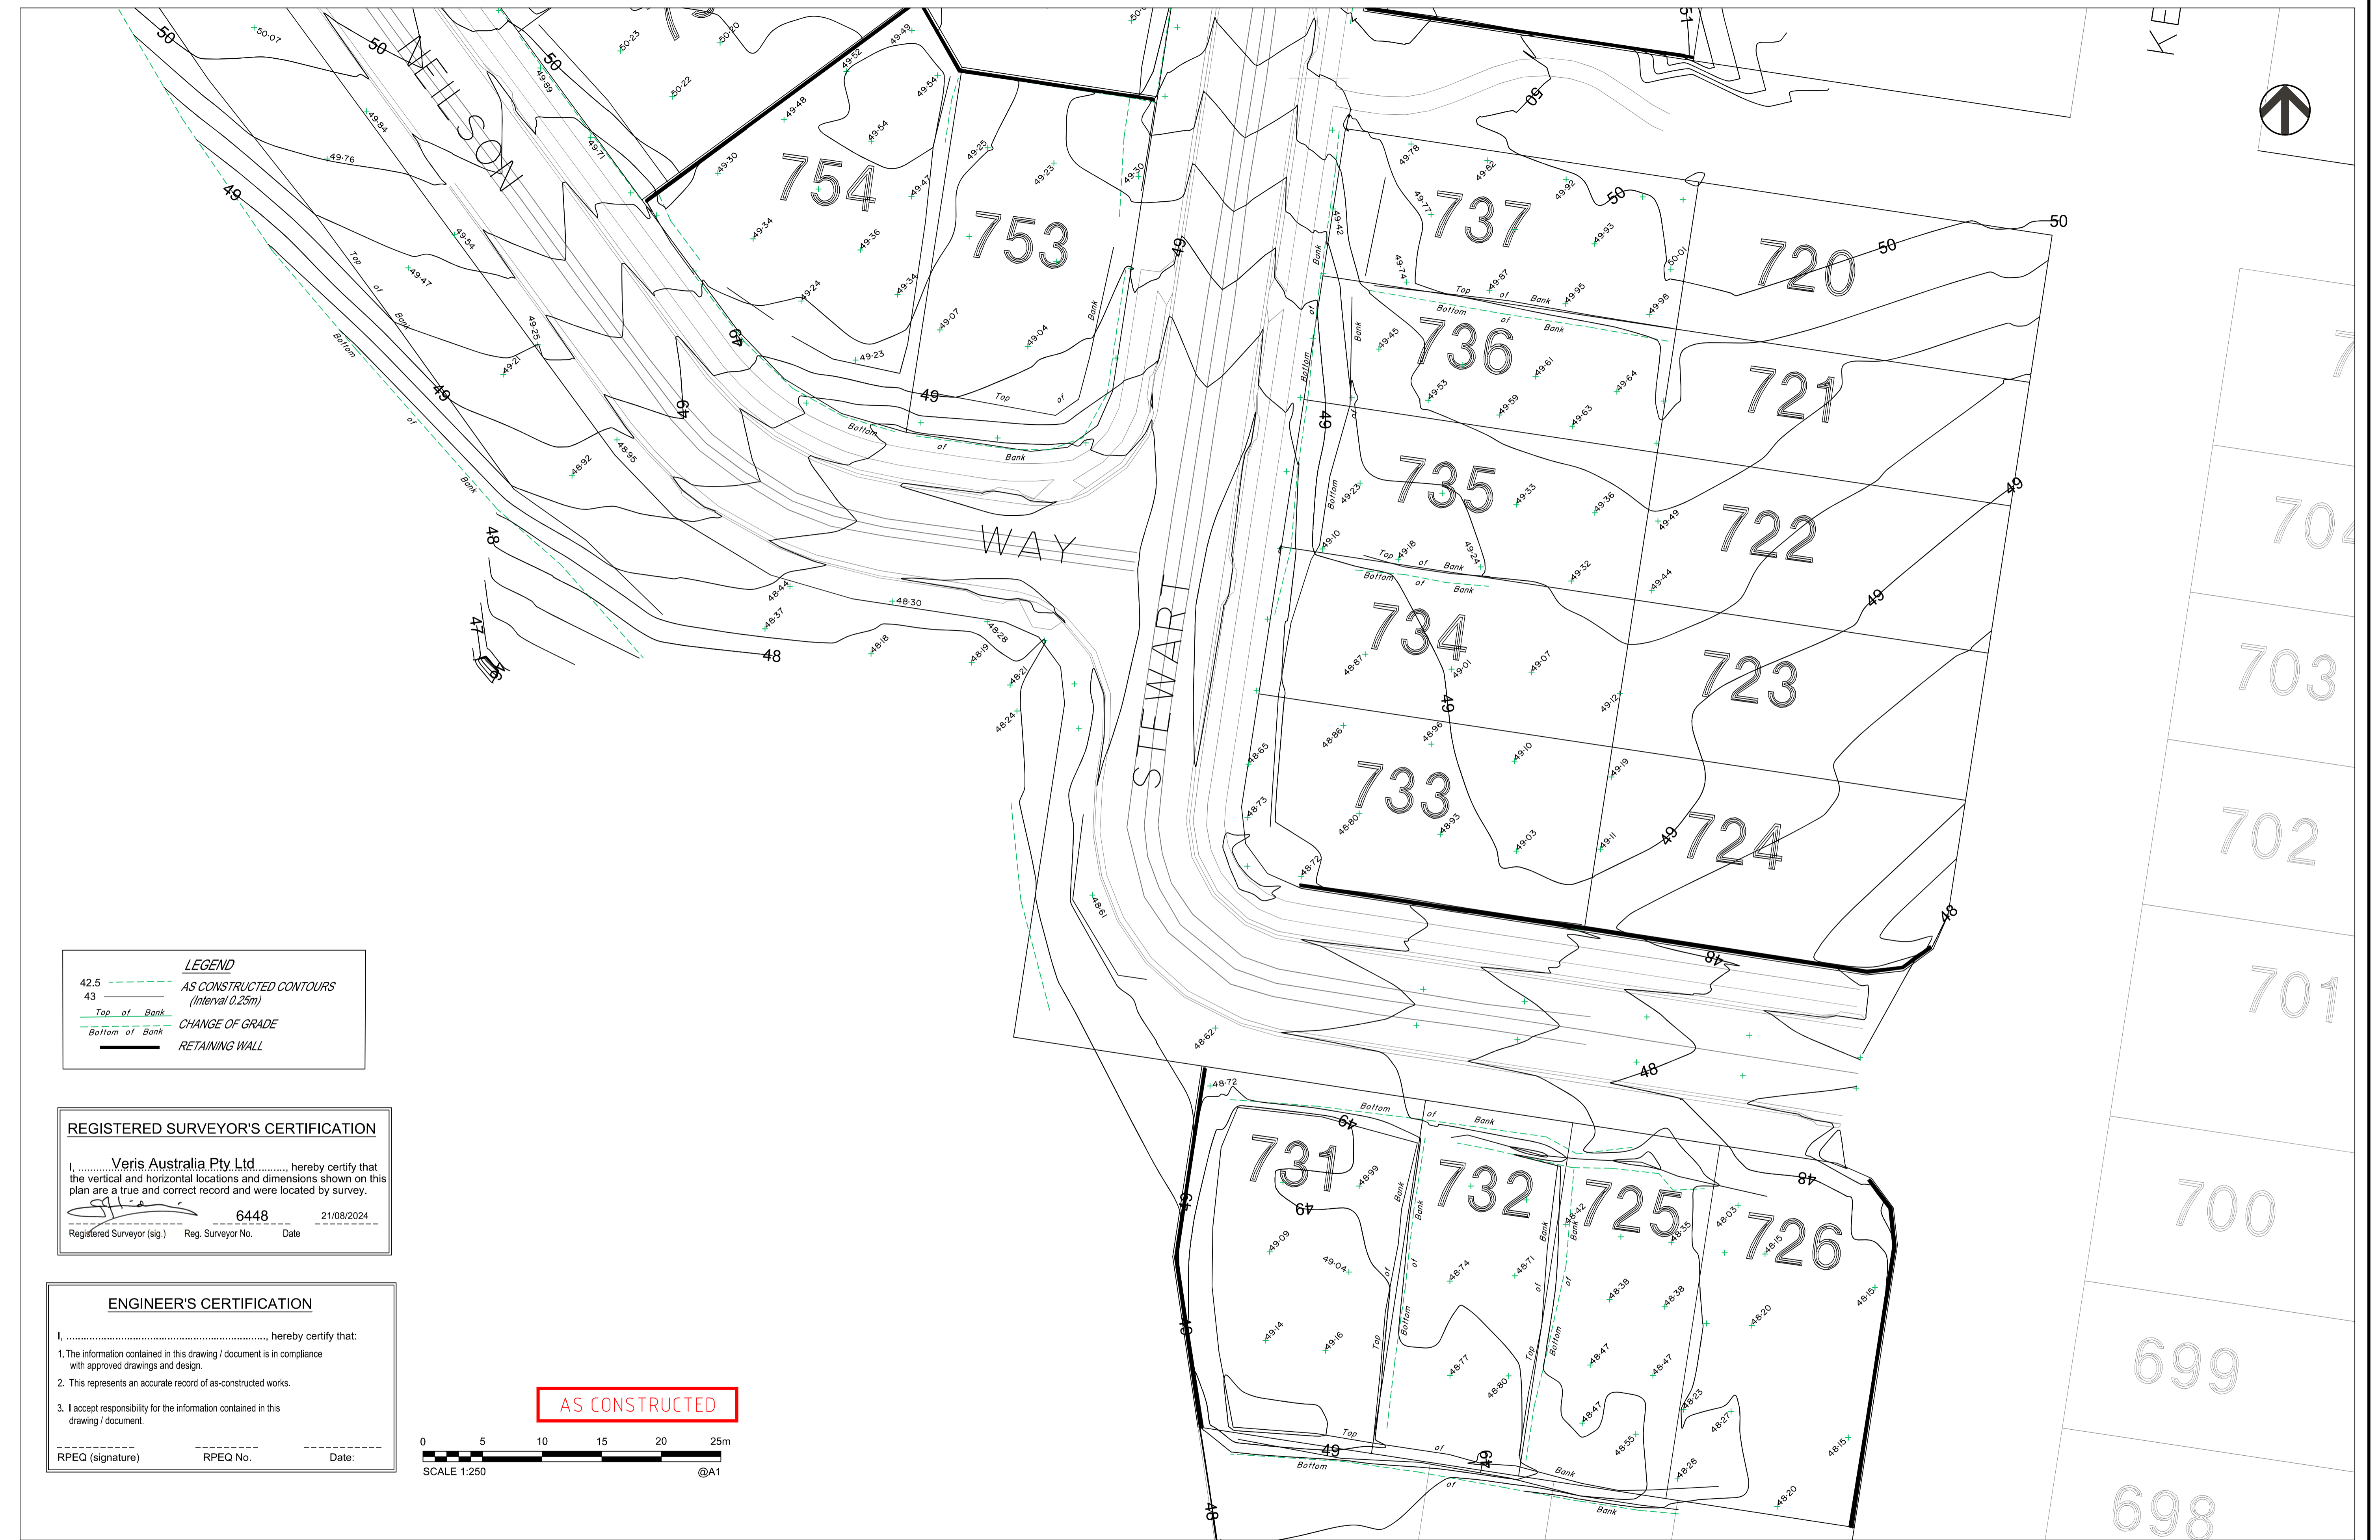

LEGEND

42.5	AS CONSTRUCTED CONTOURS (Interval 0.25m)
43	Top of Bank
Bottom of Bank	CHANGE OF GRADE
Retaining Wall	RETAINING WALL

REGISTERED SURVEYOR'S CERTIFICATION

I, **Veris Australia Pty Ltd**, hereby certify that the vertical and horizontal locations and dimensions shown on this plan are a true and correct record and were located by survey.

Registered Surveyor (sig.) **[Signature]** Reg. Surveyor No. **6448** Date **21/08/2024**


ENGINEER'S CERTIFICATION

I, _____, hereby certify that:

- The information contained in this drawing / document is in compliance with approved drawings and design.
- This represents an accurate record of as-constructed works.
- I accept responsibility for the information contained in this drawing / document.

RPEQ (signature) _____ RPEQ No. _____ Date: _____

AS CONSTRUCTED

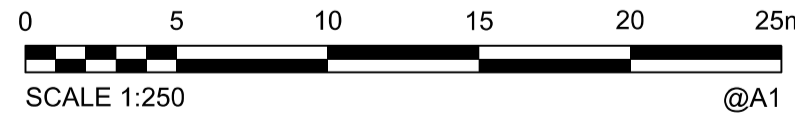


A1

INDEX	DATE	REVISIONS	DRAWN	CHECKED	PASSED
B	25/07/2024	FINAL	JMc		
A	17/07/2024	PROGRESS PLOT	JMc		

DRAWN	CHECKED	PASSED	INITIALS	DATE
JMc				13/02/2024



BRISBANE (07) 3660 4700
 WHITSUNDAYS (07) 4945 6600
 MACKAY (07) 5487 9700
 CAIRNS (07) 4232 3400
 veris.com.au
 ACN 615 735 727
 Veris Australia Pty Ltd

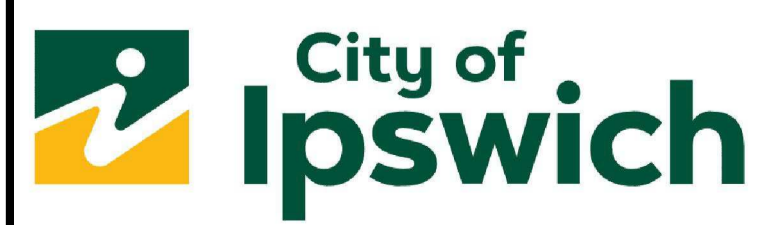

IPSWICH CITY COUNCIL

WATERLEA WALLOON STAGE 6F
 AS CONSTRUCTED
 EARTHWORKS

SCALE 1:250 @A1

SHEET 3 OF 3 SHEETS

DRAWING NO.

401905-6F-AEW01

B
A