



REGISTERED SURVEYOR'S CERTIFICATION

I, Veris Australia Pty Ltd, hereby certify that the vertical and horizontal locations and dimensions shown on this plan are a true and correct record and were located by survey.



[Signature] 6448 21/08/2024
 Registered Surveyor (sig.) Reg. Surveyor No. Date

ENGINEER'S CERTIFICATION

I, _____, hereby certify that:

- The information contained in this drawing / document is in compliance with approved drawings and design.
- The new water and sewerage works defined by this drawing have been designed and constructed in accordance with the SEQ Code.
- This represents an accurate record of as-constructed works.
- I accept responsibility for the information contained in this drawing / document.

RPEQ (signature) RPEQ No. Date:

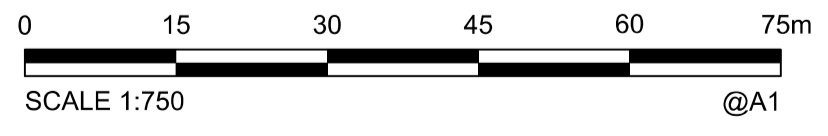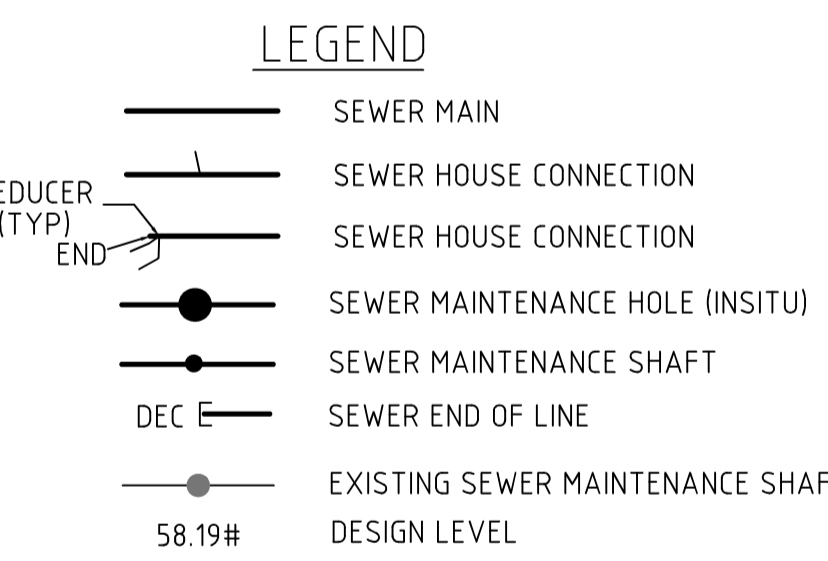

A1

REV NO	DATE	REVISION PURPOSE / DESCRIPTION	DRAWN	RPEQ	RPEQ No	INITIALS	DATE
E	25/07/2024	FINAL	JMc				
D	16/07/2024	PROGRESS PLOT AS CON SEWER	JMc				
C	27/05/2024	PROGRESS PLOT AS CON SEWER	JMc			DRAWN	JMc 12/02/2024
B	22/03/2024	PROGRESS PLOT AS CON SEWER	JMc			CHECKED	
F	20/08/2024	PROGRESS PLOT AS CON SEWER	JMc			APPROVED	

veris

BRISBANE (07) 3666 4700 WHITSUNDAYS (07) 4945 6600
 MACKAY (07) 4957 9700 CAIRNS (07) 4052 9400


veris.com.au
 ACN 615 735 727
 Veris Australia Pty Ltd



DAWN WALLOON
 Neilson Way Walloon

STAGE 6F
 AS CONSTRUCTED SEWER

DRAWING STATUS AS CONSTRUCTED	
SHEET 1 OF 3 SHEETS	
DRAWING NO. 401905-6F-AS01	REV. F

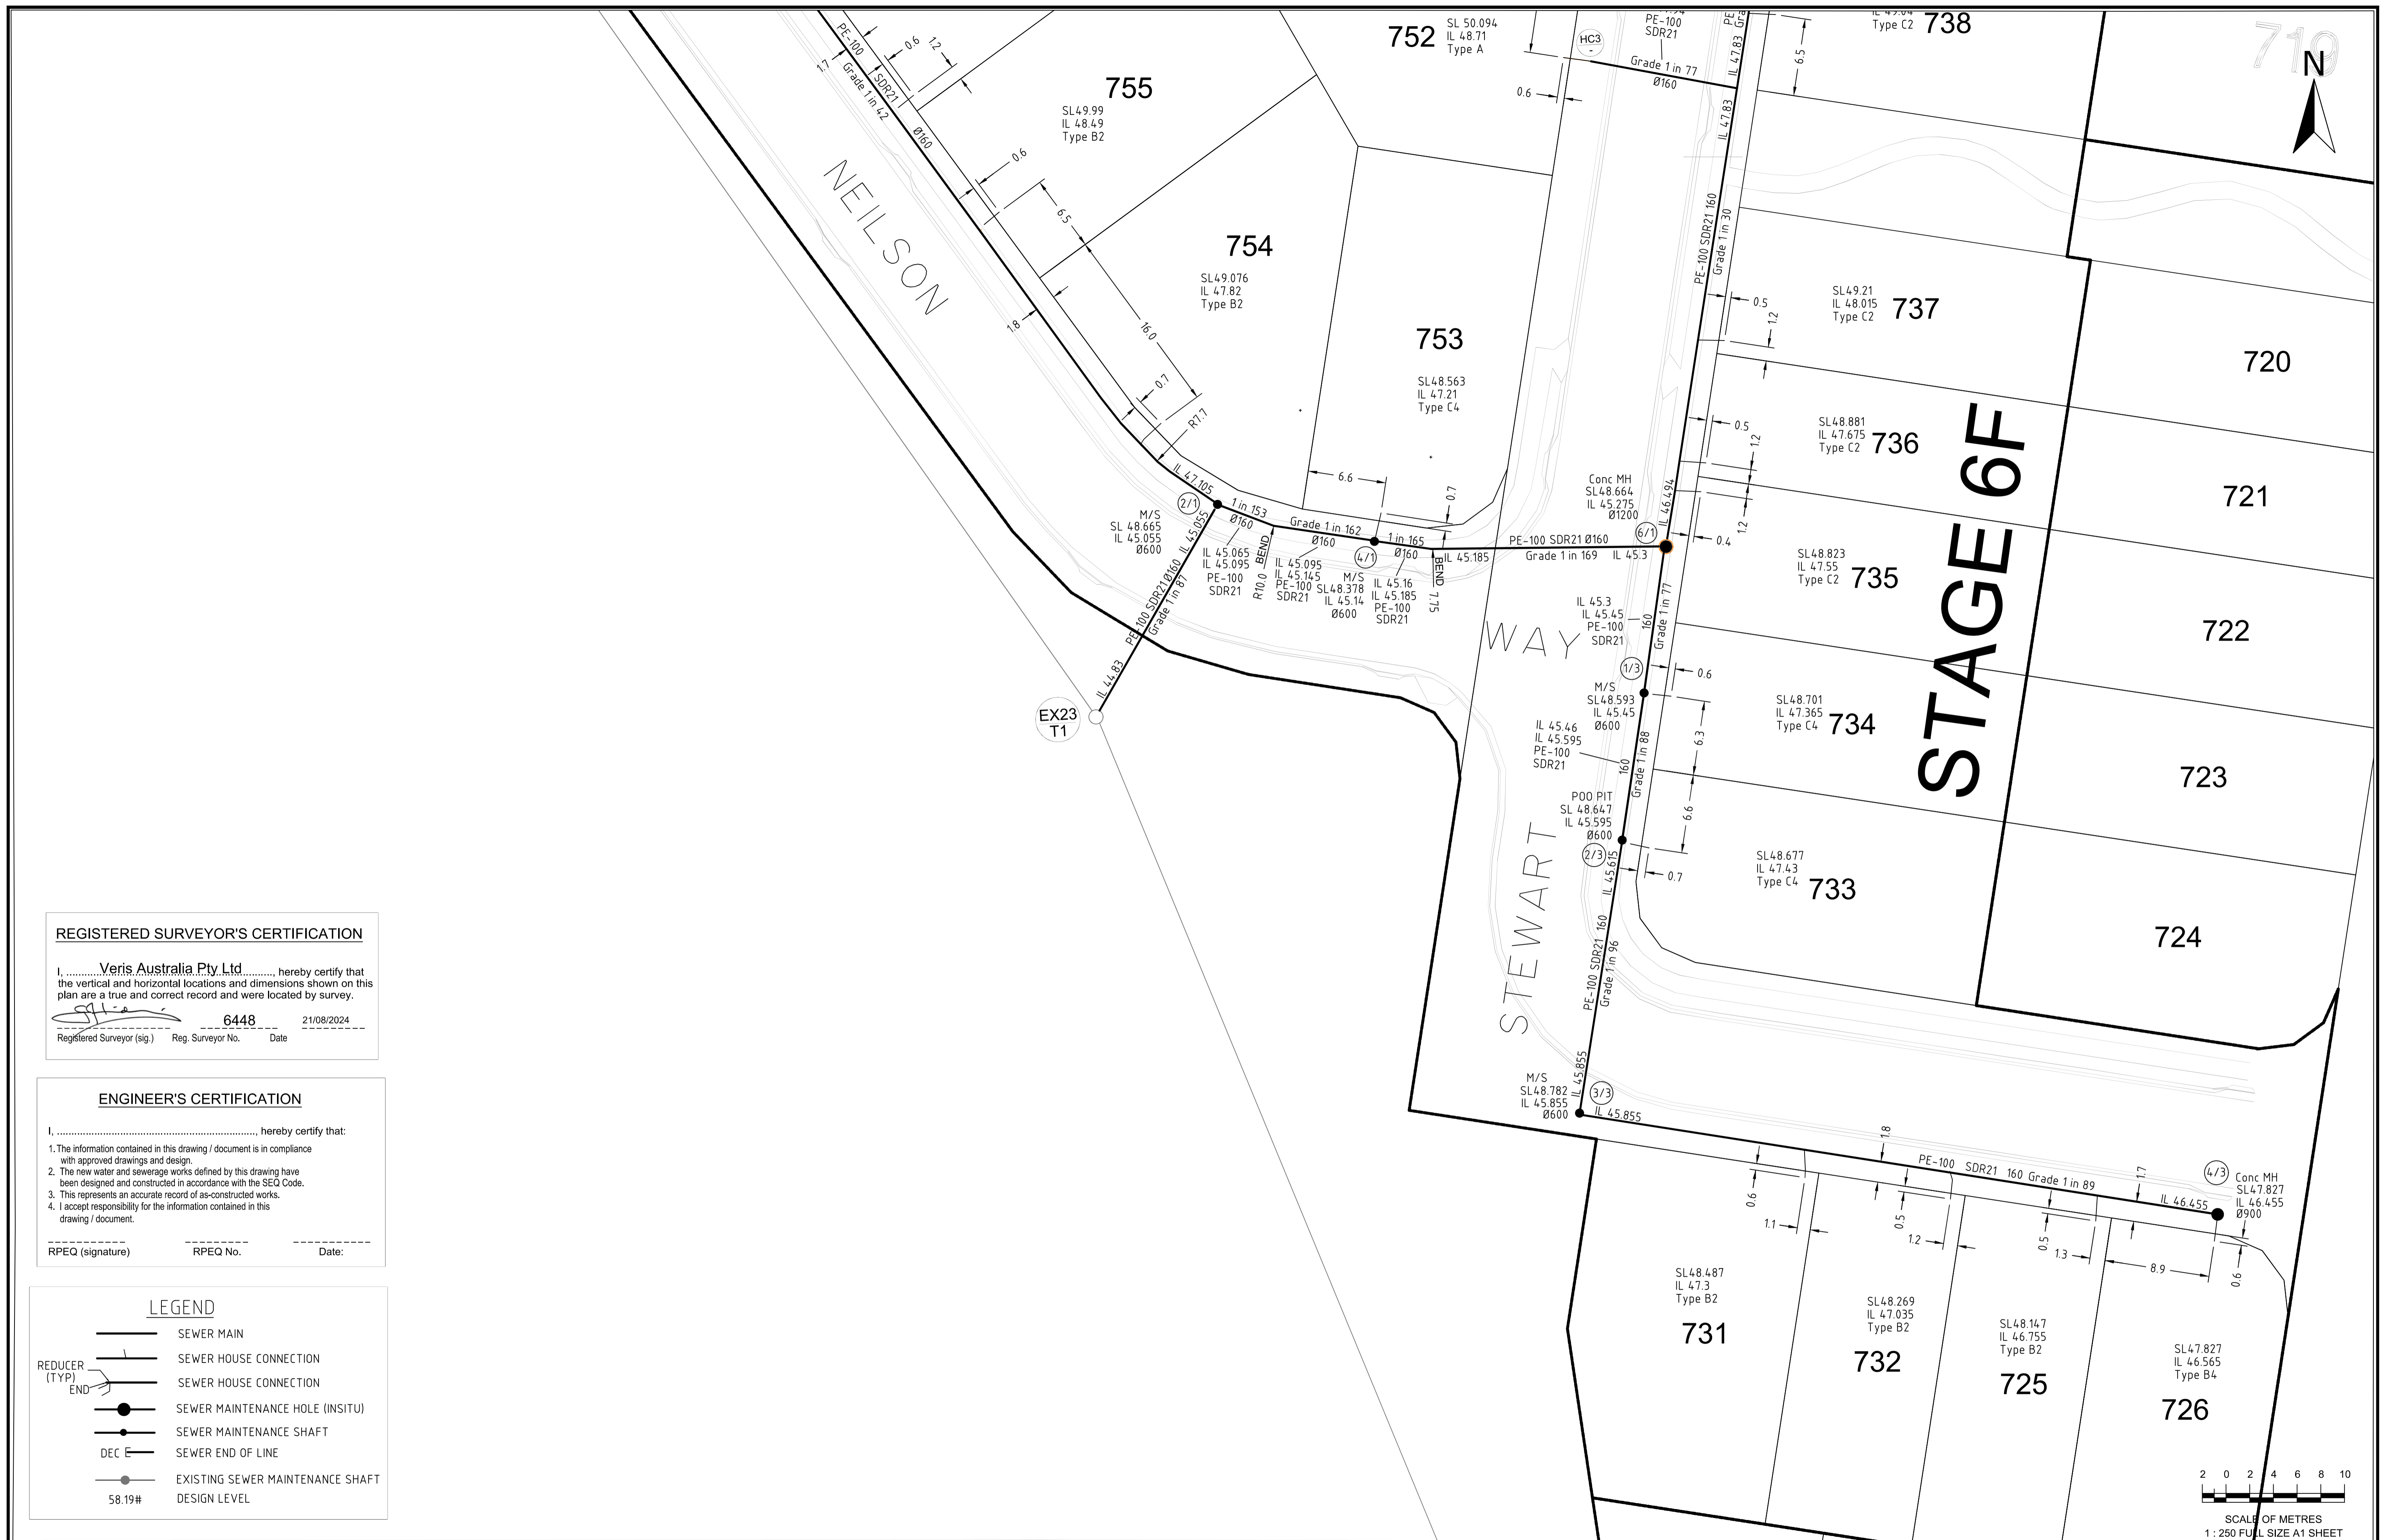

REGISTERED SURVEYOR'S CERTIFICATION

I, Veris Australia Pty Ltd, hereby certify that the vertical and horizontal locations and dimensions shown on this plan are a true and correct record and were located by survey.


[Signature] 6448 21/08/2024
 Registered Surveyor (sig.) Reg. Surveyor No. Date

ENGINEER'S CERTIFICATION

I, _____, hereby certify that:

- The information contained in this drawing / document is in compliance with approved drawings and design.
- The new water and sewerage works defined by this drawing have been designed and constructed in accordance with the SEQ Code.
- This represents an accurate record of as-constructed works.
- I accept responsibility for the information contained in this drawing / document.

 RPEQ (signature) RPEQ No. Date:

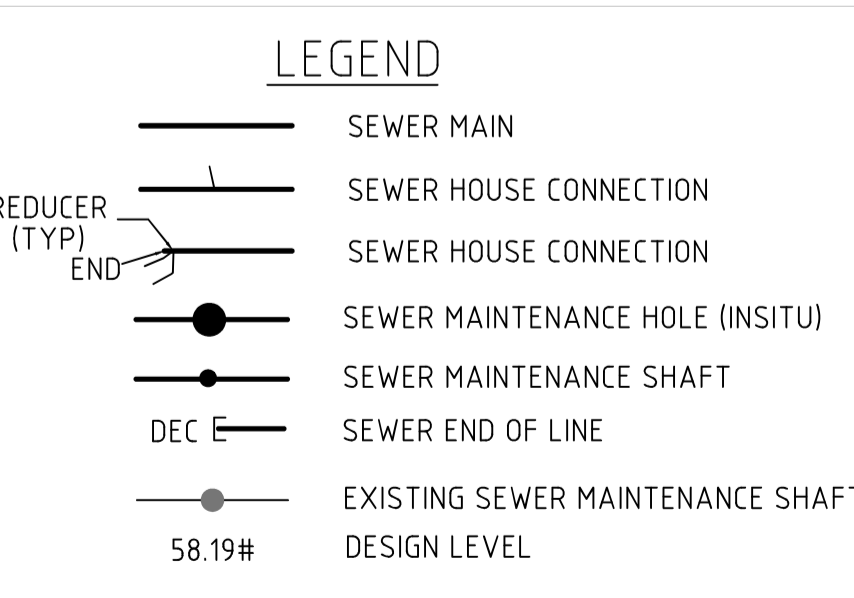

A1	E	25/07/2024	FINAL	JMc				
	D	16/07/2024	PROGRESS PLOT AS CON SEWER	JMc				
	C	27/05/2024	PROGRESS PLOT AS CON SEWER	JMc				
	B	22/03/2024	PROGRESS PLOT AS CON SEWER	JMc			DRAWN	JMc 12/02/2024
	F	20/08/2024	PROGRESS PLOT AS CON SEWER	JMc			CHECKED	
	REV NO	DATE	REVISION PURPOSE / DESCRIPTION	DRAWN	RPEQ	RPEQ No	INITIALS	DATE

veris

BRISBANE (07) 3666 4700 WHITSUNDAYS (07) 4945 6600
 MACKAY (07) 4957 9100 CAIRNS (07) 4052 9400

veris.com.au
 ACN 615 735 727
 Veris Australia Pty Ltd



DAWN WALLOON
 Neilson Way Walloon

STAGE 6F
 AS CONSTRUCTED SEWER

DRAWING STATUS
AS CONSTRUCTED

SHEET 3 OF 3 SHEETS

DRAWING NO. 401905-6F-AS01 REV. F