

SHEET 2

SHEET 3

SHEET 4


REGISTERED SURVEYOR'S CERTIFICATION
 I, Veris Australia Pty Ltd, hereby certify that the vertical and horizontal locations and dimensions shown on this plan are a true and correct record and were located by survey.

 Registered Surveyor (sig.) Reg. Surveyor No. 6448 Date: 21/08/2024

ENGINEER'S CERTIFICATION
 I, _____, hereby certify that:
 1. The information contained in this drawing / document is in compliance with approved drawings and design.
 2. This represents an accurate record of as-constructed works.
 3. I accept responsibility for the information contained in this drawing / document.

 RPEQ (signature) RPEQ No. Date:

AS CONSTRUCTED

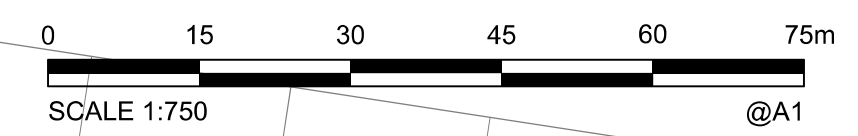

A1	E	20/08/2024	PROGRESS PLOT	JMc		
	D	25/07/2024	PROGRESS PLOT	JMc		
	C	22/07/2024	ADDED PIPE LENGTHS AND GRADES	JMc		
	B	16/07/2024	PROGRESS PLOT	JMc		
	A	22/05/2024	PROGRESS PLOT	JMc		
INDEX	DATE	REVISIONS	DRAWN	CHECKED	PASSED	


DRAWN	JMc	22/05/2024
CHECKED		
PASSED		
INITIALS		DATE

veris
 BRISBANE (07) 3800 4700 WHITSUNDAYS (07) 4945 0500
 MACKAY (07) 5497 9700 CAIRNS (07) 4232 3400
 veris.com.au
 ACN 615 735 727
 Veris Australia Pty Ltd



IPSWICH CITY COUNCIL
 WATERLEA WALLOON STAGE 6F
 AS CONSTRUCTED
 DRAINAGE

SCALE 1:750 @A1
 SHEET 1 OF 4 SHEETS
 DRAWING NO. 401905-6F-ASW01

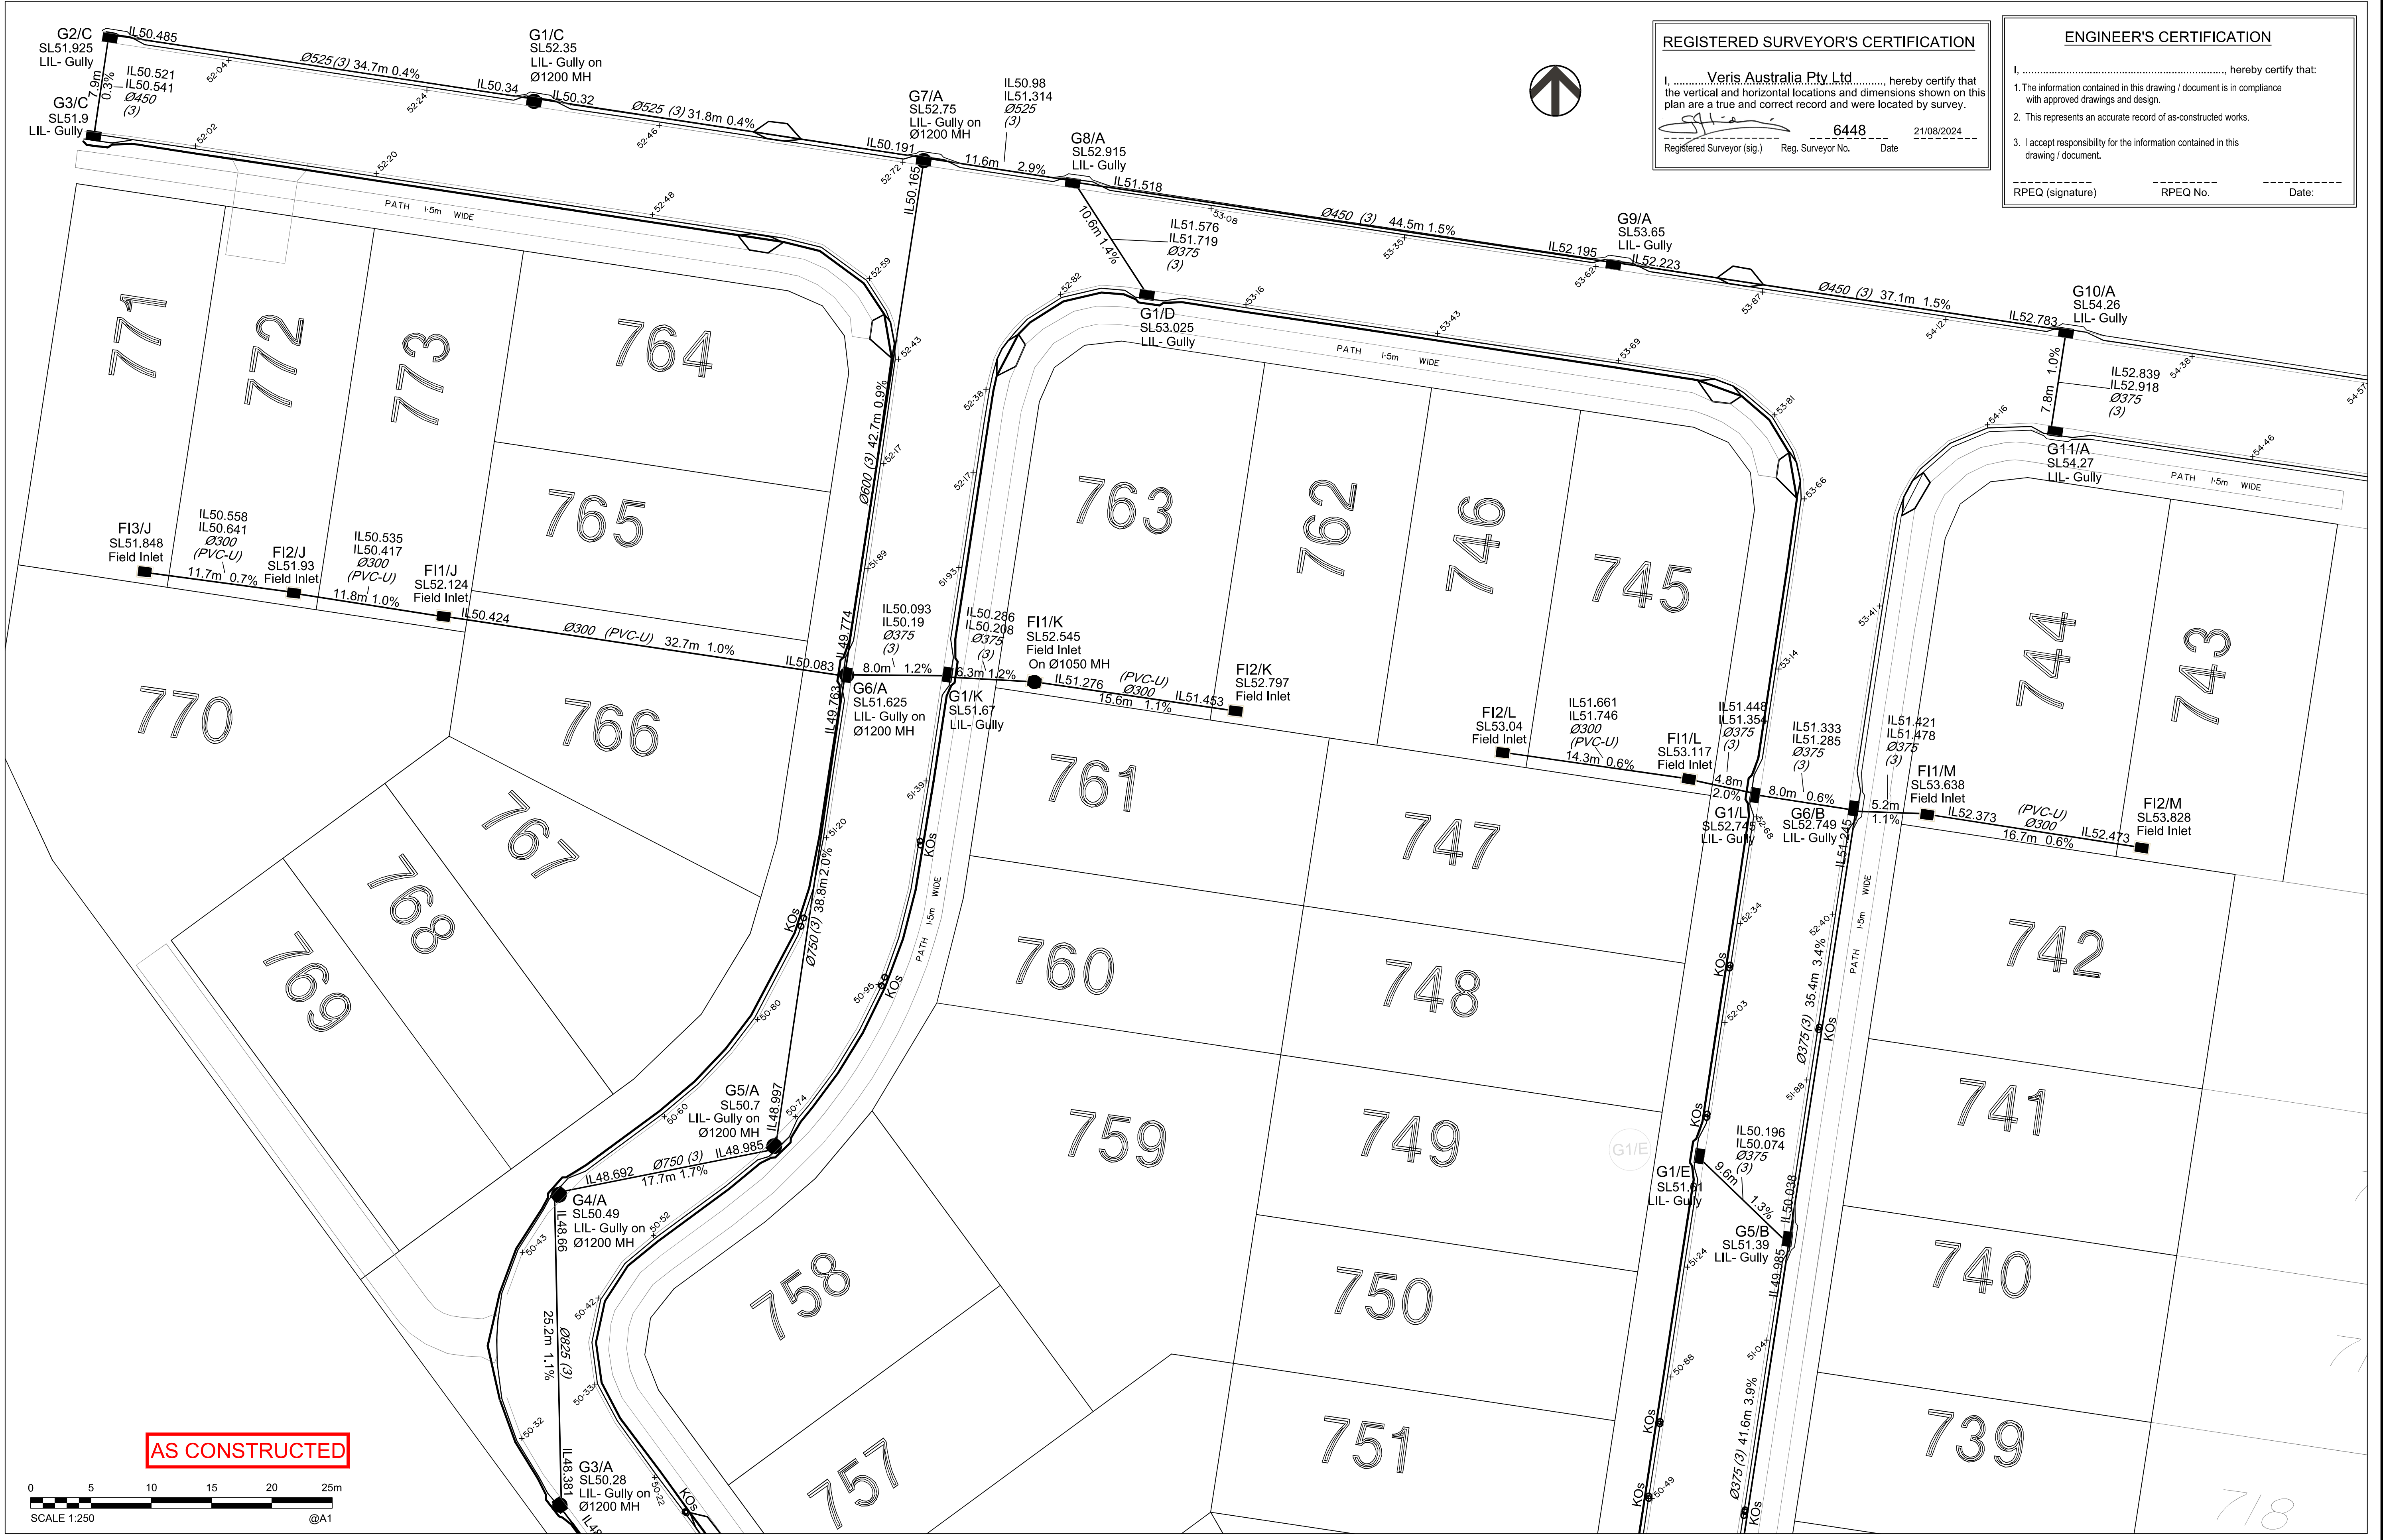

REGISTERED SURVEYOR'S CERTIFICATION

I, Veris Australia Pty Ltd, hereby certify that the vertical and horizontal locations and dimensions shown on this plan are a true and correct record and were located by survey.

Registered Surveyor (sig.) [Signature] Reg. Surveyor No. 6448 Date 21/08/2024

ENGINEER'S CERTIFICATION

I, _____, hereby certify that:

- The information contained in this drawing / document is in compliance with approved drawings and design.
- This represents an accurate record of as-constructed works.
- I accept responsibility for the information contained in this drawing / document.

RPEQ (signature) _____ RPEQ No. _____ Date: _____

A1	E	20/08/2024	PROGRESS PLOT	Jk		
	D	25/07/2024	PROGRESS PLOT	Jk		
	C	22/07/2024	ADDED PIPE LENGTHS AND GRADES	Jk		
	B	16/07/2024	PROGRESS PLOT	Jk		
	A	13/02/2024	PROGRESS PLOT	Jk		
INDEX	DATE	REVISIONS	DRAWN	CHECKED	PASSED	

DRAWN	Jk	13/02/2024
CHECKED		
PASSED		
INITIALS		DATE

veris


BRISBANE (07) 3666 4700 WHITSUNDAYS (07) 4945 5600
 MACKAY (07) 4907 9100 CAIRNS (07) 4522 9400
 veris.com.au
 ACN 615 735 727
 Veris Australia Pty Ltd



IPSWICH CITY COUNCIL

WATERLEA WALLOON STAGE 6F
 AS CONSTRUCTED
 DRAINAGE

SCALE	1:250 @A1
SHEET 2	OF 4 SHEETS
DRAWING NO.	E D C B A
	401905-6F-ASW01

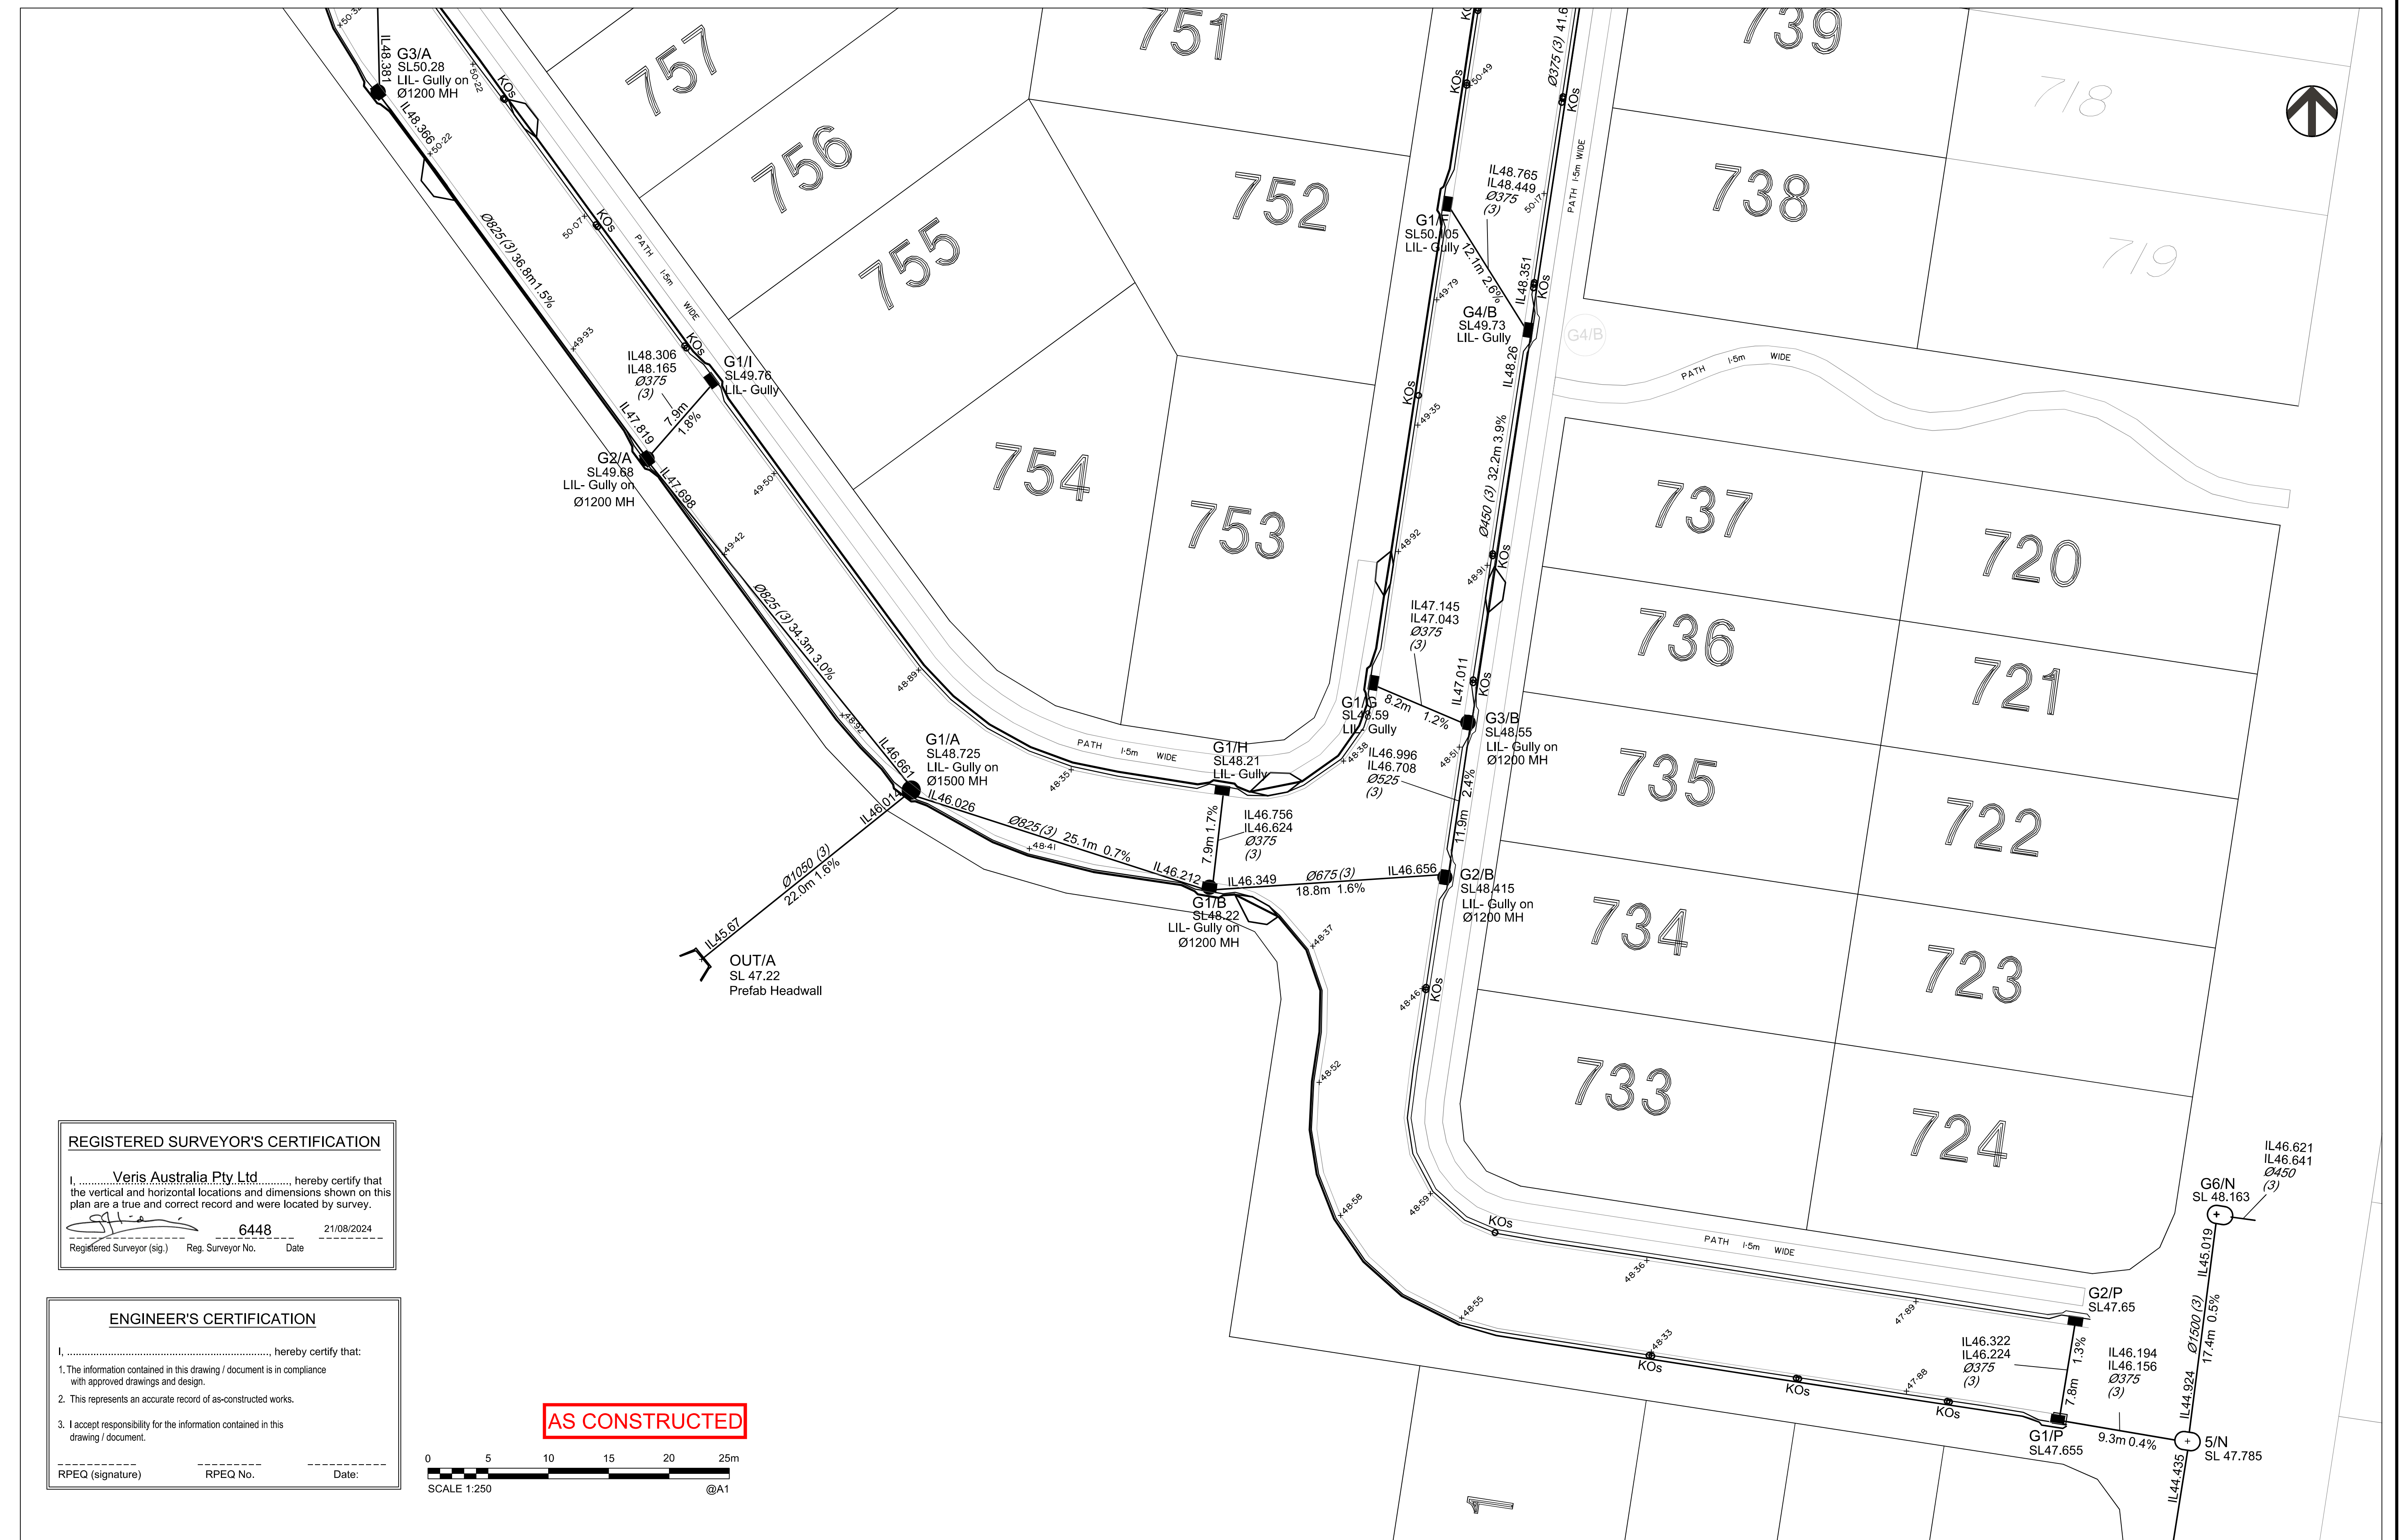

REGISTERED SURVEYOR'S CERTIFICATION

I, Veris Australia Pty Ltd, hereby certify that the vertical and horizontal locations and dimensions shown on this plan are a true and correct record and were located by survey.


 6448 21/08/2024
 Registered Surveyor (sig.) Reg. Surveyor No. Date

ENGINEER'S CERTIFICATION

I, _____, hereby certify that:

- The information contained in this drawing / document is in compliance with approved drawings and design.
- This represents an accurate record of as-constructed works.
- I accept responsibility for the information contained in this drawing / document.

RPEQ (signature) RPEQ No. Date:

AS CONSTRUCTED



A1

E	20/08/2024	PROGRESS PLOT	JMc		
D	25/07/2024	PROGRESS PLOT	JMc		
C	22/07/2024	ADDED PIPE LENGTHS AND GRADES	JMc		
B	16/07/2024	PROGRESS PLOT	JMc		
A	13/02/2024	PROGRESS PLOT	JMc		
INDEX	DATE	REVISIONS	DRAWN	CHECKED	PASSED

DRAWN	JMc	13/02/2024
CHECKED		
PASSED		
INITIALS		DATE



BRISBANE (07) 3860 4700 WHITSUNDAYS (07) 4945 8600
 MACKAY (07) 5487 9100 CAIRNS (07) 4232 3400
 veris.com.au
 ACN 615 735 727
 Veris Australia Pty Ltd



IPSWICH CITY COUNCIL

WATERLEA WALLOON STAGE 6F
AS CONSTRUCTED
DRAINAGE

SCALE	1:250 @A1
SHEET	3 OF 4 SHEETS
DRAWING NO.	401905-6F-ASW01
	E D C B A



REGISTERED SURVEYOR'S CERTIFICATION

I, Veris Australia Pty Ltd, hereby certify that the vertical and horizontal locations and dimensions shown on this plan are a true and correct record and were located by survey.

[Signature] 6448 21/08/2024
 Registered Surveyor (sig.) Reg. Surveyor No. Date


ENGINEER'S CERTIFICATION

I, _____, hereby certify that:

- The information contained in this drawing / document is in compliance with approved drawings and design.
- This represents an accurate record of as-constructed works.
- I accept responsibility for the information contained in this drawing / document.

 RPEQ (signature) RPEQ No. Date:

AS CONSTRUCTED

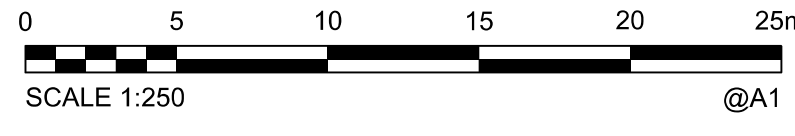

A1

E	20/08/2024	PROGRESS PLOT	JMc		
D	25/07/2024	PROGRESS PLOT	JMc		
C	22/07/2024	ADDED PIPE LENGTHS AND GRADES	JMc		
B	16/07/2024	PROGRESS PLOT	JMc		
A	13/02/2024	PROGRESS PLOT	JMc		
INDEX	DATE	REVISIONS	DRAWN	CHECKED	PASSED

DRAWN	JMc	13/02/2024
CHECKED		
PASSED		
INITIALS		DATE

veris

BRISBANE (07) 3888 4700 WHITSUNDAYS (07) 4945 8500
 MACKAY (07) 5487 9100 CAIRNS (07) 4232 3400
 veris.com.au
 ACN 615 735 727
 Veris Australia Pty Ltd



IPSWICH CITY COUNCIL

WATERLEA WALLOON STAGE 6F
 AS CONSTRUCTED
 DRAINAGE

SCALE	1:250 @A1
SHEET	4 OF 4 SHEETS
DRAWING NO.	401905-6F-ASW01
E	
D	
C	
B	
A	