


AS CONSTRUCTED



NBN SYMBOL LEGEND

	Transformer / Kiosk / Pad Mount Sub-station / Pole Mount Transformer
PIT-ID 5	Network Boundary/Local Network Pit (Single Lid) (700mmX450mmX650mm)
PIT-ID 8	Distribution/Local Network Connection Pit (1360mmX555mmX860mm)
PIT-ID 9	Fibre Distribution Hub (FDH) Pit (2000mmX555mmX900mm)
	Shared Trench Symbol
	Energex Pillar

TRENCH SECTION

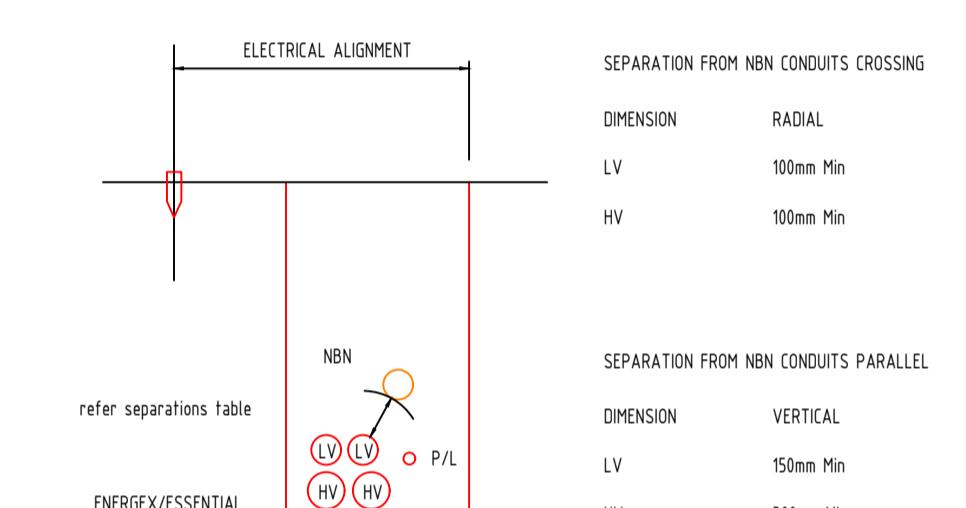


SDU Development Information

Development Name: DAWN - STAGE 6F
Developer Company: JG Walloon Development Pty Ltd
Development Address: WATERLEA BLVD, WALLOON
Authorised Rep: PE CONSULTING ENGINEERS
Phone: 07 5596 1425
E-Mail: urd@pece.com.au


nbn Reference Number: STG-M000138608 Stage Number: 6F Design Revision: C

BILL OF MATERIAL				
NO OF LOTS: 45				
PITS	DUCTS			
SIZE	QTY	SIZE		
2	8	P100	26	719.6
5	16	P50	9	24.6.4
6	0	P20	45	355.2
8	7			
9	0			
TOTAL NUMBER OF PITS: 31				
TOTAL NUMBER OF MANHOLES: 0				
TOTAL NUMBER OF CONDUITS: 80				
TOTAL LENGTH OF CONDUITS: 13212				

CONDUIT CONFIGURATION

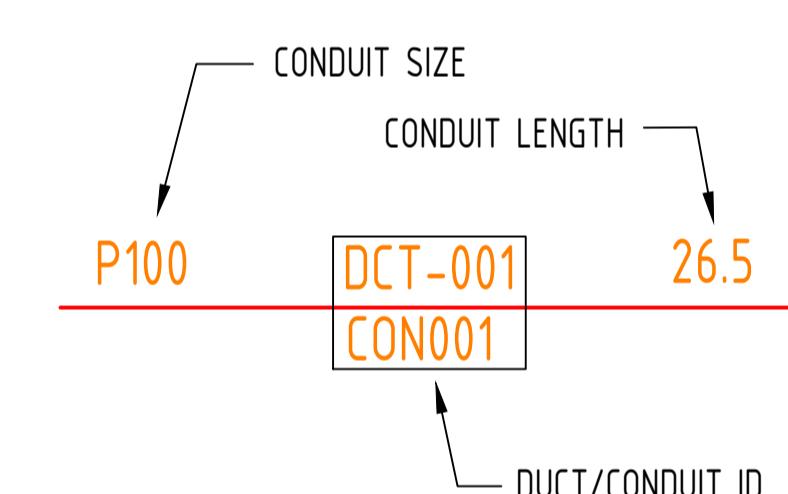

STANDARD NBN PIT OFFSET TO ENERGEX PILLAR

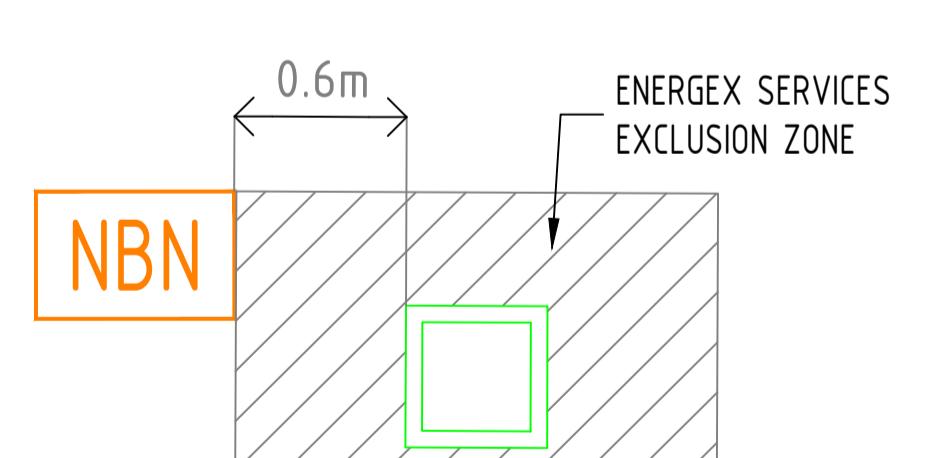

WHERE PITS ARE NOT LOCATED BESIDE PILLARS, OFFSETS WILL BE SHOWN ON THE LAYOUT TO THE NEAREST TRUNCATION. IF NO OFFSET DISTANCE IS SHOWN, PLEASE CONTACT DESIGN CONSULTANT PRIOR TO INSTALLATION.



STRICTLY CONFIDENTIAL			
NBNCO APPROVAL RECORD:			
SIGNATURE _____ DATE _____			
<input type="checkbox"/> DD <input type="checkbox"/> WD <input type="checkbox"/> AB			
QUALITY RECORD :			
NBNCO DISCLAIMER			
THIS DOCUMENT HAS BEEN PREPARED SOLELY FOR THE USE OF NBNCO LIMITED (ABN 86 136 533 741) FOR USE IN MAINTAINING NBNCO FACILITIES. IT HAS NOT BEEN CREATED FOR ANY OTHER USE. IT SHOULD NOT BE USED TO LOCATE NBNCO ASSETS. NO WARRANTY IS GIVEN THAT THE INFORMATION IS ACCURATE OR COMPLETE.			
C	02.09.24	AJ	AS CONSTRUCTED
B	22.03.24	AJ	ISSUED FOR CONSTRUCTION
A	12.09.2023	AI	ISSUE FOR NBN APPROVAL
REV	DATE	DRAFTER	DESCRIPTION
			APPROVED