




**AS CONSTRUCTED**

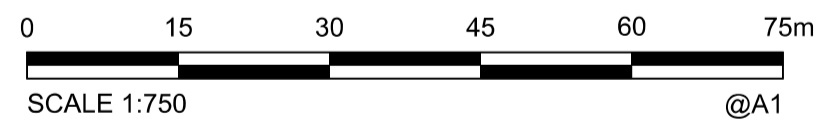

**REGISTERED SURVEYOR'S CERTIFICATION**

I, **Veris Australia Pty Ltd**, hereby certify that the vertical and horizontal locations and dimensions shown on this plan are a true and correct record and were located by survey.

*[Signature]* **6448** 17/01/2025  
 Qld Registered Surveyor (sig.) Qld Reg. Surveyor No. Date

**ENGINEER'S CERTIFICATION**

- I, \_\_\_\_\_, hereby certify that:
- The information contained in this drawing / document is in compliance with approved drawings and design.
  - This represents an accurate record of as-constructed works.
  - I accept responsibility for the information contained in this drawing / document.

RPEQ (signature) RPEQ No. Date:

**LEGEND**

- 42.5 AS CONSTRUCTED CONTOURS (Interval 0.25m)
- 43 Top of Bank
- CHANGE OF GRADE
- RETAINING WALL

**A1**

B	15/01/2025	INCLUDE TEMP TURNAROUND CONTOURS	JMc		
A	15/11/2024	FINAL	JMc		
INDEX	DATE	REVISIONS	DRAWN	CHECKED	PASSED

DRAWN	JMc	15/11/2024
CHECKED		
PASSED		
INITIALS		DATE



BRISBANE (07) 3800 4700  
 WHITSUNDAYS (07) 4945 0500  
 MACKAY (07) 5497 9100 CAIRNS (07) 4232 3400  
 veris.com.au  
 ACN 615 735 727  
 Veris Australia Pty Ltd



**IPSWICH CITY COUNCIL**

WATERLEA WALLOON STAGE 6E  
 AS CONSTRUCTED  
 EARTHWORKS

SCALE	1:750 @A1
SHEET	1 OF 4 SHEETS
DRAWING NO.	401905-6E-AEW01
	B
	A



**LEGEND**

42.5	AS CONSTRUCTED CONTOURS (Interval 0.25m)
43	Top of Bank
44	Bottom of Bank
—	CHANGE OF GRADE
—	RETAINING WALL

**ENGINEER'S CERTIFICATION**

I, ....., hereby certify that:

- The information contained in this drawing / document is in compliance with approved drawings and design.
- This represents an accurate record of as-constructed works.
- I accept responsibility for the information contained in this drawing / document.


RPEQ (signature) \_\_\_\_\_ RPEQ No. \_\_\_\_\_ Date: \_\_\_\_\_

**REGISTERED SURVEYOR'S CERTIFICATION**

I, ..... **Veris Australia Pty Ltd** ....., hereby certify that the vertical and horizontal locations and dimensions shown on this plan are a true and correct record and were located by survey.

*[Signature]* \_\_\_\_\_ **6448** \_\_\_\_\_ 17/01/2025  
 Old Registered Surveyor (sig.) Old Reg. Surveyor No. Date

**AS CONSTRUCTED**

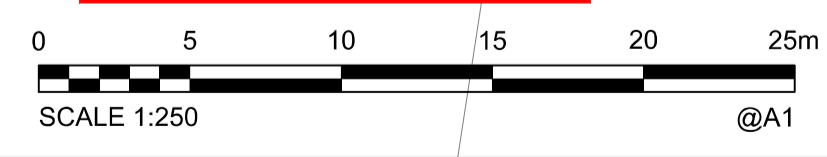

<b>A1</b>	B	15/01/2024	INCLUDE TEMP TURNAROUND CONTOURS	JMc						
	A	15/11/2024	FINAL	JMc						
	INDEX	DATE	REVISIONS	DRAWN	CHECKED	PASSED	INITIALS	DATE		


**veris**  
 BRISBANE (07) 3800 4700  
 MACKAY (07) 4987 9100  
 WHITSUNDAYS (07) 4945 0500  
 CAIRNS (07) 4332 3400  
 veris.com.au  
 ACN 616 735 727  
 Veris Australia Pty Ltd



**IPSWICH CITY COUNCIL**

WATERLEA WALLOON STAGE 6E  
 AS CONSTRUCTED  
 EARTHWORKS

SCALE	1:250 @A1
SHEET	2 OF 4 SHEETS
DRAWING NO.	401905-6E-AEW01

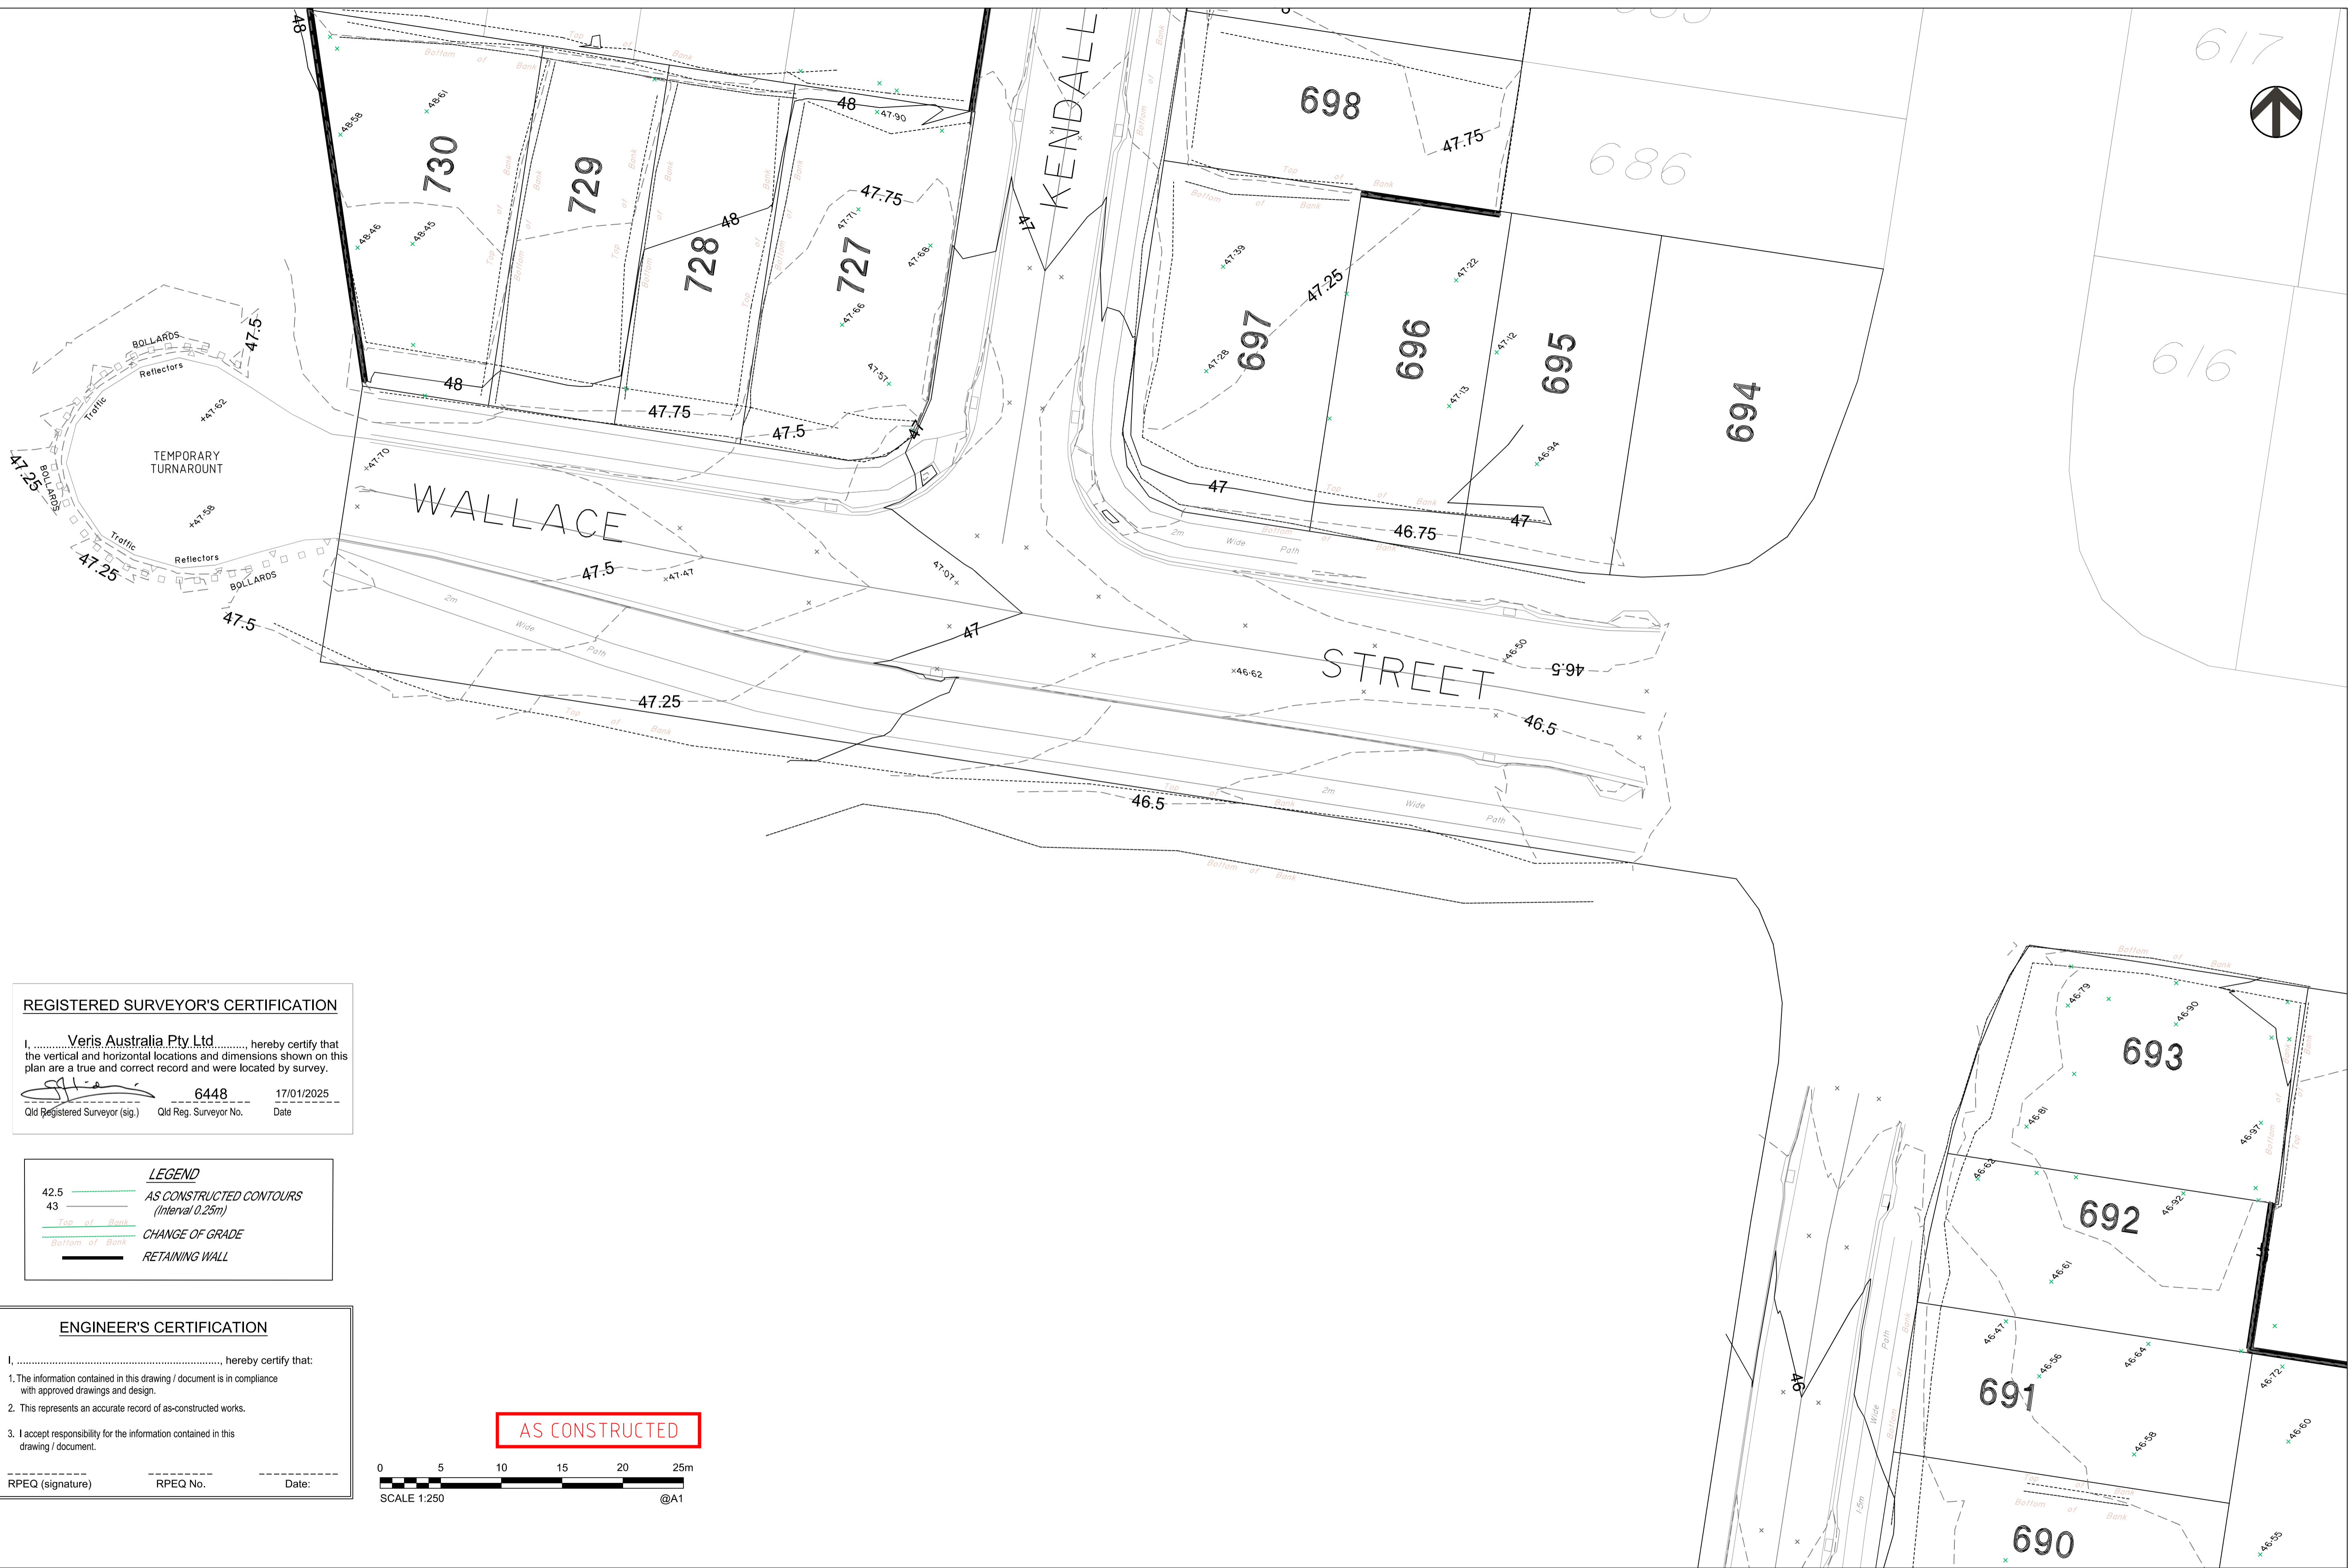

**REGISTERED SURVEYOR'S CERTIFICATION**

I, Veris Australia Pty Ltd, hereby certify that the vertical and horizontal locations and dimensions shown on this plan are a true and correct record and were located by survey.

*[Signature]* 6448 17/01/2025  
 Old Registered Surveyor (sig.) Old Reg. Surveyor No. Date

**LEGEND**

42.5 AS CONSTRUCTED CONTOURS  
 43 (Interval 0.25m)

Top of Bank CHANGE OF GRADE  
 Bottom of Bank

RETAINING WALL


**ENGINEER'S CERTIFICATION**

I, \_\_\_\_\_, hereby certify that:

- The information contained in this drawing / document is in compliance with approved drawings and design.
- This represents an accurate record of as-constructed works.
- I accept responsibility for the information contained in this drawing / document.

RPEQ (signature) RPEQ No. Date:

**AS CONSTRUCTED**

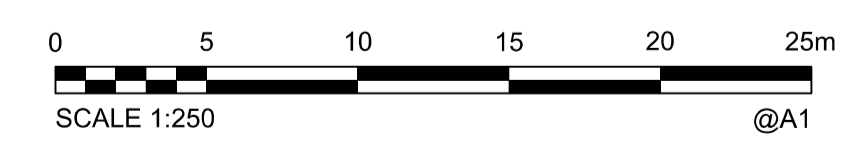

A1	B	15/01/2025	INCLUDE TEMP TURNAROUND CONTOURS	JMc		
	A	15/11/2024	FINAL	JMc		
INDEX	DATE	REVISIONS		DRAWN	CHECKED	PASSED

DRAWN	JMc	15/11/2024
CHECKED		
PASSED		
INITIALS		DATE

**veris**


BRISBANE (07) 3888 4700  
 WHITSUNDAYS (07) 4945 0500  
 MACKAY (07) 5487 9100  
 CAIRNS (07) 4232 3400  
 veris.com.au  
 ACN 615 735 727  
 Veris Australia Pty Ltd



**IPSWICH CITY COUNCIL**

WATERLEA WALLOON STAGE 6E  
 AS CONSTRUCTED  
 EARTHWORKS

SCALE 1:250 @A1  
 SHEET 3 OF 4 SHEETS  
 DRAWING NO.  
 401905-6F-AEW01

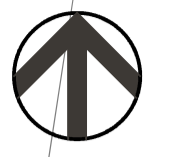

**REGISTERED SURVEYOR'S CERTIFICATION**

I, Veris Australia Pty Ltd, hereby certify that the vertical and horizontal locations and dimensions shown on this plan are a true and correct record and were located by survey.

[Signature] 6448 17/01/2025  
 Old Registered Surveyor (sig.) Old Reg. Surveyor No. Date

**LEGEND**

42.5 AS CONSTRUCTED CONTOURS (Interval 0.25m)

43 CHANGE OF GRADE

RETAINING WALL


**ENGINEER'S CERTIFICATION**

I, \_\_\_\_\_, hereby certify that:

- The information contained in this drawing / document is in compliance with approved drawings and design.
- This represents an accurate record of as-constructed works.
- I accept responsibility for the information contained in this drawing / document.

RPEQ (signature) RPEQ No. Date:

**AS CONSTRUCTED**

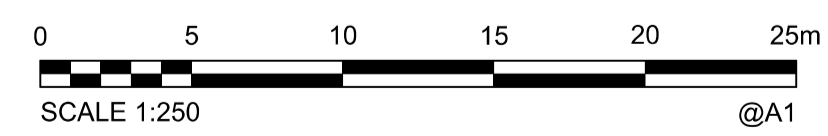

<b>A1</b>	B	15/01/2025	INCLUDE TEMP TURNAROUND CONTOURS	JMc		
	A	15/11/2024	FINAL	JMc		
INDEX	DATE	REVISIONS		DRAWN	CHECKED	PASSED

DRAWN	JMc	15/11/2024
CHECKED		
PASSED		
INITIALS		DATE

**veris**

BRISBANE (07) 3800 4700 WHITSUNDAYS (07) 4945 0500  
 MACKAY (07) 5487 9700 CAIRNS (07) 4232 3400  
 veris.com.au  
 ACN 616 735 727  
 Veris Australia Pty Ltd



**IPSWICH CITY COUNCIL**

WATERLEA WALLOON STAGE 6E  
 AS CONSTRUCTED  
 EARTHWORKS

SCALE 1:250 @A1  
 SHEET 4 OF 4 SHEETS  
 DRAWING NO.  
 401905-6F-AEW01