


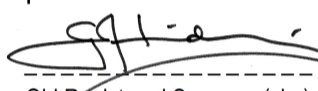

REGISTERED SURVEYOR'S CERTIFICATION

I, Veris Australia Pty Ltd, hereby certify that the vertical and horizontal locations and dimensions shown on this plan are a true and correct record and were located by survey.



 6448 17/01/2025
 Qld Registered Surveyor (sig.) Qld Reg. Surveyor No. Date

ENGINEER'S CERTIFICATION

I, _____, hereby certify that:

- The information contained in this drawing / document is in compliance with approved drawings and design.
- The new water and sewerage works defined by this drawing have been designed and constructed in accordance with the SEQ Code.
- This represents an accurate record of as-constructed works.
- I accept responsibility for the information contained in this drawing / document.

RPEQ (signature) RPEQ No. Date:

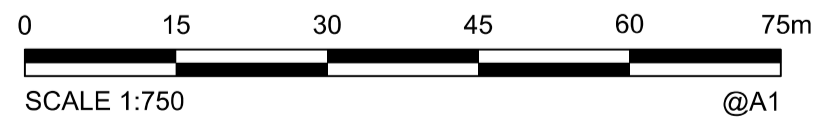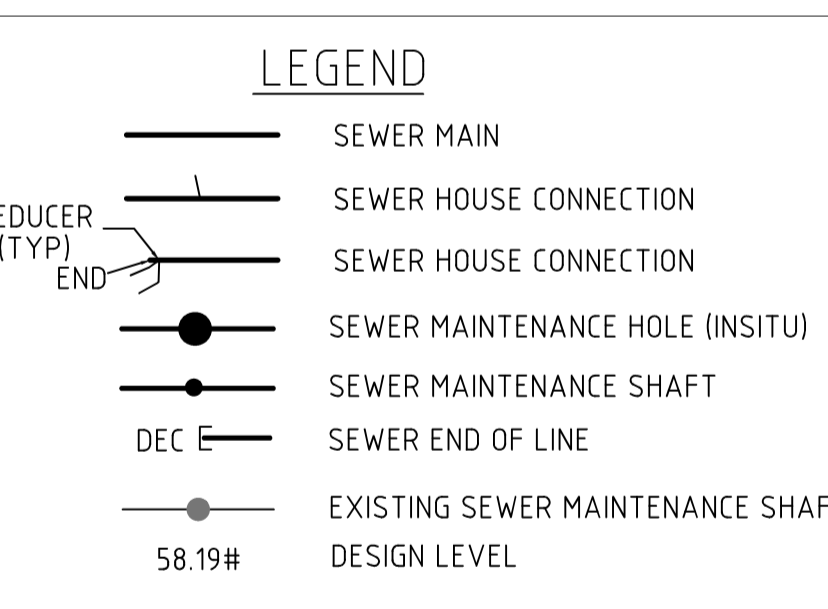

A1	E	31/10/2024	PROGRESS PLOT AS CON SEWER	JMc					
	D	30/09/2024	PROGRESS PLOT AS CON SEWER	JMc					
	C	21/08/2024	PROGRESS PLOT AS CON SEWER	JMc			DRAWN	JMc	05/06/2024
	B	18/06/2024	PROGRESS PLOT AS CON SEWER	JMc			CHECKED		
	A	05/06/2024	PROGRESS PLOT AS CON SEWER	JMc			APPROVED		
REV NO	DATE	REVISION PURPOSE / DESCRIPTION			DRAWN	RPEQ	RPEQ No	INITIALS	DATE

veris

BRISBANE (07) 3666 4700 WHITSUNDAYS (07) 4945 6600
 MACKAY (07) 4957 9700 CAIRNS (07) 4052 9400
 veris.com.au
 ACN 615 735 727
 Veris Australia Pty Ltd



DAWN WALLOON
 Banjo Drive Walloon

STAGE 6E
 AS CONSTRUCTED SEWER

DRAWING STATUS AS CONSTRUCTED	
SHEET 1 OF 4 SHEETS	
DRAWING NO. 401905-6E-AS01	REV. E



REGISTERED SURVEYOR'S CERTIFICATION

I, Veris Australia Pty Ltd, hereby certify that the vertical and horizontal locations and dimensions shown on this plan are a true and correct record and were located by survey.

[Signature] 6448 17/01/2025
 Old Registered Surveyor (sig.) Old Reg. Surveyor No. Date

ENGINEER'S CERTIFICATION

I, Veris Australia Pty Ltd, hereby certify that:
 1. The information contained in this drawing / document is in compliance with approved drawings and design.
 2. The new water and sewerage works defined by this drawing have been designed and constructed in accordance with the SEQ Code.
 3. This represents an accurate record of as-constructed works.
 4. I accept responsibility for the information contained in this drawing / document.

 RPEQ (signature) RPEQ No. Date:

LEGEND

- SEWER MAIN
- SEWER HOUSE CONNECTION
- SEWER HOUSE CONNECTION
- SEWER MAINTENANCE HOLE (INSITU)
- SEWER MAINTENANCE SHAFT
- SEWER END OF LINE
- EXISTING SEWER MAINTENANCE SHAFT
- 58.19# DESIGN LEVEL



SCALE OF METRES
 1 : 250 FULL SIZE A1 SHEET


A1	E	31/10/2024	PROGRESS PLOT AS CON SEWER	JMc					
	D	30/09/2024	PROGRESS PLOT AS CON SEWER	JMc					
	C	21/08/2024	PROGRESS PLOT AS CON SEWER	JMc			DRAWN	JMc	05/06/2024
	B	18/06/2024	PROGRESS PLOT AS CON SEWER	JMc			CHECKED		
	A	05/06/2024	PROGRESS PLOT AS CON SEWER	JMc			APPROVED		
REV NO	DATE	REVISION PURPOSE / DESCRIPTION	DRAWN	RPEQ	RPEQ No		INITIALS	DATE	

veris
 BRISBANE (07) 3666 4700 WHITSUNDAYS (07) 4945 6600
 MACKAY (07) 4957 9700 CAIRNS (07) 4052 9400
 veris.com.au
 ACN 615 735 727
 Veris Australia Pty Ltd

QUEENSLAND UrbanUtilities

DAWN WALLOON
 Banjo Drive Walloon
STAGE 6E
 AS CONSTRUCTED SEWER

DRAWING STATUS
AS CONSTRUCTED
 SHEET 2 OF 4 SHEETS
 DRAWING NO. 401905-6E-AS01
 REV. E

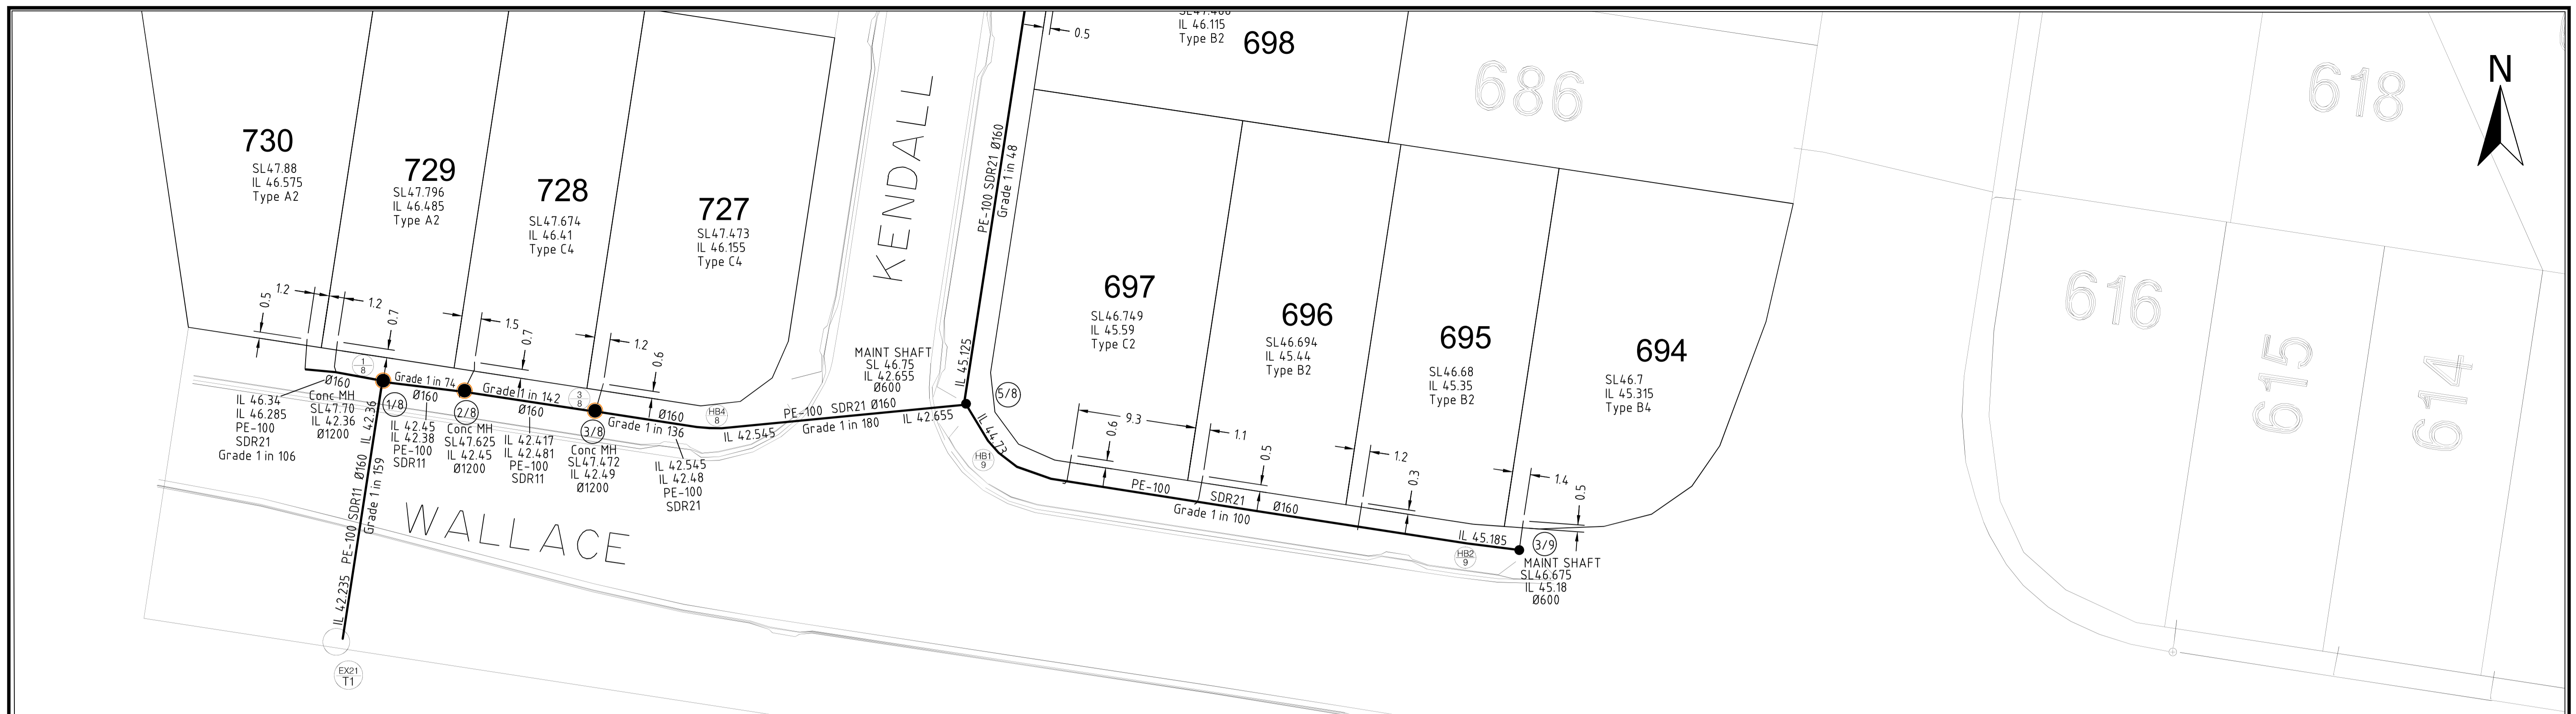

REGISTERED SURVEYOR'S CERTIFICATION

I, **Veris Australia Pty Ltd**, hereby certify that the vertical and horizontal locations and dimensions shown on this plan are a true and correct record and were located by survey.

Old Registered Surveyor (sig.) **6448** 17/01/2025
 Old Reg. Surveyor No. Date

ENGINEER'S CERTIFICATION

I, _____, hereby certify that:

- The information contained in this drawing / document is in compliance with approved drawings and design.
- The new water and sewerage works defined by this drawing have been designed and constructed in accordance with the SEQ Code.
- This represents an accurate record of as-constructed works.
- I accept responsibility for the information contained in this drawing / document.

RPEQ (signature) RPEQ No. Date:

LEGEND

- SEWER MAIN
- SEWER HOUSE CONNECTION
- SEWER HOUSE CONNECTION
- SEWER MAINTENANCE HOLE (INSITU)
- SEWER MAINTENANCE SHAFT
- SEWER END OF LINE
- EXISTING SEWER MAINTENANCE SHAFT
- DESIGN LEVEL



A1	E	31/10/2024	PROGRESS PLOT AS CON SEWER	JMc					
	D	30/09/2024	PROGRESS PLOT AS CON SEWER	JMc					
	C	21/08/2024	PROGRESS PLOT AS CON SEWER	JMc					
	B	18/06/2024	PROGRESS PLOT AS CON SEWER	JMc					
	A	05/06/2024	PROGRESS PLOT AS CON SEWER	JMc					
REV NO	DATE	REVISION PURPOSE / DESCRIPTION	DRAWN	RPEQ	RPEQ No	INITIALS	DATE		

veris

BRISBANE (07) 3666 4700 WHITSUNDAYS (07) 4945 6600
 MACKAY (07) 4957 9700 CAIRNS (07) 4052 9400

veris.com.au
 ACN 615 735 727
 Veris Australia Pty Ltd



DAWN WALLOON
 Banjo Drive Walloon

STAGE 6E
 AS CONSTRUCTED SEWER

DRAWING STATUS AS CONSTRUCTED	
SHEET 3 OF 4 SHEETS	
DRAWING NO. 401905-6E-AS01	REV. E

REGISTERED SURVEYOR'S CERTIFICATION

I, **Veris Australia Pty Ltd**, hereby certify that the vertical and horizontal locations and dimensions shown on this plan are a true and correct record and were located by survey.

[Signature] **6448** 17/01/2025
 Old Registered Surveyor (sig.) Old Reg. Surveyor No. Date

ENGINEER'S CERTIFICATION


I, _____, hereby certify that:

- The information contained in this drawing / document is in compliance with approved drawings and design.
- The new water and sewerage works defined by this drawing have been designed and constructed in accordance with the SEQ Code.
- This represents an accurate record of as-constructed works.
- I accept responsibility for the information contained in this drawing / document.

 RPEQ (signature) RPEQ No. Date:

LEGEND

- SEWER MAIN
- SEWER HOUSE CONNECTION
- SEWER END OF LINE
- SEWER MAINTENANCE HOLE (INSITU)
- SEWER MAINTENANCE SHAFT
- EXISTING SEWER MAINTENANCE SHAFT
- DESIGN LEVEL

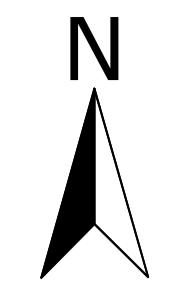

A1	E	31/10/2024	PROGRESS PLOT AS CON SEWER	JMc					
	D	30/09/2024	PROGRESS PLOT AS CON SEWER	JMc					
	C	21/08/2024	PROGRESS PLOT AS CON SEWER	JMc		DRAWN	JMc	05/06/2024	
	B	18/06/2024	PROGRESS PLOT AS CON SEWER	JMc		CHECKED			
	A	05/06/2024	PROGRESS PLOT AS CON SEWER	JMc		APPROVED			
REV NO	DATE	REVISION PURPOSE / DESCRIPTION		DRAWN	RPEQ	RPEQ No	INITIALS	DATE	

BRISBANE (07) 3666 4700
 MACKAY (07) 4957 9100
 veris.com.au
 ACN 615 735 727
 Veris Australia Pty Ltd

WHITSUNDAYS (07) 4945 6600
 CAIRNS (07) 4002 9400

QUEENSLAND
UrbanUtilities

DAWN WALLOON
 Banjo Drive Walloon

STAGE 6E
 AS CONSTRUCTED SEWER

DRAWING STATUS	
AS CONSTRUCTED	
SHEET 4 OF 4 SHEETS	
DRAWING NO.	REV.
401905-6E-AS01	E