

**REGISTERED SURVEYOR'S CERTIFICATION**

I, Veris Australia Pty Ltd, hereby certify that the vertical and horizontal locations and dimensions shown on this plan are a true and correct record and were located by survey.

*[Signature]* 6448 17/01/2025  
 Old Registered Surveyor (sig.) Old Reg. Surveyor No. Date

**ENGINEER'S CERTIFICATION**

I, \_\_\_\_\_, hereby certify that:

- The information contained in this drawing / document is in compliance with approved drawings and design.
- This represents an accurate record of as-constructed works.
- I accept responsibility for the information contained in this drawing / document.

-----  
 RPEQ (signature) RPEQ No. Date:

**AS CONSTRUCTED**

0 15 30 45 60 75m  
 SCALE 1:750 @A1

**A1**

E	15/01/2025	INCLUDE TEMP TURNAROUND	JMc		
D	29/11/2024	PROGRESS PLOT	JMc		
C	29/10/2024	PROGRESS PLOT	JMc		
B	08/10/2024	PROGRESS PLOT	JMc		
A	23/09/2024	PROGRESS PLOT	JMc		
INDEX	DATE	REVISIONS	DRAWN	CHECKED	PASSED

DRAWN	JMc	18/09/2024
CHECKED		
PASSED		
INITIALS		DATE


**veris**  
 BRISBANE (07) 3800 4700 WHITSUNDAYS (07) 4945 0500  
 MACKAY (07) 5487 9100 CAIRNS (07) 4332 3400  
 veris.com.au  
 ACN 615 735 727  
 Veris Australia Pty Ltd



**IPSWICH CITY COUNCIL**

WATERLEA WALLOON STAGE 6E  
 AS CONSTRUCTED  
 DRAINAGE


SCALE	1:750 @A1
SHEET	1 OF 4 SHEETS
DRAWING NO.	401905-6E-ASW01
E	
D	
C	
B	
A	

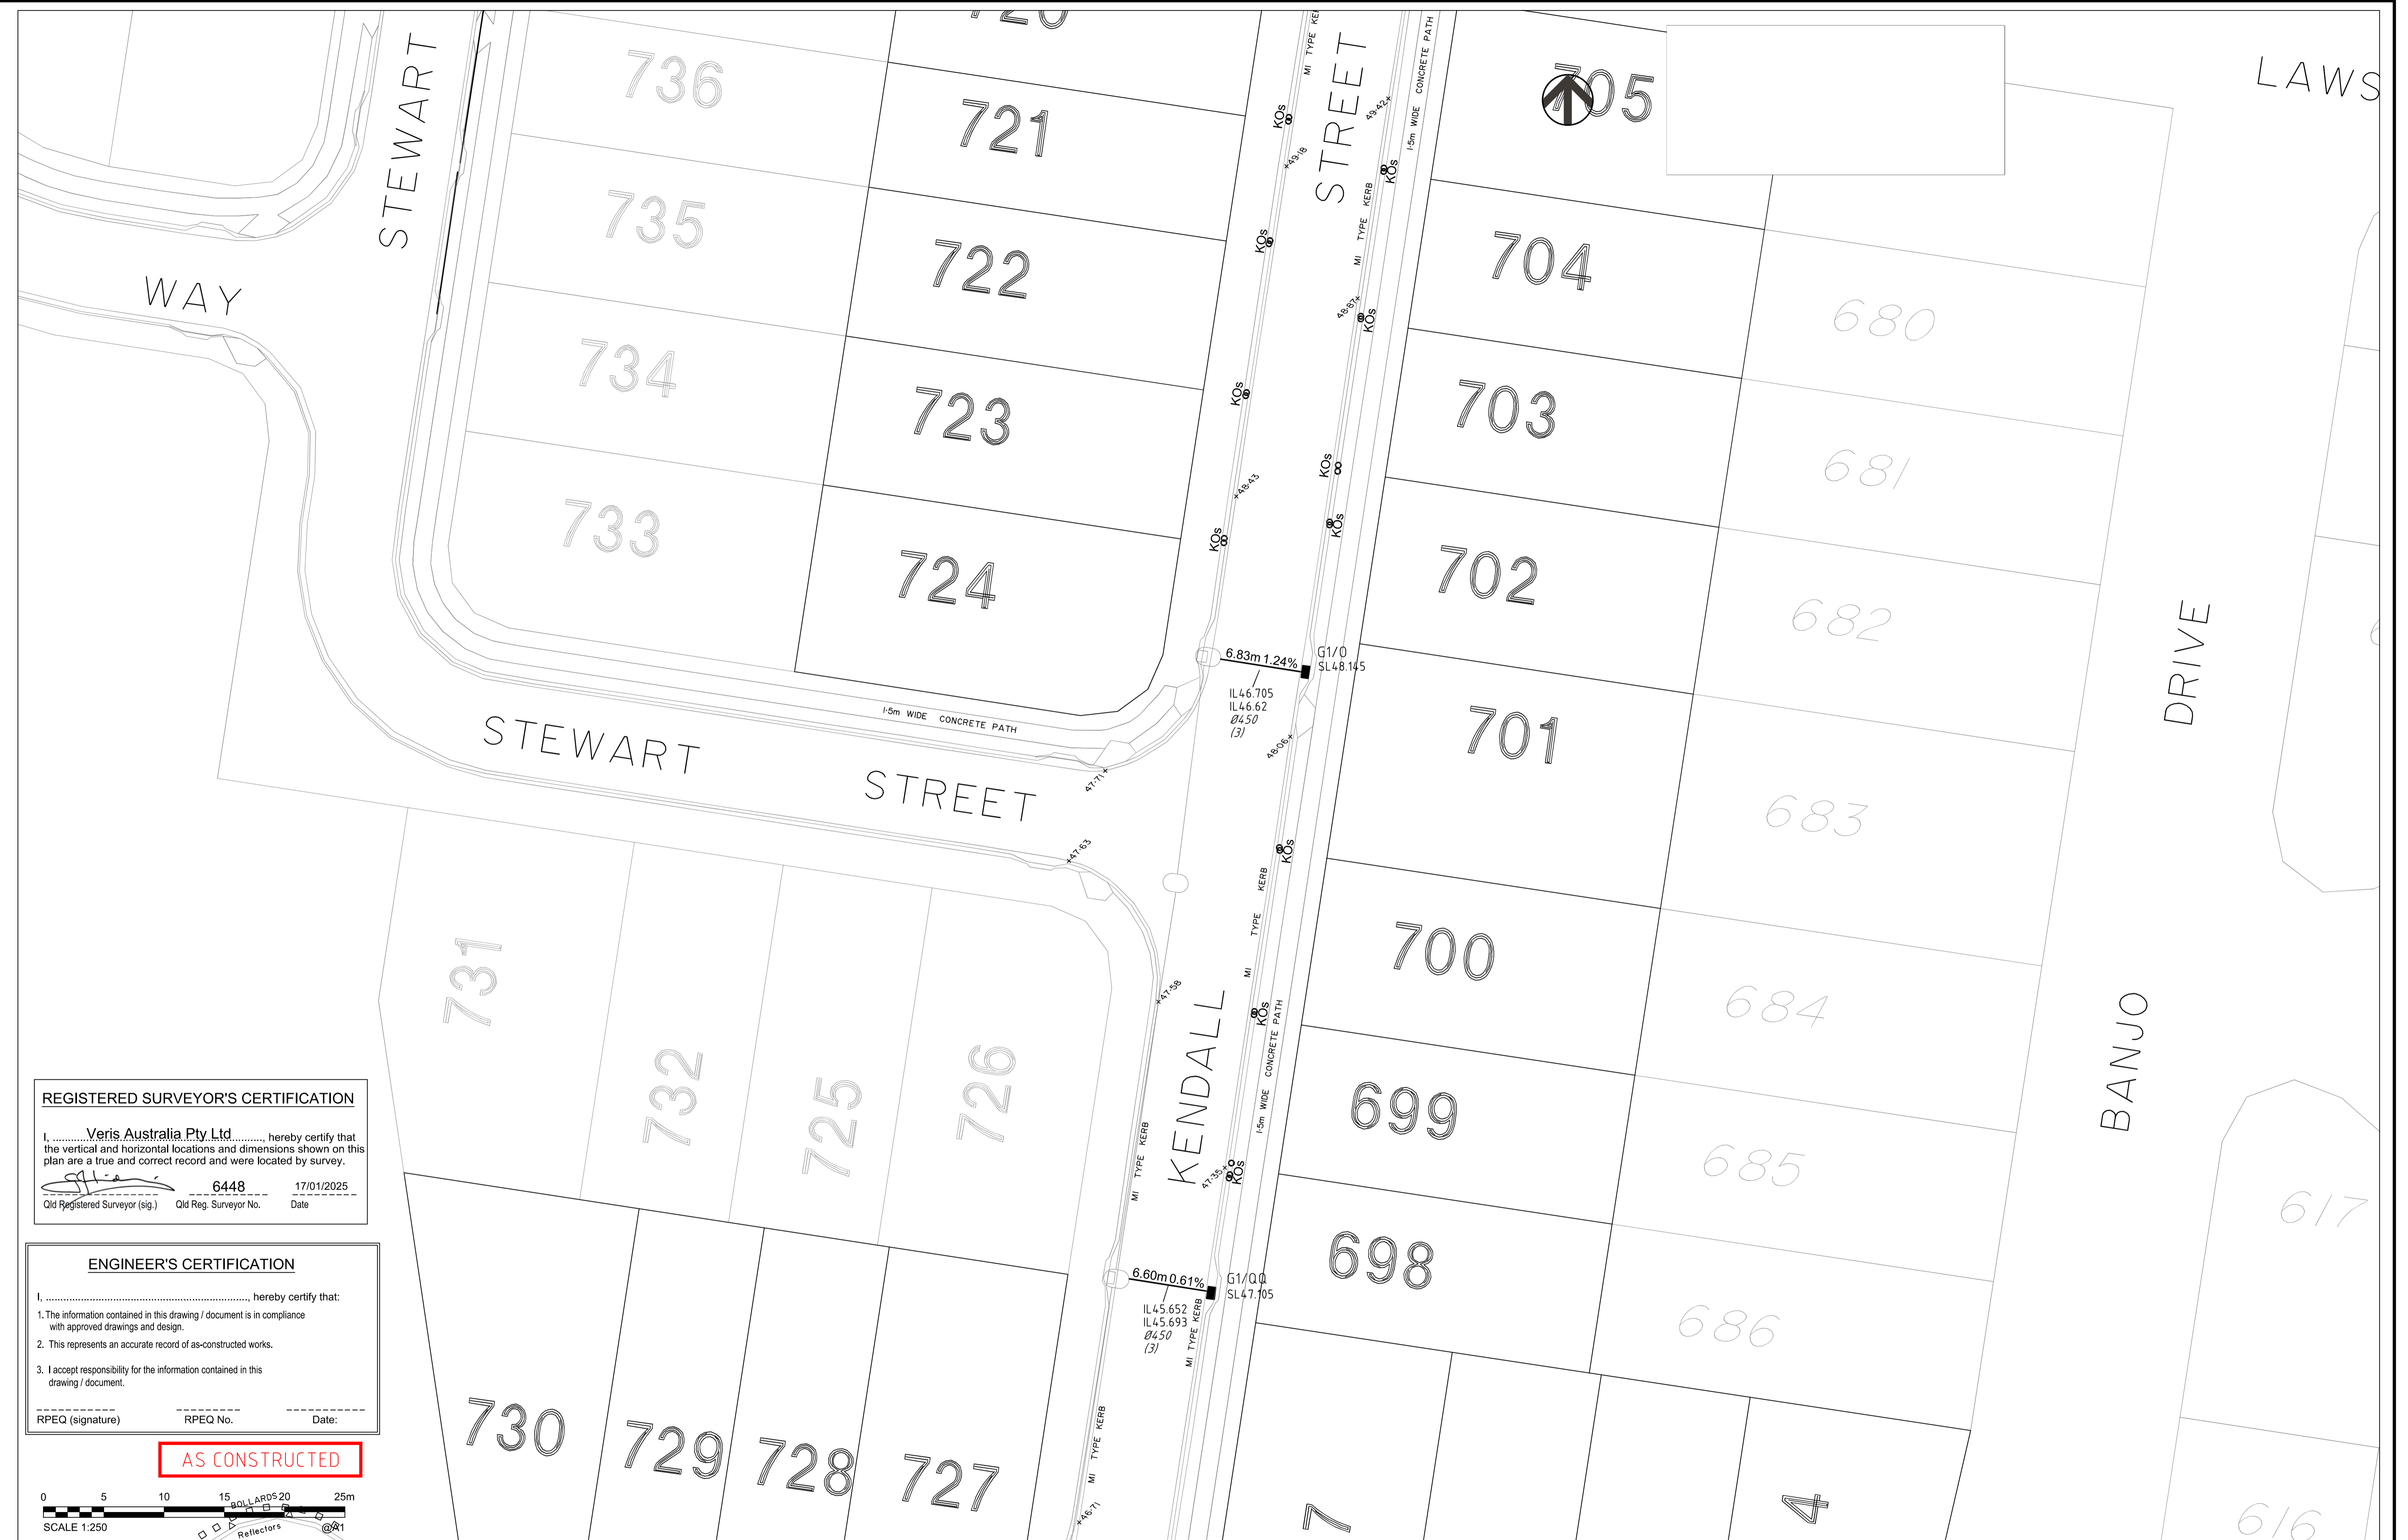

**REGISTERED SURVEYOR'S CERTIFICATION**  
 I, Veris Australia Pty Ltd, hereby certify that the vertical and horizontal locations and dimensions shown on this plan are a true and correct record and were located by survey.  
 Old Registered Surveyor (sig.) [Signature] 6448 17/01/2025  
 Old Reg. Surveyor No. Date

**ENGINEER'S CERTIFICATION**  
 I, \_\_\_\_\_, hereby certify that:  
 1. The information contained in this drawing / document is in compliance with approved drawings and design.  
 2. This represents an accurate record of as-constructed works.  
 3. I accept responsibility for the information contained in this drawing / document.  
 RPEQ (signature) \_\_\_\_\_ RPEQ No. \_\_\_\_\_ Date: \_\_\_\_\_

**AS CONSTRUCTED**

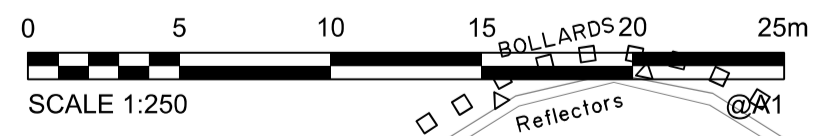

**A1**

E	15/01/2025	INCLUDE TEMP TURNAROUND	JMc		
D	29/11/2024	PROGRESS PLOT	JMc		
C	29/10/2024	PROGRESS PLOT	JMc		
B	08/10/2024	PROGRESS PLOT	JMc		
A	23/09/2024	PROGRESS PLOT	JMc		
INDEX	DATE	REVISIONS	DRAWN	CHECKED	PASSED


DRAWN	JMc	18/09/2024
CHECKED		
PASSED		
INITIALS		DATE

**veris**  
 BRISBANE (07) 3666 4700 WHITSUNDAYS (07) 4945 6600  
 MACKAY (07) 4957 9100 CAIRNS (07) 4522 9600  
 veris.com.au  
 ACN 615 735 727  
 Veris Australia Pty Ltd




**IPSWICH CITY COUNCIL**  
 WATERLEA WALLOON STAGE 6E  
 AS CONSTRUCTED  
 DRAINAGE

SCALE	1:250 @A1
SHEET	2 OF 4 SHEETS
DRAWING NO.	401905-6E-ASW01
E	
D	
C	
B	
A	

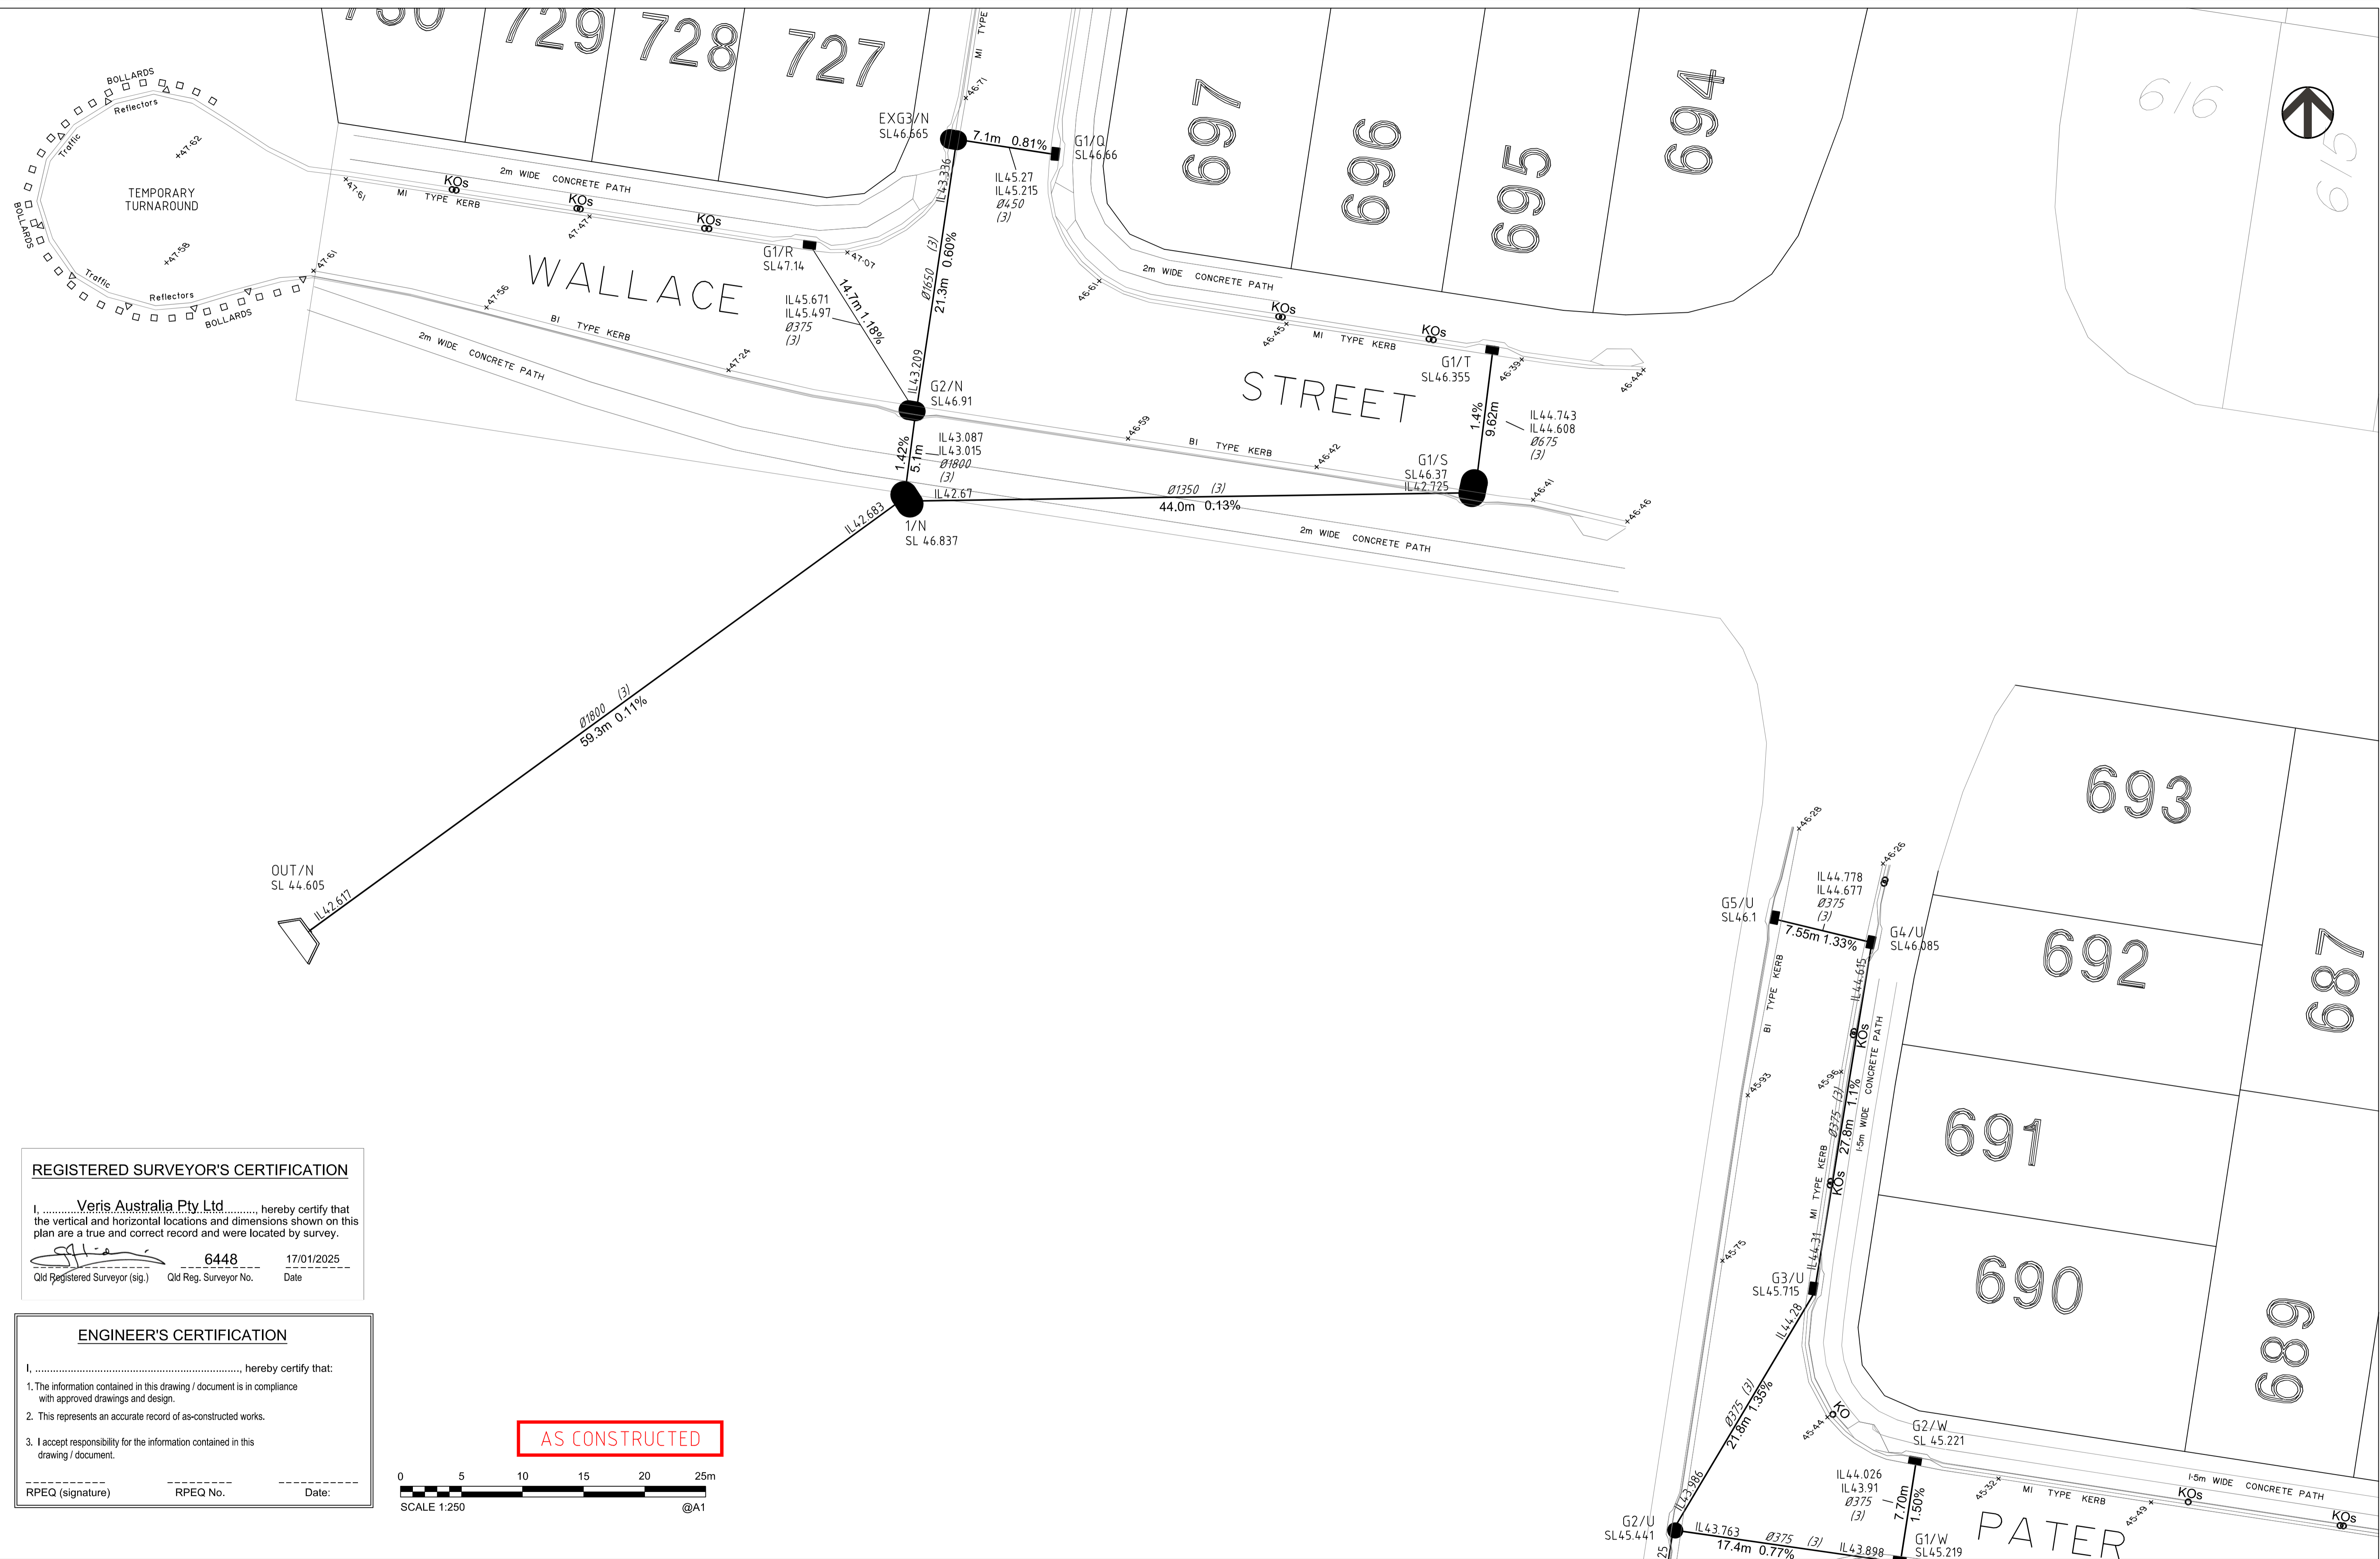

**REGISTERED SURVEYOR'S CERTIFICATION**

I, **Veris Australia Pty Ltd**, hereby certify that the vertical and horizontal locations and dimensions shown on this plan are a true and correct record and were located by survey.

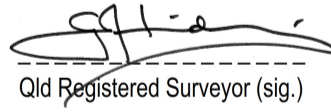
6448
17/01/2025  
Old Registered Surveyor (sig.) Old Reg. Surveyor No. Date


**ENGINEER'S CERTIFICATION**

I, \_\_\_\_\_, hereby certify that:

- The information contained in this drawing / document is in compliance with approved drawings and design.
- This represents an accurate record of as-constructed works.
- I accept responsibility for the information contained in this drawing / document.

RPEQ (signature) \_\_\_\_\_ RPEQ No. \_\_\_\_\_ Date: \_\_\_\_\_

AS CONSTRUCTED

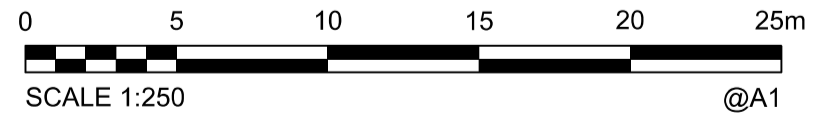

A1

INDEX	DATE	REVISIONS	DRAWN	CHECKED	PASSED
E	15/01/2025	INCLUDE TEMP TURNAROUND	JMc		
D	29/11/2024	PROGRESS PLOT	JMc		
C	29/10/2024	PROGRESS PLOT	JMc		
B	08/10/2024	PROGRESS PLOT	JMc		
A	23/09/2024	PROGRESS PLOT	JMc		

DRAWN	JMc	18/09/2024
CHECKED		
PASSED		
INITIALS		DATE



BRISBANE (07) 3860 4700 WHITSUNDAYS (07) 4945 0500  
 MACKAY (07) 4887 9100 CAIRNS (07) 4232 3400  
 veris.com.au  
 ACN 615 735 727  
 Veris Australia Pty Ltd




**IPSWICH CITY COUNCIL**

WATERLEA WALLOON STAGE 6E  
 AS CONSTRUCTED  
 DRAINAGE

SCALE	1:250 @A1
SHEET	3 OF 4 SHEETS
DRAWING NO.	401905-6E-ASW01

E  
D  
C  
B  
A

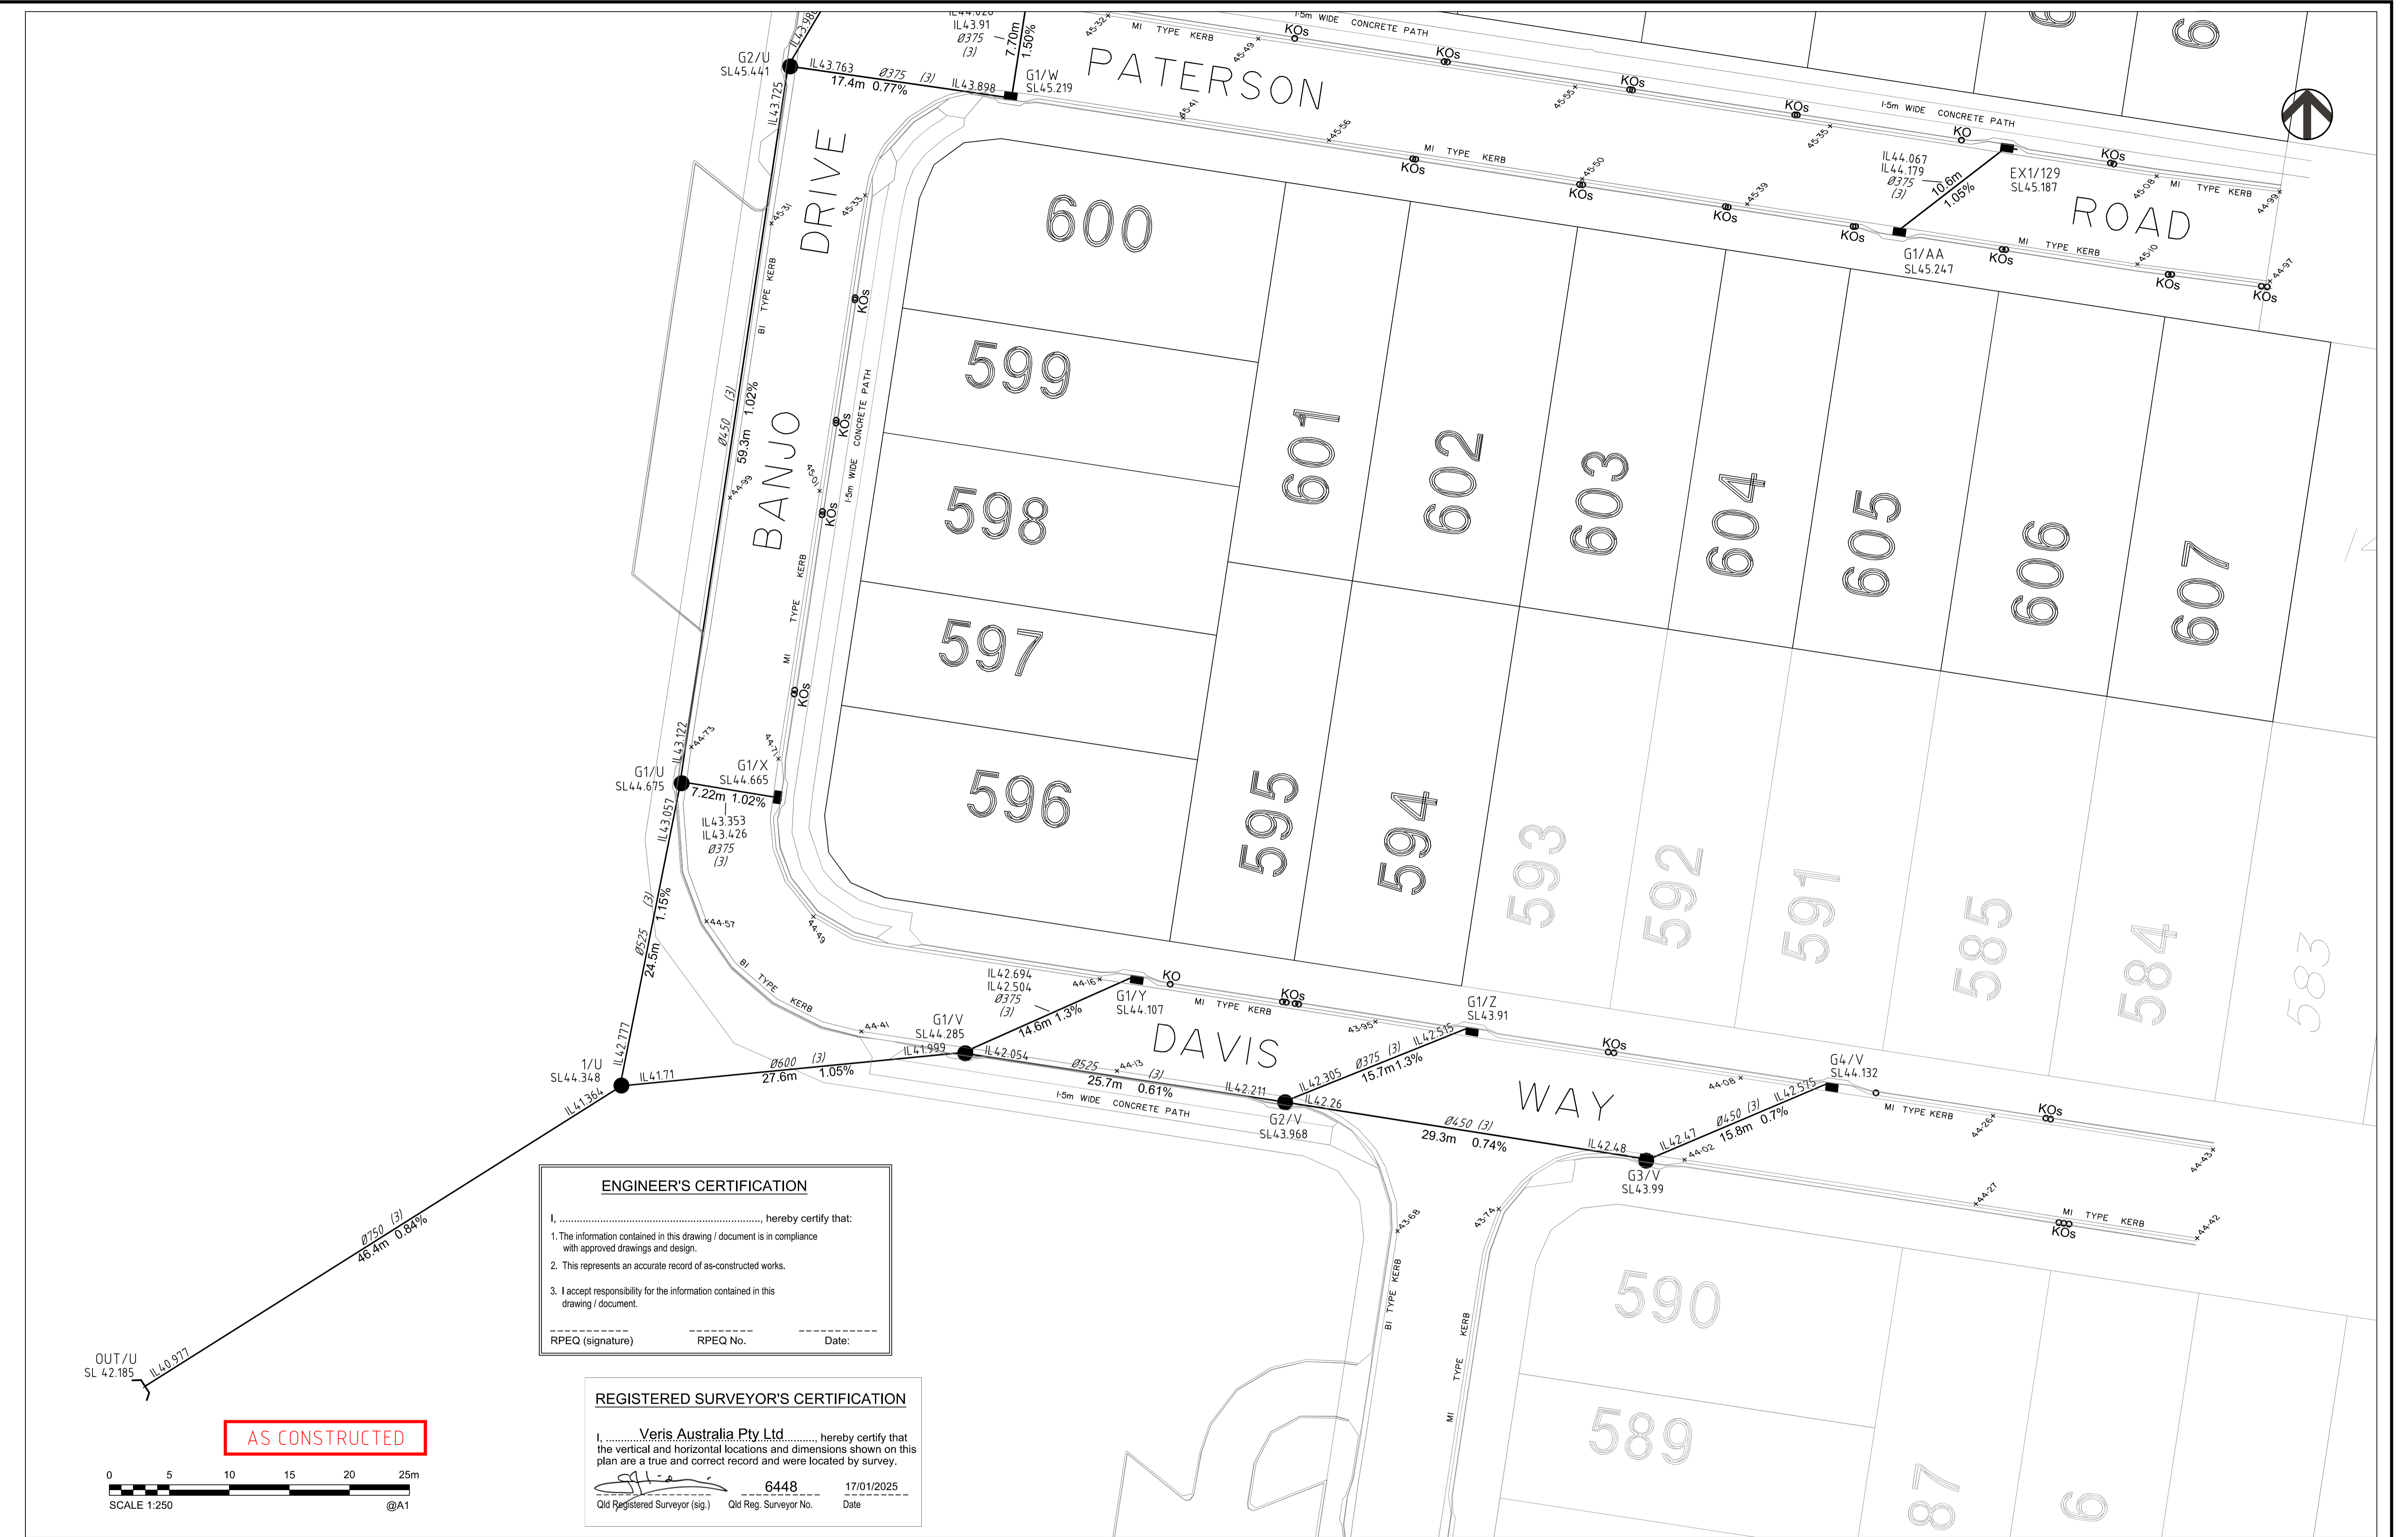

**ENGINEER'S CERTIFICATION**


I, \_\_\_\_\_, hereby certify that:

- The information contained in this drawing / document is in compliance with approved drawings and design.
- This represents an accurate record of as-constructed works.
- I accept responsibility for the information contained in this drawing / document.


\_\_\_\_\_  
RPEQ (signature)      RPEQ No.      Date:

**REGISTERED SURVEYOR'S CERTIFICATION**

I, **Veris Australia Pty Ltd**, hereby certify that the vertical and horizontal locations and dimensions shown on this plan are a true and correct record and were located by survey.

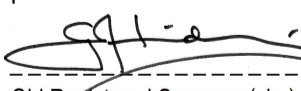      **6448**      17/01/2025  
Old Registered Surveyor (sig.)      Old Reg. Surveyor No.      Date

**AS CONSTRUCTED**

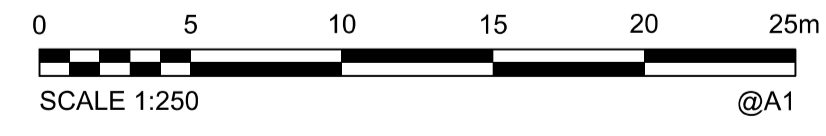

**A1**

E	15/01/2025	INCLUDE TEMP TURNAROUND	JMc		
D	29/11/2024	PROGRESS PLOT	JMc		
C	29/10/2024	PROGRESS PLOT	JMc		
B	08/10/2024	PROGRESS PLOT	JMc		
A	23/09/2024	PROGRESS PLOT	JMc		
INDEX	DATE	REVISIONS	DRAWN	CHECKED	PASSED

DRAWN	JMc	18/09/2024
CHECKED		
PASSED		
INITIALS		DATE

**veris**

BRISBANE (07) 3860 4700      WHITSUNDAYS (07) 4945 0500  
 MACKAY (07) 4887 9100      CAIRNS (07) 4332 3400  
 veris.com.au  
 ACN 615 735 727  
 Veris Australia Pty Ltd



**IPSWICH CITY COUNCIL**

WATERLEA WALLOON STAGE 6E  
AS CONSTRUCTED  
DRAINAGE

SCALE	1:250 @A1
SHEET	4 OF 4 SHEETS
DRAWING NO.	401905-6E-ASW01
	E D C B A