

**LEGEND**

42.5 — AS CONSTRUCTED CONTOURS  
(Interval 0.25m)

43 — CHANGE OF GRADE

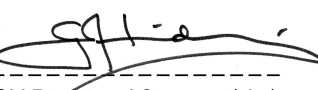
Top of Bank

Bottom of Bank

RETAINING WALL

**REGISTERED SURVEYOR'S CERTIFICATION**

I, **Veris Australia Pty Ltd**, hereby certify that the vertical and horizontal locations and dimensions shown on this plan are a true and correct record and were located by survey.

 **6448** **10/02/2025**

Old Registered Surveyor (sig.) Old Reg. Surveyor No. Date

**ENGINEER'S CERTIFICATION**

I, \_\_\_\_\_, hereby certify that:

1. The information contained in this drawing / document is in compliance with approved drawings and design.

2. This represents an accurate record of as-constructed works.

3. I accept responsibility for the information contained in this drawing / document.

RPEQ (signature) RPEQ No. Date:

**AS CONSTRUCTED**

0 15 30 45 60 75m

SCALE 1:750 @A1

A1

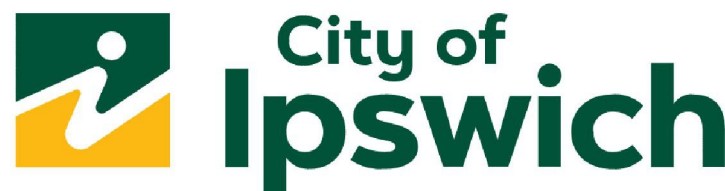
B	31/01/2025	FINAL	JMc		
A	04/12/2024	PROGRESS PLOT	JMc		
INDEX	DATE	REVISIONS	DRAWN	CHECKED	PASSED

DRAWN	JMc	04/12/2024
CHECKED		
PASSED		
INITIALS	DATE	



BRISBANE (07) 3699 4700  
MACKAY (07) 5487 8700  
veris.com.au  
ACN 615 735 727  
Veris Australia Pty Ltd

WHITSUNDAYS (07) 4945 8800  
CAIRNS (07) 4202 5400



IPSWICH CITY COUNCIL

WATERLEA WALLOON STAGE 6D  
AS CONSTRUCTED  
EARTHWORKS

SCALE	1:1000 @A1
SHEET	1 OF 5 SHEETS
DRAWING NO.	401905-6D-AEW01
B	
A	





LEGEND	
42.5	AS CONSTRUCTED CONTOURS
43	(Interval 0.25m)
Top of Bank	CHANGE OF GRADE
Bottom of Bank	
Retaining Wall	RETAINING WALL

REGISTERED SURVEYOR'S CERTIFICATION

I, **Veris Australia Pty Ltd**, hereby certify that the vertical and horizontal locations and dimensions shown on this plan are a true and correct record and were located by survey.

*[Signature]* **6448** 10/02/2025  
Old Registered Surveyor (sig.) Old Reg. Surveyor No. Date

ENGINEER'S CERTIFICATION

I, \_\_\_\_\_, hereby certify that:

1. The information contained in this drawing / document is in compliance with approved drawings and design.

2. This represents an accurate record of as-constructed works.

3. I accept responsibility for the information contained in this drawing / document.

RPEQ (signature) RPEQ No. Date:

AS CONSTRUCTED



A1

INDEX	DATE	REVISIONS	DRAWN	CHECKED	PASSED
B	31/01/2025	FINAL	JMc		
A	04/12/2024	PROGRESS PLOT	JMc		

DRAWN	CHECKED	PASSED	INITIALS	DATE
JMc				04/12/2024



BRISBANE (07) 3666 4700 WHITSUNDAYS (07) 4945 6600  
MACKAY (07) 4657 7000 CAIRNS (07) 4552 9400  
veris.com.au  
ACN 615 735 727  
Veris Australia Pty Ltd



IPSWICH CITY COUNCIL

WATERLEA WALLOON STAGE 6D  
AS CONSTRUCTED  
EARTHWORKS

SCALE 1:250 @A1	SHEET 2 OF 5 SHEETS
DRAWING NO.	
401905-6D-AEW01	





**LEGEND**

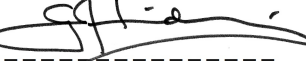
42.5 — AS CONSTRUCTED CONTOURS  
43 — (Interval 0.25m)

Top of Bank — CHANGE OF GRADE  
Bottom of Bank —

— RETAINING WALL

REGISTERED SURVEYOR'S CERTIFICATION

I, **Veris Australia Pty Ltd**, hereby certify that the vertical and horizontal locations and dimensions shown on this plan are a true and correct record and were located by survey.

 **6448** **10/02/2025**  
Old Registered Surveyor (sig.) Old Reg. Surveyor No. Date

ENGINEER'S CERTIFICATION

I, \_\_\_\_\_, hereby certify that:

- The information contained in this drawing / document is in compliance with approved drawings and design.
- This represents an accurate record of as-constructed works.
- I accept responsibility for the information contained in this drawing / document.

RPEQ (signature) RPEQ No. Date:

AS CONSTRUCTED



A1

B	31/01/2025	FINAL	JMc		
A	04/12/2024	PROGRESS PLOT	JMc		
INDEX	DATE	REVISIONS	DRAWN	CHECKED	PASSED

DRAWN	JMc	04/12/2024
CHECKED		
PASSED		
INITIALS	DATE	



BRISBANE (07) 3888 4700 WHITSUNDAYS (07) 4945 8800  
MACKAY (07) 5487 8700 CAIRNS (07) 4202 3400  
veris.com.au  
ACN 616 736 727  
Veris Australia Pty Ltd



IPSWICH CITY COUNCIL

WATERLEA WALLOON STAGE 6D  
AS CONSTRUCTED  
EARTHWORKS

SCALE 1:250 @A1

SHEET 3 OF 5 SHEETS

DRAWING NO.

401905-6D-AEW01

B  
A







