

REGISTERED SURVEYOR'S CERTIFICATION

I, Veris Australia Pty Ltd, hereby certify that the vertical and horizontal locations and dimensions shown on this plan are a true and correct record and were located by survey.

[Signature] 6448 10/02/2025
Old Registered Surveyor (sig.) Old Reg. Surveyor No. Date

ENGINEER'S CERTIFICATION

I, _____, hereby certify that:

1. The information contained in this drawing / document is in compliance with approved drawings and design.

2. The new water and sewerage works defined by this drawing have been designed and constructed in accordance with the SEQ Code.

3. This represents an accurate record of as-constructed works.

4. I accept responsibility for the information contained in this drawing / document.

RPEQ (signature) RPEQ No. Date:

LEGEND

SEWER MAIN

SEWER HOUSE CONNECTION

SEWER HOUSE CONNECTION

SEWER MAINTENANCE HOLE (INSITU)


SEWER MAINTENANCE SHAFT

SEWER END OF LINE

EXISTING SEWER MAINTENANCE SHAFT

58.19#

DESIGN LEVEL

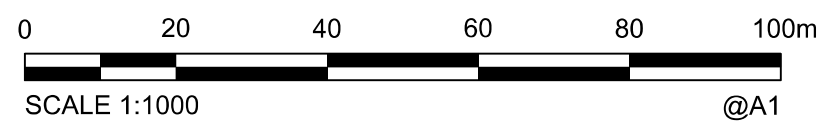

A1

D	TBD	PROGRESS PLOT AS CON SEWER	JMc						
C	13/01/2025	PROGRESS PLOT AS CON SEWER	JMc			DRAWN	JMc	08/10/2024	
B	28/11/2024	PROGRESS PLOT AS CON SEWER	JMc			CHECKED			
A	08/10/2024	PROGRESS PLOT AS CON SEWER	JMc			APPROVED			
REV NO	DATE	REVISION PURPOSE / DESCRIPTION	DRAWN	RPEQ	RPEQ No	INITIALS	DATE		

BRISBANE (07) 3665 4700
MACKAY (07) 4957 9700
WHITSUNDAYS (07) 4945 6600
CAIRNS (07) 4052 9400
veris.com.au
ACN 615 735 727
Veris Australia Pty Ltd



DAWN WALLOON
Banjo Drive Walloon

STAGE 6D
AS CONSTRUCTED SEWER

DRAWING STATUS AS CONSTRUCTED	
SHEET 1 OF 5 SHEETS	
DRAWING NO. 401905-6D-AS01	REV. D


**veris**

QUEENSLAND
UrbanUtilities

DRAWING STATUS
AS CONSTRUCTED

SHEET 2 OF 5 SHEETS

DRAWING NO. 401905-6D-AS01	R
--------------------------------------	---

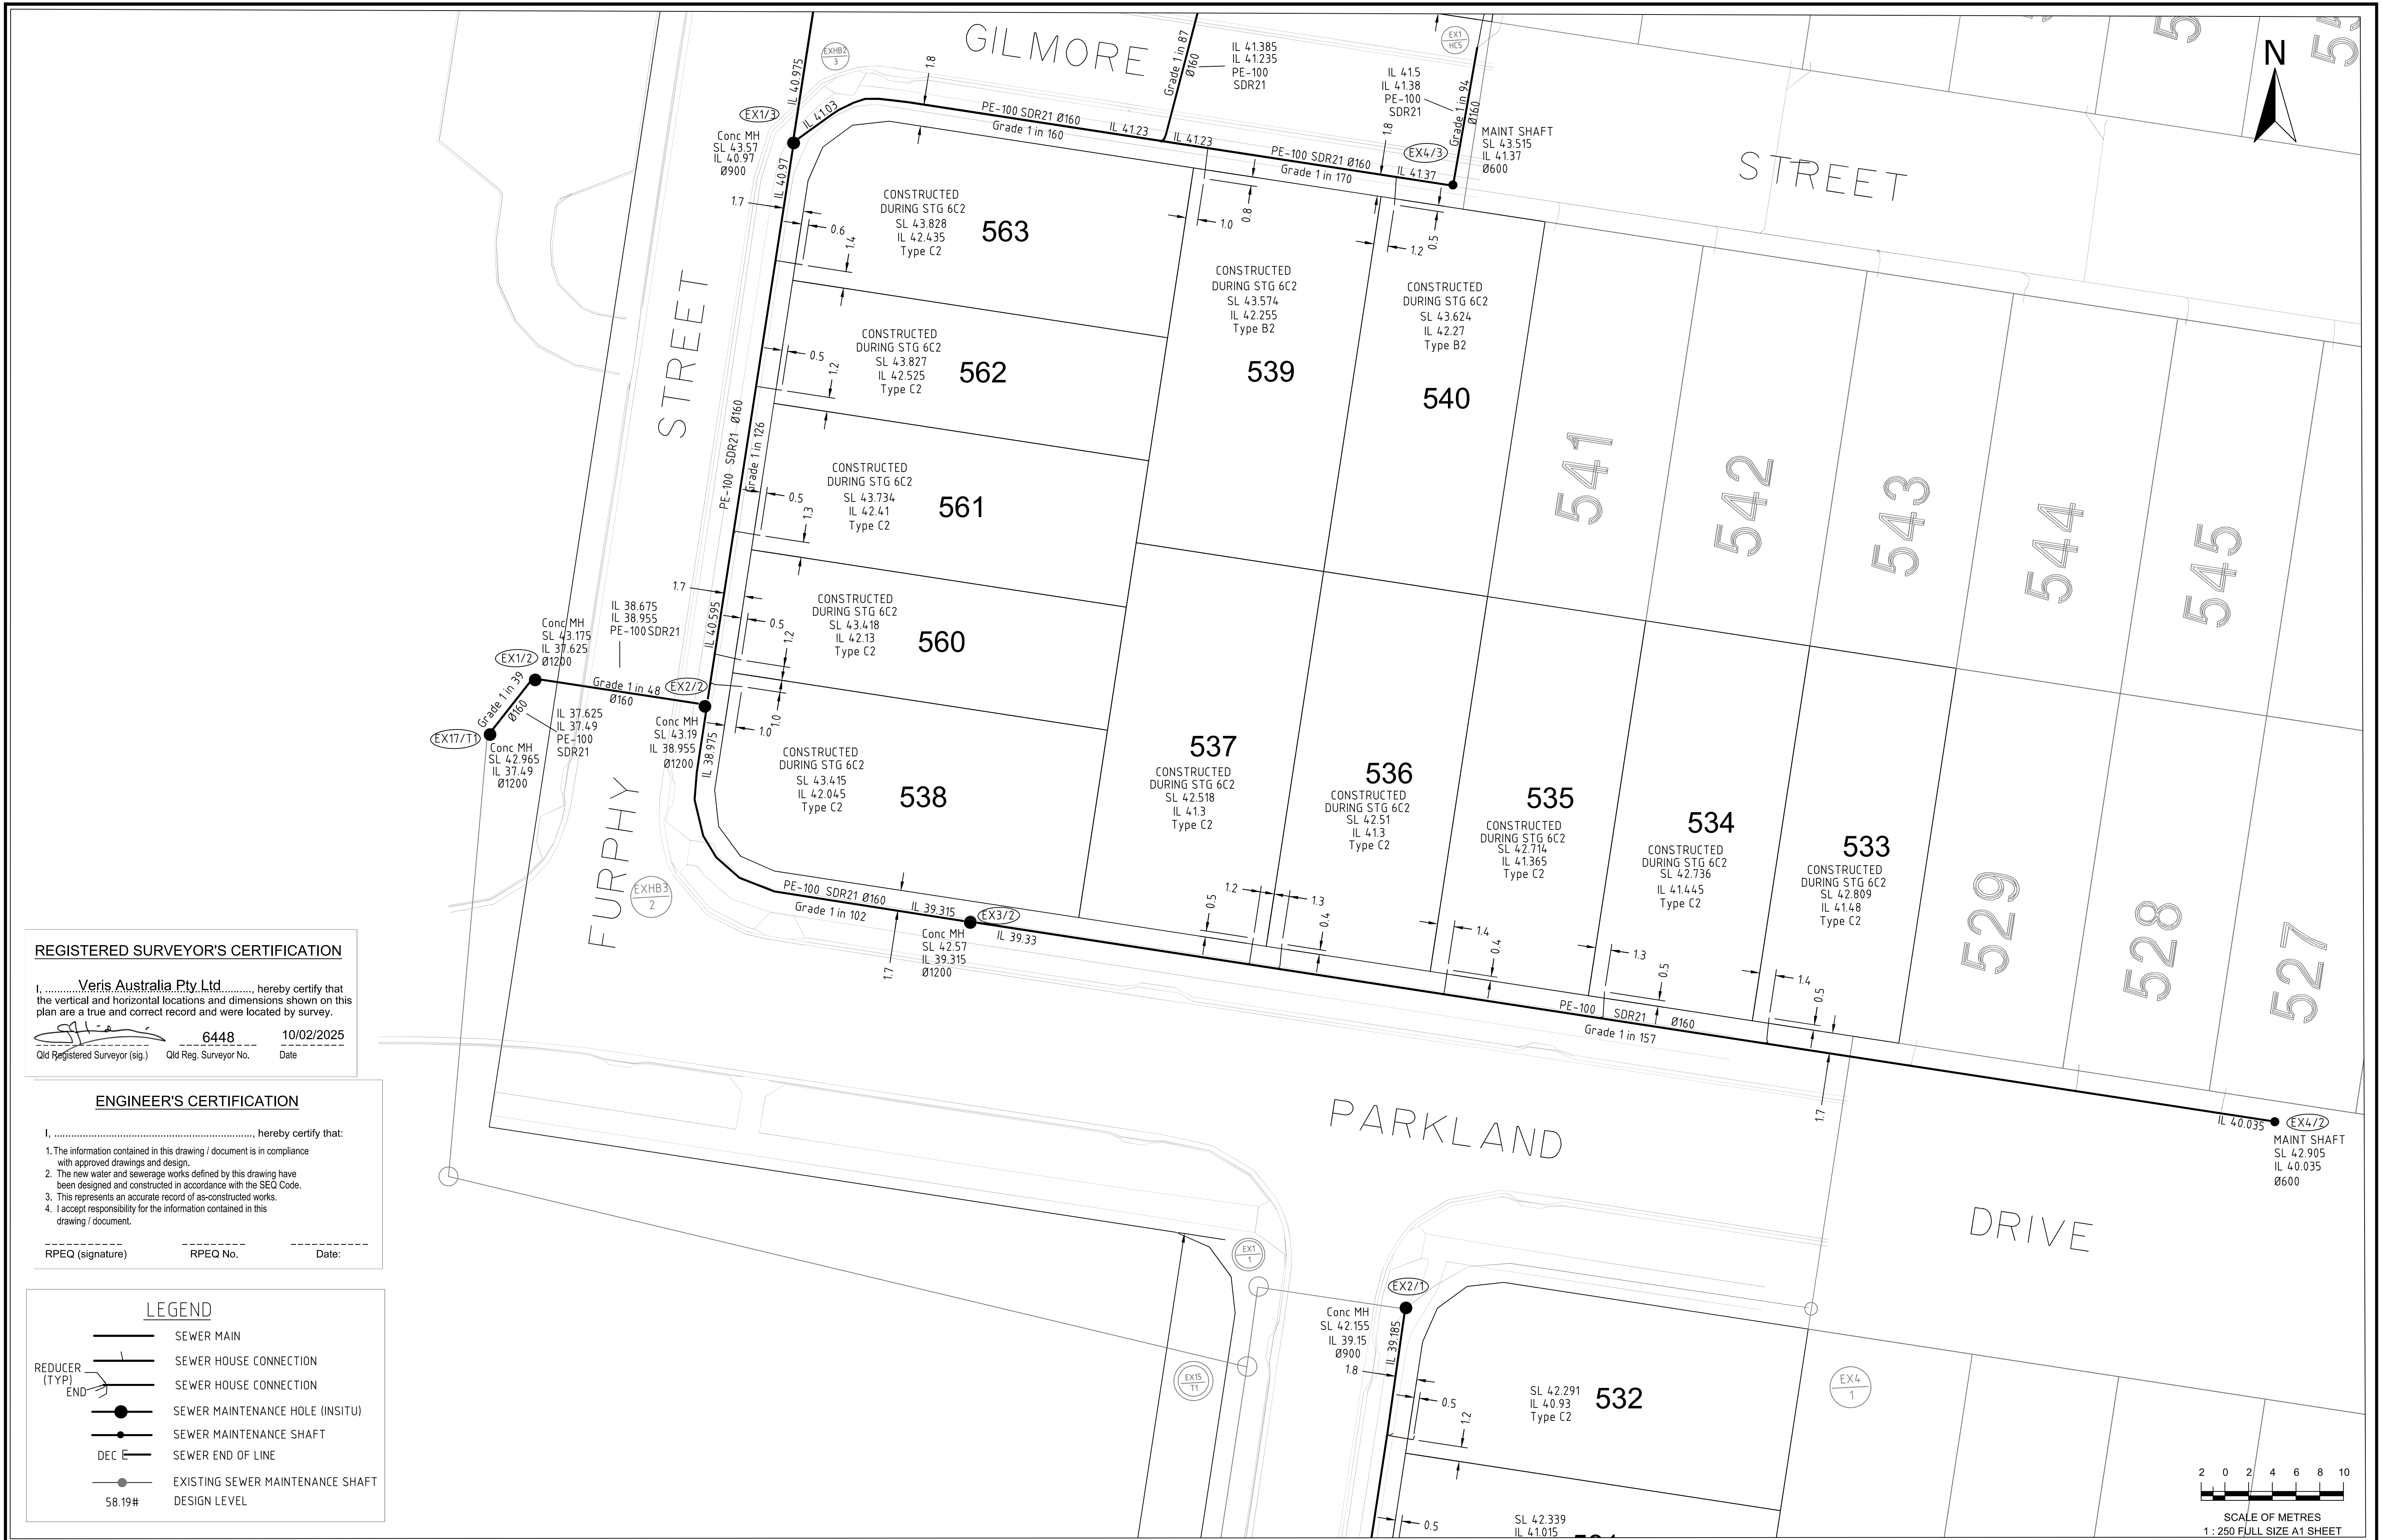

REGISTERED SURVEYOR'S CERTIFICATION

I, **Veris Australia Pty Ltd**, hereby certify that the vertical and horizontal locations and dimensions shown on this plan are a true and correct record and were located by survey.

[Signature] **6448** **10/02/2025**
Old Registered Surveyor (sig.) Old Reg. Surveyor No. Date

ENGINEER'S CERTIFICATION

I, _____, hereby certify that:

- The information contained in this drawing / document is in compliance with approved drawings and design.
- The new water and sewerage works defined by this drawing have been designed and constructed in accordance with the SEQ Code.
- This represents an accurate record of as-constructed works.
- I accept responsibility for the information contained in this drawing / document.

RPEQ (signature) RPEQ No. Date:

LEGEND

- SEWER MAIN
- SEWER HOUSE CONNECTION
- SEWER HOUSE CONNECTION
- SEWER MAINTENANCE HOLE (INSITU)
- SEWER MAINTENANCE SHAFT
- SEWER END OF LINE
- EXISTING SEWER MAINTENANCE SHAFT
- DESIGN LEVEL

A1

D	TBD	PROGRESS PLOT AS CON SEWER	JMc					
C	13/01/2025	PROGRESS PLOT AS CON SEWER	JMc			DRAWN	JMc	08/10/2024
B	28/11/2024	PROGRESS PLOT AS CON SEWER	JMc			CHECKED		
A	08/10/2024	PROGRESS PLOT AS CON SEWER	JMc			APPROVED		
REV NO	DATE	REVISION PURPOSE / DESCRIPTION	DRAWN	RPEQ	RPEQ No	INITIALS	DATE	

veris

BRISBANE
(07) 3665 4700
MACKAY
(07) 4957 9700
WHITSUNDAYS
(07) 4945 6600
CAIRNS
(07) 4052 9400
veris.com.au
ACN 615 735 727
Veris Australia Pty Ltd



DAWN WALLOON
Banjo Drive Walloon

STAGE 6D
AS CONSTRUCTED SEWER

DRAWING STATUS
AS CONSTRUCTED


SHEET 3 OF 5 SHEETS

DRAWING NO.

401905-6D-AS01

REV.

D

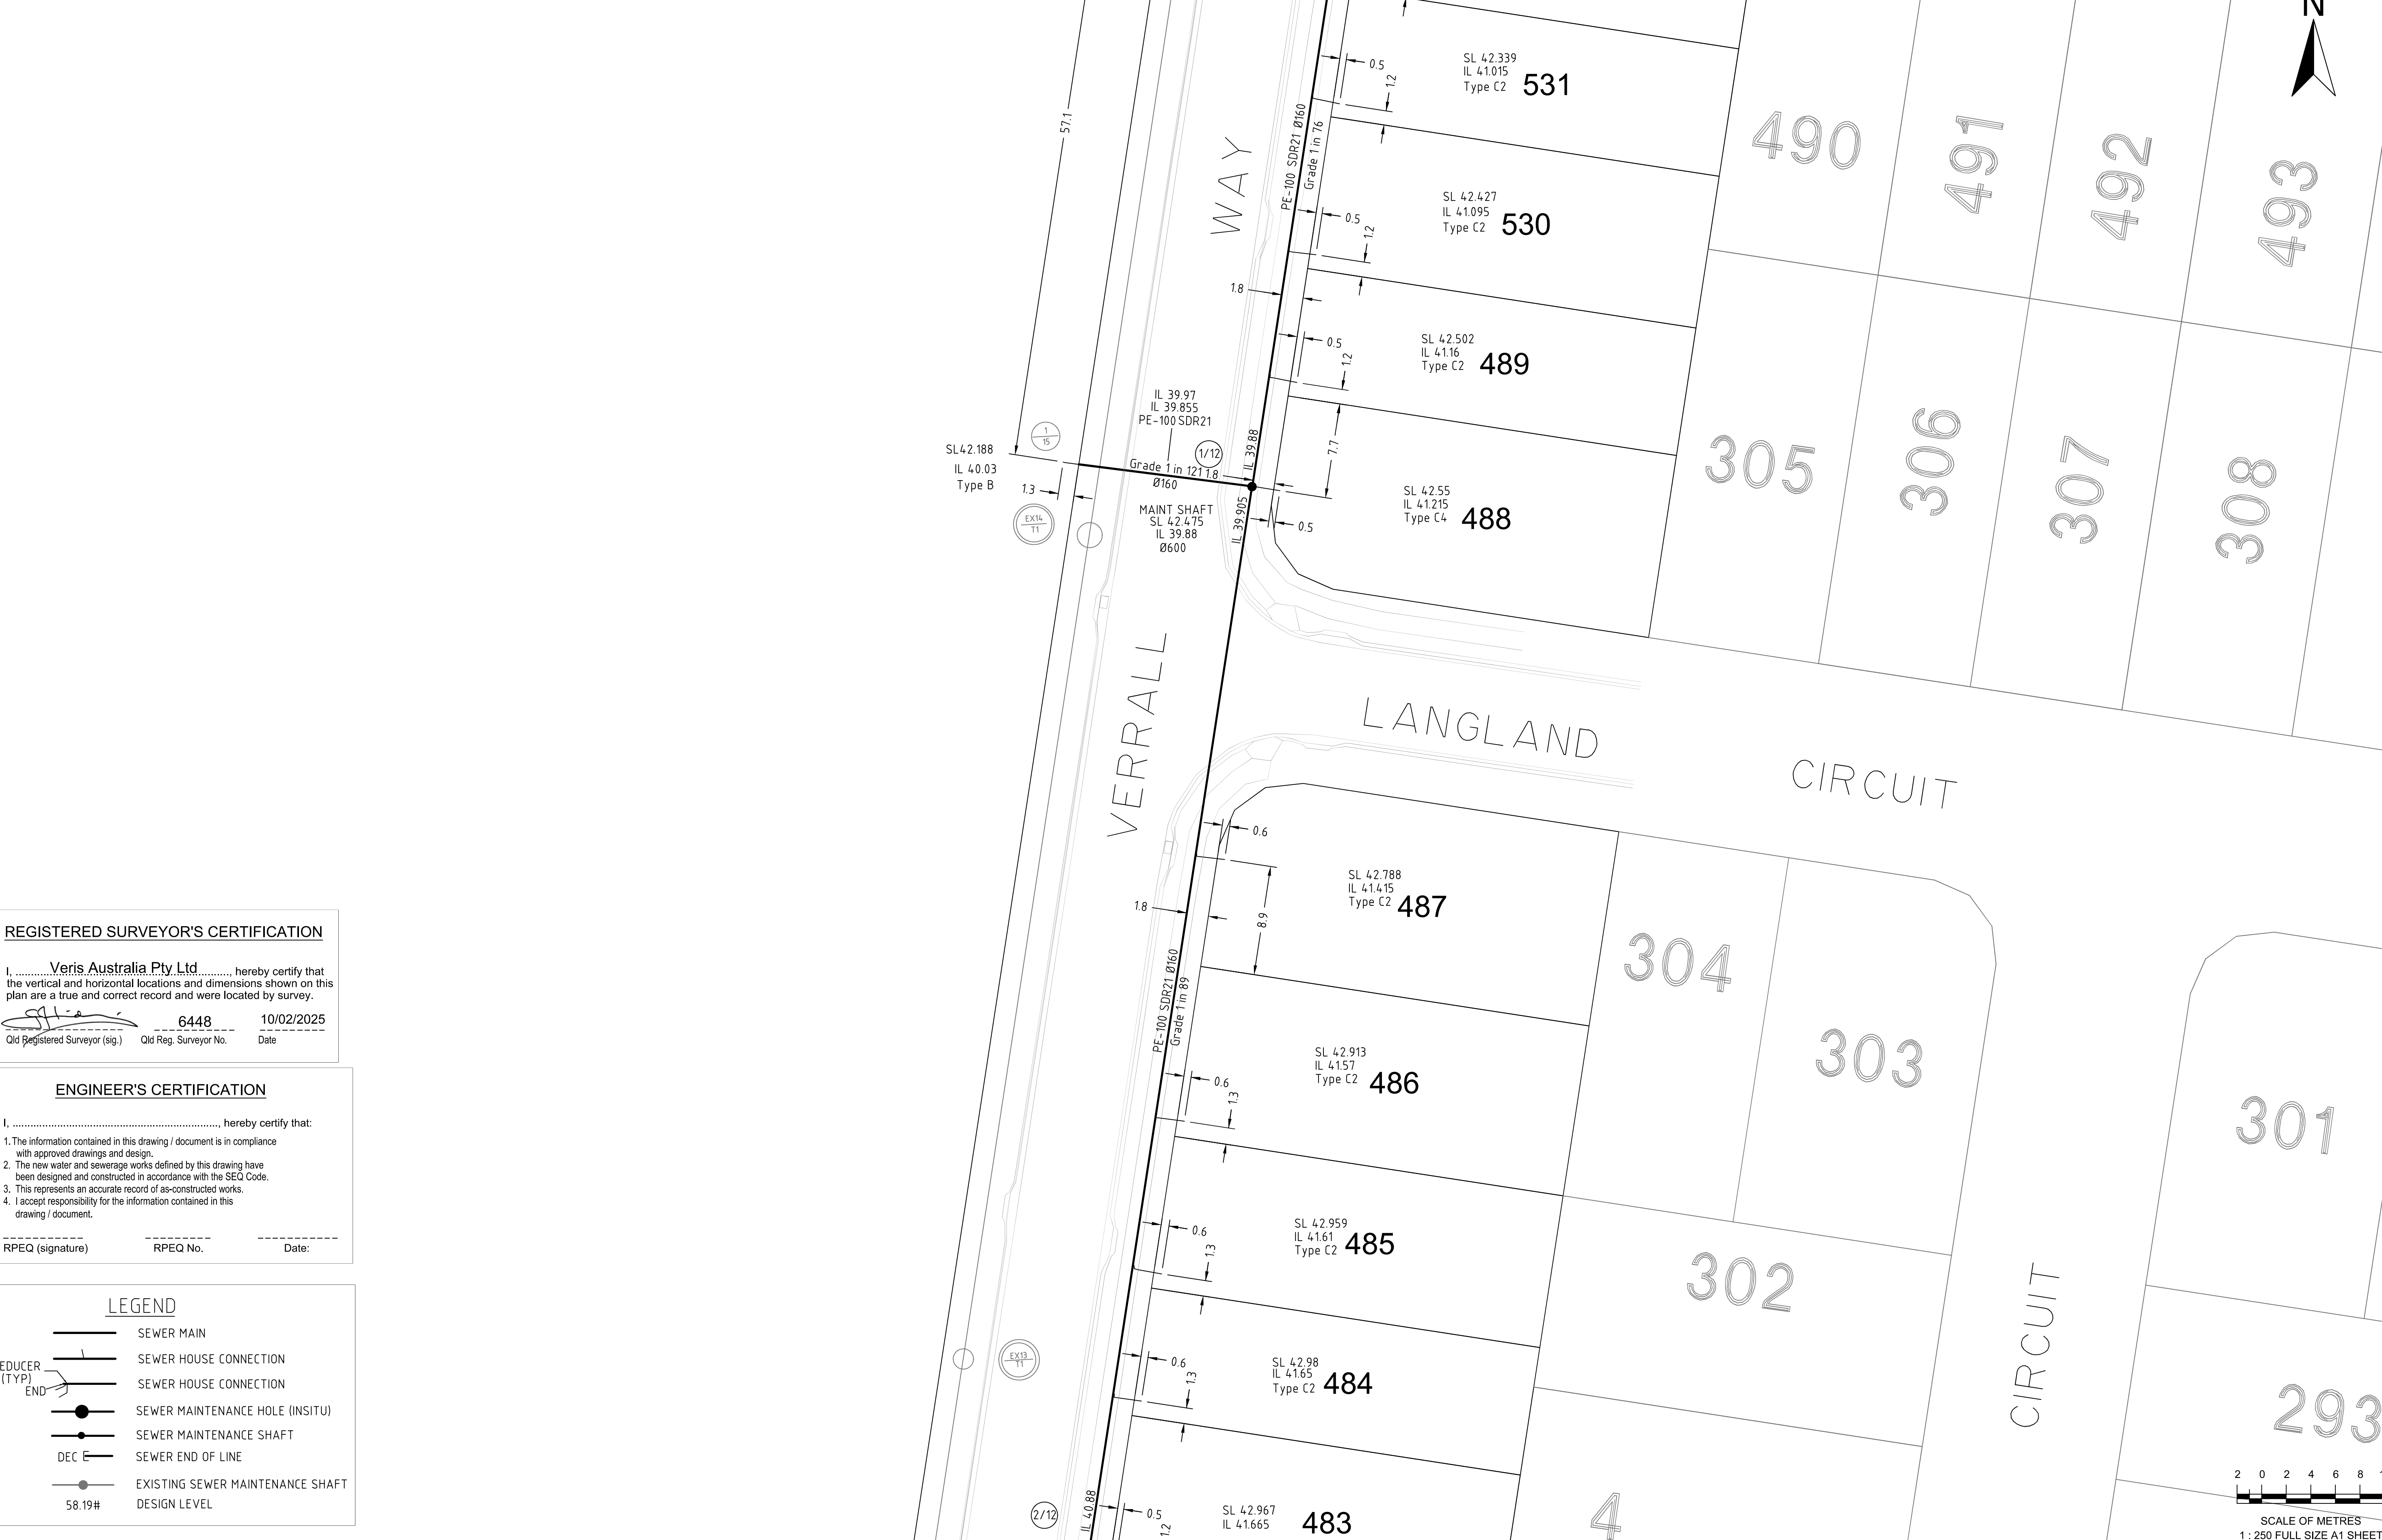

REGISTERED SURVEYOR'S CERTIFICATION

I, Veris Australia Pty Ltd, hereby certify that the vertical and horizontal locations and dimensions shown on this plan are a true and correct record and were located by survey.

[Signature] 6448 10/02/2025
Old Registered Surveyor (sig.) Old Reg. Surveyor No. Date

ENGINEER'S CERTIFICATION

I, _____, hereby certify that:

- The information contained in this drawing / document is in compliance with approved drawings and design.
- The new water and sewerage works defined by this drawing have been designed and constructed in accordance with the SEQ Code.
- This represents an accurate record of as-constructed works.
- I accept responsibility for the information contained in this drawing / document.

RPEQ (signature) RPEQ No. Date:

LEGEND

- SEWER MAIN
- SEWER HOUSE CONNECTION
- SEWER HOUSE CONNECTION
- SEWER MAINTENANCE HOLE (INSITU)
- SEWER MAINTENANCE SHAFT
- SEWER END OF LINE
- EXISTING SEWER MAINTENANCE SHAFT
- DESIGN LEVEL

A1	D	TBD	PROGRESS PLOT AS CON SEWER	JMc							<div><div>BRISBANE (07) 3666 4700</div><div>WHITSUNDAYS (07) 4945 6600</div><div>MACKAY (07) 4957 9700</div><div>CAIRNS (07) 4052 9400</div><div>veris.com.au</div><div>ACN 615 735 727</div><div>Veris Australia Pty Ltd</div></div>	<div><div>QUEENSLAND</div><div>UrbanUtilities</div></div>	DAWN WALLOON Banjo Drive Walloon		DRAWING STATUS AS CONSTRUCTED	
	C	13/01/2025	PROGRESS PLOT AS CON SEWER	JMc			DRAWN	JMc	08/10/2024	SHEET 4 OF 5 SHEETS						
	B	28/11/2024	PROGRESS PLOT AS CON SEWER	JM			CHECKED			DRAWING NO.						
	A	08/10/2024	PROGRESS PLOT AS CON SEWER	JMc			APPROVED			401905-6D-AS01						
	REV NO	DATE	REVISION PURPOSE / DESCRIPTION			DRAWN	RPEQ	RPEQ No		INITIALS			DATE	REV. D		

REGISTERED SURVEYOR'S CERTIFICATION

I, Veris Australia Pty Ltd, hereby certify that the vertical and horizontal locations and dimensions shown on this plan are a true and correct record and were located by survey.

[Signature] 6448 10/02/2025
Old Registered Surveyor (sig.) Old Reg. Surveyor No. Date

ENGINEER'S CERTIFICATION

I, _____, hereby certify that:

1. The information contained in this drawing / document is in compliance with approved drawings and design.
2. The new water and sewerage works defined by this drawing have been designed and constructed in accordance with the SEQ Code.
3. This represents an accurate record of as-constructed works.
4. I accept responsibility for the information contained in this drawing / document.

RPEQ (signature) RPEQ No. Date:

LEGEND

SEWER MAIN

SEWER HOUSE CONNECTION

SEWER HOUSE CONNECTION

SEWER MAINTENANCE HOLE (INSITU)

SEWER MAINTENANCE SHAFT

SEWER END OF LINE

EXISTING SEWER MAINTENANCE SHAFT

DESIGN LEVEL

58.19#

A1	D	TBD	PROGRESS PLOT AS CON SEWER	JMc					
	C	13/01/2025	PROGRESS PLOT AS CON SEWER	JMc			DRAWN	JMc	08/10/2024
	B	28/11/2024	PROGRESS PLOT AS CON SEWER	JMc			CHECKED		
	A	08/10/2024	PROGRESS PLOT AS CON SEWER	JMc			APPROVED		
	REV NO	DATE	REVISION PURPOSE / DESCRIPTION	DRAWN	RPEQ	RPEQ No	INITIALS	DATE	

BRISBANE (07) 3665 4700
MACKAY (07) 4957 9700
veris.com.au
ACN 615 735 727
Veris Australia Pty Ltd

WHITSUNDAYS (07) 4945 6600
CAIRNS (07) 4052 9400

QUEENSLAND
UrbanUtilities

DAWN WALLOON
Banjo Drive Walloon

STAGE 6D
AS CONSTRUCTED SEWER

DRAWING STATUS
AS CONSTRUCTED

SHEET 5 OF 5 SHEETS

DRAWING NO.
401905-6D-AS01

REV.
D