





AS CONSTRUCTED

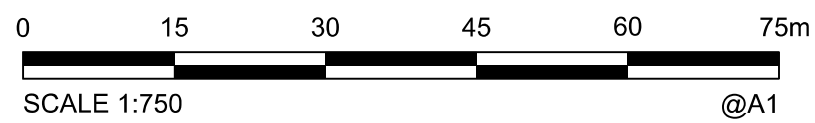

REGISTERED SURVEYOR'S CERTIFICATION

I, **Veris Australia Pty Ltd**, hereby certify that the vertical and horizontal locations and dimensions shown on this plan are a true and correct record and were located by survey.

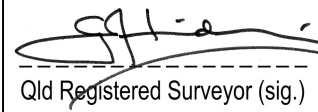 **6448** **10/02/2025**
Old Registered Surveyor (sig.) Old Reg. Surveyor No. Date

ENGINEER'S CERTIFICATION

I, _____, hereby certify that:

- The information contained in this drawing / document is in compliance with approved drawings and design.
- This represents an accurate record of as-constructed works.
- I accept responsibility for the information contained in this drawing / document.

RPEQ (signature) RPEQ No. Date:

A1

D	31/01/2025	AMENDMENTS APPLIED	JMc		
C	21/01/2025	FINAL	JMc		
B	02/12/2024	PROGRESS PLOT	JMc		
A	05/11/2024	PROGRESS PLOT	JMc		
INDEX	DATE	REVISIONS	DRAWN	CHECKED	PASSED

DRAWN	JMc	10/10/2024			
CHECKED					
PASSED					
	INITIALS	DATE			



BRISBANE (07) 3699 4700 WHITSUNDAYS (07) 4945 8800
MACKAY (07) 5481 8700 CAIRNS (07) 4232 3400
veris.com.au
ACN 616 736 727
Veris Australia Pty Ltd



IPSWICH CITY COUNCIL

WATERLEA WALLOON STAGE 6D
AS CONSTRUCTED
DRAINAGE

SCALE 1:1000 @A1
SHEET 1 OF 5 SHEETS
DRAWING NO.
401905-6D-ASW01
D
C
B
A



BANJO

597

596

595

594

593

592

591

585

584

583

DAVIS

WAY

FURPHY STREET

590

589

588

565

564

587

586

566

567

559

558

557

556

Furphy Street
Off street
Parking

FURPHY

GIL

REGISTERED SURVEYOR'S CERTIFICATION

I, **Veris Australia Pty Ltd**, hereby certify that the vertical and horizontal locations and dimensions shown on this plan are a true and correct record and were located by survey.



6448 10/02/2025
Qld Registered Surveyor (sig.) Qld Reg. Surveyor No. Date

ENGINEER'S CERTIFICATION

I, _____, hereby certify that:
1. The information contained in this drawing / document is in compliance with approved drawings and design.
2. This represents an accurate record of as-constructed works.
3. I accept responsibility for the information contained in this drawing / document.

RPEQ (signature) RPEQ No. Date:

AS CONSTRUCTED

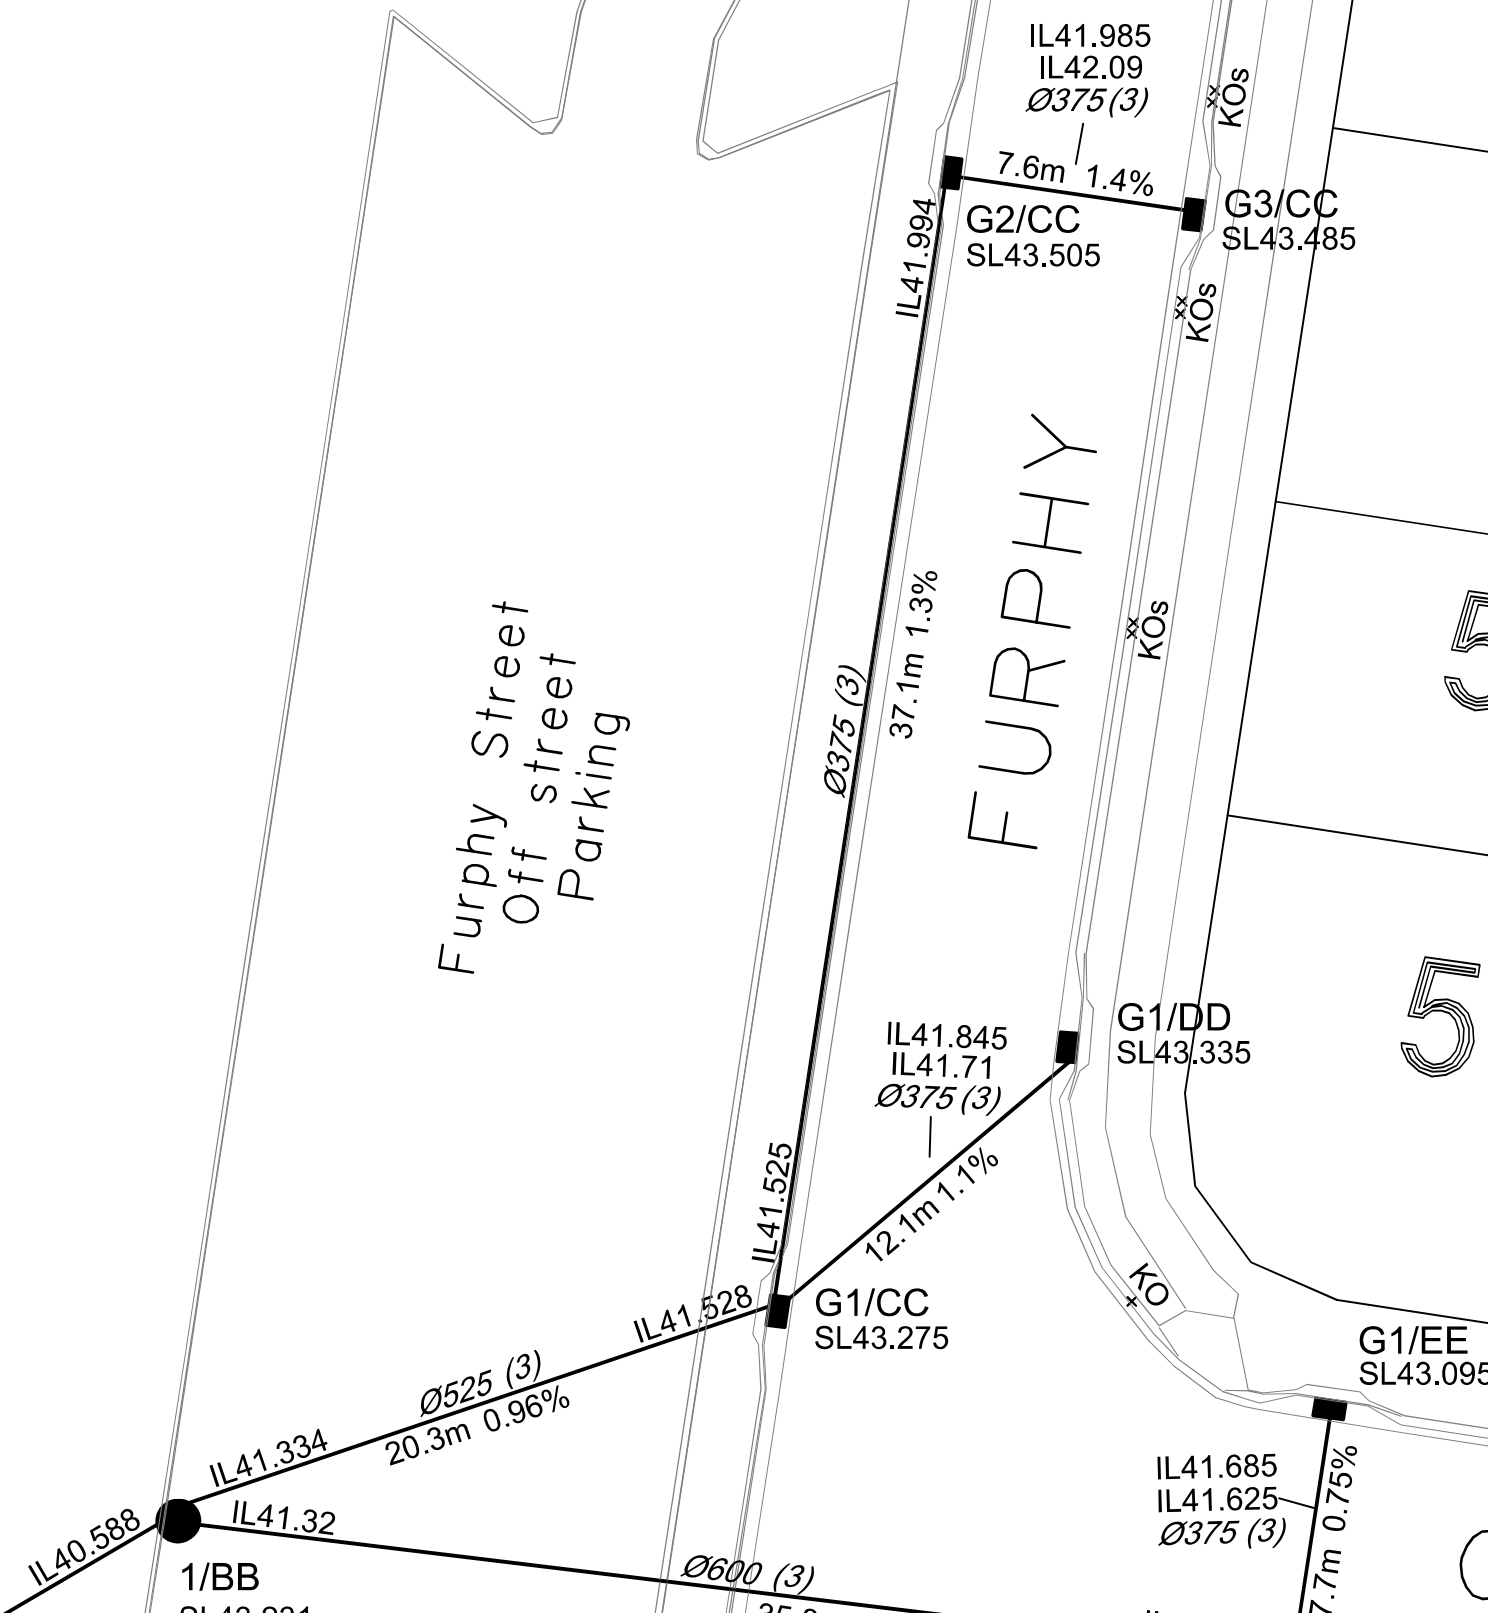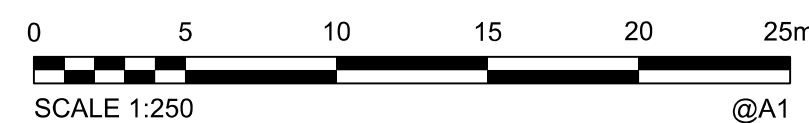

A1

D	31/01/2025	AMENDMENTS APPLIED	JMc		
C	21/01/2025	FINAL	JMc		
B	02/12/2024	PROGRESS PLOT	JMc		
A	05/11/2024	PROGRESS PLOT	JMc		
INDEX	DATE	REVISIONS	DRAWN	CHECKED	PASSED

DRAWN	JMc	10/10/2024
CHECKED	JMc	
PASSED		
INITIALS	DATE	



BRISBANE (07) 3666 4700 WHITSUNDAYS (07) 4945 6600
MACKAY (07) 4657 3100 CAIRNS (07) 4552 9400
veris.com.au
ACN 615 735 727
Veris Australia Pty Ltd



IPSWICH CITY COUNCIL

WATERLEA WALLOON STAGE 6D
AS CONSTRUCTED
DRAINAGE


SCALE 1:250 @A1

SHEET 2 OF 5 SHEETS

DRAWING NO.

401905-6D-ASW01

D
C
B
A

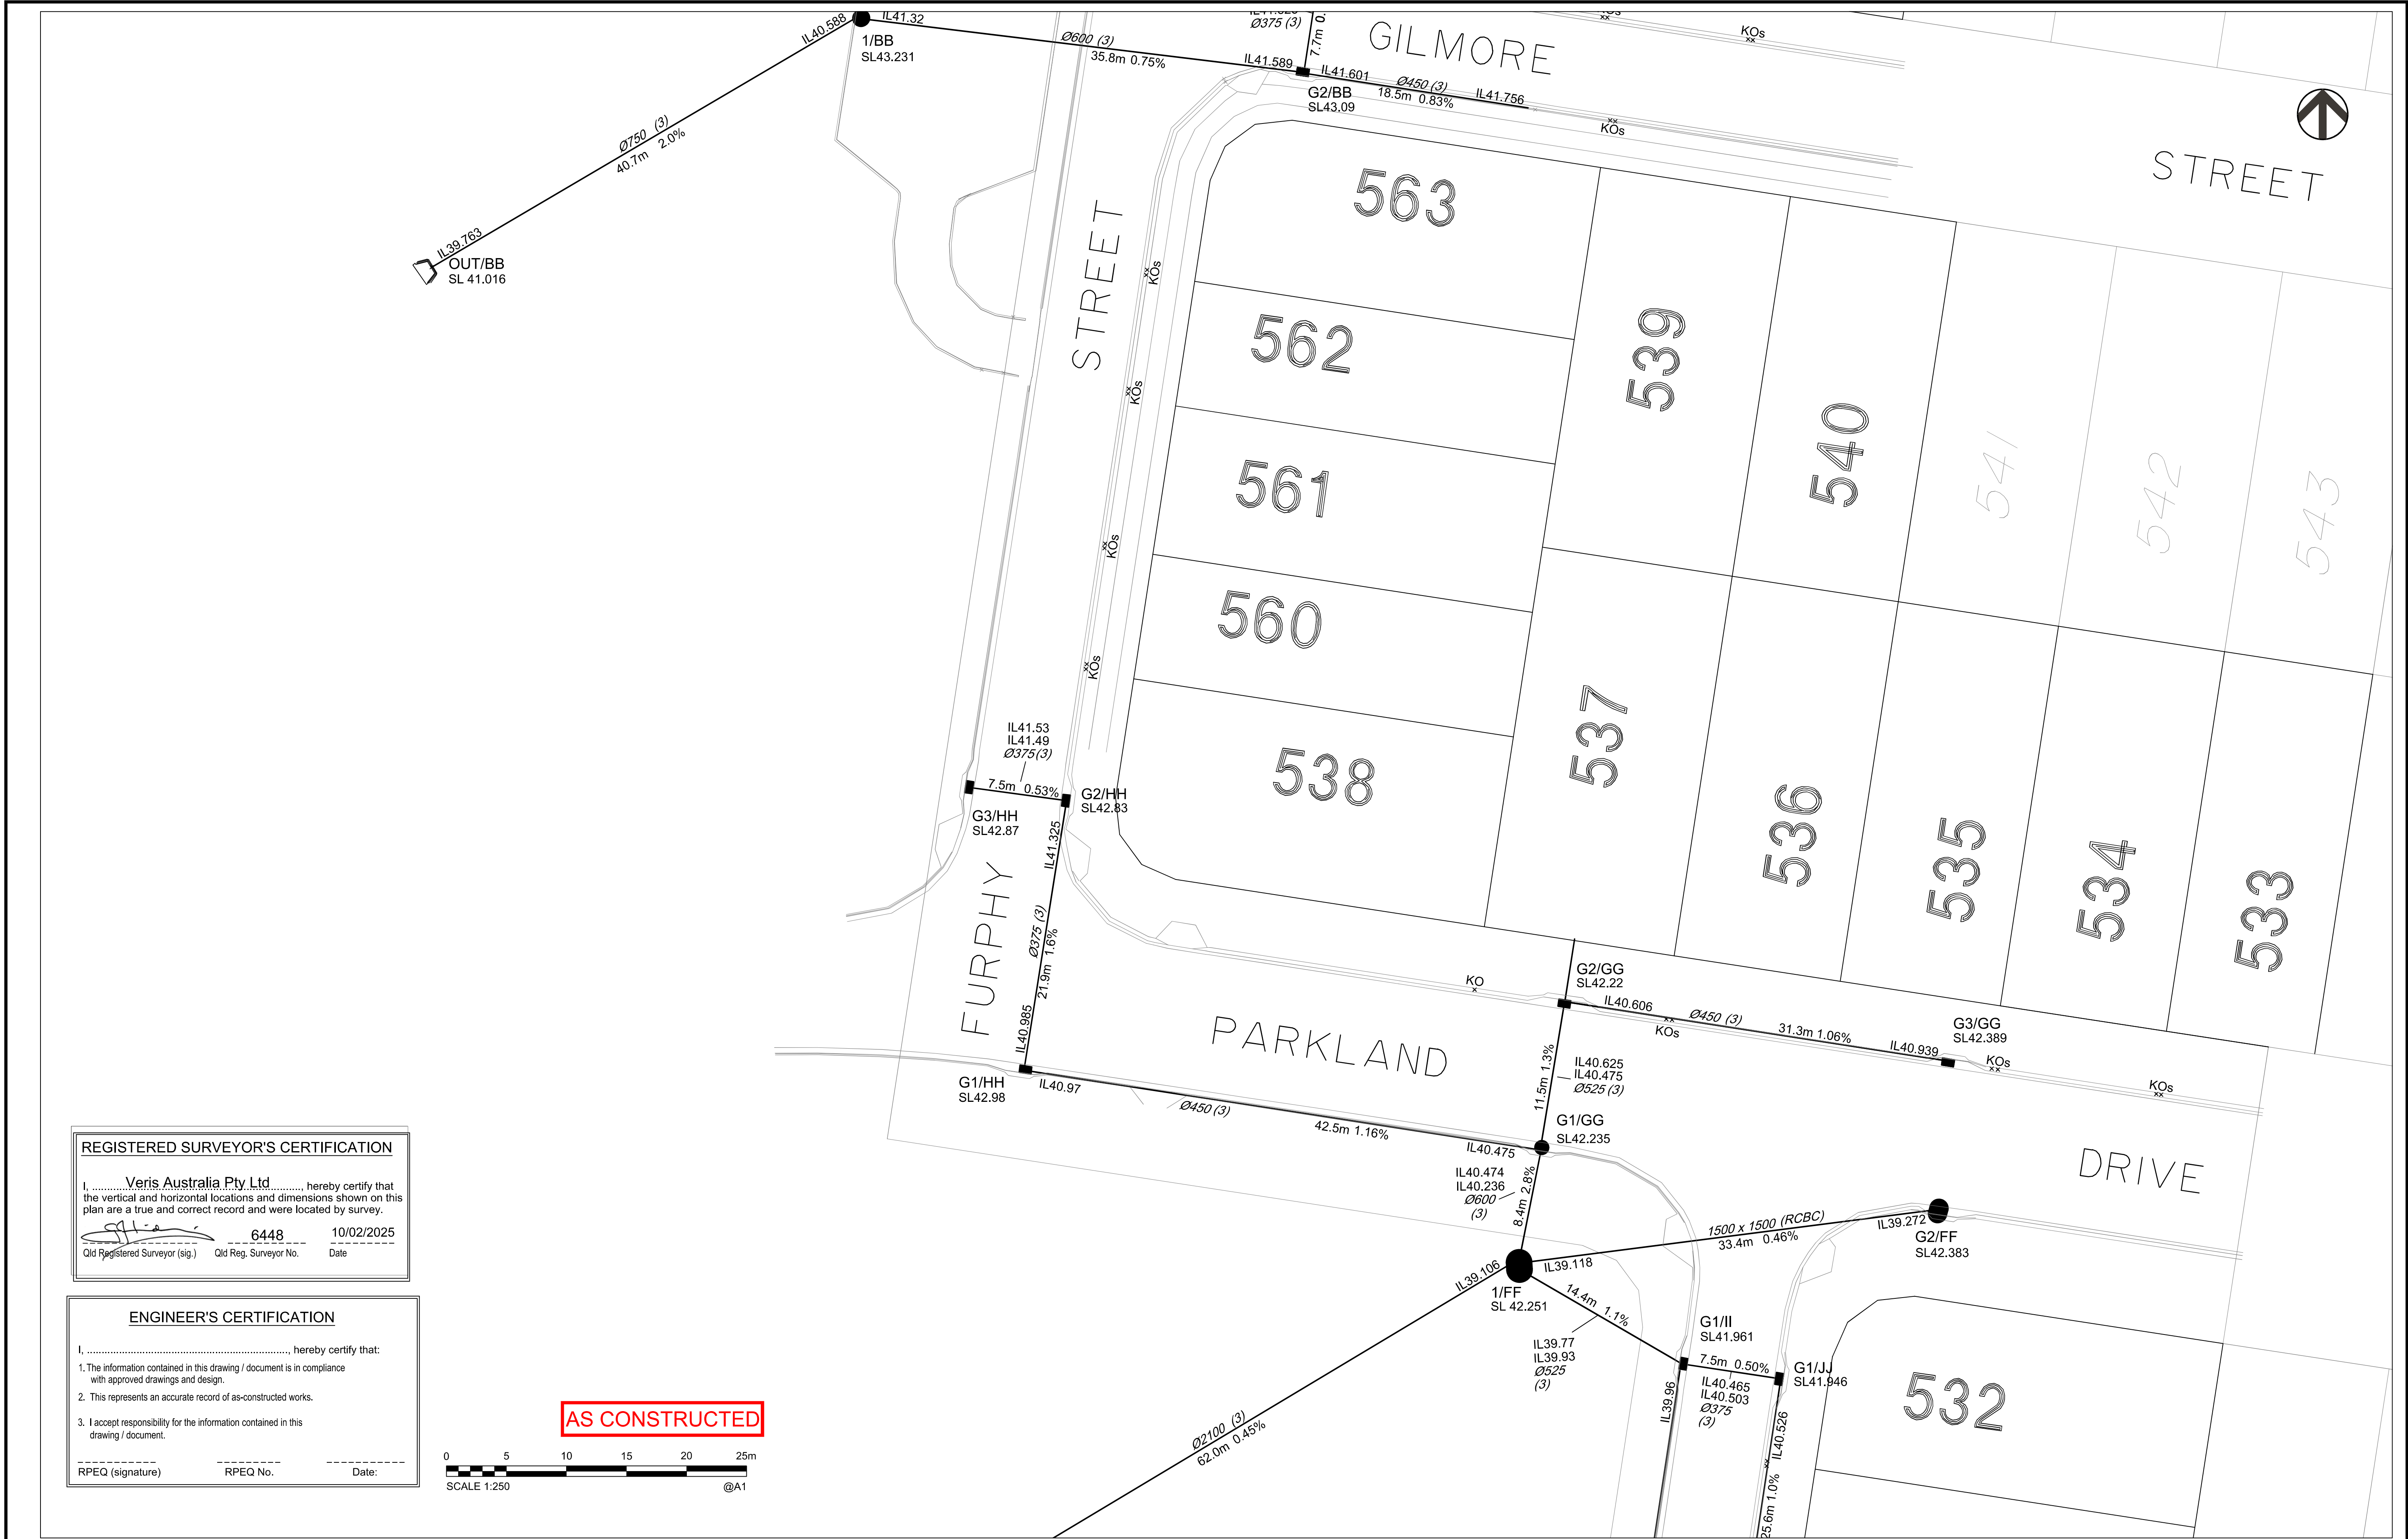

REGISTERED SURVEYOR'S CERTIFICATION

I, Veris Australia Pty Ltd, hereby certify that the vertical and horizontal locations and dimensions shown on this plan are a true and correct record and were located by survey.

Signature: [Signature] 6448 10/02/2025
Old Registered Surveyor (sig.) Old Reg. Surveyor No. Date

ENGINEER'S CERTIFICATION

- I, hereby certify that:
- The information contained in this drawing / document is in compliance with approved drawings and design.
 - This represents an accurate record of as-constructed works.
 - I accept responsibility for the information contained in this drawing / document.

RPEQ (signature) RPEQ No. Date:

AS CONSTRUCTED



A1

D	31/01/2025	AMENDMENTS APPLIED	JMc		
C	21/01/2025	FINAL	JMc		
B	02/12/2024	PROGRESS PLOT	JMc		
A	05/11/2024	PROGRESS PLOT	JMc		
INDEX	DATE	REVISIONS	DRAWN	CHECKED	PASSED

DRAWN	JMc	10/10/2024
CHECKED		
PASSED		
INITIALS		DATE



BRISBANE (07) 3699 4700 WHITSUNDAYS (07) 4945 6600
MACKAY (07) 4687 8700 CAIRNS (07) 4262 3400
veris.com.au
ACN 616 736 727
Veris Australia Pty Ltd



IPSWICH CITY COUNCIL

WATERLEA WALLOON STAGE 6D
AS CONSTRUCTED
DRAINAGE


SCALE 1:250 @A1

SHEET 3 OF 5 SHEETS

DRAWING NO.

401905-6D-ASW01

D
C
B
A

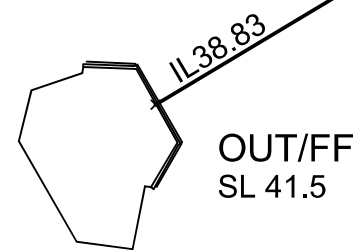

REGISTERED SURVEYOR'S CERTIFICATION

I, Veris Australia Pty Ltd, hereby certify that the vertical and horizontal locations and dimensions shown on this plan are a true and correct record and were located by survey.

[Signature] 6448 10/02/2025
Old Registered Surveyor (sig.) Old Reg. Surveyor No. Date



ENGINEER'S CERTIFICATION

I,, hereby certify that:

- The information contained in this drawing / document is in compliance with approved drawings and design.
- This represents an accurate record of as-constructed works.
- I accept responsibility for the information contained in this drawing / document.

RPEQ (signature) RPEQ No. Date:

AS CONSTRUCTED

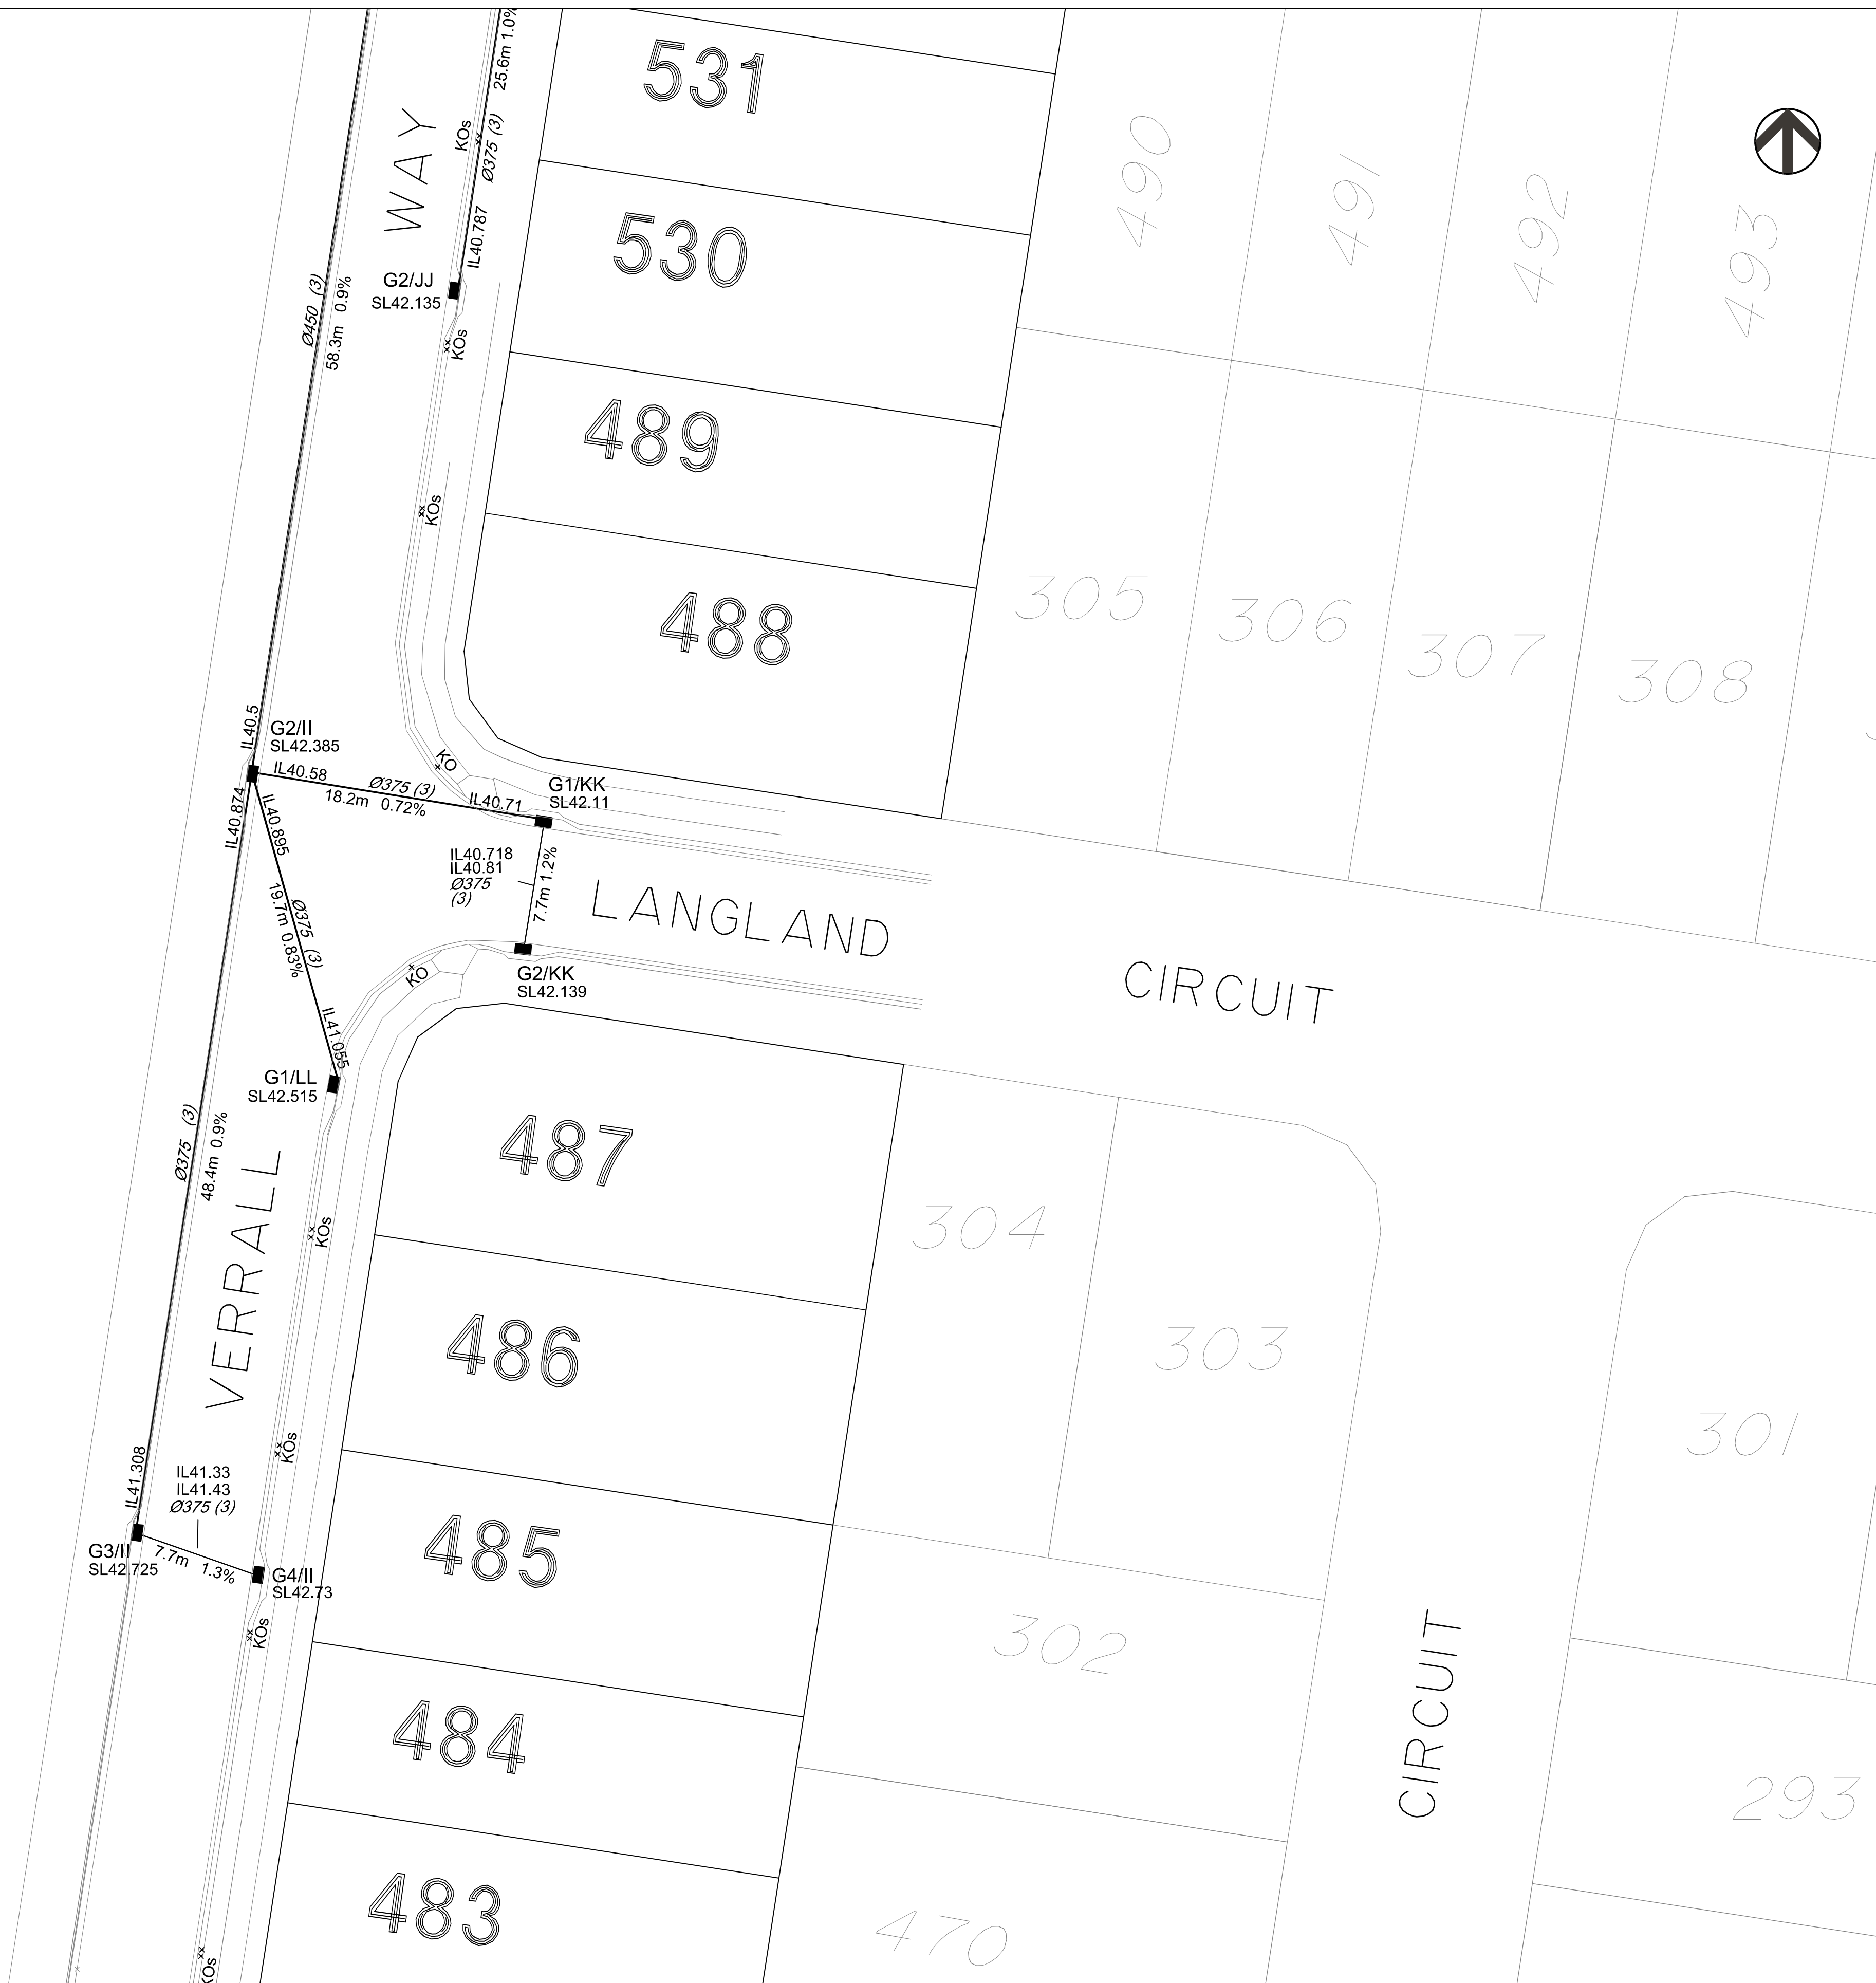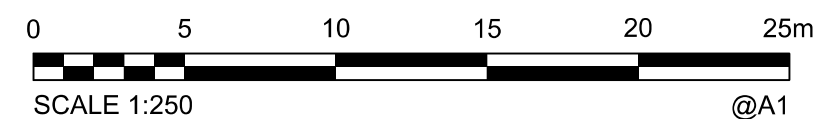

A1

D	31/01/2025	AMENDMENTS APPLIED	JMc		
C	21/01/2025	FINAL	JMc		
B	02/12/2024	PROGRESS PLOT	JMc		
A	05/11/2024	PROGRESS PLOT	JMc		
INDEX	DATE	REVISIONS	DRAWN	CHECKED	PASSED

DRAWN	JMc	10/10/2024
CHECKED		
PASSED		
INITIALS		DATE



BRISBANE (07) 3699 4700 WHITSUNDAYS (07) 4945 8800
MACKAY (07) 5481 8700 CAIRNS (07) 4282 3400
veris.com.au
ACN 615 735 727
Veris Australia Pty Ltd



IPSWICH CITY COUNCIL

WATERLEA WALLOON STAGE 6D
AS CONSTRUCTED
DRAINAGE

SCALE 1:250 @A1
SHEET 4 OF 5 SHEETS
DRAWING NO.
401905-6D-ASW01
D
C
B
A

REGISTERED SURVEYOR'S CERTIFICATION

I, Veris Australia Pty Ltd, hereby certify that the vertical and horizontal locations and dimensions shown on this plan are a true and correct record and were located by survey.

[Signature] 6448 10/02/2025
Old Registered Surveyor (sig.) Old Reg. Surveyor No. Date

ENGINEER'S CERTIFICATION

I, _____, hereby certify that:

1. The information contained in this drawing / document is in compliance with approved drawings and design.

2. This represents an accurate record of as-constructed works.

3. I accept responsibility for the information contained in this drawing / document.

RPEQ (signature) RPEQ No. Date:

AS CONSTRUCTED



A1

D	31/01/2025	AMENDMENTS APPLIED	JMc		
C	21/01/2025	FINAL	JMc		
B	02/12/2024	PROGRESS PLOT	JMc		
A	05/11/2024	PROGRESS PLOT	JMc		
INDEX	DATE	REVISIONS	DRAWN	CHECKED	PASSED

DRAWN	JMc	10/10/2024
CHECKED		
PASSED		
INITIALS		DATE



BRISBANE (07) 3699 4700 WHITSUNDAYS (07) 4945 9900
MACKAY (07) 5481 8700 CAIRNS (07) 4202 3400
veris.com.au
ACN 616 736 727
Veris Australia Pty Ltd



IPSWICH CITY COUNCIL

WATERLEA WALLOON STAGE 6D
AS CONSTRUCTED
DRAINAGE

SCALE 1:250 @A1
SHEET 5 OF 5 SHEETS
DRAWING NO.
401905-6D-ASW01
D
C
B
A