


REGISTERED SURVEYOR'S CERTIFICATION

I, Veris Australia Pty Ltd, hereby certify that the vertical and horizontal locations and dimensions shown on this plan are a true and correct record and were located by survey.


 Qld Registered Surveyor (sig.)


6448
 Qld Reg. Surveyor No.

27/10/2025
 Date

ENGINEER'S CERTIFICATION



Oliver Hartigan
I,, hereby certify that:

1. The information contained in this drawing / document is in compliance with approved drawings and design.
2. The new water and sewerage works defined by this drawing have been designed and constructed in accordance with the SEQ Code.
3. This represents an accurate record of as-constructed works.
4. I accept responsibility for the information contained in this drawing / document.

drawing / document. 21 November 2025
 27508

 RPEQ (signature) RPEQ No. Date:

LEGEND

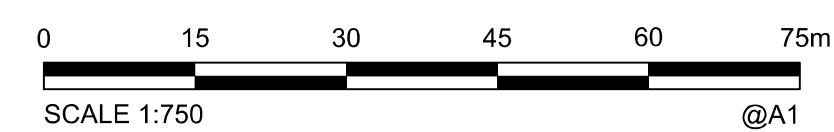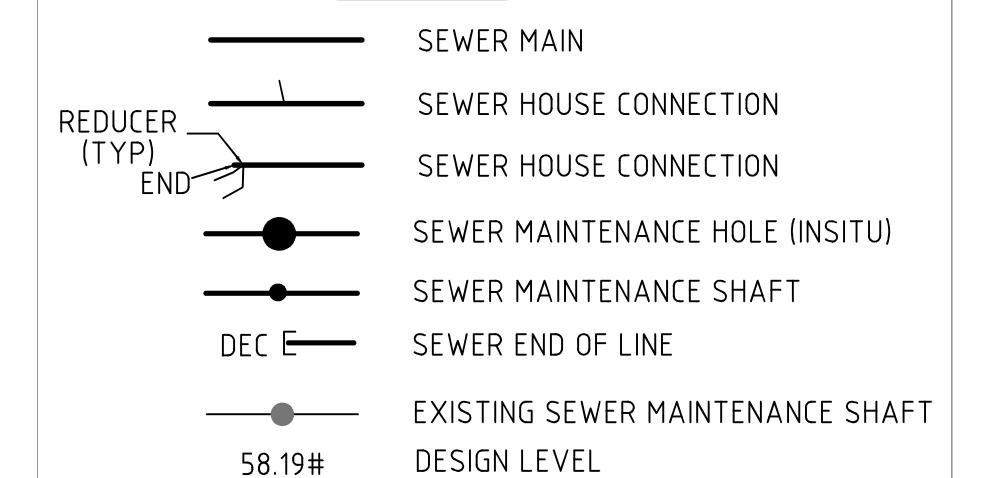

A1

[illegible]

CONSULTING SURVEYOR



BRISBANE (37) 2696 4700
MACKAY (37) 4957 6700
WHITSUNDY (37) 4945 6600
CAIRNS (37) 4252 9400
veris.com.au
ACN 615 735 727
Veris Australia Pty Ltd



DAWN WALLOON
Banjo Drive Walloon

STAGE GIBBS STAGE 2
AS CONSTRUCTED SEWER

DRAWING STATUS
AS CONSTRUCTED

SHEET 1 OF 4 SHEETS

DRAWING NO.
401905-62-AS01-C

EV.	
C	



REGISTERED SURVEYOR'S CERTIFICATION

I, Veris Australia Pty Ltd, hereby certify that the vertical and horizontal locations and dimensions shown on this plan are a true and correct record and were located by survey.

[Signature] 6448 27/10/2025
Qld Registered Surveyor (sig.) Qld Reg. Surveyor No. Date

ENGINEER'S CERTIFICATION

I, Oliver Hartigan, hereby certify that:

- The information contained in this drawing / document is in compliance with approved drawings and design.
- The new water and sewerage works defined by this drawing have been designed and constructed in accordance with the SEQ Code.
- This represents an accurate record of as-constructed works.
- I accept responsibility for the information contained in this drawing / document.

[Signature] 27508 21 November 2025
RPEQ (signature) RPEQ No. Date:

LEGEND

- SEWER MAIN
- SEWER HOUSE CONNECTION
- SEWER HOUSE CONNECTION
- SEWER MAINTENANCE HOLE (INSITU)
- SEWER MAINTENANCE SHAFT
- SEWER END OF LINE
- EXISTING SEWER MAINTENANCE SHAFT
- DESIGN LEVEL



SCALE OF METRES
1 : 250 FULL SIZE A1 SHEET

A1

REV NO	DATE	REVISION PURPOSE / DESCRIPTION	DRAWN	RPEQ	RPEQ No	INITIALS	DATE
C	07/10/2025	INCLUDE EXISTING SEWER HCs LOTS 782-784 & 822	JMc			DRAWN	JMc 20/08/2025
B	19/09/2025	FINAL	JMc			CHECKED	
A	20/08/2025	PROGRESS PLOT AS CON SEWER	JMc			APPROVED	



DAWN WALLOON
Banjo Drive Walloon
STAGE GIBBS STAGE 2
AS CONSTRUCTED SEWER

DRAWING STATUS	
AS CONSTRUCTED	
SHEET 2 OF 4 SHEETS	
DRAWING NO.	REV.
401905-62-AS01-C	C



BANJO

WAY

834
SL62.658
IL 61.362
Type C2

810
SL62.778
IL 61.46
Type B2

796

833
SL62.609
IL 61.197
Type C2

811
SL62.453
IL 61.173
Type B2

795

832
SL62.253
IL 60.976
Type C2

812
SL62.405
IL 61.102
Type C4

794

831
SL61.877
IL 60.688
Type B2

813
SL61.949
IL 60.669
Type B2

793

830
SL61.379
IL 60.189
Type C2

814
SL61.894
IL 60.598
Type C4

792

466
SL61.025
IL 59.665
Type C2

815
SL61.364
IL 60.042
Type C4

791

828
SL60.225
IL 59.02
Type B2

816
SL60.709
IL 59.405
Type C4

790

827
SL59.667
IL 58.443
Type B2

817
SL59.993
IL 58.686
Type C4

789

826
SL58.814
IL 57.814
Type B2

818
SL59.076
IL 57.828
Type B2

788

825
SL58.469
IL 57.227
Type B2

SL58.966

REGISTERED SURVEYOR'S CERTIFICATION

I, Veris Australia Pty Ltd, hereby certify that the vertical and horizontal locations and dimensions shown on this plan are a true and correct record and were located by survey.

Oliver Hartigan 6448 27/10/2025
Qld Registered Surveyor (sig.) Qld Reg. Surveyor No. Date

ENGINEER'S CERTIFICATION

I, oliver Hartigan, hereby certify that:

- The information contained in this drawing / document is in compliance with approved drawings and design.
- The new water and sewerage works defined by this drawing have been designed and constructed in accordance with the SEQ Code.
- This represents an accurate record of as-constructed works.
- I accept responsibility for the information contained in this drawing / document.

Oliver Hartigan 27508 21 November 2025
RPEQ (signature) RPEQ No. Date:

LEGEND

- SEWER MAIN
- SEWER HOUSE CONNECTION
- SEWER HOUSE CONNECTION
- SEWER MAINTENANCE HOLE (INSITU)
- SEWER MAINTENANCE SHAFT
- SEWER END OF LINE
- EXISTING SEWER MAINTENANCE SHAFT
- DESIGN LEVEL



SCALE OF METRES
1 : 250 FULL SIZE A1 SHEET

A1

REV NO	DATE	REVISION PURPOSE / DESCRIPTION	DRAWN	RPEQ	RPEQ No	INITIALS	DATE
C	07/10/2025	INCLUDE EXISTING SEWER HCs LOTS 782-784 & 822	JMc			DRAWN	JMc 20/08/2025
B	19/09/2025	FINAL	FINAL	JMc		CHECKED	
A	20/08/2025	PROGRESS PLOT AS CON SEWER	JMc			APPROVED	


CONSULTING SURVEYOR
veris
BRISBANE WHITSUNDAYS
MACKAY CAIRNS
TULLOCH TOWNSHIP
VERIS AUSTRALIA PTY LTD

egis
© 2023 Egis Consulting Pty Ltd
www.egis-group.com

QUEENSLAND
UrbanUtilities

DAWN WALLOON
Banjo Drive Walloon
STAGE GIBBS STAGE 2
AS CONSTRUCTED SEWER

DRAWING STATUS	
AS CONSTRUCTED	
SHEET 3 OF 4 SHEETS	
DRAWING NO.	REV.
401905-62-AS01-C	C

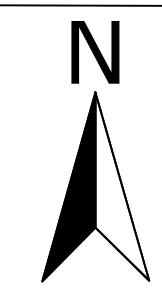

I, Veris Australia Pty Ltd, hereby certify that the vertical and horizontal locations and dimensions shown on this plan are a true and correct record and were located by survey.

Qld Registered Surveyor (sig.) 6448 27/10/2025
Qld Reg. Surveyor No. Date

oliver hartigan
I, _____, hereby certify that:

1. The information contained in this drawing / document is in compliance with approved drawings and design.
2. The new water and sewerage works defined by this drawing have been designed and constructed in accordance with the SEQ Code.
3. This represents an accurate record of as-constructed works.
4. I accept responsibility for the information contained in this drawing / document.


drawing / document. 27508 21 November 2025

RPEQ (signature) RPEQ No. Date:

REDUCER
(TYP)

END

- SEWER MAIN
SEWER HOUSE CONNECTION
SEWER HOUSE CONNECTION
SEWER MAINTENANCE HOLE (INSITU)
SEWER MAINTENANCE SHAFT
SEWER END OF LINE
EXISTING SEWER MAINTENANCE SHAFT
DESIGN LEVEL

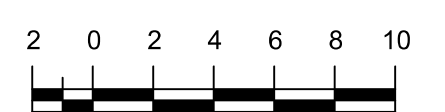

SCALE OF METRES
1 : 250 FULL SIZE A1 SHEET

A1	C	07/10/2025	INCLUDE EXISTING SEWER HCs LOTS 782-784 & 822	JMc			DRAWN	JMc	20/08/2025	<div><div>CONSULTING SURVEYOR</div><div></div><div><div><div>BRISSANE (07) 5564 6786 MURRAY (07) 4687 4000</div><div>WHITSUNDAYS (07) 5564 6786 MACKAY (07) 4687 4000</div></div><div><div></div><div>© 2023 Egis Consulting Pty Ltd</div><div>www.egis-group.com</div></div><div><div></div></div></div></div>	DAWN WALLOON Banjo Drive Walloon		DRAWING STATUS <u>AS CONSTRUCTED</u>	
	B	19/09/2025	FINAL	JMc			CHECKED				SHEET 4 OF 4 SHEETS			
	A	20/08/2025	PROGRESS PLOT AS CON SEWER	JMc			APPROVED				STAGE GIBBS STAGE 2 AS CONSTRUCTED SEWER			
	REV NO	DATE	REVISION PURPOSE / DESCRIPTION	DRAWN	RPEQ	RPEQ No		INITIALS	DATE		DRAWING NO.	REV.		
											401905-62-AS01-C	C		