

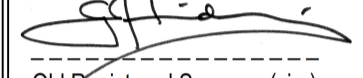
**ENGINEER'S CERTIFICATION**

- I, ..... hereby certify that:
1. The information contained in this drawing / document is in compliance with approved drawings and design.
  2. This represents an accurate record of as-constructed works.
  3. I accept responsibility for the information contained in this drawing / document.

RPEQ (signature) RPEQ No. Date:

**REGISTERED SURVEYOR'S CERTIFICATION**

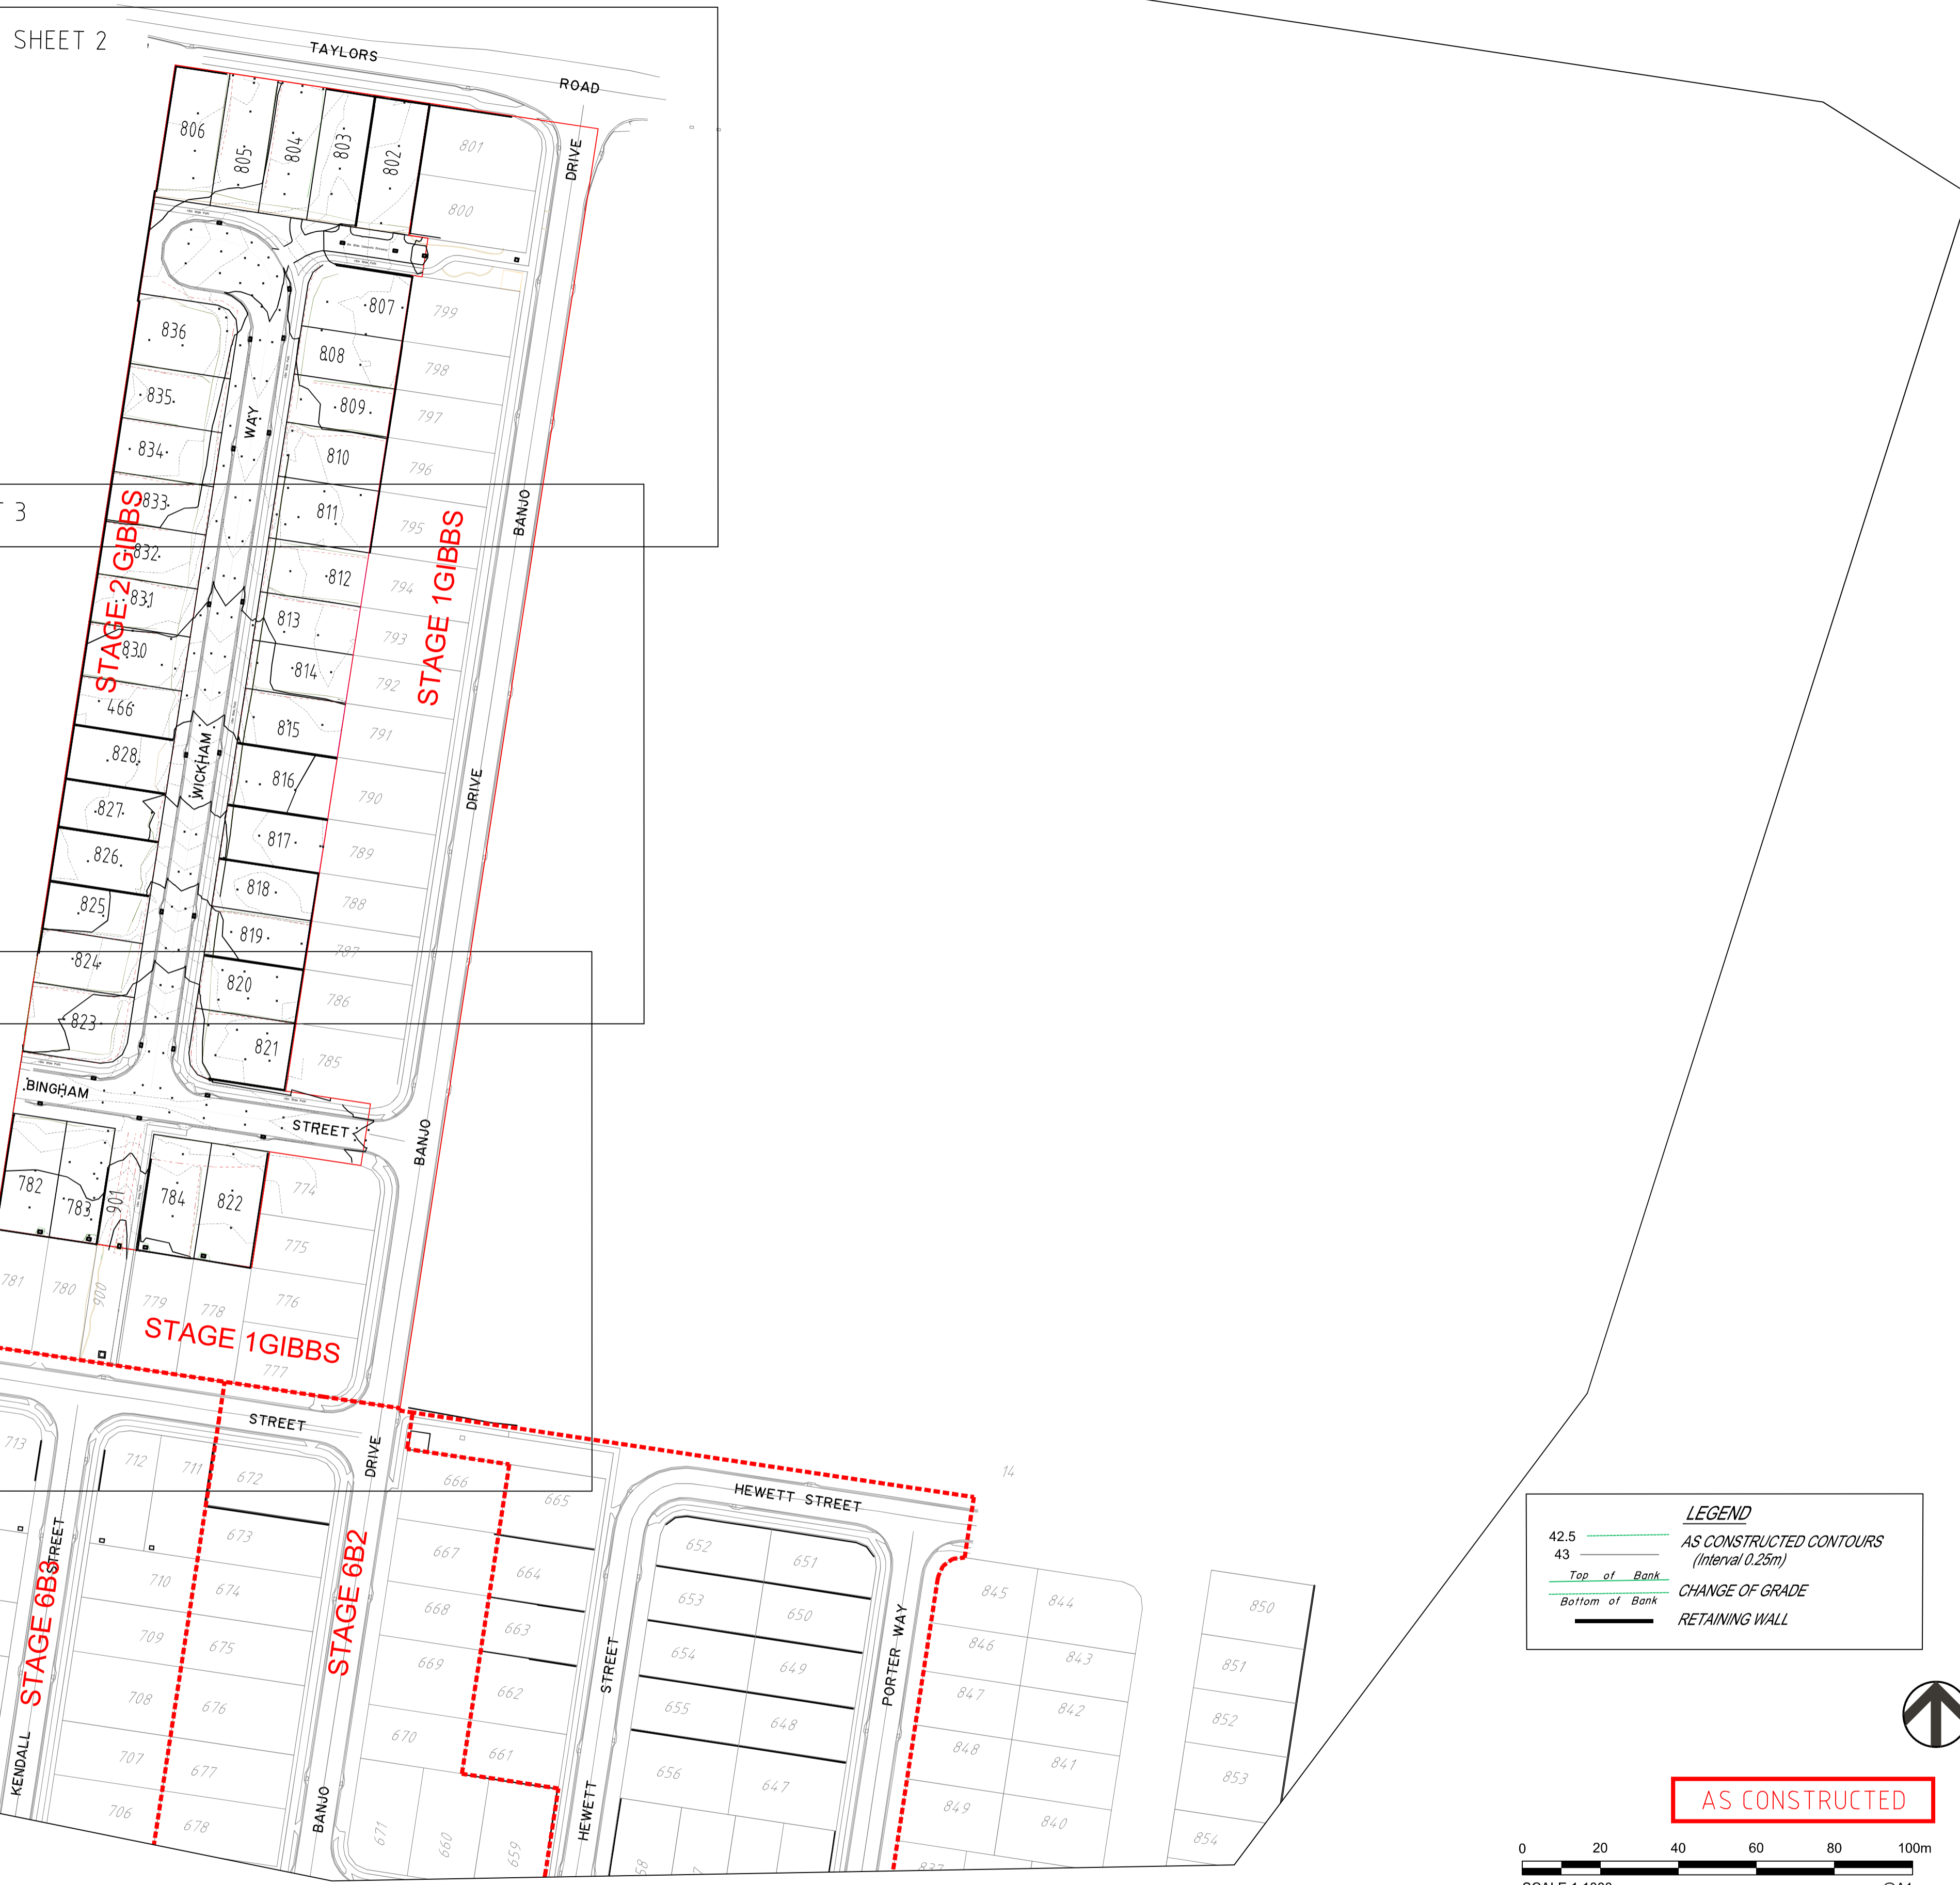
I, Veris Australia Pty Ltd, hereby certify that the vertical and horizontal locations and dimensions shown on this plan are a true and correct record and were located by survey.

 6448 08/12/2025  
 Old Registered Surveyor (sig.) Old Reg. Surveyor No. Date

SHEET 2

SHEET 3

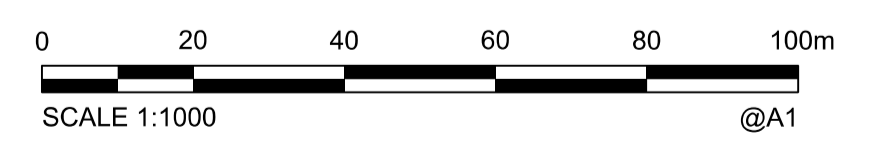
SHEET 4



**LEGEND**

- 42.5 AS CONSTRUCTED CONTOURS (Interval 0.25m)
- 43 Top of Bank
- Bottom of Bank CHANGE OF GRADE
- RETAINING WALL

**AS CONSTRUCTED**



**A1**

|       |            |               |       |         |        |
|-------|------------|---------------|-------|---------|--------|
| INDEX | DATE       | REVISIONS     | DRAWN | CHECKED | PASSED |
| A     | 07/10/2025 | PROGRESS PLOT | JMc   |         |        |

|          |     |            |
|----------|-----|------------|
| DRAWN    | JMc | 03/10/2025 |
| CHECKED  |     |            |
| PASSED   |     |            |
| INITIALS |     | DATE       |

**veris**

BRISBANE (07) 3066 4700 WHITSUNDAYS (07) 4945 9600  
 MACKAY (07) 4957 9100 CAIRNS (07) 4522 9400  
 veris.com.au  
 ACN 615 735 727  
 Veris Australia Pty Ltd



**IPSWICH CITY COUNCIL**

WATERLEA WALLOON STAGE 2 GIBBS DAWN WALLOON  
 AS CONSTRUCTED  
 EARTHWORKS

|             |                 |
|-------------|-----------------|
| SCALE       | 1:1000@A1       |
| SHEET       | 1 OF 4 SHEETS   |
| DRAWING NO. | 401905-62-AFS A |

**ENGINEER'S CERTIFICATION**

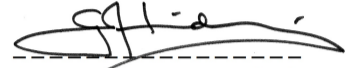
I, ..... hereby certify that:

- The information contained in this drawing / document is in compliance with approved drawings and design.
- This represents an accurate record of as-constructed works.
- I accept responsibility for the information contained in this drawing / document.

RPEQ (signature) \_\_\_\_\_ RPEQ No. \_\_\_\_\_ Date: \_\_\_\_\_

**REGISTERED SURVEYOR'S CERTIFICATION**

I, Veris Australia Pty Ltd, hereby certify that the vertical and horizontal locations and dimensions shown on this plan are a true and correct record and were located by survey.

 6448 08/12/2025  
 Old Registered Surveyor (sig.) Old Reg. Surveyor No. Date



**STAGE 2 GIBBS**

**STAGE 1 GIBBS**



**ENGINEER'S CERTIFICATION**

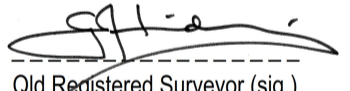
I, ....., hereby certify that:

- The information contained in this drawing / document is in compliance with approved drawings and design.
- This represents an accurate record of as-constructed works.
- I accept responsibility for the information contained in this drawing / document.


-----  
RPEQ (signature) RPEQ No. Date: -----

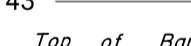
**REGISTERED SURVEYOR'S CERTIFICATION**

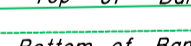
I, Veris Australia Pty Ltd, hereby certify that the vertical and horizontal locations and dimensions shown on this plan are a true and correct record and were located by survey.

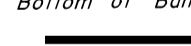
 6448 08/12/2025  
Old Registered Surveyor (sig.) Old Reg. Surveyor No. Date

**LEGEND**

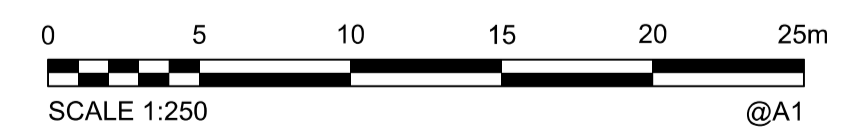
42.5  AS CONSTRUCTED CONTOURS (Interval 0.25m)

43  Top of Bank

 Bottom of Bank CHANGE OF GRADE

 RETAINING WALL

**AS CONSTRUCTED**



|           |      |            |               |  |       |         |        |          |      |
|-----------|------|------------|---------------|--|-------|---------|--------|----------|------|
| <b>A1</b> |      |            |               |  |       |         |        |          |      |
|           | A    | 07/10/2025 | PROGRESS PLOT |  |       |         | JMc    |          |      |
| INDEX     | DATE |            | REVISIONS     |  | DRAWN | CHECKED | PASSED | INITIALS | DATE |

|         |     |            |
|---------|-----|------------|
| DRAWN   | JMc | 03/10/2025 |
| CHECKED |     |            |
| PASSED  |     |            |
|         |     |            |
|         |     |            |

**veris**

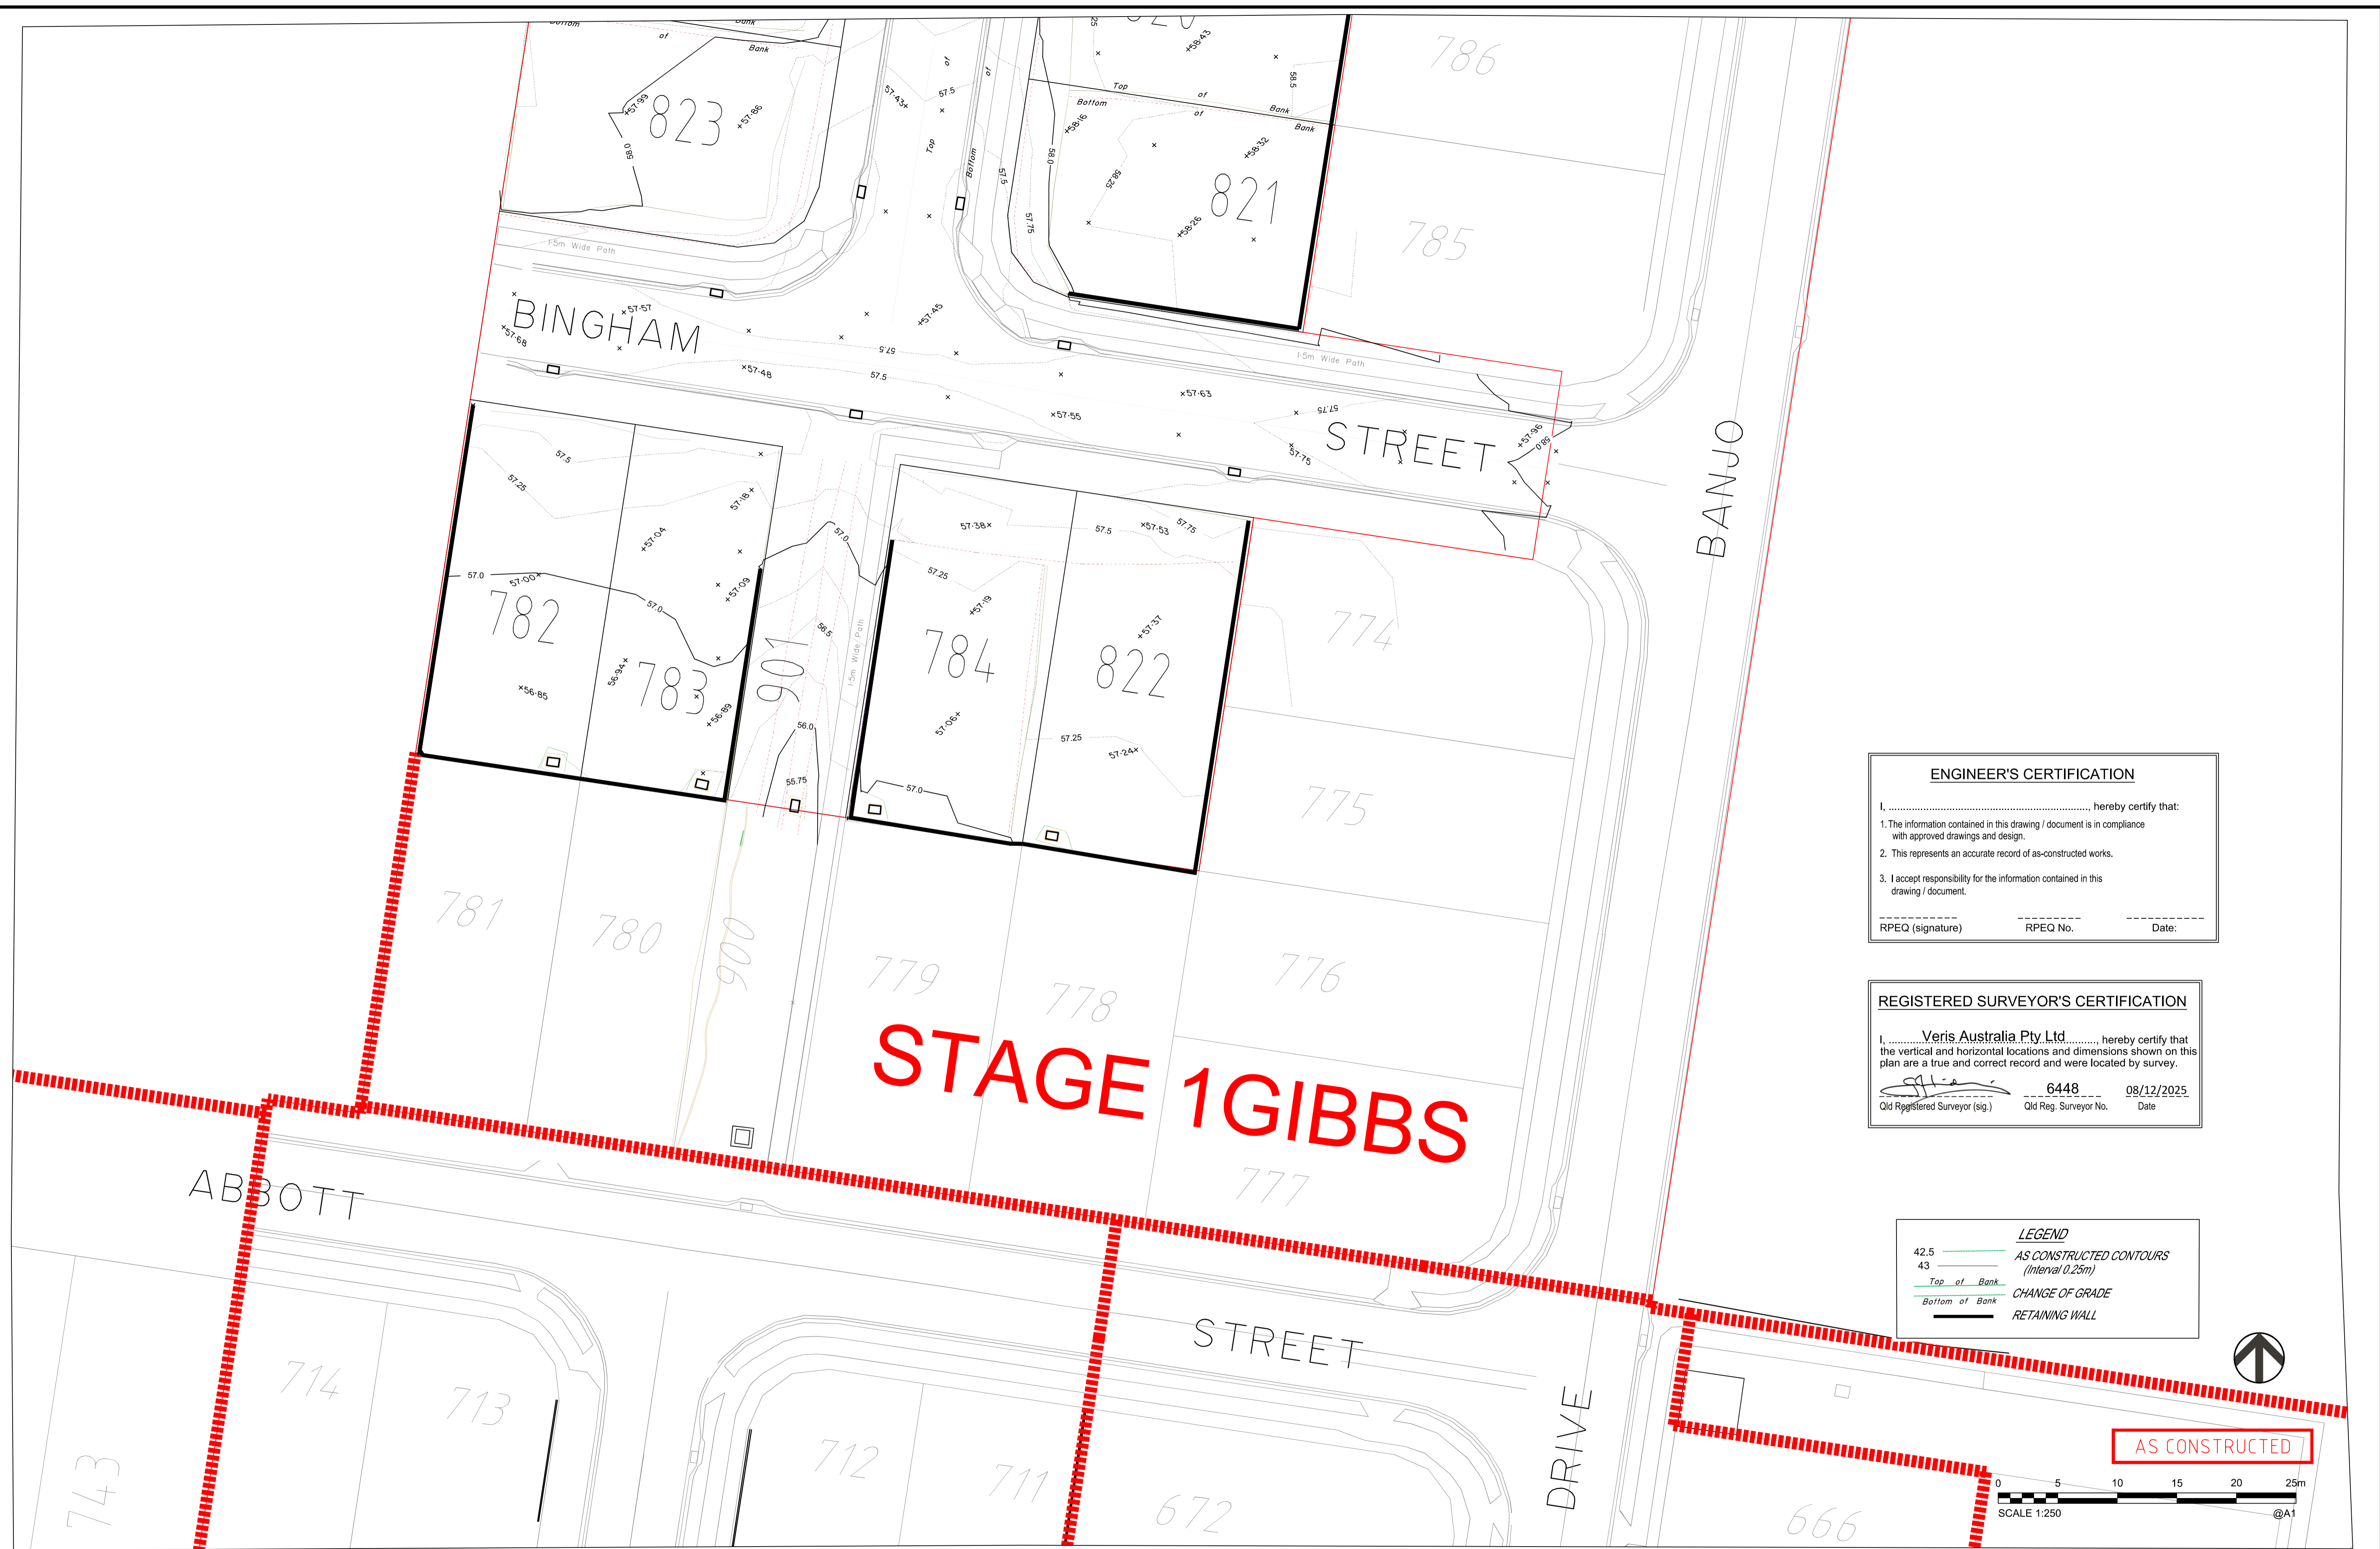
BRISBANE (07) 3860 4700 WHITSUNDAYS (07) 4945 0500  
MACKAY (07) 4887 9700 CAIRNS (07) 4232 3400  
veris.com.au  
ACN 615 735 727  
Veris Australia Pty Ltd



**IPSWICH CITY COUNCIL**

WATERLEA WALLOON STAGE 2 GIBBS DAWN WALLOON  
AS CONSTRUCTED  
EARTHWORKS

SCALE 1:250 @A1  
SHEET 3 OF 4 SHEETS  
DRAWING NO.  
401905-62-AFS A



**ENGINEER'S CERTIFICATION**

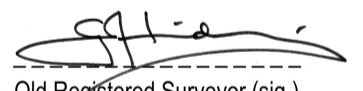
I, ....., hereby certify that:

- The information contained in this drawing / document is in compliance with approved drawings and design.
- This represents an accurate record of as-constructed works.
- I accept responsibility for the information contained in this drawing / document.

RPEQ (signature) \_\_\_\_\_ RPEQ No. \_\_\_\_\_ Date: \_\_\_\_\_

**REGISTERED SURVEYOR'S CERTIFICATION**

I, Veris Australia Pty Ltd, hereby certify that the vertical and horizontal locations and dimensions shown on this plan are a true and correct record and were located by survey.

 6448 08/12/2025  
 Old Registered Surveyor (sig.) Old Reg. Surveyor No. Date

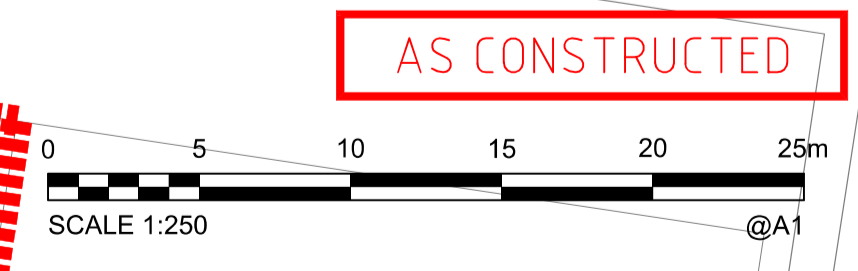
**LEGEND**

42.5 AS CONSTRUCTED CONTOURS (Interval 0.25m)

43 Top of Bank

Bottom of Bank CHANGE OF GRADE

RETAINING WALL



|    |       |            |               |       |         |        |
|----|-------|------------|---------------|-------|---------|--------|
| A1 | INDEX | DATE       | REVISIONS     | DRAWN | CHECKED | PASSED |
|    | A     | 07/10/2025 | PROGRESS PLOT | JMc   |         |        |

|          |     |            |
|----------|-----|------------|
| DRAWN    | JMc | 03/10/2025 |
| CHECKED  |     |            |
| PASSED   |     |            |
| INITIALS |     | DATE       |

**veris**

BRISBANE (07) 3800 4700 WHITSUNDAYS (07) 4945 0500  
 MACKAY (07) 4987 9100 CAIRNS (07) 4232 3400  
 veris.com.au  
 ACN 616 735 727  
 Veris Australia Pty Ltd



**IPSWICH CITY COUNCIL**

WATERLEA WALLOON STAGES 2 GIBBS DAWN WALLOON  
 AS CONSTRUCTED  
 EARTHWORKS

SCALE 1:250 @A1  
 SHEET 4 OF 4 SHEETS  
 DRAWING NO.  
 401905-611-AFS A