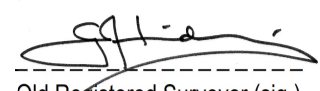


REGISTERED SURVEYOR'S CERTIFICATION

I, Veris Australia Pty Ltd, hereby certify that the vertical and horizontal locations and dimensions shown on this plan are a true and correct record and were located by survey.

 6448 20/11/2025
Old Registered Surveyor (sig.) Old Reg. Surveyor No. Date

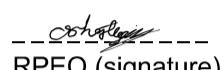
ENGINEER'S CERTIFICATION

I, Oliver Hartigan, hereby certify that:

1. The information contained in this drawing / document is in compliance with approved drawings and design.

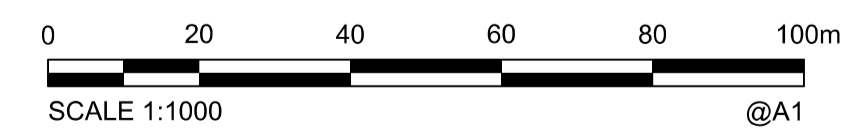
2. This represents an accurate record of as-constructed works.

3. I accept responsibility for the information contained in this drawing / document.

 27508 21 November 2025
RPEQ (signature) RPEQ No. Date:



AS CONSTRUCTED



A1	C	07/10/2025	INCLUDED EXISTING DRAINAGE IN THOROUGHFARE NEAR LOT 800	JMc		
	B	22/09/2025	FINAL	JMc		
	A	22/08/2025	PROGRESS PLOT	JMc		
	INDEX	DATE	REVISIONS	DRAWN	CHECKED	PASSED

DRAWN	JMc	22/08/2025
CHECKED		
PASSED		
INITIALS		DATE

CONSULTING SURVEYOR



BRISBANE 075 996 0702
MACKAY 075 996 0702
JOLLY SPRING 075 996 0702
VERIS AUSTRALIA PTY LTD

WHITSLANDAYS
075 996 0800
CARBON
075 996 0800
MURKIN
075 996 0800
VERIS AUSTRALIA PTY LTD
ACN 615 735 727
Veris Australia Pty Ltd



© 2023 Egis Consulting Pty Ltd
www.egis-group.com



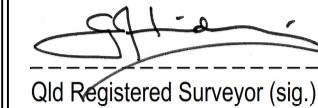
IPSWICH CITY COUNCIL

WATERLEA WALLOON STAGE 2 GIBBS DAWN WALLOON
AS CONSTRUCTED
STORMWATER

SCALE	1:1250@A1
SHEET	1 OF 4 SHEETS
DRAWING NO.	401905-62-ASW01-C
	C
	B
	A

REGISTERED SURVEYOR'S CERTIFICATION

I, Veris Australia Pty Ltd, hereby certify that the vertical and horizontal locations and dimensions shown on this plan are a true and correct record and were located by survey.

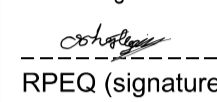
 6448 20/11/2025
Old Registered Surveyor (sig.) Old Reg. Surveyor No. Date

ENGINEER'S CERTIFICATION

I, Oliver Hartigan, hereby certify that:

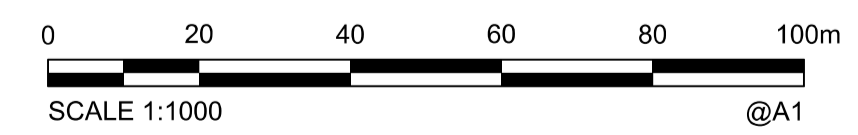
- The information contained in this drawing / document is in compliance with approved drawings and design.
- This represents an accurate record of as-constructed works.

3. I accept responsibility for the information contained in this drawing / document.

 27508 21 November 2025
RPEQ (signature) RPEQ No. Date:



AS CONSTRUCTED



A1

INDEX	DATE	REVISIONS	DRAWN	CHECKED	PASSED
C	07/10/2025	INCLUDED EXISTING DRAINAGE IN THOROUGHFARE NEAR LOT 800	JMc		
B	22/09/2025	FINAL	JMc		
A	22/08/2025	PROGRESS PLOT	JMc		

DRAWN	JMc	22/08/2025
CHECKED		
PASSED		
INITIALS		DATE

CONSULTING SURVEYOR
veris
BRISBANE WHITSUNDAYS
MACKAY CAIRNS
075 260 0700 075 460 000
075 467 0700 075 462 000
075 467 0700 075 462 000
www.veris.com.au
ACN 815 738 727
Veris Australia Pty Ltd

egis
© 2023 Egis Consulting Pty Ltd
www.egis-group.com

City of Ipswich

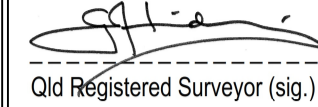
IPSWICH CITY COUNCIL

WATERLEA WALLOON STAGE 2 GIBBS DAWN WALLOON
AS CONSTRUCTED
STORMWATER

SCALE	1:250@A1
SHEET	2 OF 4 SHEETS
DRAWING NO.	401905-62-ASW01-C
C	
B	
A	

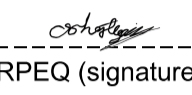
REGISTERED SURVEYOR'S CERTIFICATION

I, Veris Australia Pty Ltd, hereby certify that the vertical and horizontal locations and dimensions shown on this plan are a true and correct record and were located by survey.

 6448 20/11/2025
Old Registered Surveyor (sig.) Old Reg. Surveyor No. Date


ENGINEER'S CERTIFICATION

I, Oliver Hartigan, hereby certify that:
 1. The information contained in this drawing / document is in compliance with approved drawings and design.
 2. This represents an accurate record of as-constructed works.
 3. I accept responsibility for the information contained in this drawing / document.

 27508 21 November 2025
RPEQ (signature) RPEQ No. Date



AS CONSTRUCTED



SCALE 1:1000 @A1

A1	C	07/10/2025	INCLUDED EXISTING DRAINAGE IN THOROUGHFARE NEAR LOT 800	JMc		
	B	22/09/2025	FINAL	JMc		
	A	22/08/2025	PROGRESS PLOT	JMc		
	INDEX	DATE	REVISIONS	DRAWN	CHECKED	PASSED

DRAWN	JMc	22/08/2025
CHECKED		
PASSED		
INITIALS	DATE	

CONSULTING SURVEYOR

veris

BRISBANE (07) 3860 2000 WHITSUNDAYS (07) 4917 8889
 MACKAY (07) 4917 9979 CAIRNS (07) 4022 8440
 WETSLANDS (07) 4022 8440
 A/CN 610 730 727
 www.veris.com.au

egis

© 2023 Egis Consulting Pty Ltd
 www.egis-group.com

City of Ipswich

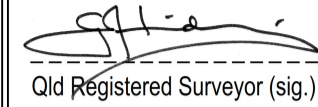
IPSWICH CITY COUNCIL

WATERLEA WALLOON STAGE 2 GIBBS DAWN WALLOON
 AS CONSTRUCTED
 STORMWATER

SCALE	1:250@A1
SHEET	3 OF 4 SHEETS
DRAWING NO.	401905-62-ASW01-C
	C
	B
	A

REGISTERED SURVEYOR'S CERTIFICATION

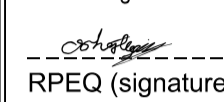
I, Veris Australia Pty Ltd, hereby certify that the vertical and horizontal locations and dimensions shown on this plan are a true and correct record and were located by survey.

 **6448** **20/11/2025**
Old Registered Surveyor (sig.) Old Reg. Surveyor No. Date

ENGINEER'S CERTIFICATION

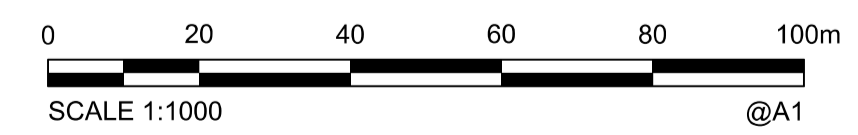
I, Oliver Hartigan, hereby certify that:

- The information contained in this drawing / document is in compliance with approved drawings and design.
- This represents an accurate record of as-constructed works.
- I accept responsibility for the information contained in this drawing / document.

 **27508** **21 November 2025**
RPEQ (signature) RPEQ No. Date:



AS CONSTRUCTED



A1

INDEX	DATE	REVISIONS	DRAWN	CHECKED	PASSED
C	07/10/2025	INCLUDED EXISTING DRAINAGE IN THOROUGHFARE NEAR LOT 800	JMc		
B	22/09/2025	FINAL	JMc		
A	22/08/2025	PROGRESS PLOT	JMc		

DRAWN	JMc	22/08/2025
CHECKED		
PASSED		
INITIALS		DATE

CONSULTING SURVEYOR
veris
BRISBANE 075 390 4700 WHITSUNDAYS 075 390 4700
MACKAY 075 452 1640 CAIRNS 075 452 1640
107 4627 9700 WINKA 075 452 1640
ACT 0 819 738 727
VERIS AUSTRALIA PTY LTD

egis
© 2023 Egis Consulting Pty Ltd
www.egis-group.com

City of Ipswich

IPSWICH CITY COUNCIL
WATERLEA WALLOON STAGE 2 GIBBS DAWN WALLOON
AS CONSTRUCTED
STORMWATER

SCALE	1:250@A1
SHEET	4 OF 4 SHEETS
DRAWING NO.	401905-62-ASW01-C
	C
	B
	A