


1
SP331771


REGISTERED SURVEYOR'S CERTIFICATION
 I, Veris Australia Pty Ltd, hereby certify that the vertical and horizontal locations and dimensions shown on this plan are a true and correct record and were located by survey.
Alastair Byrom 6448 30/08/2022
 Registered Surveyor (sig.) Reg. Surveyor No. Date

ENGINEER'S CERTIFICATION
 I, _____, hereby certify that:
 1. The information contained in this drawing / document is in compliance with approved drawings and design.
 2. The new water and sewerage works defined by this drawing have been designed and constructed in accordance with the SEQ Code.
 3. This represents an accurate record of as-constructed works.
 4. I accept responsibility for the information contained in this drawing / document.

 RPEQ (signature) RPEQ No. Date:

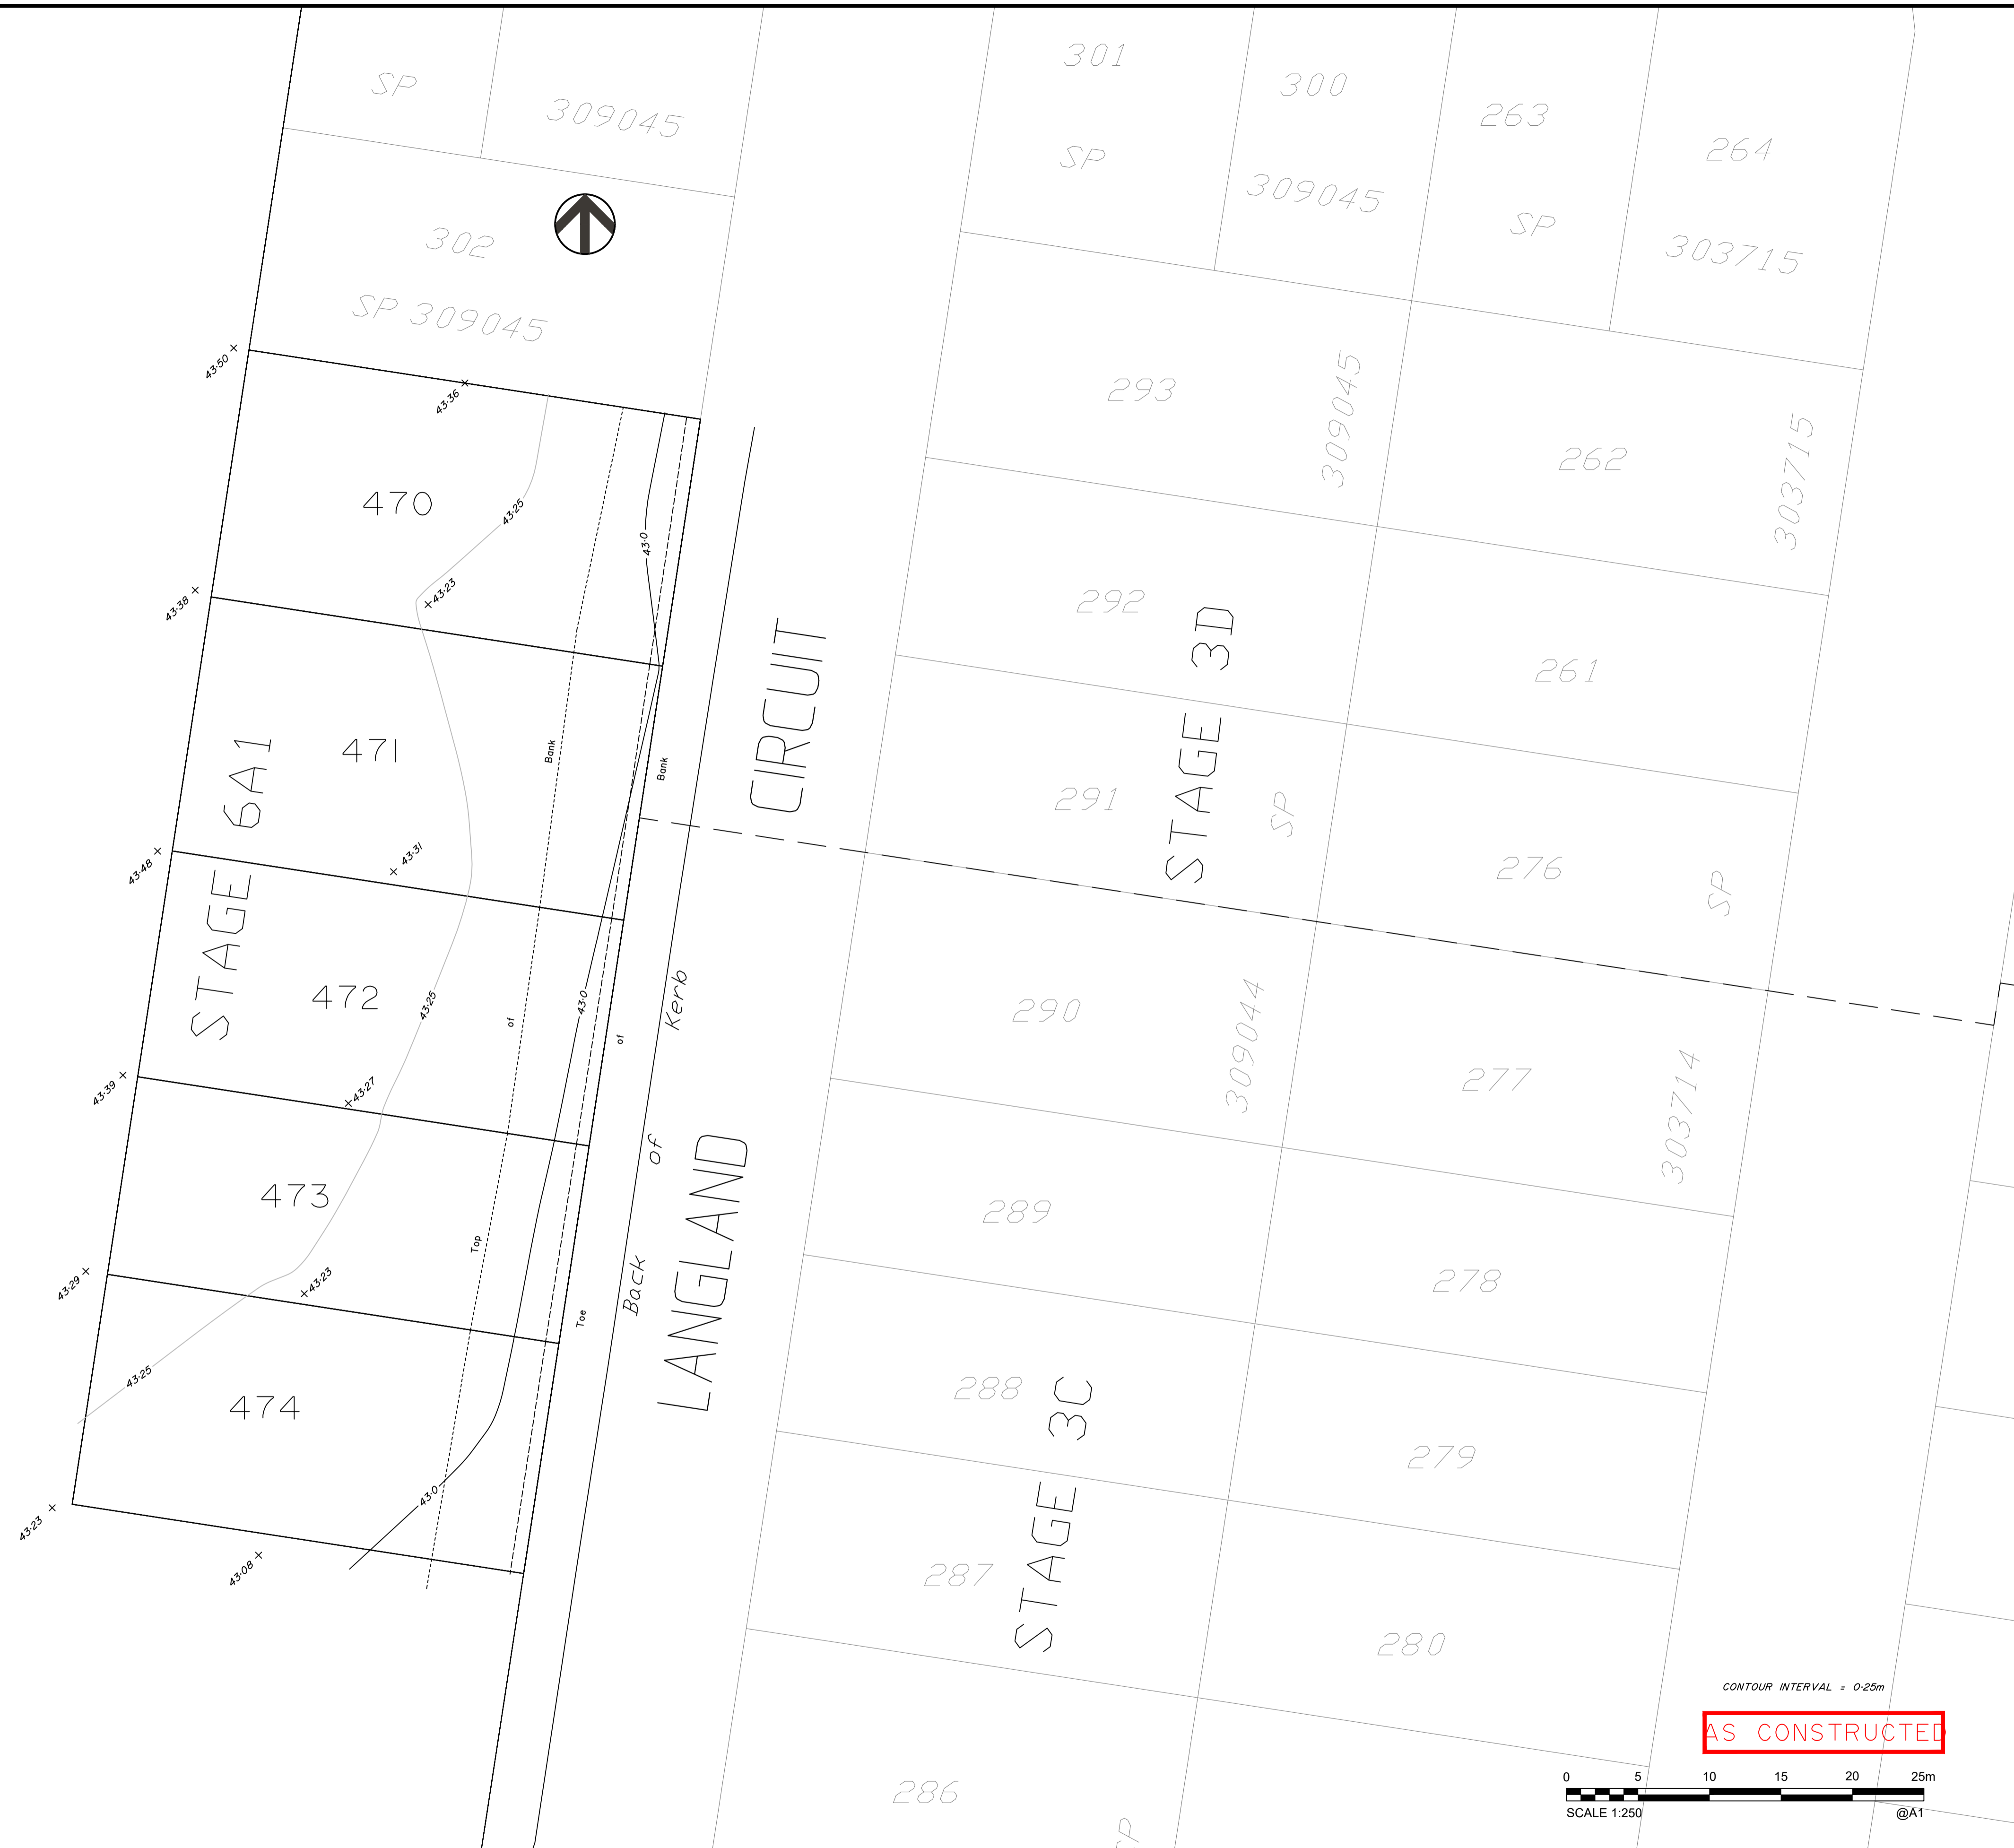

CONTOUR INTERVAL = 0.25m
AS CONSTRUCTED

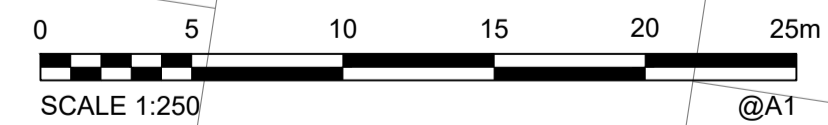

A1	A	23/08/2022	PROGRESS PLOT	JMc					
	INDEX	DATE	REVISIONS	DRAWN	CHECKED	PASSED	INITIALS	DATE	

BRISBANE (07) 3566 4700 WHITSUNDAYS (07) 4346 5900
 MACKAY (07) 4507 9700 CAIRNS (07) 4252 9400
 veris.com.au
 ACN 615 735 727
 Veris Australia Pty Ltd



IPSWICH CITY COUNCIL
 DAWN WALLOON STAGE 6A1
 AS CONSTRUCTED
 EARTHWORKS

SCALE	1:250 @A1
SHEET	1 OF 1 SHEETS
DRAWING NO.	401905-6A1-AE01