

LEGEND

- NEW HYDRANT
- NEW SLUICE VALVE
- NEW TEE
- NEW END CAP
- NEW TAPER
- NEW WATER SERVICE CONDUIT (Ø100 PVC-D PN16)
- NEW WATER SERVICE (Ø25 PE PN16)
- NEW WATER METER
- NEW WATER HOUSE CONNECTION (READY TAP)
- NEW WATER MAIN (Ø100 PVC-D PN16)
- NEW WATER MAIN (Ø150 PVC-D PN16)
- NEW WATER MAIN (Ø125 or Ø180 PE-100 PN16)
- EXISTING HYDRANT
- EXISTING SLUICE VALVE
- EXISTING TEE
- EXISTING WATER HOUSE CONNECTION (READY TAP)
- EXISTING WATER MAIN

1
SP331771

REGISTERED SURVEYOR'S CERTIFICATION

I, Veris Australia Pty Ltd, hereby certify that the vertical and horizontal locations and dimensions shown on this plan are a true and correct record and were located by survey.


Alister Byron 6448 29/08/2022
Registered Surveyor (sig.) Reg. Surveyor No. Date

ENGINEER'S CERTIFICATION

I, _____, hereby certify that:

- The information contained in this drawing / document is in compliance with approved drawings and design.
- The new water and sewerage works defined by this drawing have been designed and constructed in accordance with the SEQ Code.
- This represents an accurate record of as-constructed works.
- I accept responsibility for the information contained in this drawing / document.

RPEQ (signature) RPEQ No. Date:

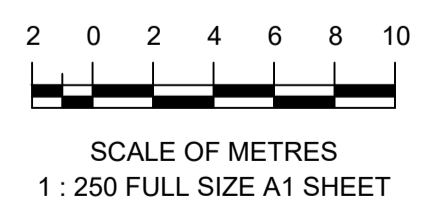

A1	REV NO	DATE	REVISION PURPOSE / DESCRIPTION	DRAWN	RPEQ	RPEQ No	DRAWN	INITIALS	DATE
	A	22/08/2022	WATER METERS STAGE 6A1	JMc					

veris

BRISBANE (07) 3666 4700
WHITSUNDAYS (07) 4945 6600
MACKAY (07) 4957 9700
CAIRNS (07) 4052 9400

veris.com.au
ACN 615 735 727
Veris Australia Pty Ltd



DAWN WALLOON
Langland Circuit, Walloon

STAGE 6A1
AS CONSTRUCTED WATER

DRAWING STATUS AS CONSTRUCTED	
SHEET 1 OF 1 SHEETS	
DRAWING NO. 401905-6A1-AW01	REV. A