



**REGISTERED SURVEYOR'S CERTIFICATION**

I, Veris Australia Pty Ltd, hereby certify that the vertical and horizontal locations and dimensions shown on this plan are a true and correct record and were located by survey.

*Alister Byrom* 6448 3/05/2023  
 Registered Surveyor (sig.) Reg. Surveyor No. Date


**ENGINEER'S CERTIFICATION**

I, \_\_\_\_\_, hereby certify that:

- The information contained in this drawing / document is in compliance with approved drawings and design.
- This represents an accurate record of as-constructed works.
- I accept responsibility for the information contained in this drawing / document.

\_\_\_\_\_  
 RPEQ (signature) RPEQ No. Date:

**AS CONSTRUCTED**

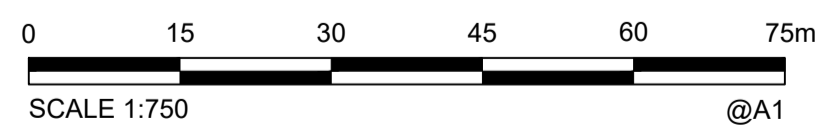


**A1**

C	03/05/2023	FINAL SURFACE SURVEY	JMc		
B	04/04/2023	ADD SPOT HEIGHTS	JMc		
A	13/03/2023	PROGRESS PLOT	JMc		
INDEX	DATE	REVISIONS	DRAWN	CHECKED	PASSED

DRAWN	JMc	13/03/2023
CHECKED		
PASSED		
INITIALS		DATE




BRISBANE (07) 3066 4700 WHITSUNDAYS (07) 4945 6600  
 MACKAY (07) 4957 7100 CAIRNS (07) 4522 9600  
 veris.com.au  
 ACN 615 735 727  
 Veris Australia Pty Ltd

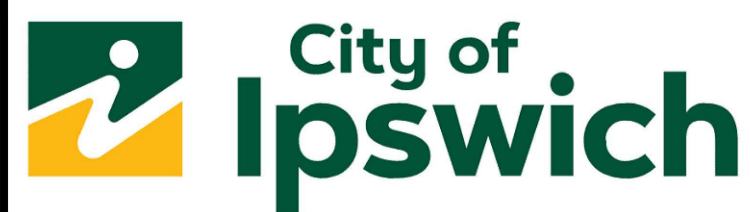

**IPSWICH CITY COUNCIL**

WATERLEA WALLOON STAGE 6B1  
AS CONSTRUCTED  
FINAL SURFACE

SCALE	1:750 @A1
SHEET	1 OF 4 SHEETS
DRAWING NO.	401905-6B1-AFS01
	C
	B
	A

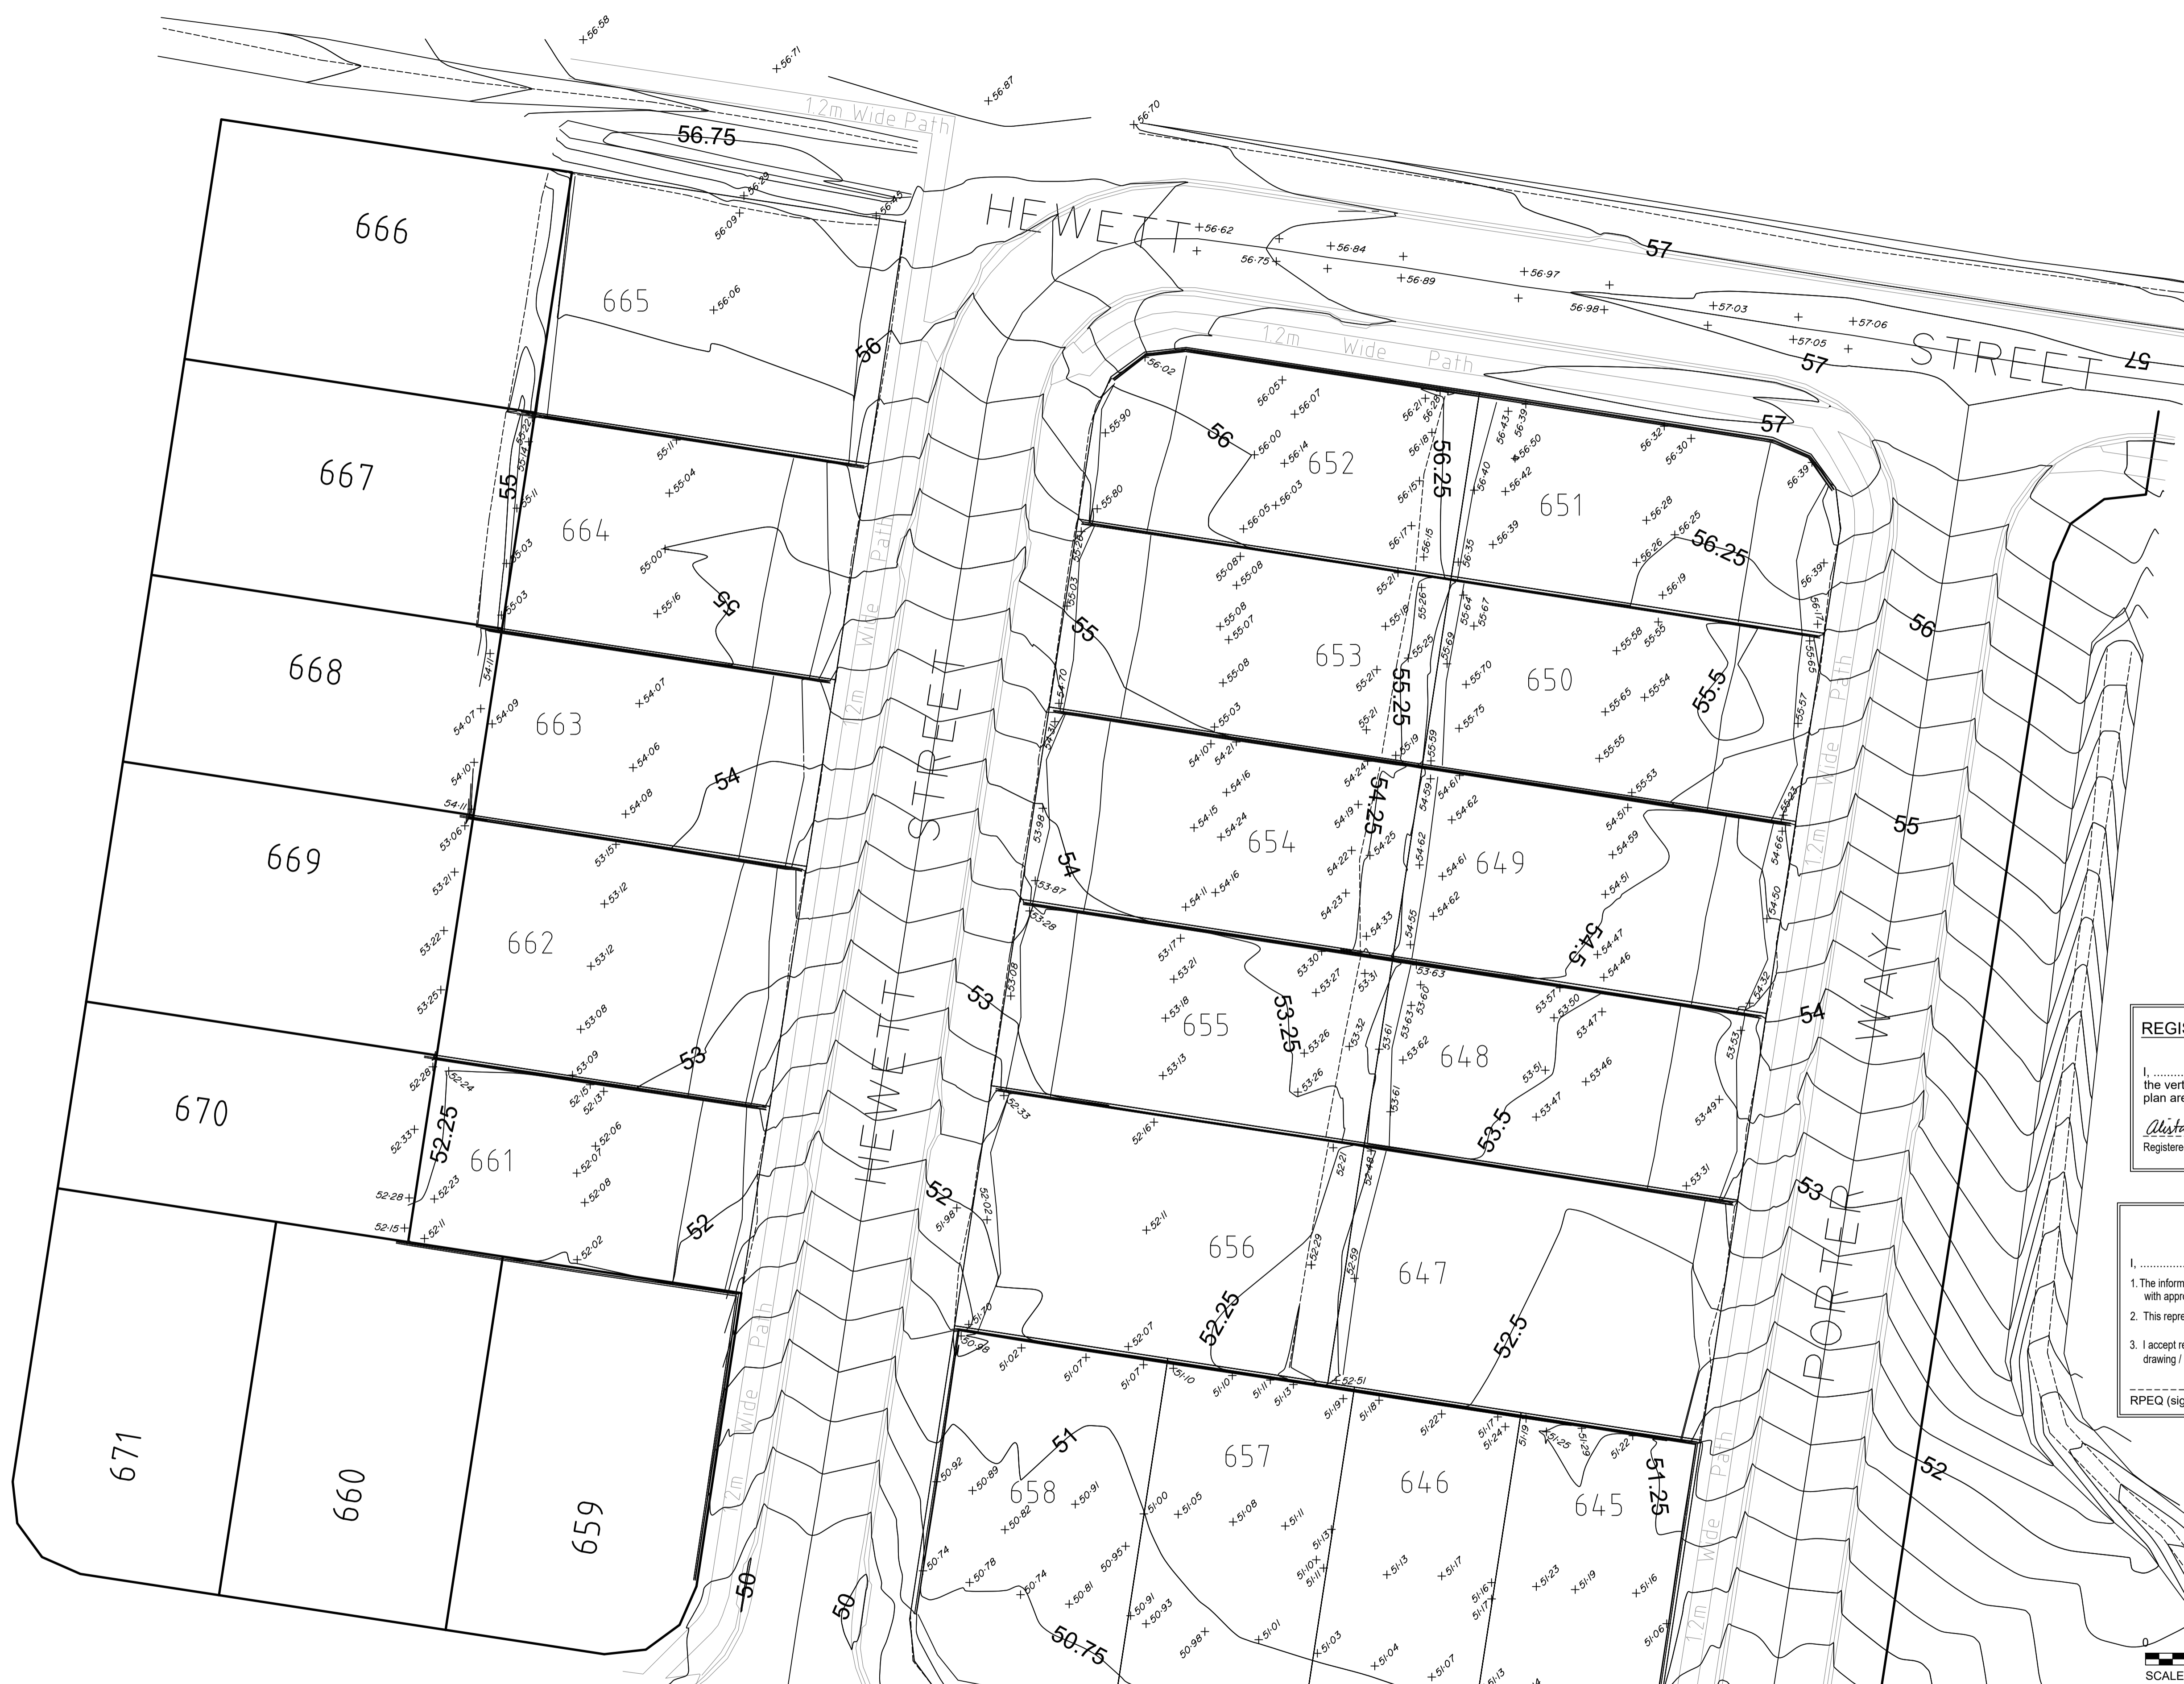

**REGISTERED SURVEYOR'S CERTIFICATION**

I, Veris Australia Pty Ltd hereby certify that the vertical and horizontal locations and dimensions shown on this plan are a true and correct record and were located by survey.

Alister Byrom 6448 3/05/2023  
Registered Surveyor (sig.) Reg. Surveyor No. Date


**ENGINEER'S CERTIFICATION**

I, \_\_\_\_\_ hereby certify that:

- The information contained in this drawing / document is in compliance with approved drawings and design.
- This represents an accurate record of as-constructed works.
- I accept responsibility for the information contained in this drawing / document.

RPEQ (signature) RPEQ No. Date:

**AS CONSTRUCTED**

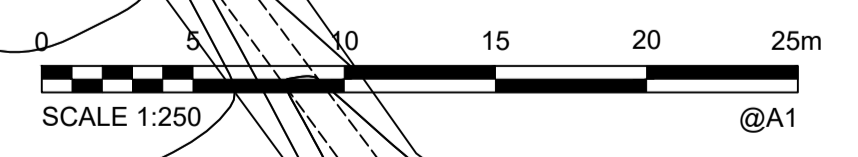

**A1**

C	03/05/2023	FINAL SURFACE SURVEY	JMc		
B	04/04/2023	ADD SPOT HEIGHTS	JMc		
A	13/03/2023	PROGRESS PLOT	JMc		
INDEX	DATE	REVISIONS	DRAWN	CHECKED	PASSED

DRAWN	JMc	13/03/2023
CHECKED		
PASSED		
INITIALS		DATE



BRISBANE WHITSUNDAYS  
(07) 3066 4700 (07) 4945 6600  
MACKAY CAIRNS  
(07) 4937 7100 (07) 4522 9600  
veris.com.au  
ACN 615 735 727  
Veris Australia Pty Ltd



**IPSWICH CITY COUNCIL**

WATERLEA WALLOON STAGE 6B1  
AS CONSTRUCTED  
FINAL SURFACE

SCALE	1:250 @A1
SHEET 2 OF 4 SHEETS	
DRAWING NO.	
401905-6B1-AFS01	
C	
B	
A	



**REGISTERED SURVEYOR'S CERTIFICATION**

I, Veris Australia Pty Ltd, hereby certify that the vertical and horizontal locations and dimensions shown on this plan are a true and correct record and were located by survey.

Alistair Bayram 6448 3/05/2023  
 Registered Surveyor (sig.) Reg. Surveyor No. Date


**ENGINEER'S CERTIFICATION**

I, \_\_\_\_\_, hereby certify that:

- The information contained in this drawing / document is in compliance with approved drawings and design.
- This represents an accurate record of as-constructed works.
- I accept responsibility for the information contained in this drawing / document.


\_\_\_\_\_  
 RPEQ (signature) RPEQ No. Date:

**AS CONSTRUCTED**

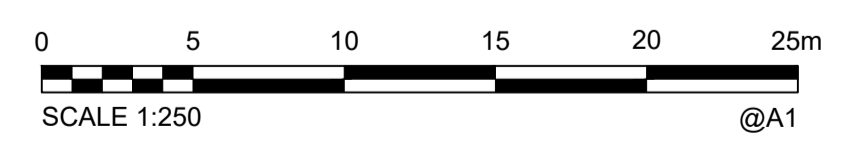


<b>A1</b>	C	03/05/2023	FINAL SURFACE SURVEY	JMc					
	B	04/04/2023	ADD SPOT HEIGHTS	JMc					
	A	13/03/2023	PROGRESS PLOT	JMc					
	INDEX	DATE	REVISIONS	DRAWN	CHECKED	PASSED	INITIALS	DATE	

DRAWN	JMc	13/03/2023
CHECKED		
PASSED		

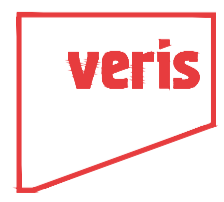


BRISBANE (07) 3066 4700 WHITSUNDAYS (07) 4945 6600  
 MACKAY (07) 4957 7100 CAIRNS (07) 4522 9600  
 veris.com.au  
 ACN 615 735 727  
 Veris Australia Pty Ltd

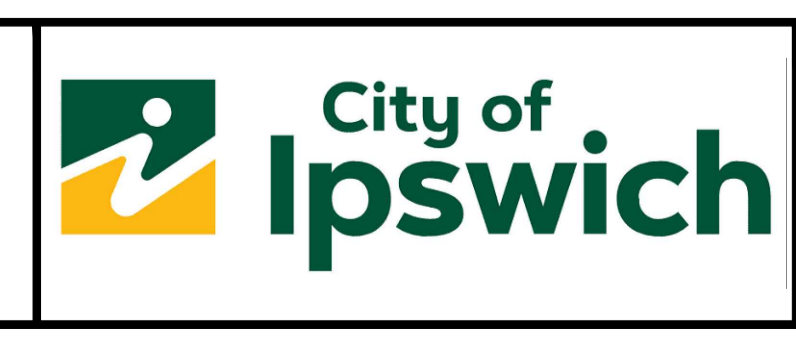

**IPSWICH CITY COUNCIL**

WATERLEA WALLOON STAGE 6B1  
 AS CONSTRUCTED  
 FINAL SURFACE

SCALE	1:250 @A1
SHEET	3 OF 4 SHEETS
DRAWING NO.	
401905-6B1-AFS01	

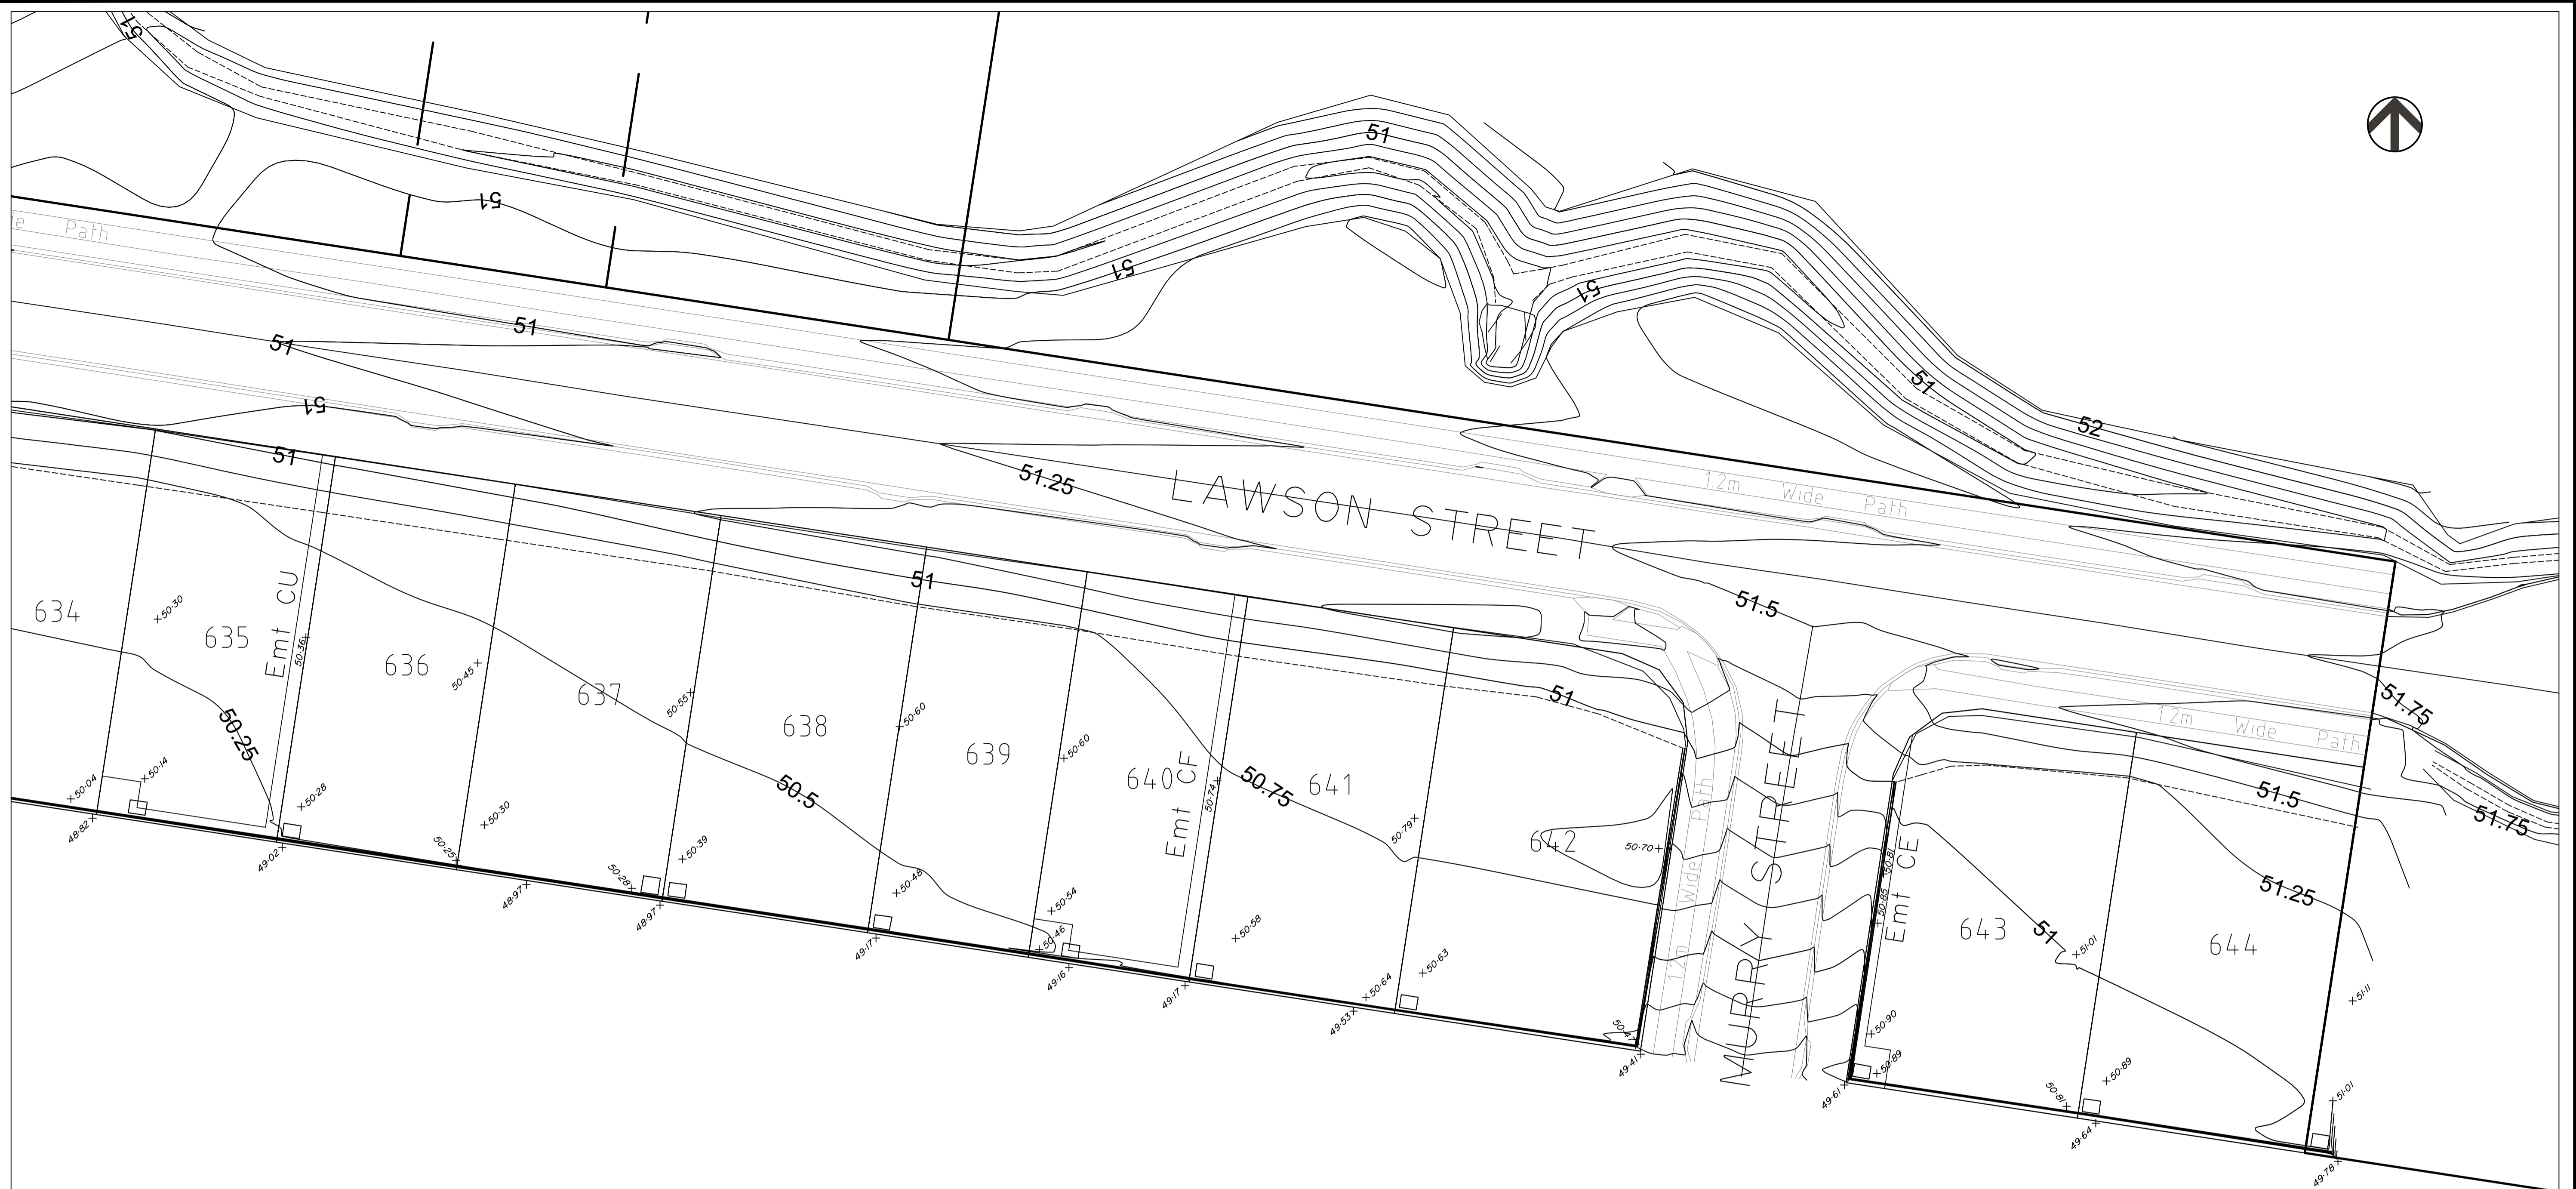

**REGISTERED SURVEYOR'S CERTIFICATION**

I, Veris Australia Pty Ltd hereby certify that the vertical and horizontal locations and dimensions shown on this plan are a true and correct record and were located by survey.

*Alister Byrom* 6448 3/05/2023  
 Registered Surveyor (sig.) Reg. Surveyor No. Date


**ENGINEER'S CERTIFICATION**

I, \_\_\_\_\_ hereby certify that:

- The information contained in this drawing / document is in compliance with approved drawings and design.
- This represents an accurate record of as-constructed works.
- I accept responsibility for the information contained in this drawing / document.

\_\_\_\_\_  
 RPEQ (signature) RPEQ No. Date:

**AS CONSTRUCTED**

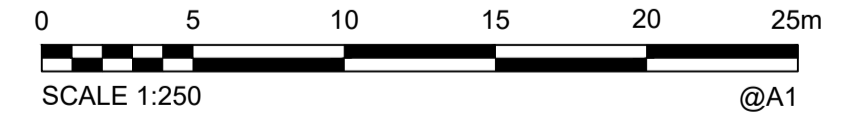

<b>A1</b>	C	03/05/2023	FINAL SURFACE SURVEY	JMc			
	B	04/04/2023	ADD SPOT HEIGHTS	JMc			
	A	13/03/2023	PROGRESS PLOT	JMc			
	INDEX	DATE	REVISIONS	DRAWN	CHECKED	PASSED	

DRAWN	JMc	13/03/2023
CHECKED		
PASSED		
INITIALS		DATE

**veris**  
 BRISBANE (07) 3066 4700 WHITSUNDAYS (07) 4945 6600  
 MACKAY (07) 4957 9100 CAIRNS (07) 4522 9400  
 veris.com.au  
 ACN 615 735 727  
 Veris Australia Pty Ltd



**IPSWICH CITY COUNCIL**  
 WATERLEA WALLOON STAGE 6B1  
 AS CONSTRUCTED  
 DRAINAGE

SCALE	1:250 @A1
SHEET	4 OF 4 SHEETS
DRAWING NO.	
<b>401905-6B1-AFS01</b>	
C	
B	
A	