


LEGEND

42.5	AS CONSTRUCTED CONTOURS (Interval 0.25m)
43	CHANGE OF GRADE
Top of Bank	RETAINING WALL
Bottom of Bank	

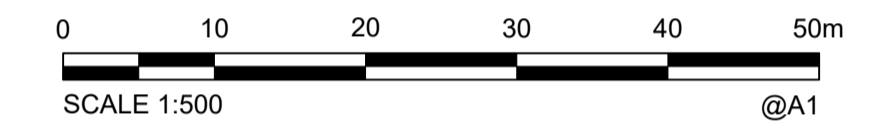

REGISTERED SURVEYOR'S CERTIFICATION

I, Veris Australia Pty Ltd, hereby certify that the vertical and horizontal locations and dimensions shown on this plan are a true and correct record and were located by survey.

[Signature] **6448** **27/01/2026**
Old Registered Surveyor (sig.) Old Reg. Surveyor No. Date

ENGINEER'S CERTIFICATION

I, _____, hereby certify that:

- The information contained in this drawing / document is in compliance with approved drawings and design.
- This represents an accurate record of as-constructed works.
- I accept responsibility for the information contained in this drawing / document.

RPEQ (signature) RPEQ No. Date:

AS CONSTRUCTED

A1	B	20/01/2026	FINAL	JMc		
	A	19/06/2025	PROGRESS PLOT	JMc		
	INDEX	DATE	REVISIONS	DRAWN	CHECKED	PASSED

DRAWN	JMc	19/06/2025
CHECKED		
PASSED		
INITIALS		DATE

veris
 BRISBANE (07) 3860 4700 WHITSUNDAYS (07) 4945 0500
 MACKAY (07) 4697 9700 CAIRNS (07) 4332 3400
 veris.com.au
 ACN 615 735 727
 Veris Australia Pty Ltd



IPSWICH CITY COUNCIL

WATERLEA WALLOON STAGE 6J NE LOTS
 AS CONSTRUCTED
 EARTH WORKS

SCALE	1500 @A1
SHEET	1 OF 2 SHEETS
DRAWING NO.	
	401905-6J-AEW01-B
	B
	A




LEGEND

42.5	-----	AS CONSTRUCTED CONTOURS (Interval 0.25m)
43	-----	Top of Bank
	-----	Bottom of Bank
	-----	CHANGE OF GRADE
	-----	RETAINING WALL

REGISTERED SURVEYOR'S CERTIFICATION

I, Veris Australia Pty Ltd, hereby certify that the vertical and horizontal locations and dimensions shown on this plan are a true and correct record and were located by survey.


 6448 27/01/2026
 Qld Registered Surveyor (sig.) Qld Reg. Surveyor No. Date


ENGINEER'S CERTIFICATION

I, _____, hereby certify that:

- The information contained in this drawing / document is in compliance with approved drawings and design.
- This represents an accurate record of as-constructed works.
- I accept responsibility for the information contained in this drawing / document.

RPEQ (signature) _____ RPEQ No. _____ Date: _____


AS CONSTRUCTED

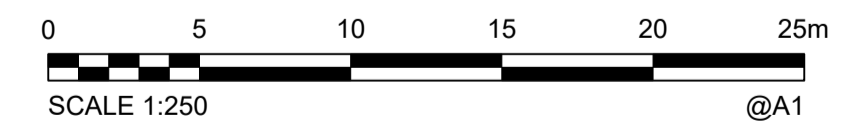

A1

B	20/01/2026	FINAL	JMc		
A	19/06/2025	PROGRESS PLOT	JMc		
INDEX	DATE	REVISIONS	DRAWN	CHECKED	PASSED

DRAWN	JMc	19/06/2025
CHECKED		
PASSED		
INITIALS		DATE

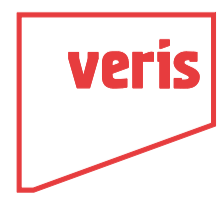

BRISBANE WHITSUNDAYS
 (07) 3066 4700 (07) 4945 6600
 MACKAY CAIRNS
 (07) 4957 7100 (07) 4922 9600
 veris.com.au
 ACN 615 735 727
 Veris Australia Pty Ltd



IPSWICH CITY COUNCIL

WATERLEA WALLOON STAGE 6J NE LOTS
 AS CONSTRUCTED
 EARTH WORKS

SCALE	1:250 @A1
SHEET	2 OF 2 SHEETS
DRAWING NO.	
401905-6J-AEW01-B	
	B
	A