

**REGISTERED SURVEYOR'S CERTIFICATION**

I, Veris Australia Pty Ltd, hereby certify that the vertical and horizontal locations and dimensions shown on this plan are a true and correct record and were located by survey.

----- 6448 -----  
Old Registered Surveyor (sig.) Old Reg. Surveyor No. Date

**ENGINEER'S CERTIFICATION**

I, \_\_\_\_\_, hereby certify that:

- The information contained in this drawing / document is in compliance with approved drawings and design.
- This represents an accurate record of as-constructed works.
- I accept responsibility for the information contained in this drawing / document.

-----  
RPEQ (signature) RPEQ No. Date:

**AS CONSTRUCTED**

<b>A1</b>	C	24/07/2025	CORRECT PIPE DIA- G5/A-G6/A	JMc		
	B	20/06/2025	FINAL	JMc		
	A	30/04/2025	PROGRESS PLOT	JMc		
	INDEX	DATE	REVISIONS	DRAWN	CHECKED	PASSED

DRAWN	JMc	30/04/2025	
CHECKED			
PASSED			
	INITIALS	DATE	

**veris**  
 BRISBANE (07) 3860 4700 WHITSUNDAYS (07) 4945 0500  
 MACKAY (07) 4697 9700 CAIRNS (07) 4232 3400  
 veris.com.au  
 ACN 615 735 727  
 Veris Australia Pty Ltd



**IPSWICH CITY COUNCIL**

WATERLEA WALLOON STAGE 6J NE LOTS  
 AS CONSTRUCTED  
 DRAINAGE

SCALE 1:250 @A1  
 SHEET 1 OF 2 SHEETS  
 DRAWING NO.  
 401905-6J-ASW01-C



**REGISTERED SURVEYOR'S CERTIFICATION**

I, ..... Veris Australia Pty Ltd ..... hereby certify that the vertical and horizontal locations and dimensions shown on this plan are a true and correct record and were located by survey.

..... 6448 .....

Old Registered Surveyor (sig.) Old Reg. Surveyor No. Date


**ENGINEER'S CERTIFICATION**

I, ..... hereby certify that:

- The information contained in this drawing / document is in compliance with approved drawings and design.
- This represents an accurate record of as-constructed works.
- I accept responsibility for the information contained in this drawing / document.

RPEQ (signature) RPEQ No. Date:

**AS CONSTRUCTED**

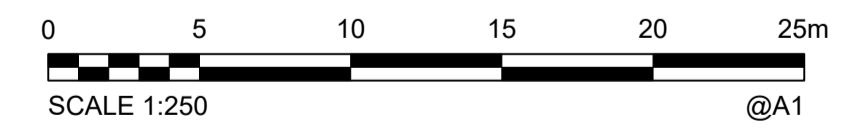

<b>A1</b>	C	24/07/2025	CORRECT PIPE DIA - G5/A-G6/A	JMc		
	B	20/06/2025	FINAL	JMc		
	A	30/04/2025	PROGRESS PLOT	JMc		
	INDEX	DATE	REVISIONS	DRAWN	CHECKED	PASSED

DRAWN	JMc	30/04/2025
CHECKED		
PASSED		
	INITIALS	DATE

**veris**

BRISBANE (07) 3066 4700 WHITSUNDAYS (07) 4945 6600  
 MACKAY (07) 4957 3100 CAIRNS (07) 4522 9600  
 veris.com.au  
 ACN 615 735 727  
 Veris Australia Pty Ltd



**IPSWICH CITY COUNCIL**

WATERLEA WALLOON STAGE 6J NE LOTS  
 AS CONSTRUCTED  
 DRAINAGE

SCALE	1:250 @A1
SHEET	2 OF 2 SHEETS
DRAWING NO.	
401905-6J-ASW01-C	
	C B A