

I, **B.B.H. Pty Ltd**, hereby certify that the vertical and horizontal locations and dimensions shown on this plan are a true and correct record and were located by survey.

Registered Surveyor (sig.) Reg. Surveyor No. 2655 Date: 11/6/2026

Kristopher Boveinis

 (Company's representative Name)

17/06/2026

 (Date)

22272

 (RPEQ)

Being a duly representative of:-
PETER EUSTACE & ASSOCIATES

 (Company Name)

Herby certify that

- The information contained in this drawing / document is in compliance with approved drawings and design supplied under the terms of the contract.
- This represents an accurate "As constructed" record of works carried out and accept responsibility for the information contained in this drawing / document.

COORDINATE DATUM NOTE:
HORIZONTAL COORDINATES (E,N) SUPPLIED ARE MAPPING GRID OF AUSTRALIA (MGA), ZONE 56 BASED ON THE UNIVERSAL TRANSVERSE MERCATOR PROJECTION AND THE GEOCENTRIC DATUM OF AUSTRALIA 2020.

0 5 10 15 20 25m
SCALE 1:250 @A1

[illegible]



 
LEGEND

-  LIGHT

 PILLAR

 PIT

 POLE

 ELECTRICAL CONDUIT
- STREET LIGHT

ELECTRICAL PILLAR

ELECTRICAL PIT

ELECTRICAL POLE

ELECTRICAL CONDUIT

REGISTERED SURVEYOR'S CERTIFICATION

B.B.H. Pty Ltd

I, B.B.H. Pty Ltd, hereby certify that the vertical and horizontal locations and dimensions shown on this plan are a true and correct record and were located by survey.


Registered Surveyor (sig) Reg. Surveyor No. 2655 Date: 11/6/2026

AS CONSTRUCTED CERTIFICATION

Kristopher Boveinis

(Company's representative Name)

(Signature)

17/06/2026

(Date)

22272

(RPEQ)

Being a duly representative of:-

PETER EUSTACE & ASSOCIATES

(Company Name)

Hereby certify that

- The information contained in this drawing / document is in compliance with approved drawings and design supplied under the terms of the contract.
- This represents an accurate "As constructed" record of works carried out and accept responsibility for the information contained in this drawing / document.

FOR CONTINUATION REFER SHEET 1

PILLAR

PILLAR

7008 PROPOSED LOT

7007 PROPOSED LOT

7006 PROPOSED LOT

7005 PROPOSED LOT

7001 PROPOSED LOT

7002 PROPOSED LOT

7003 PROPOSED LOT

3304 PROPOSED LOT

FOR CONTINUATION REFER SHEET 4

COORDINATE DATUM NOTE:

HORIZONTAL COORDINATES (E,N) SUPPLIED ARE MAPPING GRID OF AUSTRALIA (MGA), ZONE 56 BASED ON THE UNIVERSAL TRANSVERSE MERCATOR PROJECTION AND THE GEOCENTRIC DATUM OF AUSTRALIA 2020.

AS CONSTRUCTED



A1

PE CONSULTING ENGINEERS

STREET ADDRESS: U14, 39 Lawrence Dr, Nerang QLD 4211
POSTAL ADDRESS: PO Box 2833, Nerang QLD 4211
TELEPHONE: (07) 5590 1425
EMAIL: mail@pece.com.au
WEB: pece.com.au



IPSWICH CITY COUNCIL


34 LOT SUBDIVISION
DAWN ESTATE STAGE 7
ELECTRICAL CAPTURE

SCALE 1:250

SHEET 1 OF 4 SHEETS

DRAWING NO.

0

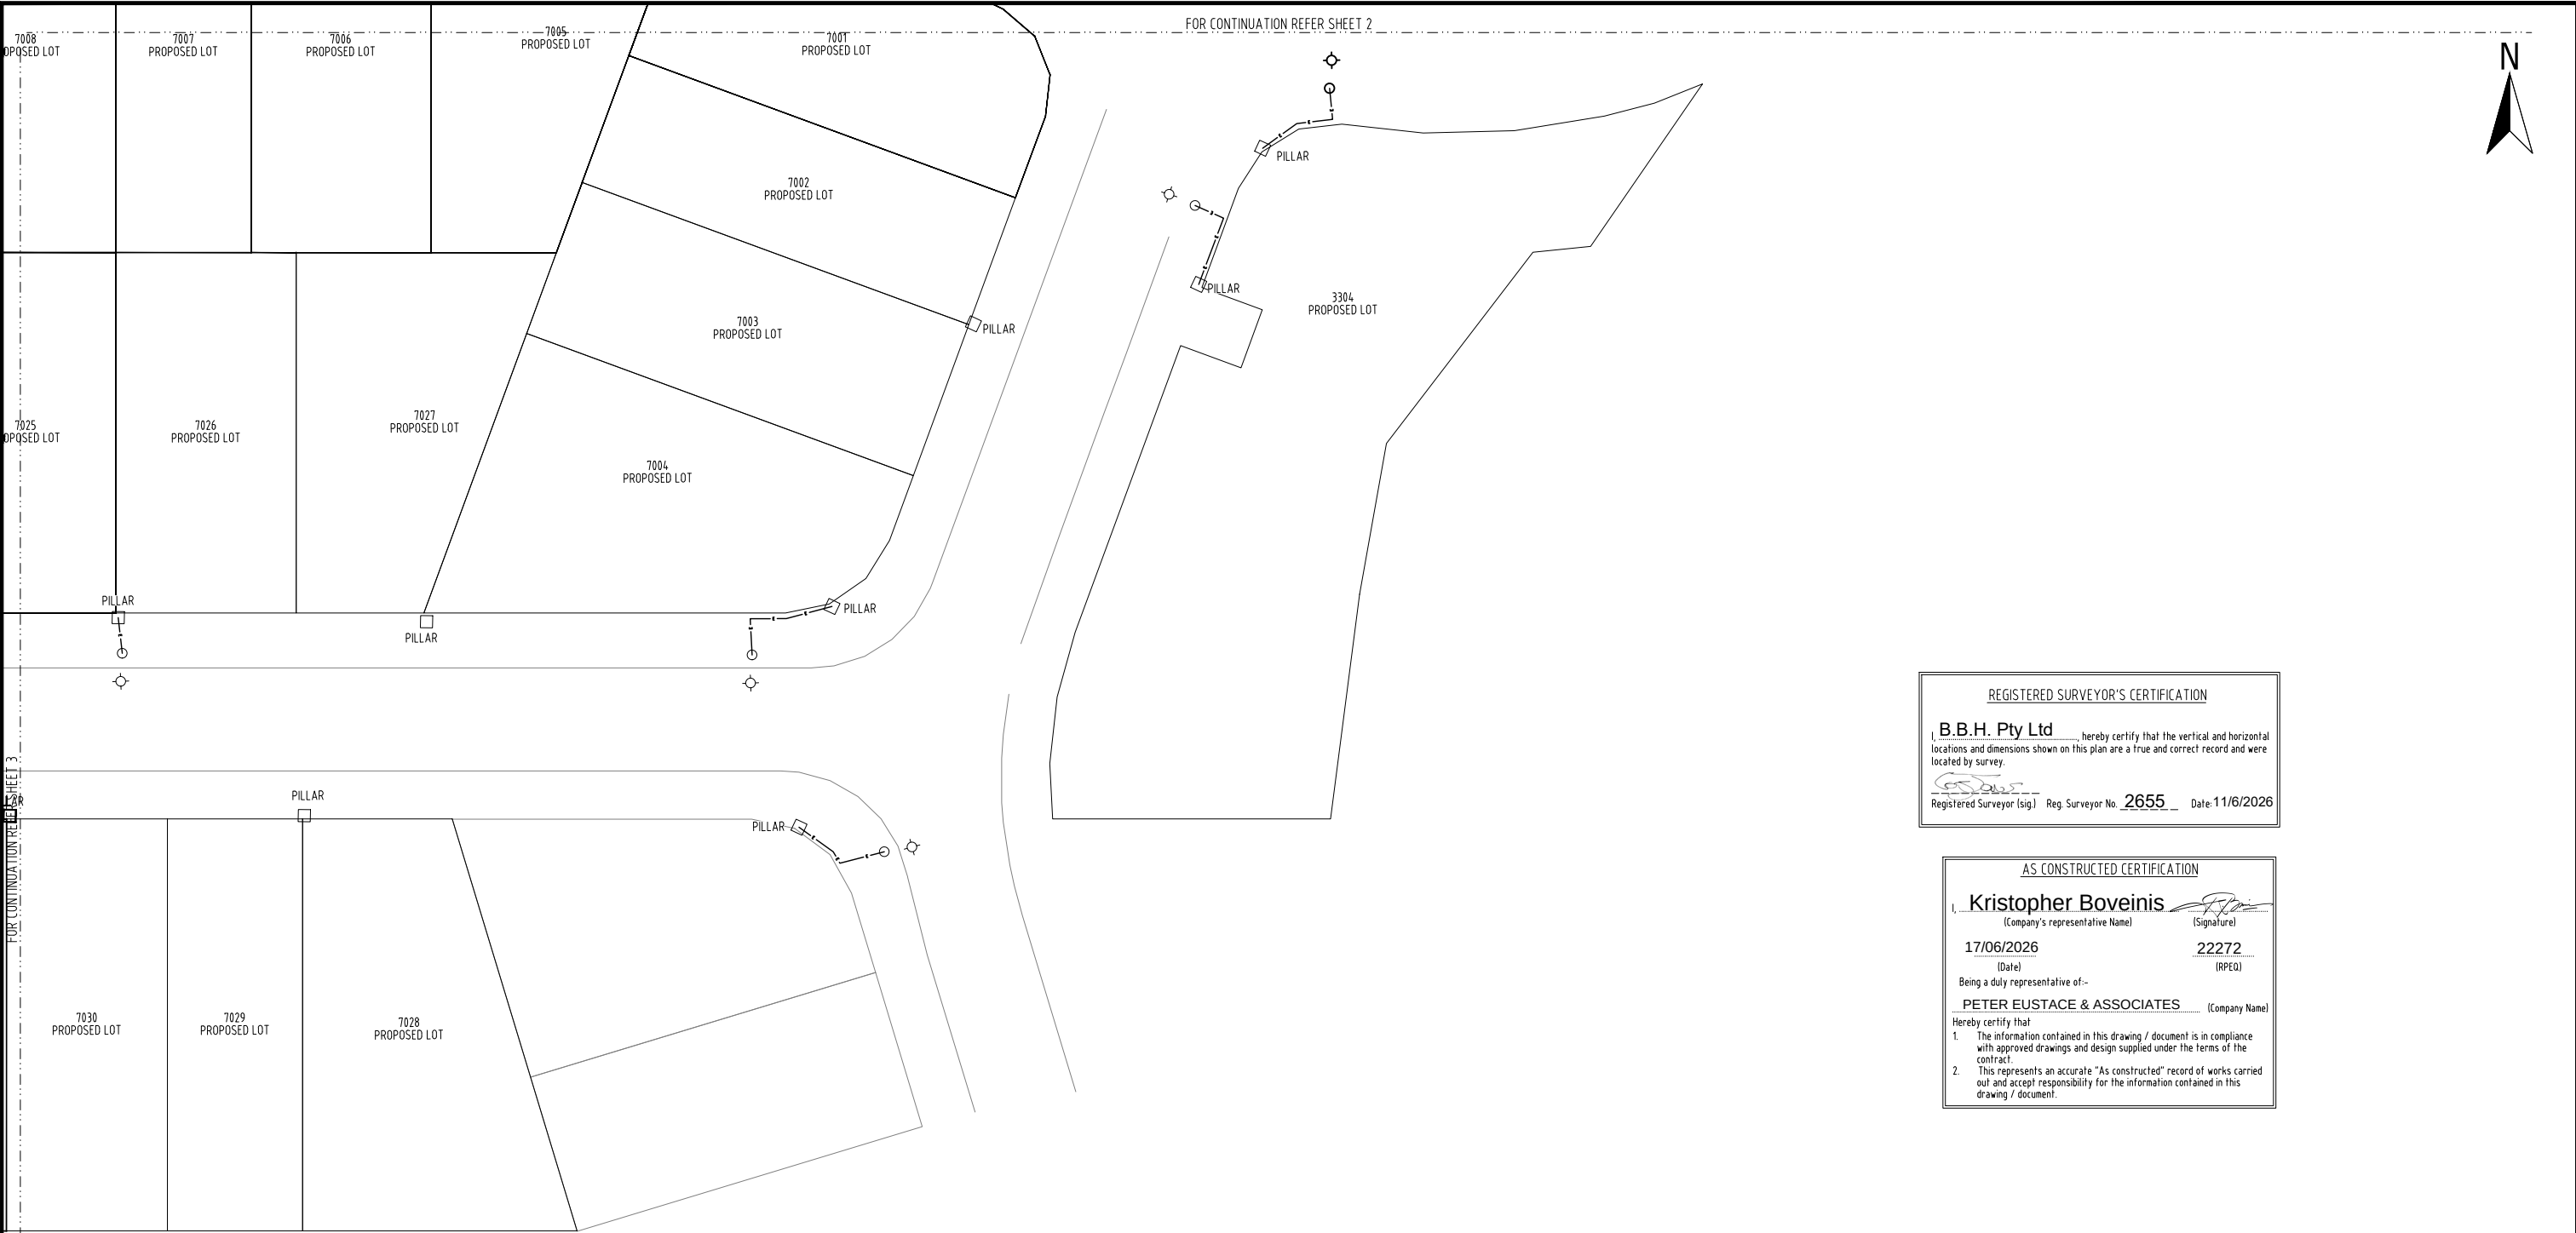

REGISTERED SURVEYOR'S CERTIFICATION

I, **B.B.H. Pty Ltd**, hereby certify that the vertical and horizontal locations and dimensions shown on this plan are a true and correct record and were located by survey.

[Signature]
Registered Surveyor (sig.) Reg. Surveyor No. **2655** Date: **11/6/2026**

AS CONSTRUCTED CERTIFICATION

I, **Kristopher Boveinis**,
(Company's representative Name) (Signature)

17/06/2026 **22272**
(Date) (RPEQ)

Being a duly representative of:-
PETER EUSTACE & ASSOCIATES (Company Name)


Hereby certify that

- The information contained in this drawing / document is in compliance with approved drawings and design supplied under the terms of the contract.
- This represents an accurate "As constructed" record of works carried out and accept responsibility for the information contained in this drawing / document.

LEGEND

- LIGHT
- PILLAR
- PIT
- POLE
- ELECTRICAL CONDUIT
- STREET LIGHT
- ELECTRICAL PILLAR
- ELECTRICAL PIT
- ELECTRICAL POLE
-

COORDINATE DATUM NOTE:
HORIZONTAL COORDINATES (E,N) SUPPLIED ARE MAPPING GRID OF AUSTRALIA (MGA), ZONE 56 BASED ON THE UNIVERSAL TRANSVERSE MERCATOR PROJECTION AND THE GEOCENTRIC DATUM OF AUSTRALIA 2020.

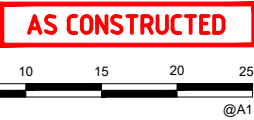

A1																																																																																																																																																																																																																																																																																																																																																																																																																																																																																																																																																																																																																																																																																																																																																																																																																																																																																																																																																																																																																																																																																																																																																																																																																																																																																																																																																																																																																										
----	--	--	