


	PAVEMENT DETAILS	ASSUMED CBR (%)	ESA'S	ROAD TYPE
	35mm A.C. SURFACING 125mm BASE TYPE 2.1 100mm SUB-BASE TYPE 2.3 300mm LOWER SUB-BASE TYPE 2.5	10	1.0×10^5	COLLIE WAY, PRESGRAVE WAY & MATSON STREET

	LIP-IN-LINE GULLY PIT
	LIP-IN-LINE GULLY PIT (ON MH)
	MAINTENANCE HOLE (PRECAST CONCRETE)
	DRAINAGE PIPE
	EXISTING DRAINAGE PIPE
	PRAM RAMP
	PATHWAY
	MOUNTABLE KERB AND CHANNEL - M1 (IPWEAQ RS-080)

Oliver Hartigan
I, _____ (Company's representative Name)
25 September 2026 **27508**
(Date) (RPEQ)
Being a duly representative of:-
Egis Consulting Pty Ltd (Company Name)
Herby certify that
1. Information contained in this drawing / document is in compliance with approved drawings and design supplied under the terms of the contract.
2. This represents an accurate "As constructed" record of works carried out and accept responsibility for the information contained in this drawing / document.

I, **B.B.H. Pty Ltd** hereby certify that the vertical and horizontal locations and dimensions shown on this plan are a true and correct record and were located by survey.

Registered Surveyor (RLD) [sig.] Reg. Surveyor No. **2655** Date: **25/9/26**

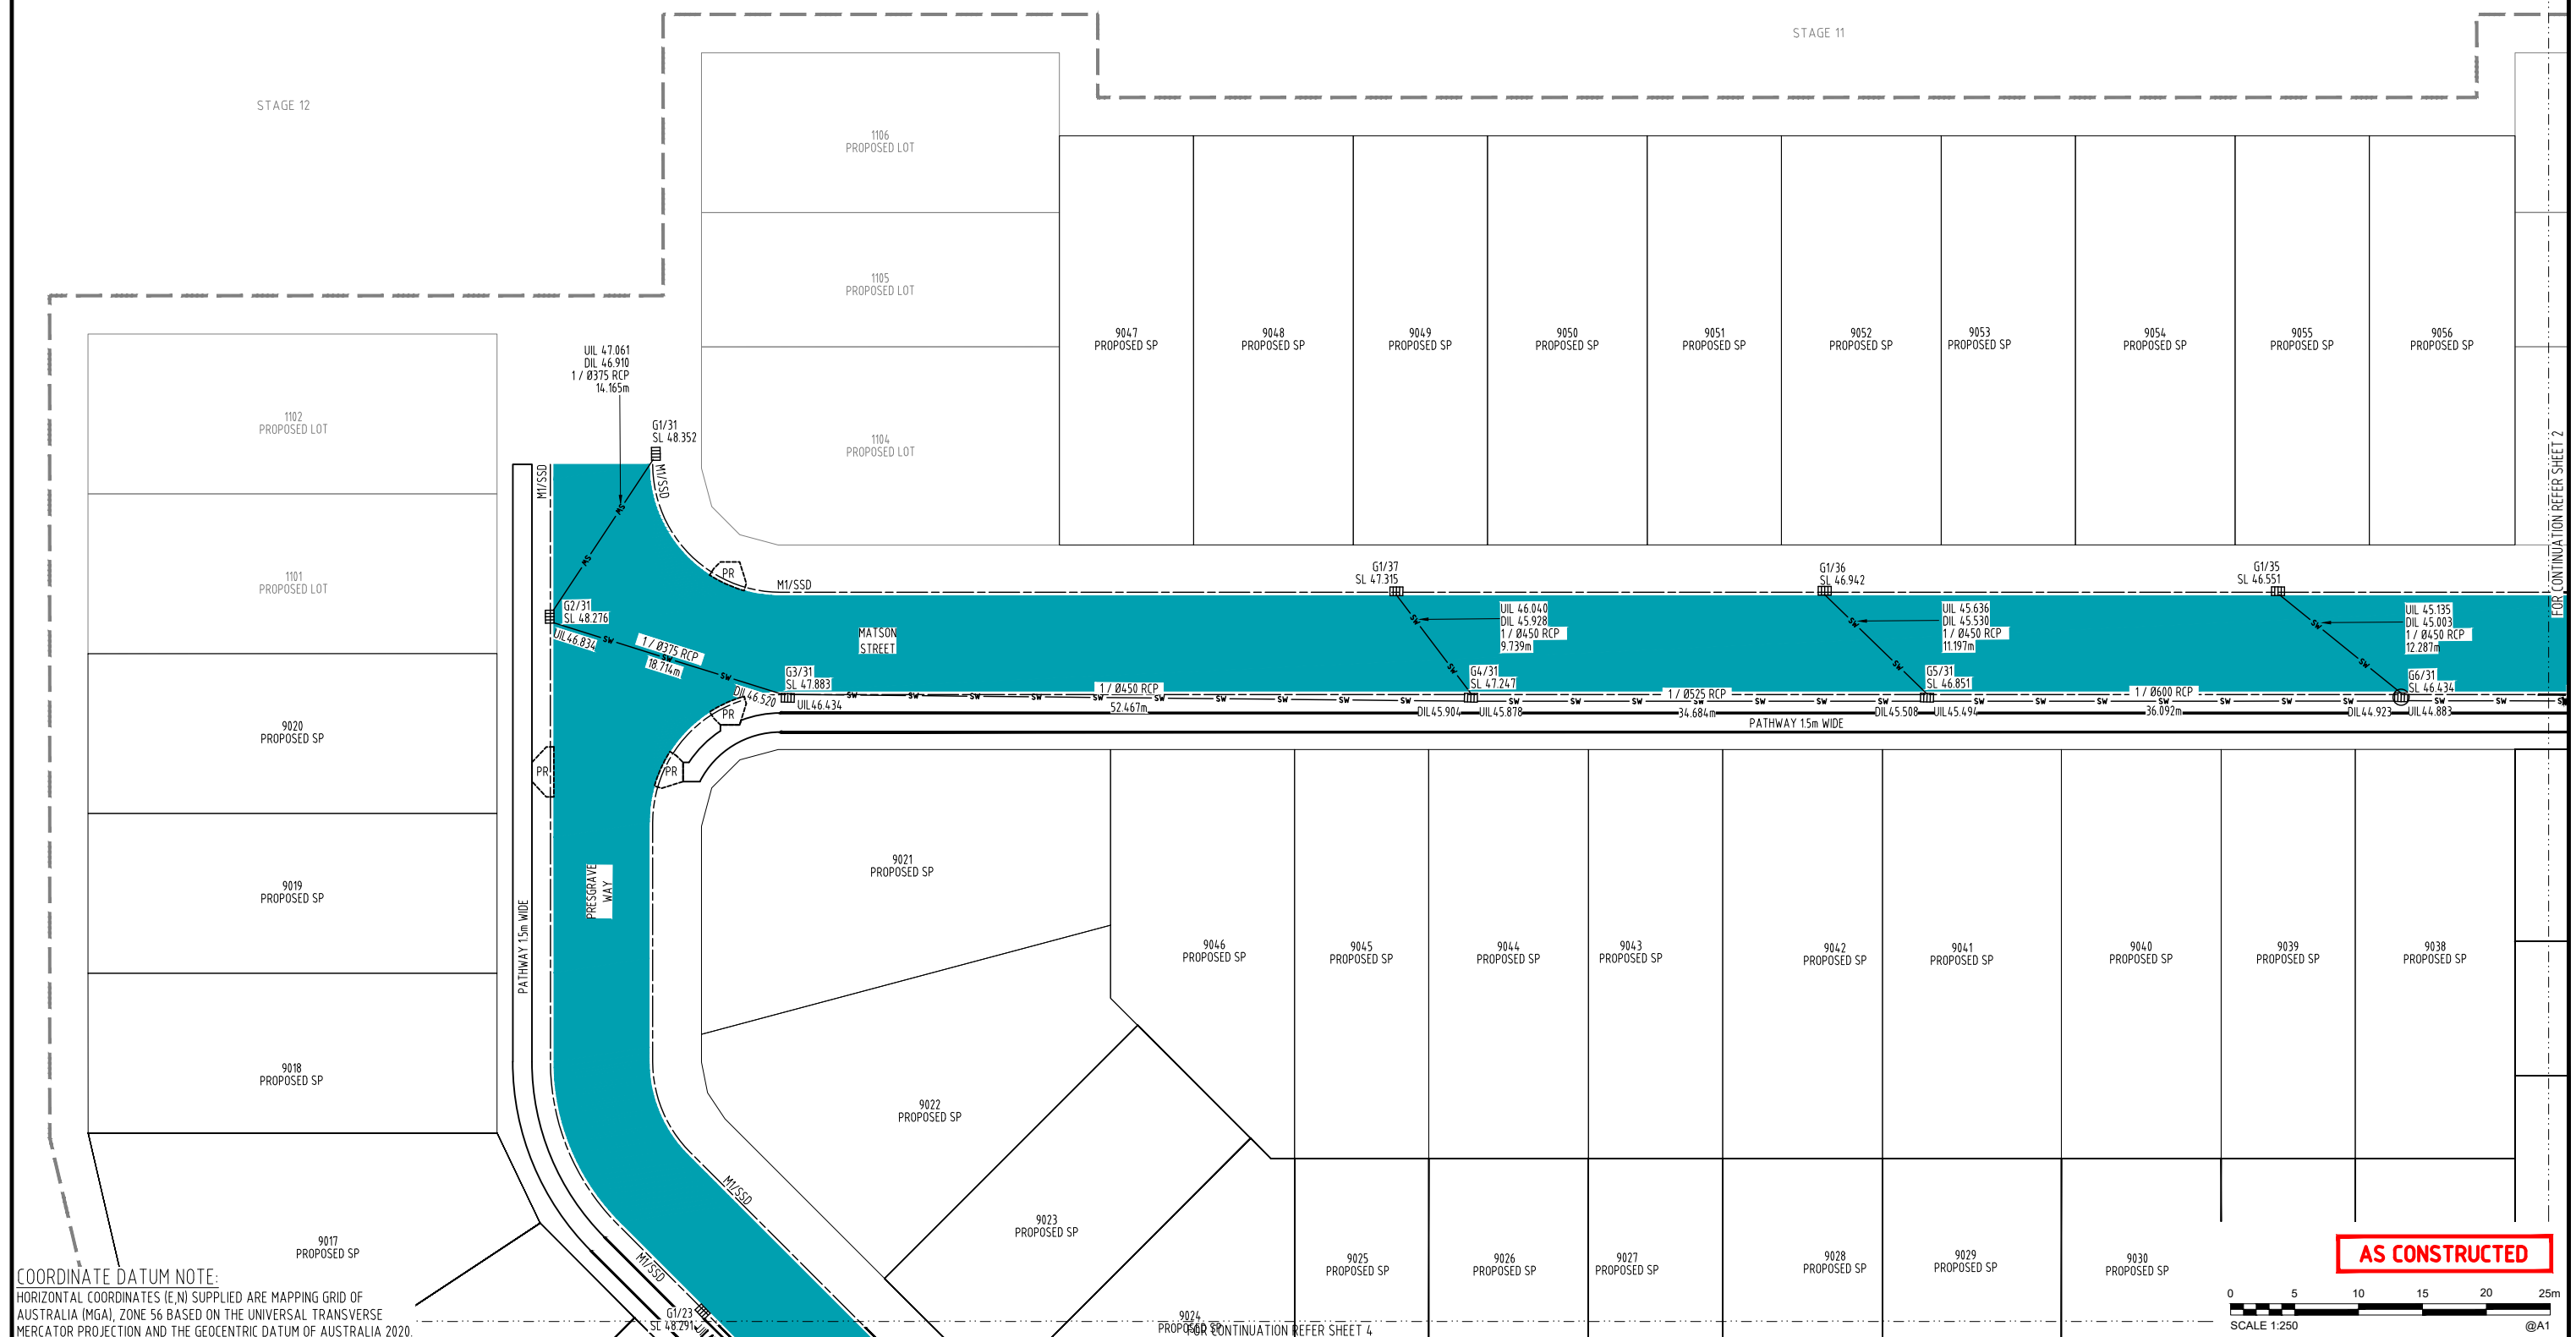

AS CONSTRUCTED

A1

[illegible]

DRAWN	JB	02/09/2026
CHECKED	MT	02/09/2026
PASSED		
	INITIALS	DATE



IPSWICH CITY COUNCIL

AS CONSTRUCTED STORMWATER
DAWN WESTERN PRECINCT -STAGE 9

SCALE	1:250
SHEET 1 OF 4 SHEETS	
DRAWING NO.	

	PAVEMENT DETAILS	ASSUMED CBR (%)	ESA'S	ROAD TYPE
	35mm A.C. SURFACING 125mm BASE TYPE 2.1 100mm SUB-BASE TYPE 2.3 300mm LOWER SUB-BASE TYPE 2.5	10	1.0 x 10 ⁵	COLLIE WAY, PRESGRAVE WAY & MATSON STREET



	LIP-IN-LINE GULLY PIT
	LIP-IN-LINE GULLY PIT (ON MH)
	MAINTENANCE HOLE (PRECAST CONCRETE)
	DRAINAGE PIPE
	EXISTING DRAINAGE PIPE
	PRAM RAMP
	PATHWAY
	MOUNTABLE KERB AND CHANNEL - M1 (IPWEAQ RS-080)



COORDINATE DATUM NOTE:
HORIZONTAL COORDINATES (E,N) SUPPLIED ARE MAPPING GRID OF AUSTRALIA (MGA), ZONE 56 BASED ON THE UNIVERSAL TRANSVERSE MERCATOR PROJECTION AND THE GEOCENTRIC DATUM OF AUSTRALIA 2020.

AS CONSTRUCTED CERTIFICATION	
Oliver Hartigan	
(Company's representative Name)	(Signature)
25 September 2026	27508
(Date)	(RPQ)
Being a duly representative of -	
Herby Consulting Pty Ltd	(Company Name)
Hereby certify that	
1. The information contained in this drawing / document is in compliance with approved drawings and design supplied under the terms of the contract.	
2. This represents an accurate "As constructed" record of works carried out and accept responsibility for the information contained in this drawing / document.	

REGISTERED SURVEYOR'S CERTIFICATION

I, **B.B.H. Pty Ltd**, hereby certify that the vertical and horizontal locations and dimensions shown on this plan are a true and correct record and were located by survey.


Registered Surveyor (Q/LD) [sig.] Reg. Surveyor No. **2655** Date: **25/9/26**

AS CONSTRUCTED



A1						
	0	02/09/2026	AS CONSTRUCTED DETAILS	JB	MT	
	INDEX	DATE	REVISIONS	DRAWN	CHECKED	PASSED

DRAWN	JB	02/09/2026
CHECKED	MT	02/09/2026
PASSED		
	INITIALS	DATE



IPSWICH CITY COUNCIL

AS CONSTRUCTED STORMWATER
DAWN WESTERN PRECINCT -STAGE 9

SCALE		1:250
SHEET 2 OF 4 SHEETS		
DRAWING NO.		
		0

