
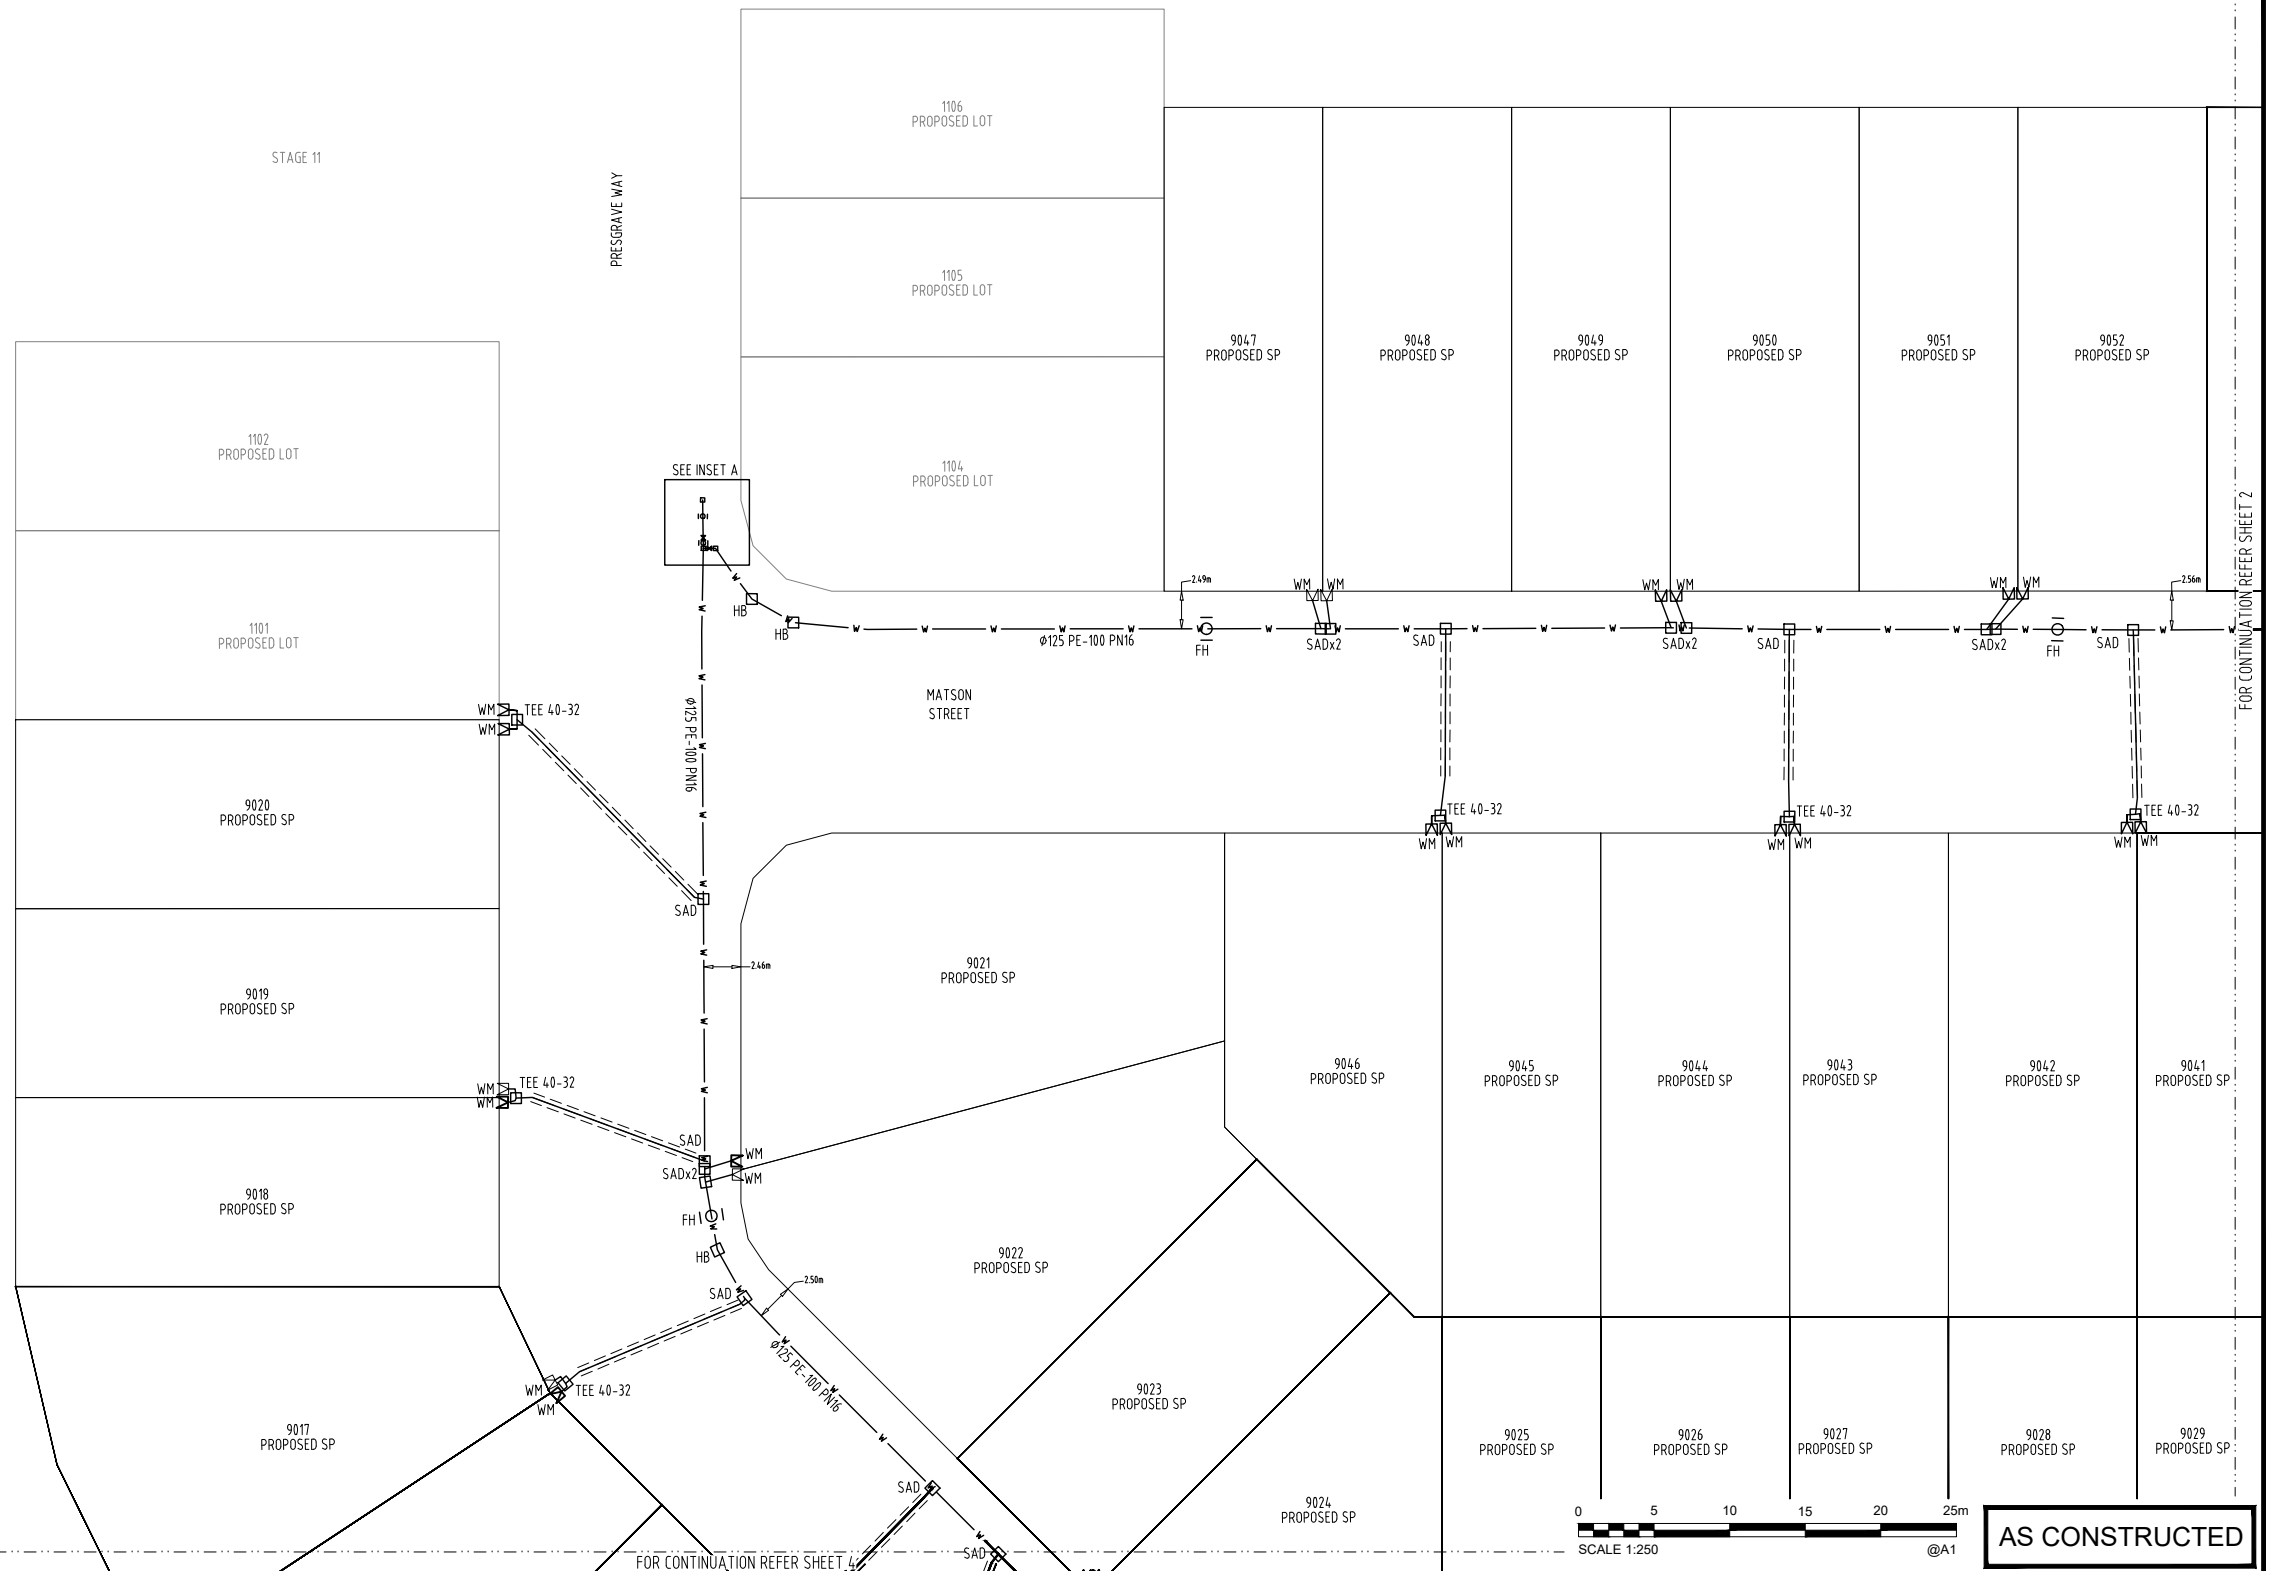


	WATER MAIN (PE-100 PN16)
	SERVICE PIPE (ø25 PE-100 PN16) U.N.O
	SERVICE PIPE CROSSING ROAD (ø40 PE-100 PN16)
	CONDUIT PIPE (ø100 PVC-M PN9)
	EXISTING WATER MAIN
	WATER METER (ø20 ELSTER V100)
	FIRE HYDRANT
	DUCKFOOT FIRE HYDRANT
	TEE
	SADDLE
	HORIZONTAL BEND
	END CAP
	STOP/GATE VALVE
	REDUCER

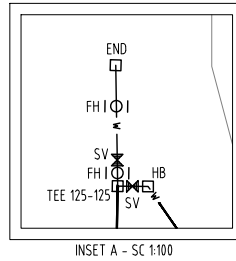

I, ..., hereby certify that the as-constructed details shown on this drawing are a true and accurate record of the construction works, in compliance with the approved drawings and approved design.

RPEQ (signature) _____ RPEQ No. _____ Date: _____

I, B.B.H. Pty Ltd hereby certify that the vertical and horizontal locations and dimensions shown on this plan are a true and correct record and were located by survey.

Registered Surveyor (QLD) (sig.) Reg. Surveyor No. 2655 Date: 25/9/26

COORDINATE DATUM NOTE:
HORIZONTAL COORDINATES(E,N) SUPPLIED ARE MAPPING GRID OF AUSTRALIA(MGA), ZONE 56 BASED ON THE UNIVERSAL TRANSVERSE MERCATOR PROJECTION AND THE GEOCENTRIC DATUM OF AUSTRALIA 2020.

FOR CONTINUATION REFER SHEET 4

DAWN WESTERN PRECINCT STAGE 9
AS-CONSTRUCTED WATER SUPPLY
UU REFERENCE NUMBER: 25-PNT-77826

AS CONSTRUCTED

SCALE	1:250
SHEET 1 OF 8 SHEETS	

DRAWING NO.

—

FOR CONTINUATION REFER SHEET 2

A1





© 2023 Egis Consulting Pty Ltd



DRAWN	JB	24/08/2026
CHECKED	FC	24/08/2026
PASSED		
	INITIALS	DATE

0	24/08/2026	AS CONSTRUCTED DETAILS	JB	FC
INDEX	DATE	REVISIONS	DRAWN	CHECKED PASSED

FOR CONTINUATION REFER SHEET 1

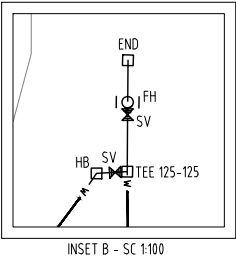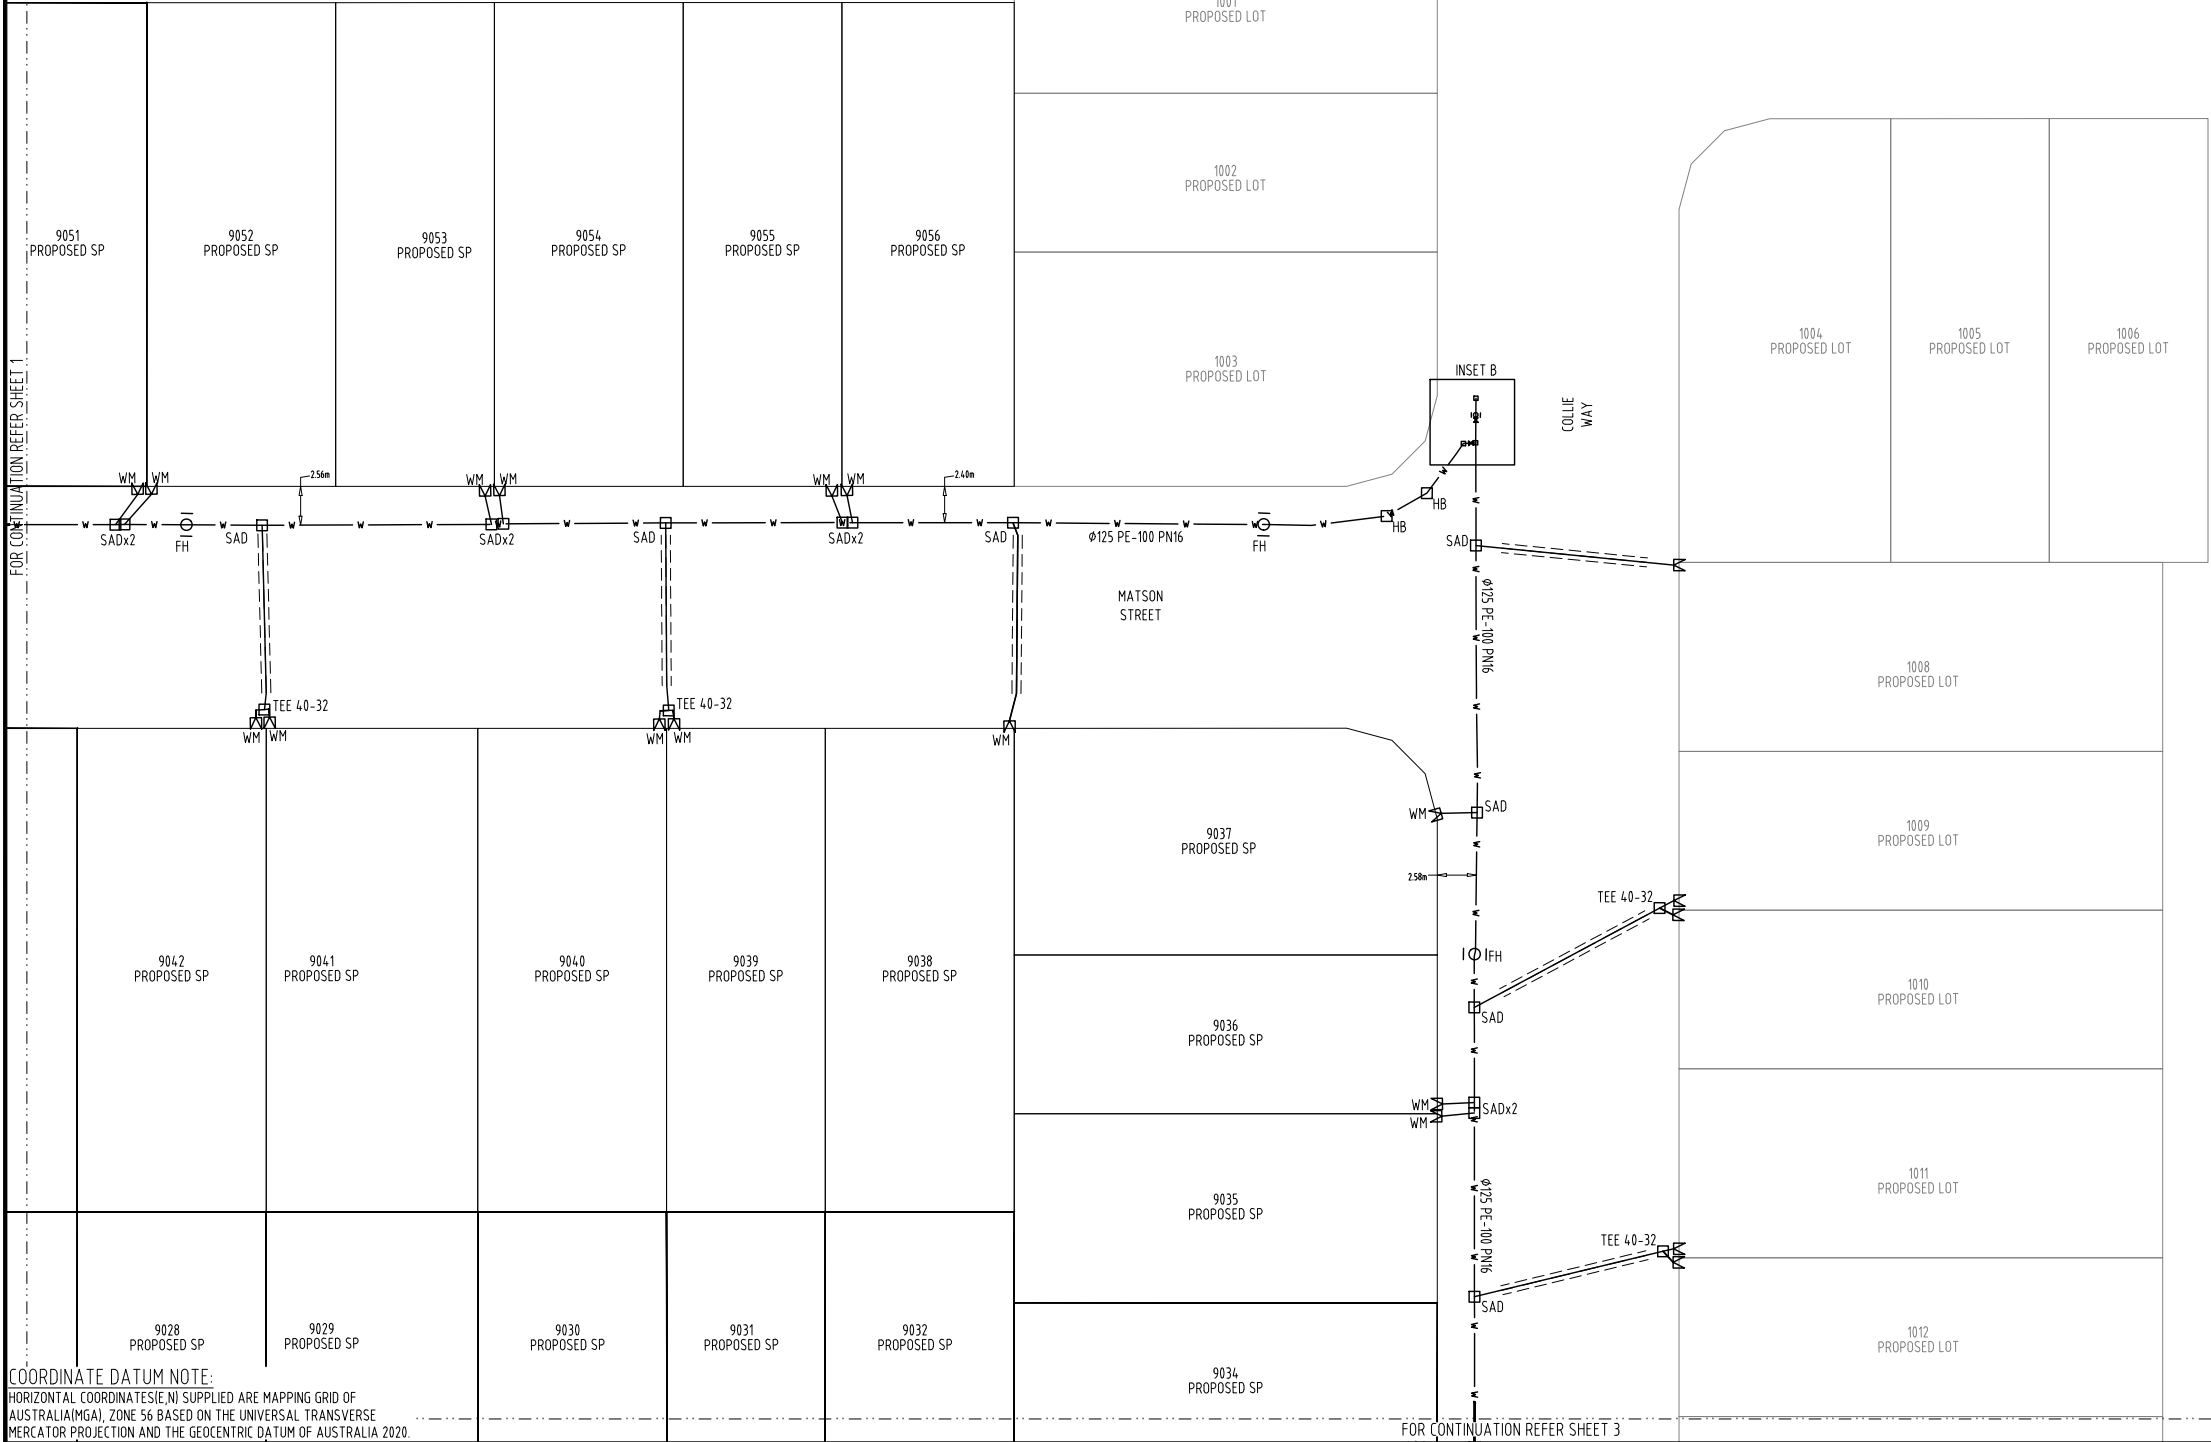

LEGEND

- WATER MAIN (PE-100 PN16)
- SERVICE PIPE (ø25 PE-100 PN16) U.N.O
- SERVICE PIPE CROSSING ROAD (ø4.0 PE-100 PN16)
- CONDUIT PIPE (ø100 PVC-M PN9)
- EXISTING WATER MAIN
- WM WATER METER (ø20 ELSTER V100)
- FH FIRE HYDRANT
- DFH DUCKFOOT FIRE HYDRANT
- TEE TEE
- SAD SADDLE
- HB HORIZONTAL BEND
- DEC END CAP
- SV STOP/GATE VALVE
- RED REDUCER



COORDINATE DATUM NOTE:
HORIZONTAL COORDINATES(E,N) SUPPLIED ARE MAPPING GRID OF AUSTRALIA(MGA), ZONE 56 BASED ON THE UNIVERSAL TRANSVERSE MERCATOR PROJECTION AND THE GEOCENTRIC DATUM OF AUSTRALIA 2020.

ENGINEER'S CERTIFICATION
I, _____, hereby certify that the as-constructed details shown on this drawing are a true and accurate record of the construction works, in compliance with the approved drawings and approved design.
RPEQ (signature) RPEQ No. _____ Date: _____

REGISTERED SURVEYOR'S CERTIFICATION
I, **B.B.H. Pty Ltd** hereby certify that the vertical and horizontal locations and dimensions shown on this plan are a true and correct record and were located by survey.
Registered Surveyor (QLD) (sig.) Reg. Surveyor No. **2655** Date: **25/9/26**



AS CONSTRUCTED

A1						
	0	24/08/2026	AS CONSTRUCTED DETAILS	JB	FC	
INDEX	DATE	REVISIONS		DRAWN	CHECKED	PASSED

DRAWN	JB	24/08/2026
CHECKED	FC	24/08/2026
PASSED		
INITIALS	DATE	



URBAN UTILITIES

DAWN WESTERN PRECINCT STAGE 9
AS-CONSTRUCTED WATER SUPPLY
UU REFERENCE NUMBER: 25-PNT-77826

SCALE	1:250
SHEET 2 OF 8 SHEETS	
DRAWING NO.	
-	
0	



LEGEND

- MAINTENANCE SHAFT (Ø600 LMDPE SMARTSTREAM POOPIT ON Ø300 UPVC RISER)
- MAINTENANCE HOLE (Ø900 INSITU CONCRETE)
- EXISTING MAINTENANCE HOLE/SHAFT
- HORIZONTAL BEND
- WYE JUNCTION (160x160 WITH 160x110 REDUCER)
- TEE
- EXTERNAL DEAD END
- REDUCER
- RETICULATION MAIN (Ø160 PE-100 SDR21)
- HOUSE CONNECTION (Ø110 PE-100)
- EXISTING SEWER MAIN

ENGINEER'S CERTIFICATION

I, _____, hereby certify that the as-constructed details shown on this drawing are a true and accurate record of the construction works, in compliance with the approved drawings and approved design.

RPEQ (signature) RPEQ No. _____ Date: _____

REGISTERED SURVEYOR'S CERTIFICATION

I, **B.B.H. Pty Ltd**, hereby certify that the vertical and horizontal locations and dimensions shown on this plan are a true and correct record and were located by survey.

Registered Surveyor (QLD) (Sig.) Reg. Surveyor No. **2655** Date: **25/9/26**

COORDINATE DATUM NOTE:
HORIZONTAL COORDINATES(E,N) SUPPLIED ARE MAPPING GRID OF AUSTRALIA(MGA), ZONE 56 BASED ON THE UNIVERSAL TRANSVERSE MERCATOR PROJECTION AND THE GEOCENTRIC DATUM OF AUSTRALIA 2020.

A1

0	24/08/2026	AS CONSTRUCTED DETAILS	JB	FC	
INDEX	DATE	REVISIONS	DRAWN	CHECKED	PASSED

DRAWN	JB	24/08/2026
CHECKED	FC	24/08/2026
PASSED		
INITIALS		DATE



URBAN UTILITIES


DAWN WESTERN PRECINCT STAGE 9
AS-CONSTRUCTED SEWER RETICULATION
UU REFERENCE NUMBER: 25-PNT-77826

SCALE 1:250

SHEET 5 OF 8 SHEETS

DRAWING NO.

-

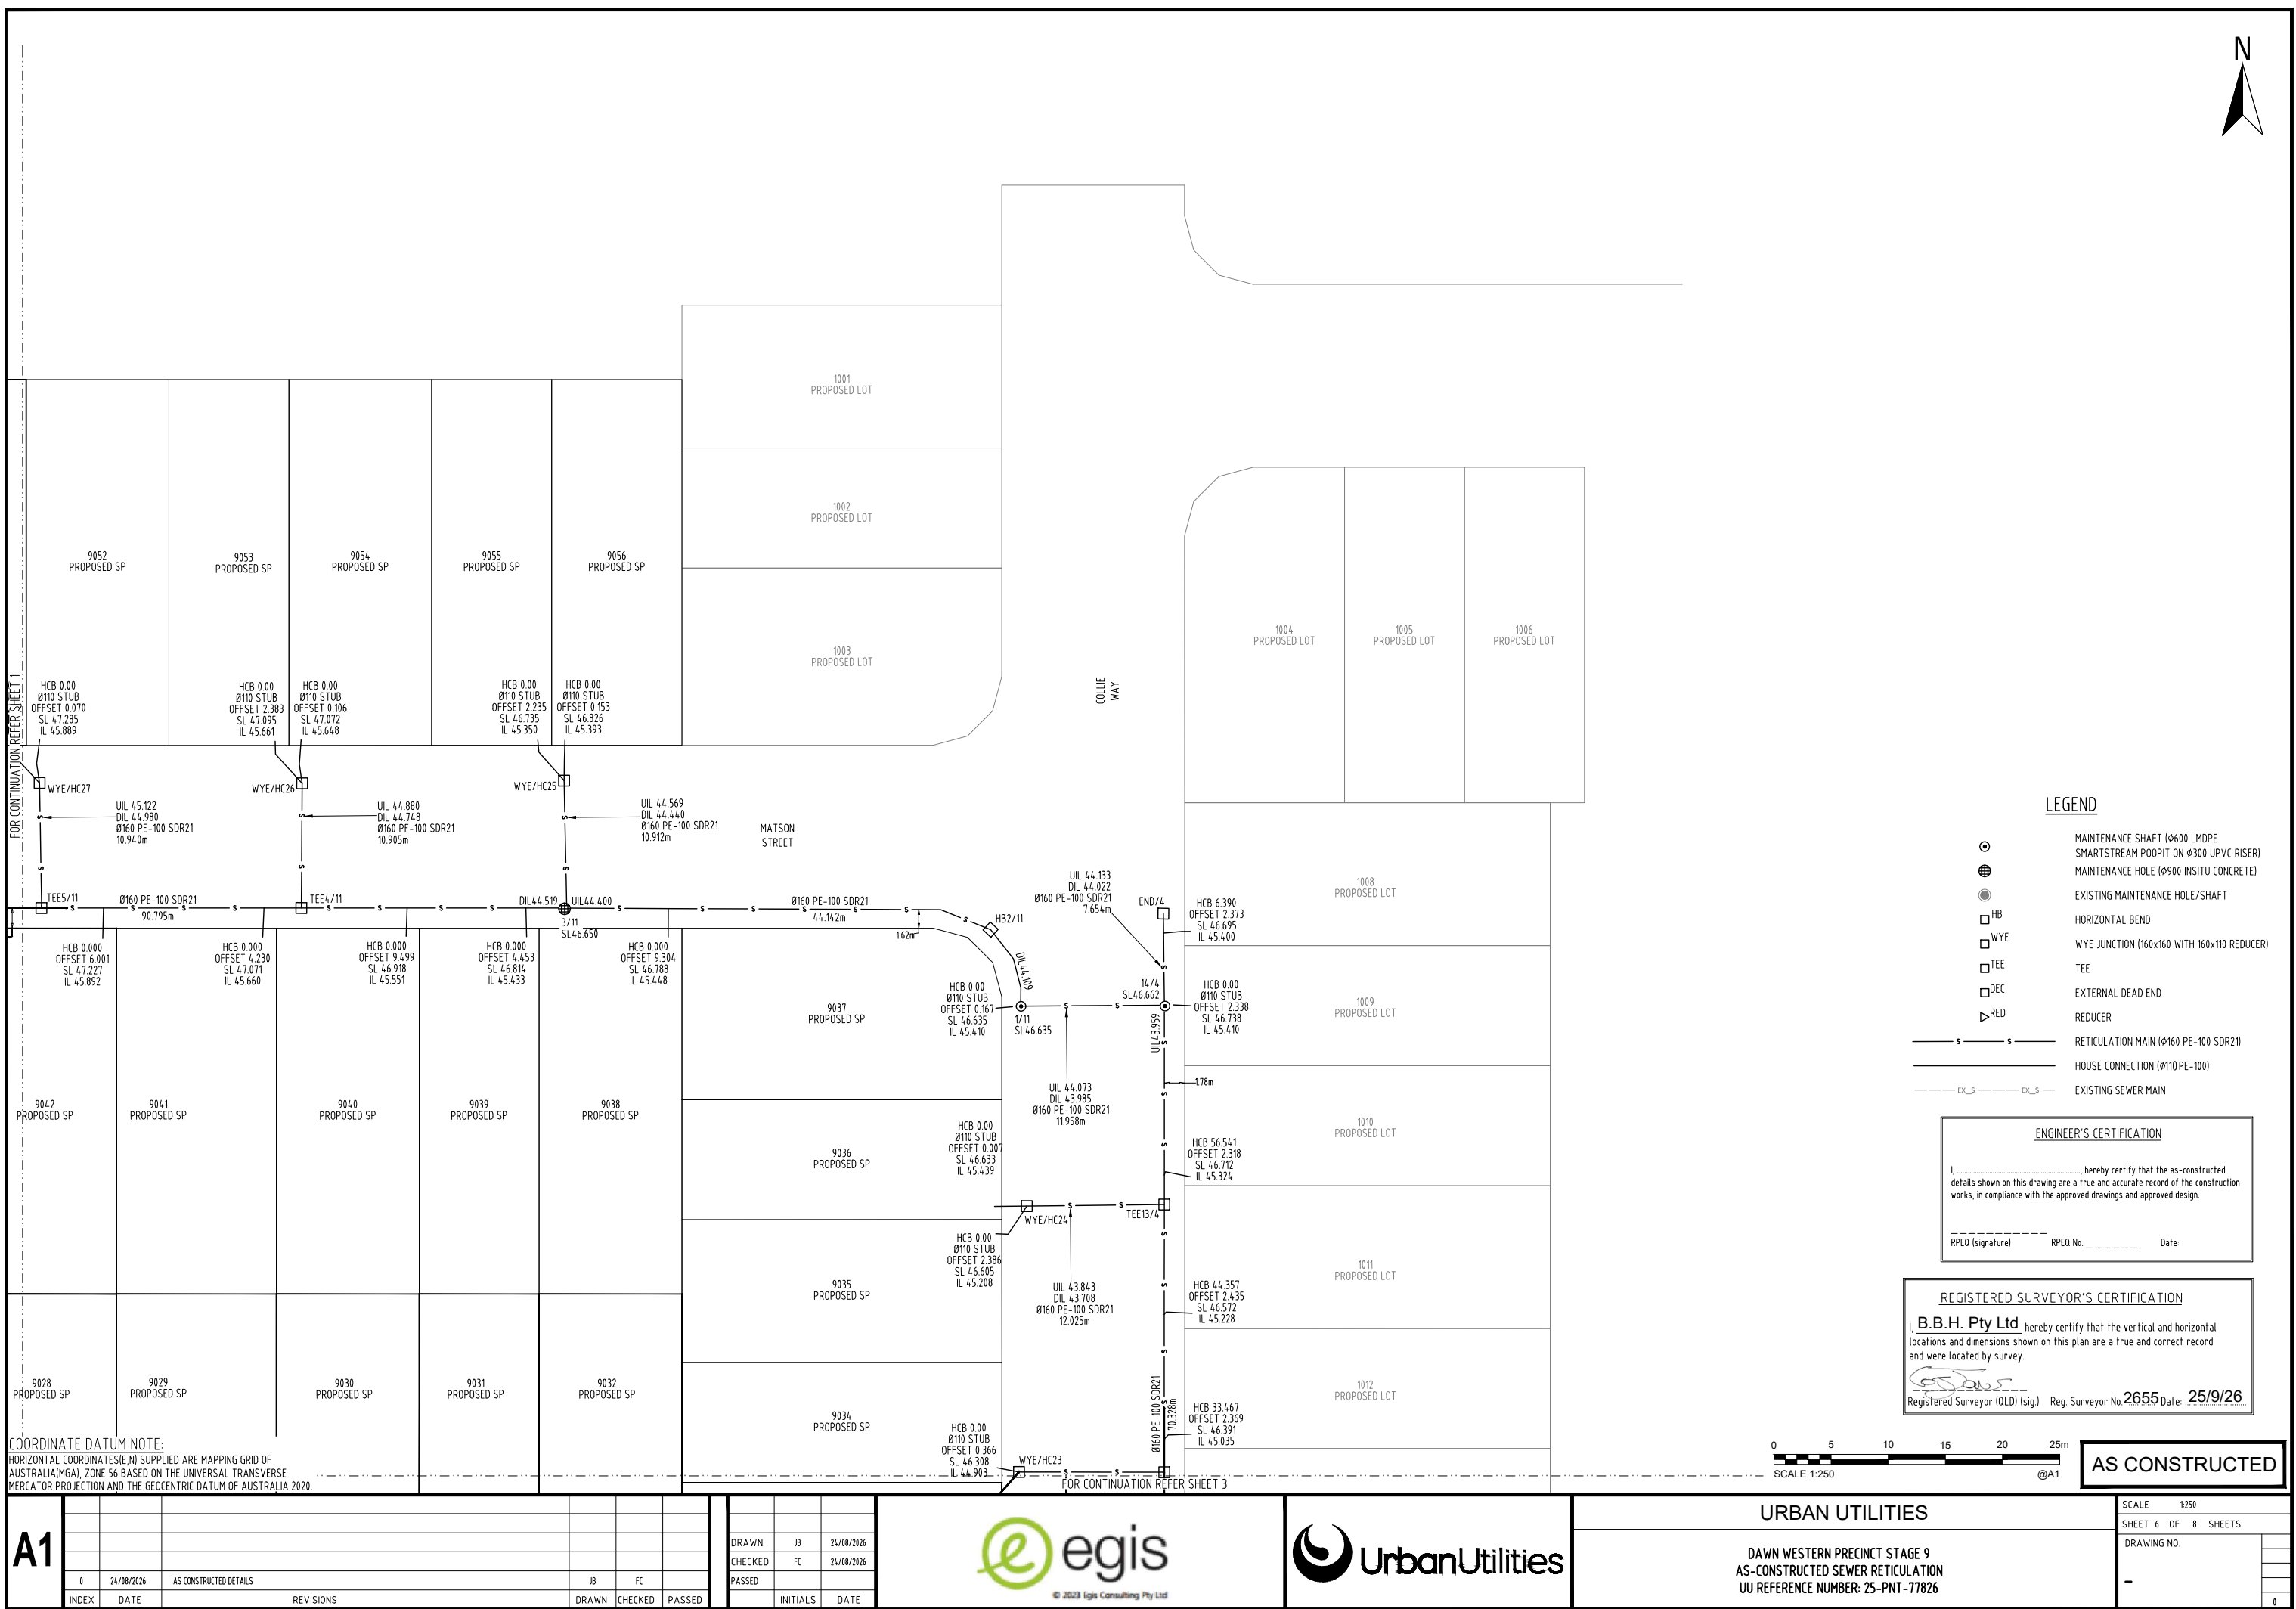



 MAINTENANCE SHAFT (Ø600 LMDPE
SMARTSTREAM POOPIT ON Ø300 UPVC RISER)
 MAINTENANCE HOLE (Ø900 INSITU CONCRETE)
 EXISTING MAINTENANCE HOLE/SHAFT
 HORIZONTAL BEND
 WYE JUNCTION (160x160 WITH 160x110 REDUCER)
 TEE
 EXTERNAL DEAD END
 REDUCER
 RETICULATION MAIN (Ø160 PE-100 SDR21)
 HOUSE CONNECTION (Ø110 PE-100)
 EXISTING SEWER MAIN

I, _____, hereby certify that the as-constructed details shown on this drawing are a true and accurate record of the construction works, in compliance with the approved drawings and approved design.

RPEQ (signature) RPEQ No. Date

B.H. Pty Ltd hereby certify that the vertical and horizontal lines and dimensions shown on this plan are a true and correct record of the location of the property as located by survey.

Registered Surveyor (QLD) (sig.) Reg. Surveyor No. 2655 Date: 25/9/26

COORDINATE DATUM NOTE:
HORIZONTAL COORDINATES(E,N) SUPPLIED ARE MAPPING GRID OF AUSTRALIA(MGA), ZONE 56 BASED ON THE UNIVERSAL TRANSVERSE MERCATOR PROJECTION AND THE GEOCENTRIC DATUM OF AUSTRALIA 2020



AS CONSTRUCTED

URBAN UTILITIES

DAWN WESTERN PRECINCT STAGE 9
AS-CONSTRUCTED SEWER RETICULATION
UU REFERENCE NUMBER: 25-PNT-77826

SCALE 1:250

SHEET 7 OF 8 SHEETS

D R A W I N G N O .

1	2	3	466
---	---	---	---	---	---	---	---	---	----	----	-----	-----	
