


AS CONSTRUCTED

NBN SYMBOL LEGEND

- Transformer / Kiosk / Pad Mount
Sub-station / Pole Mount Transformer
- PIT-ID
5 Network Boundary/Local Network Pit (Single Lid) (700mmX450mmX650mm)
- PIT-ID
8 Distribution/Local Network Connection Pit (1360mmX555mmX860mm)
- PIT-ID
9 Fibre Distribution Hub (FDH) Pit (2000mmX555mmX900mm)
- Shared Trench Symbol
- Energex Pillar

TRENCH SECTION

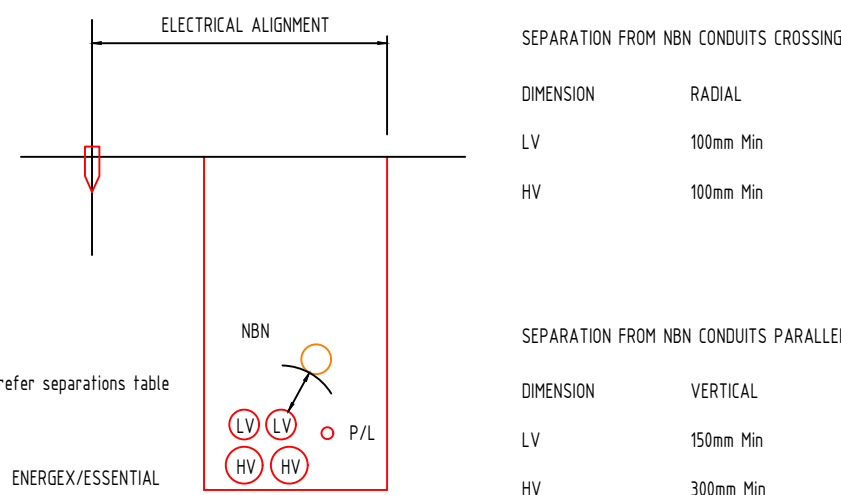

SDU Development Information

Development Name:
DAWN ESTATE STAGE 7
Developer Company:
ID WALLOON DEVELOPMENTS PTY LTD
Development Address:
WALLOON - 4036
Authorised Rep:
PE CONSULTING ENGINEERS
Phone: 07 5596 1425
E-Mail: urd@pece.com.au
nbn Reference Number: STG-M000189056
Stage Number: 7
Design Revision: E

BILL OF MATERIAL

NO OF LOTS: 34

PITS		DUCTS	
SIZE	QTY	SIZE	QTY
2	7	P100	28
5	17	P50	7
6	3	P20	42
8	2		
9	0		

TOTAL NUMBER OF PITS: 29
TOTAL NUMBER OF MANHOLES: 0
TOTAL NUMBER OF CONDUITS: 77
TOTAL LENGTH OF CONDUITS: 1370.4

