


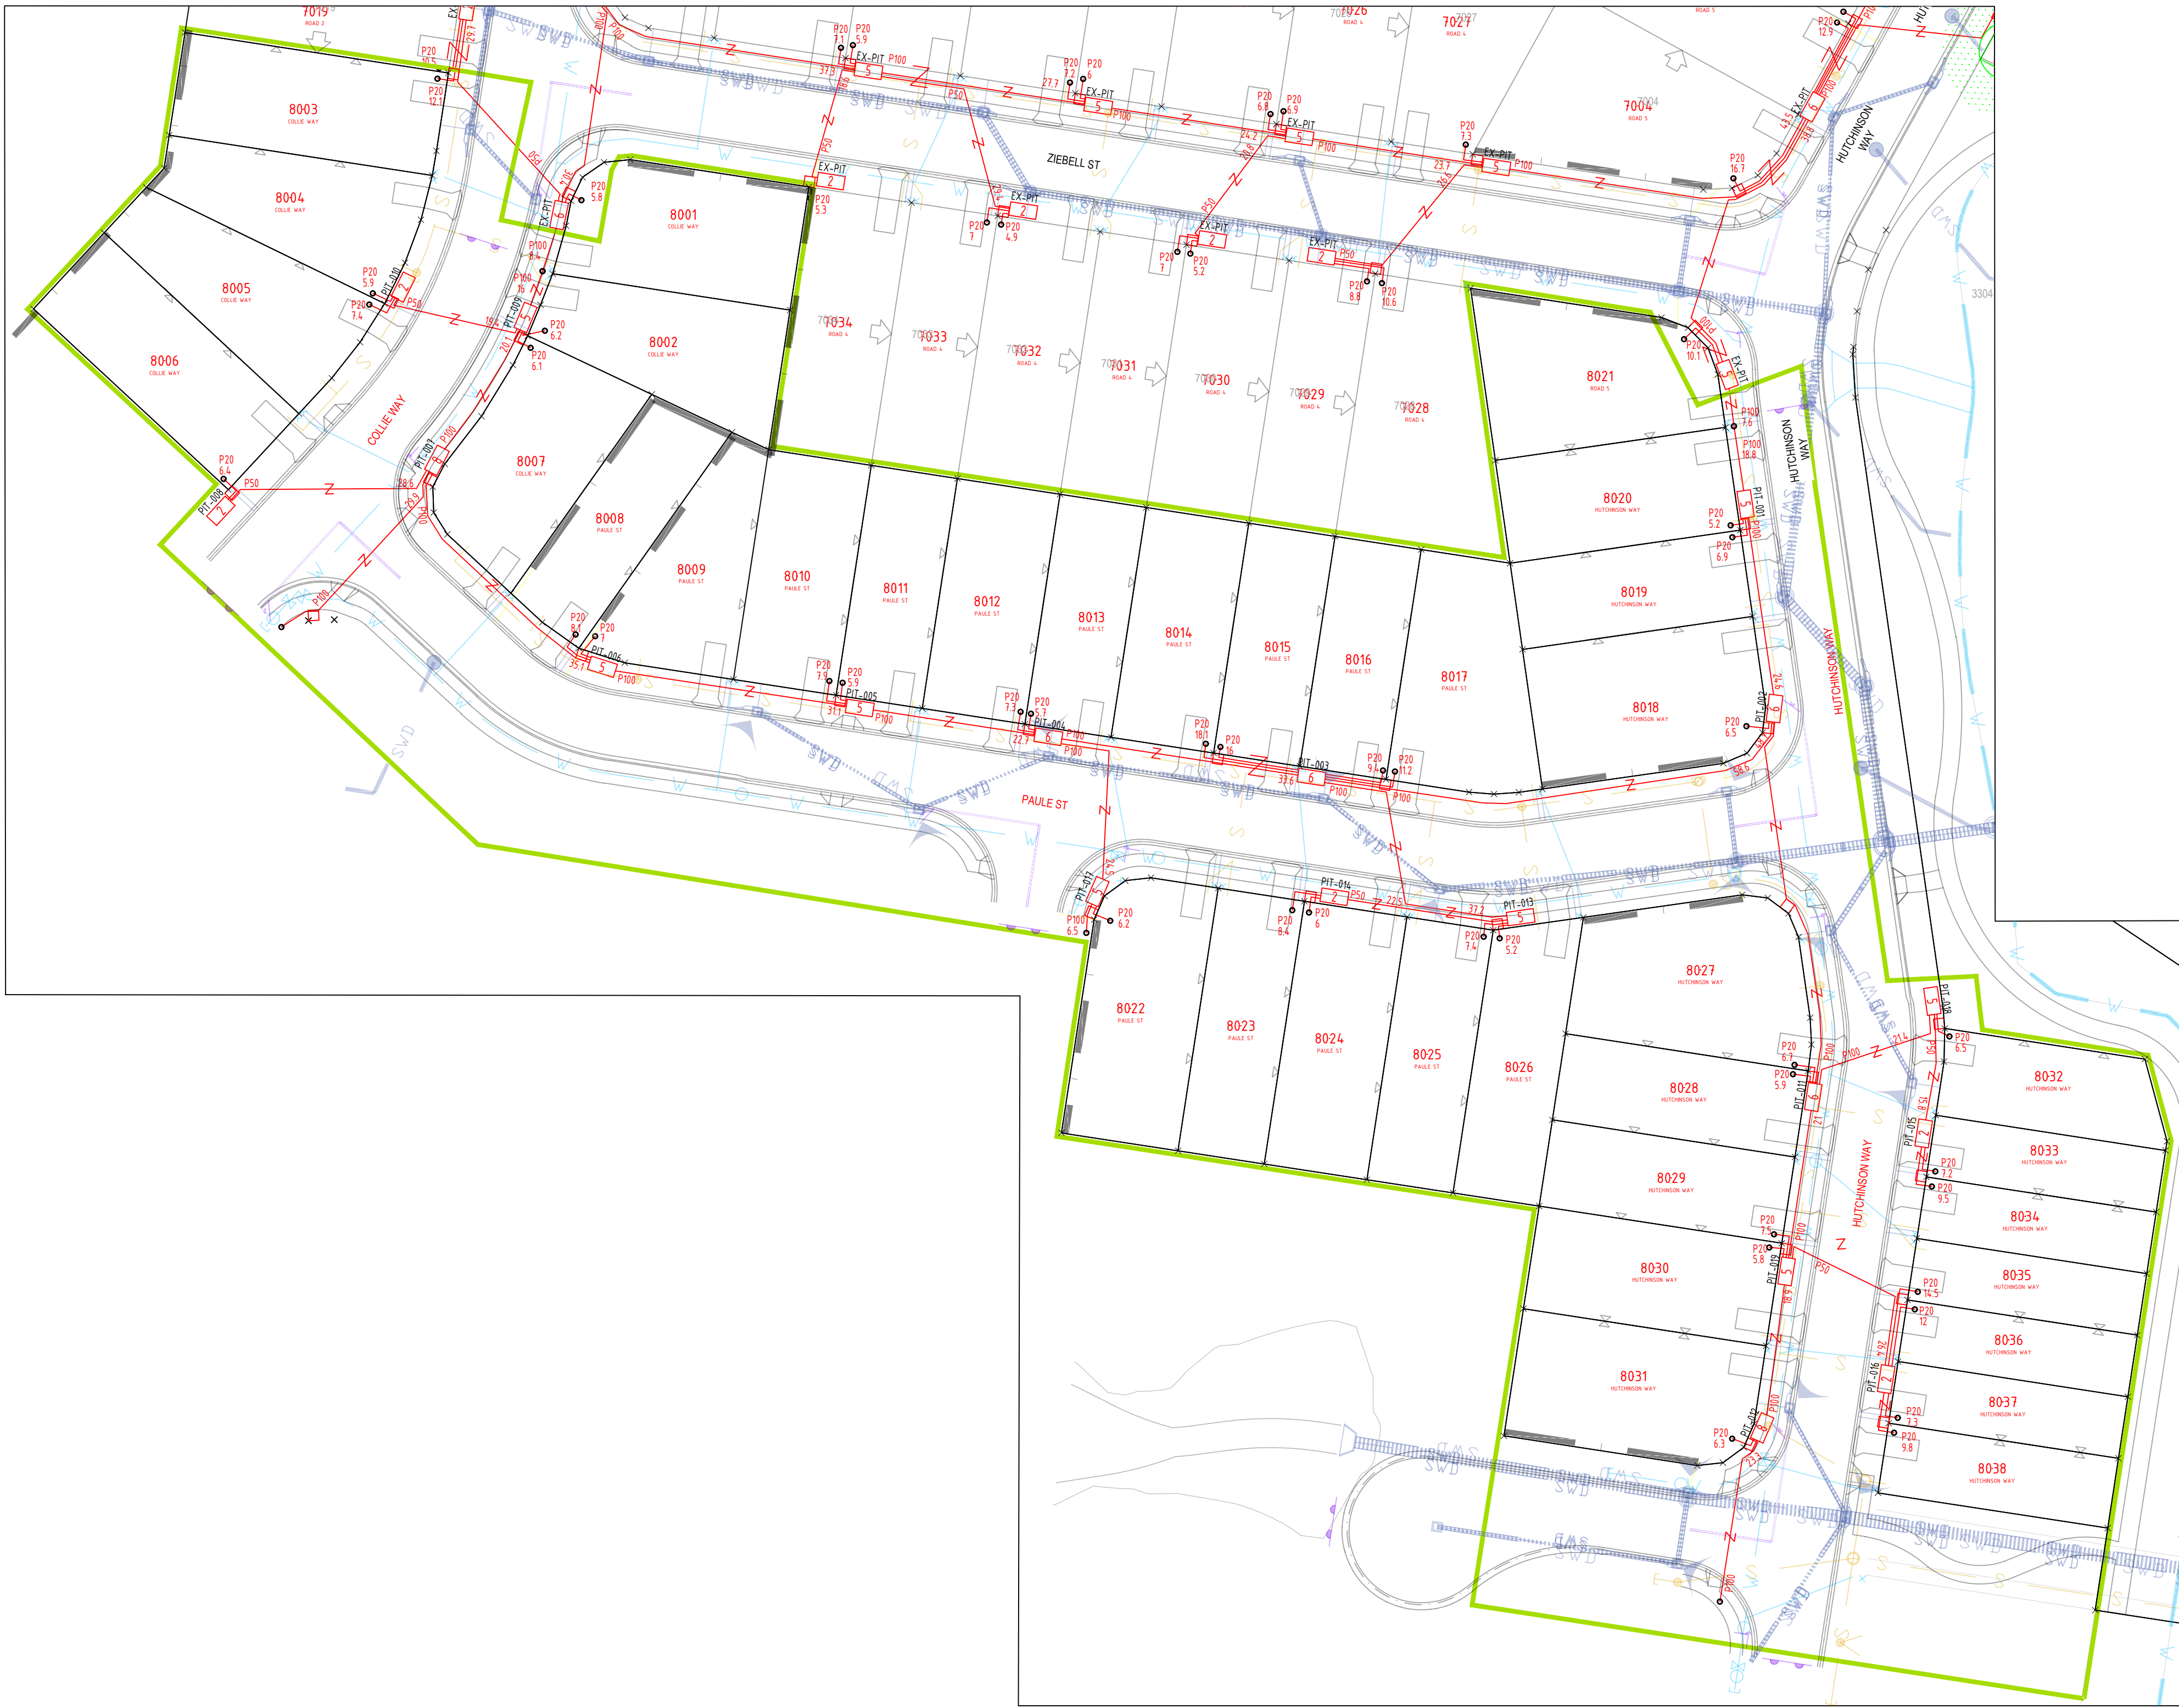

SDU Development Information


Development Name:
DAWN ESTATE STAGE 8
Developer Company:
ID WALLOON DEVELOPMENTS PTY LTD
Development Address:
PARKLAND DR - WALLOON - 4036
Authorised Rep:
PE CONSULTING ENGINEERS
Phone: 07 5596 1425
E-Mail: urd@pece.com.au
nbn Reference Number: STG-M000189058
Stage Number: 8
Design Revision: E

BILL OF MATERIAL				
NO OF LOTS: 38				
PITS		DUCTS		
SIZE	QTY	SIZE	QTY	MTRS
2	5	P100	18	475.4
5	8	P50	5	112.7
6	4	P20	35	279.4
8	2			
9	0			
TOTAL NUMBER OF PITS:		19		
TOTAL NUMBER OF MANHOLES:		0		
TOTAL NUMBER OF CONDUITS:		58		
TOTAL LENGTH OF CONDUITS:		867.5		


NBN SYMBOL LEGEND

- Transformer / Kiosk / Pad Mount
Sub-station / Pole Mount Transformer
- PIT-ID 5 Network Boundary/Local Network Pit (Single Lid) (700mmX450mmX650mm)
- PIT-ID 6 Distribution/Local Network Connection Pit (Dual Lid) (1360mmX555mmX650mm)
- PIT-ID 8 Distribution/Local Network Connection Pit (1360mmX555mmX860mm)
- Shared Trench Symbol
- Energex Pillar


TRENCH SECTION

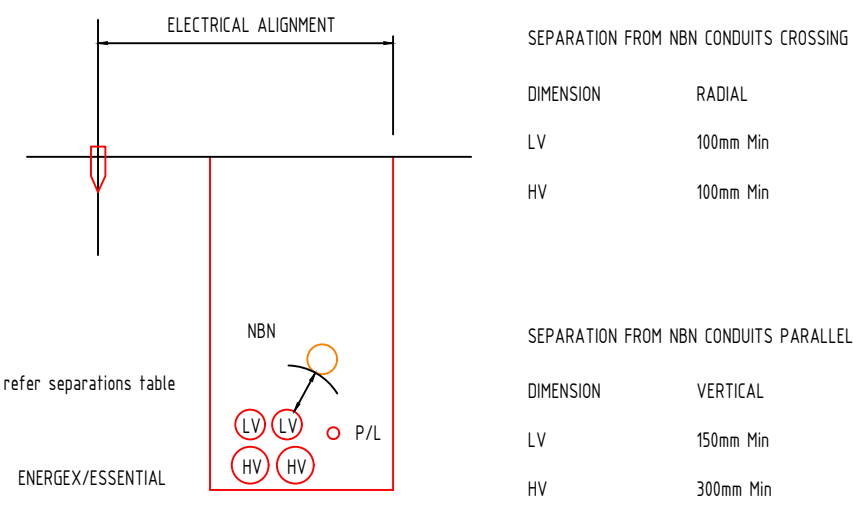

CONDUIT CONFIGURATION

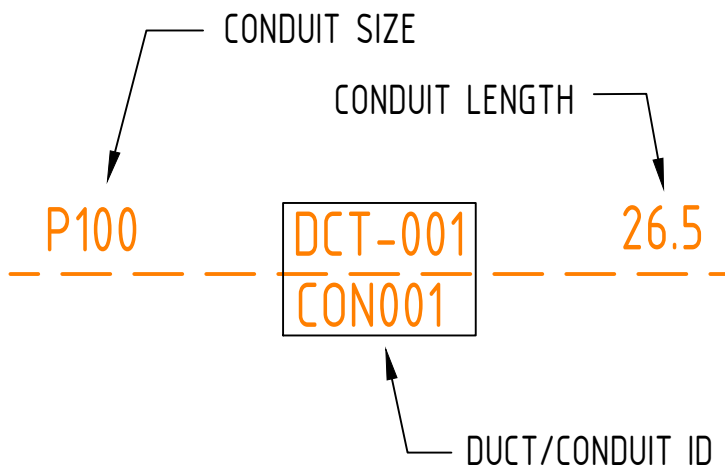

STANDARD NBN PIT OFFSET TO ENERGEX PILLAR

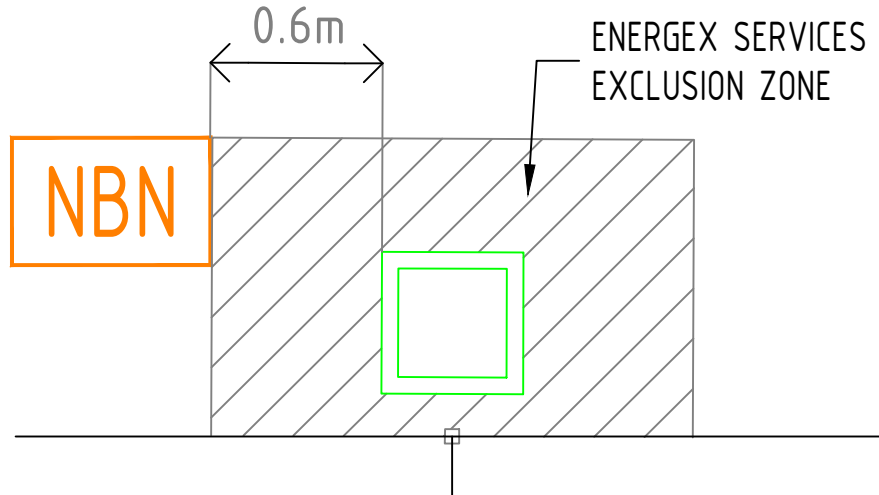

WHERE PITS ARE NOT LOCATED BESIDE PILLARS, OFFSETS WILL BE SHOWN ON THE LAYOUT TO THE NEAREST TRUNCATION. IF NO OFFSET DISTANCE IS SHOWN, PLEASE CONTACT DESIGN CONSULTANT PRIOR TO INSTALLATION.

AS CONSTRUCTED



REV	DATE	DRAFTER	DESCRIPTION	APPROVED
-				
-				
E	11.06.26	FP	As Constructed	
D	07.10.25	FP	Issued for Construction	
C	17.09.25	FP	Reissued for NBN Acceptance	
B	01.07.25	FP	Issued for NBN Acceptance	
A	-	FP	Issued for NBN Acceptance	B

STRICTLY CONFIDENTIAL

NBNCO APPROVAL RECORD:



SIGNATURE _____ DATE _____

DD ☐ WD ☐ AB ☐

QUALITY RECORD:

NBNCO DISCLAIMER

THIS DOCUMENT HAS BEEN PREPARED SOLELY FOR THE USE OF NBNCO LIMITED (ABN 86 136 533 741) FOR USE IN MAINTAINING NBNCO FACILITIES. IT HAS NOT BEEN CREATED FOR ANY OTHER USE. IT SHOULD NOT BE SCALED TO LOCATE NBNCO ASSETS. NO WARRANTY IS GIVEN THAT THE INFORMATION IS ACCURATE OR COMPLETE.

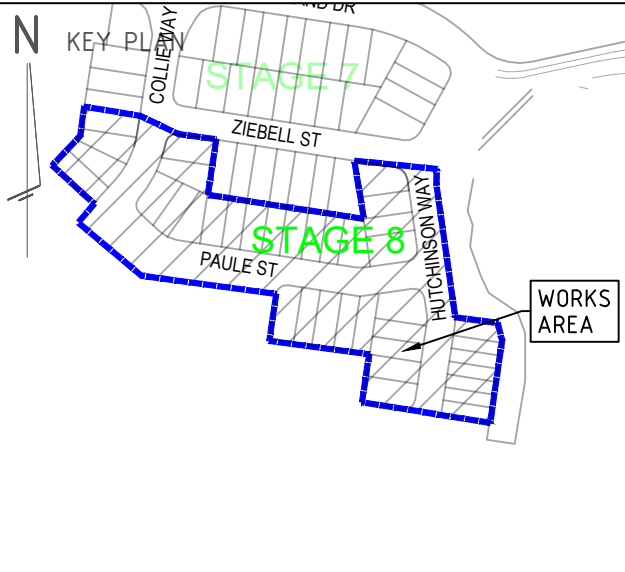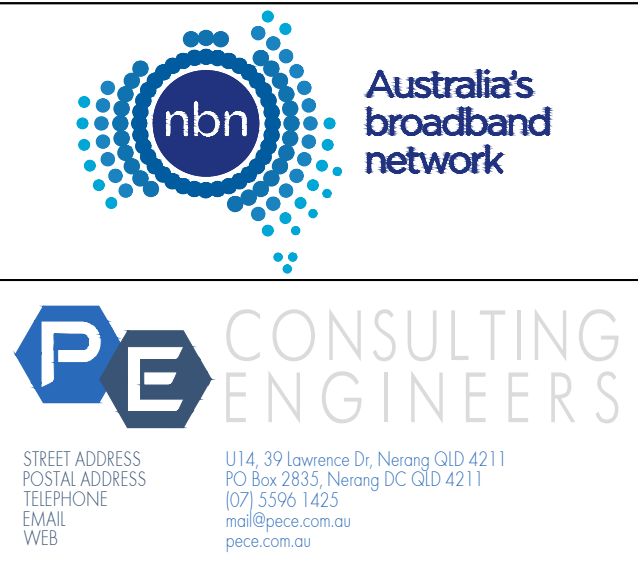

DRAWING TITLE:
STG-M000189058
PIT & PIPE LAYOUT
DAWN ESTATE STG 8
PARKLAND DR - 38 LOT SUBDIVISION
ENABLE#: 279323

STATE: QLD REGION: 56

FSA: SAM: ADA:

PROJECT No: STG-M000189058

CADREF No:

SCALE 1:500@A1 SHEET No. 1 OF 1 REV. E