


AS CONSTRUCTED

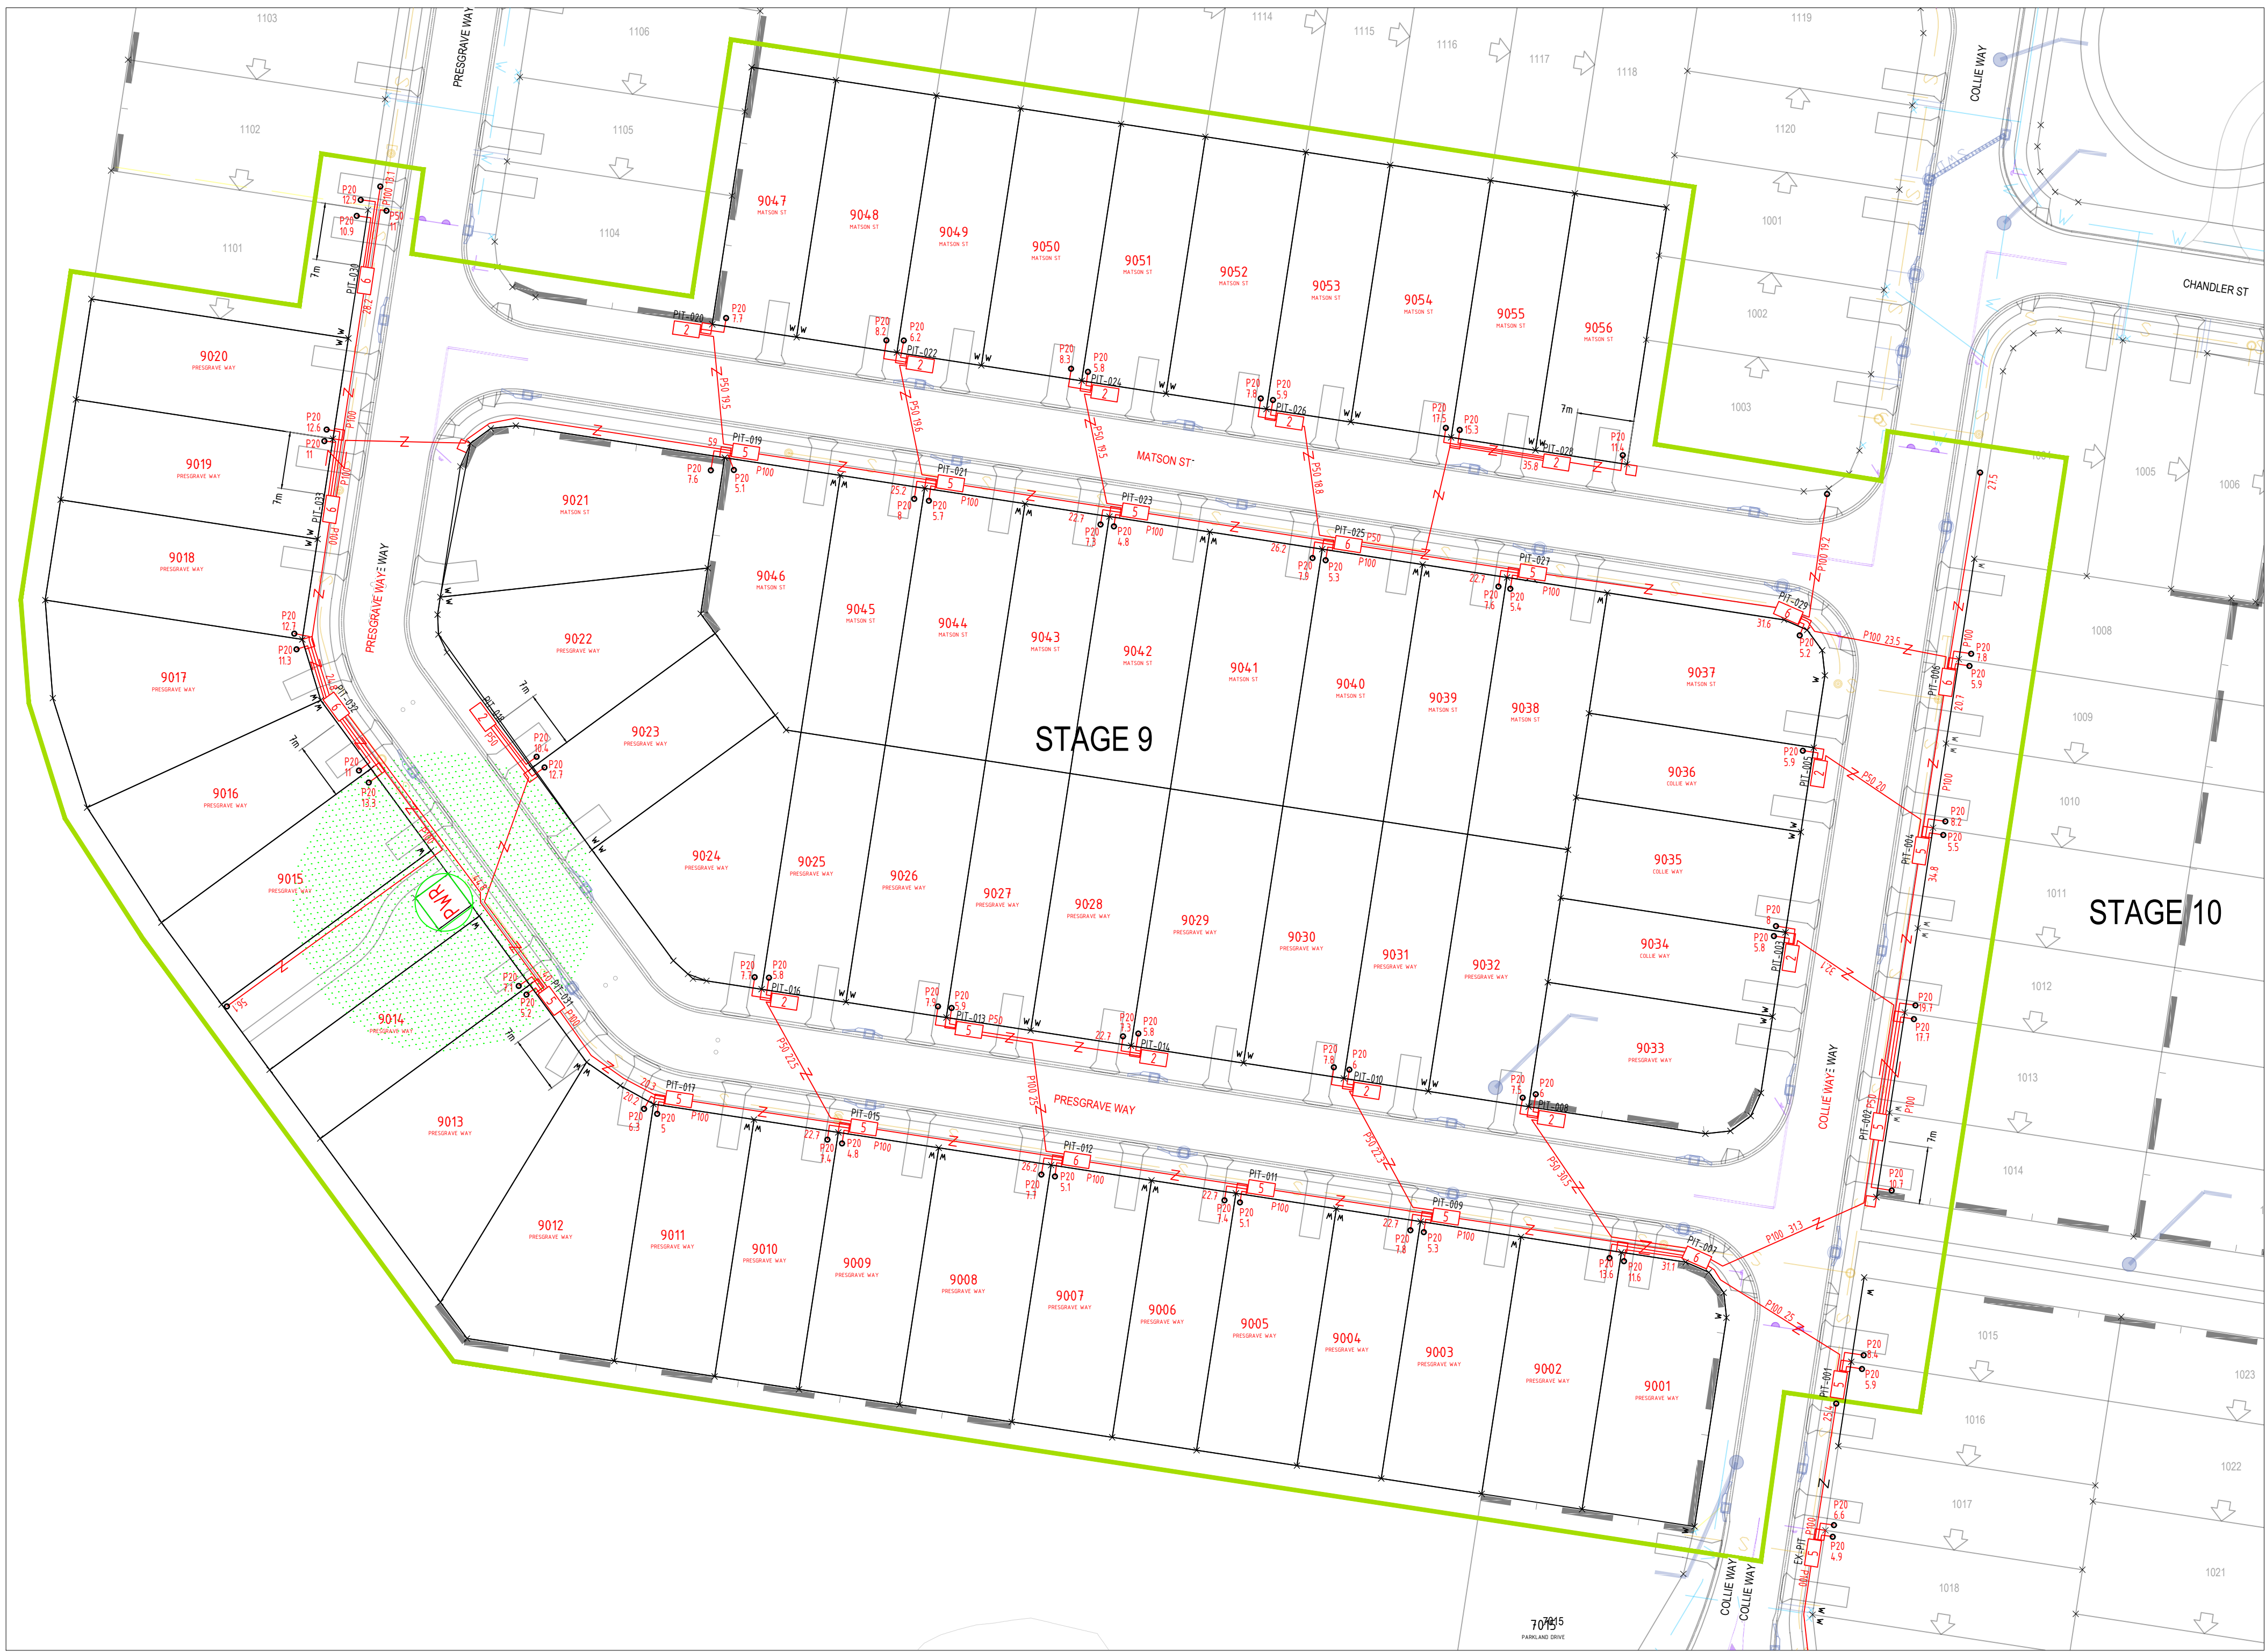

SDU Development Information


Development Name:
DAWN ESTATE STAGE 9
Developer Company:
ID WALLOON DEVELOPMENTS PTY LTD
Development Address:
33 CALEDONIAN RD, WALLOON QLD 4306
Authorised Rep:
PE CONSULTING ENGINEERS
Phone: 07 5596 1425
E-Mail: urd@pece.com.au
nbn Reference Number: STG-M000194876
Stage Number: 9
Design Revision: C

BILL OF MATERIAL				
NO OF LOTS: 56				
PITS		DUCTS		
SIZE	QTY	SIZE	QTY	MTRS
2	12	P100	25	707.1
5	13	P50	13	314.3
6	8	P20	67	559.4
8	0			
9	0			
TOTAL NUMBER OF PITS:		33		
TOTAL NUMBER OF MANHOLES:		0		
TOTAL NUMBER OF CONDUITS:		105		
TOTAL LENGTH OF CONDUITS:		1580.8		


NBN SYMBOL LEGEND

- Transformer / Kiosk / Pad Mount
Sub-station / Pole Mount Transformer
- PIT-ID
5 Network Boundary/Local Network Pit (Single Lid) (700mmX450mmX650mm)
- PIT-ID
8 Distribution/Local Network Connection Pit (1360mmX555mmX860mm)
- PIT-ID
9 Fibre Distribution Hub (FDH) Pit (2000mmX555mmX900mm)
- Shared Trench Symbol
- Energex Pillar


TRENCH SECTION

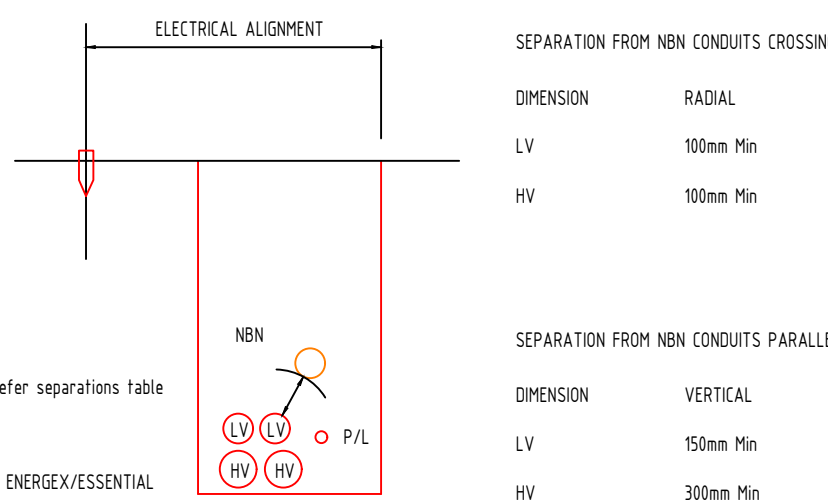

CONDUIT CONFIGURATION

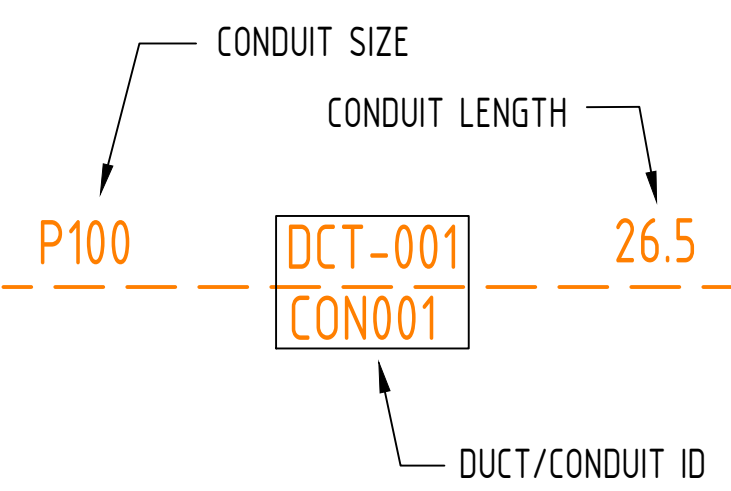

STANDARD NBN PIT OFFSET TO ENERGEX PILLAR

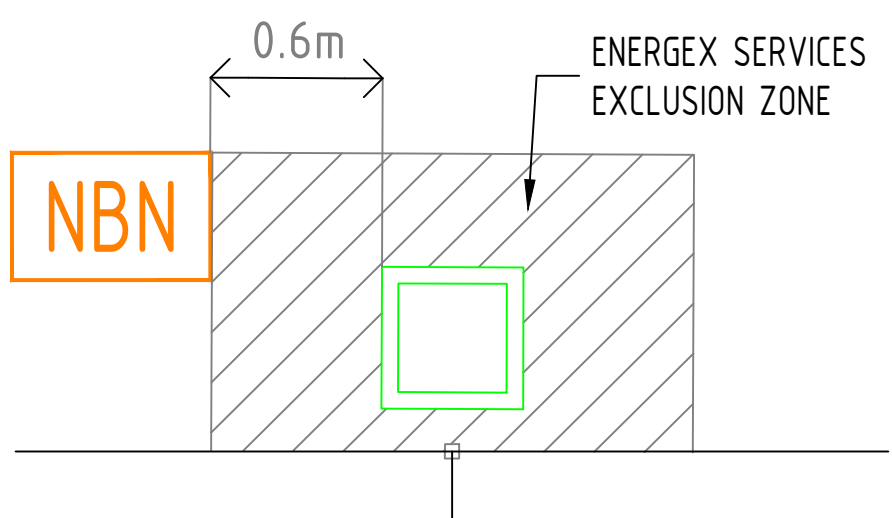

WHERE PITS ARE NOT LOCATED BESIDE PILLARS, OFFSETS WILL BE SHOWN ON THE LAYOUT TO THE NEAREST TRUNCATION. IF NO OFFSET DISTANCE IS SHOWN, PLEASE CONTACT DESIGN CONSULTANT PRIOR TO INSTALLATION.




REV	DATE	DRAFTER	DESCRIPTION	APPROVED
C	11.06.26	FP	As Constructed	
B	29.10.25	FP	Issue for Construction	
A	31.07.25	FP	Issued for NBN Acceptance	

STRICTLY CONFIDENTIAL	
NBNCO APPROVAL RECORD:	
SIGNATURE	DATE
☐ DD	
☐ WD	
☐ AB	
QUALITY RECORD:	
NBNCO DISCLAIMER	
THIS DOCUMENT HAS BEEN PREPARED SOLELY FOR THE USE OF NBNCO LIMITED (ABN 86 136 533 741) FOR USE IN MAINTAINING NBNCO FACILITIES. IT HAS NOT BEEN CREATED FOR ANY OTHER USE. IT SHOULD NOT BE SCALED TO LOCATE NBNCO ASSETS. NO WARRANTY IS GIVEN THAT THE INFORMATION IS ACCURATE OR COMPLETE.	

Australia's broadband network

PE CONSULTING ENGINEERS

STREET ADDRESS: PO BOX 2853, NANNING QLD 4211
TELEPHONE: (07) 5596 1425
EMAIL: urd@pece.com.au
WEB: pece.com.au

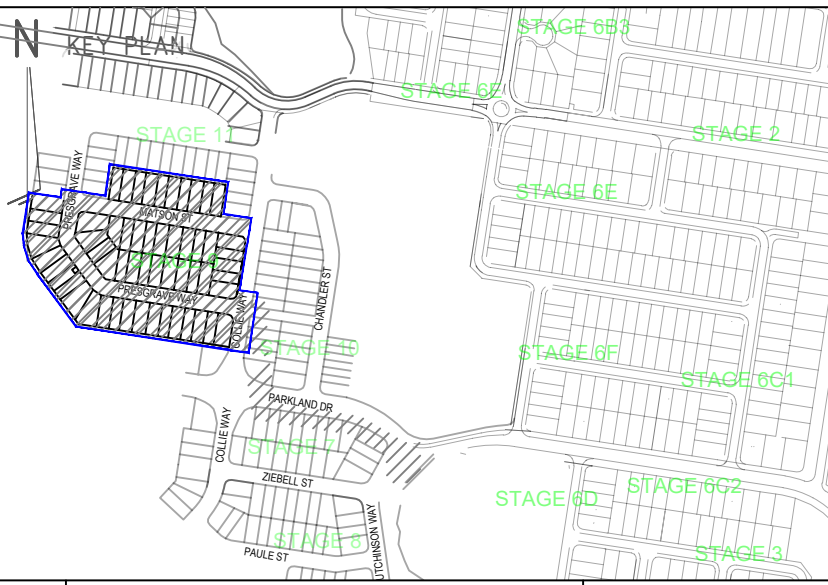

DRAWING TITLE: STG-M000194876 PIT & PIPE LAYOUT DAWN ESTATE STG 9 33 CALEDONIAN RD, WALLOON - QLD 4306			
ENABLE#: 279323			
STATE: QLD		REGION: 56	
FSA:	SAM:	ADA:	
PROJECT No: 25-0123			
CADREF No: 25-0123			
SCALE 1:500@A1	SHEET No. 1	OF 1	REV. C